A RENOVATION OF THE MISSISSIPPPI COUNTY HEALTH UNITS SCEQLA, ARKANSAS BLY I'HE' Re-Issue: October 28, 2022

Vicinity Map:



- ROOM NAMES AND NUMBERS FOLLOW ROOM NAMES & NUMBERS FROM ORIGINAL ARCHITECTURAL DRAWINGS FROM THE 1990'S. IT IS POSSIBLE SOME HAVE CHANGED OVER TIME, CONTRACTOR VERIFY. ORIGINAL ARCH. DRAWINGS ARE AVAILABLE FOR VIEWING. CONTACT ARCHITECT TO REQUEST A WEBLINK WHERE YOU MAY DOWNLOAD FOR VIEWING
- CONTRACTOR SHALL ASSUME LARGE FURNISHING ITEMS SUCH AS APPLIANCES, VACCINE REFRIGERATORS & FREEZERS, EXAM TABLES ARE TO REMAIN DURING THE COURSE OF CONSTRUCTION AND SHALL BE MOVED FROM ROOM TO ROOM AS NEEDED TO ACCOMMODATE THE WORK AND TO PROTECT THEM FROM DAMAGE AND UNNECESSARY HANDLING. MOVE BACK INTO PLACE UPON COMPLETION.
- CONTRACTOR ASSUME MISC. WALL MOUNTED DEVICES WILL NEED TO BE REMOVED TO ACCOMMODATE THE WORK. TEMPORARILY REMOVE AND RE-INSTALL AED DEVICES, FIRE EXTINGUISHERS OR OTHER EXPENSIVE EQUIPMENT. REFER TO ALLOWANCES FOR THE PURCHASE OF REPLACEMENT WALL MOUNTED HAND SANITIZERS & OTHER MISC.
- HEALTH UNITS IN MISSISSIPPI COUNTY, ARKANSAS. TO MINIMIZE DISRUPTION TO PATRONS, THE PROJECT SHALL BE PHASED SUCH THAT ONLY ONE UNIT IS CLOSED AT A TIME.

UPON NOTICE TO PROCEED, THE BLYTHEVILLE UNIT WILL BE CLOSED FIRST, ALLOWING FOR WORK TO TAKE PLACE, THEN RE-OPENED ONLY UPON SUBSTANTIAL COMPLETION. APPROXIMATELY ONE WEEK AFTER SUBSTANTIAL COMPLETION ON THE BLYTHEVILLE UNIT, THE OSCEOLA UNIT WILL BE CLOSED TO THE PUBLIC TO ALLOW FOR RENOVATIONS.

FOR ACCOUNTING PURPOSES ONLY, CONTRACTORS ARE REQUESTED TO SEPARATE THEIR BIDS, GIVING A PRICE FOR WORK RELATED TO THE BLYTHEVILLE UNIT SEPARATE FROM THE PRICE RELATED TO THE OSCEOLA UNIT. REFERENCE THE BID FORM IN THE SPECIFICATIONS.

AISSISSIPPI COUNTY HEALTH UNIT 1299 N. 10TH ST, BLYTHEVILLE, AR 72315 Great Riv Medical Cente Chickasawba Mound 🖻 Delta Gateway Museum Promise Me Arkansas 😋 stern College ove's Travel Stop Hatcher Cemetery INTERSTATE 55 TO OSCEOLA

201 S. Chester St., Little Rock, AR


6.) MANY WALLS SHOULD BE CONSIDERED LOAD-BEARING. CONTRACTOR VERIFY BY COMPARING ORIGINAL ARCH. DRAWINGS WITH FIELD CONDITIONS. REVIEW ORIG. FOUNDATION PLAN WHICH SHOWS FOOTINGS BENEATH LOAD-BEARING WALLS SUPPORTING TRUSSES ABOVE. CONTRACTOR IS RESPONSIBLE FOR SHORING WALLS AS NEEDED PRIOR TO FULL DEMOLITION.

REFERENCE "ALLOWANCES" IN SPECIFICATIONS FOR A NUMBER OF WORK SCOPE ITEMS. SOME OF THESE ITEMS REQUIRE WORK TO BE INCLUDED IN THE BASE BID.

THIS PROJECT ESSENTIALLY INVOLVES NEW FINISIHES FOR BOTH UNITS, INCLUDING NEW FINISH FLOORING, BASE, NEW PAINT FOR ALL WALLS & DOOR FRAMES, AND CEILINGS. CONTRACTOR SHALL TAKE NOTE OF SOME EXISTING DAMAGE TO SURFACES THROUGHOUT AND PATCH AS REQUIRED PRIOR TO NEW PAINT. MATCH TEXTURE ON CEILINGS WITH EXISTING ADJACENT.

She	et List:		
Г-І	Title Sheet, Contatcs, Sheet List, Vicinity Map		
OSCEOL	A UNIT DRAWINGS LIST:	BLYTHE	EVILLE UNIT DRAWINGS LIST:
JC-1.1	Architectural Site Plan, Project General Notes	BC-I.I	Architectural Site Plan, Project General Notes
DA-1.1 DA-1.2	Demo & Proposed New Floor Plans, Notes Demo & Proposed New Reflected Ceiling Plans	BA-1.1 BA-1.2	Demo & Proposed New Floor Plans, Notes Demo & Proposed New Reflected Ceiling Plans
JA-2.I	Exterior Elevations	BA-2.1	Exterior Elevations
DA-3.1 DA-3.2 DA-3.3 DA-3.4	Enlarged Floor Plans & Interior Elevations Enlarged Floor Plans & Interior Elevations Millwork Details Millwork Details	BA-3.1 BA-3.2 BA-3.3 BA-3.4 BA-3.5	Enlarged Floor Plans & Interior Elevations Enlarged Floor Plans & Interior Elevations Enlarged Floor Plans & Interior Elevations Millwork Details Millwork Details
JA-4.I	Schedules	BA-4.1	Schedules
OM-0.1 OM-1.1 OM-1.2 OM-2.1 OM-3.1	Mechanical Notes & Legend Demo HVAC Plan- Osceola Reno HVAC Plan- Osceola Mechanical Details I Mechanical Schedules	BM-0.1 BM-1.1 BM-1.2 BM-2.1 BM-3.1	Mechanical Notes & Legend Demo HVAC Plan- Osceola Reno HVAC Plan- Osceola Mechanical Details I Mechanical Schedules
OP-0.1 OP-1.1 OP-1.2 OP-2.1	Plumbing Notes, Schedules & Legend Demo Plumbing Plan- Osceola Reno Plumbing Plan- Osceola Plumbing Details	BP-0.1 BP-1.1 BP-1.2 BP-2.1	Plumbing Notes, Schedules & Legend Demo Plumbing Plan- Osceola Reno Plumbing Plan- Osceola Plumbing Details
DE-0.1 DE-1.1 DE-1.2 DE-2.1 DE-2.2	Electrical General Notes & Legend Lighting Power & Systems Electrical Details & Diagrams Electrical Schedules	BE-0.1 BE-1.1 BE-1.2 BE-2.1 BE-2.2	Electrical General Notes & Legend Lighting Power & Systems Electrical Details & Diagrams Electrical Schedules
	\frown		

THIS PROJECT WAS ORIGINALLY ISSUED ON AUGUST 26, 2022 AND BID ON OCTOBER 18, 2022. DUE TO THE FACT THAT THE ONLY BID RECEIVED WAS SIGNIFICANTLY OVER BUDGET, THE PROJECT SCOPE HAS BEEN CHANGED AND THE PROJECT IS BEING RE-ISSUED FOR RE-BIDDING. CHANGES MADE IN THE SCOPE FROM THE ORIGINAL ISSUE ARE CLOUDED & MARKED "DELTA 1"

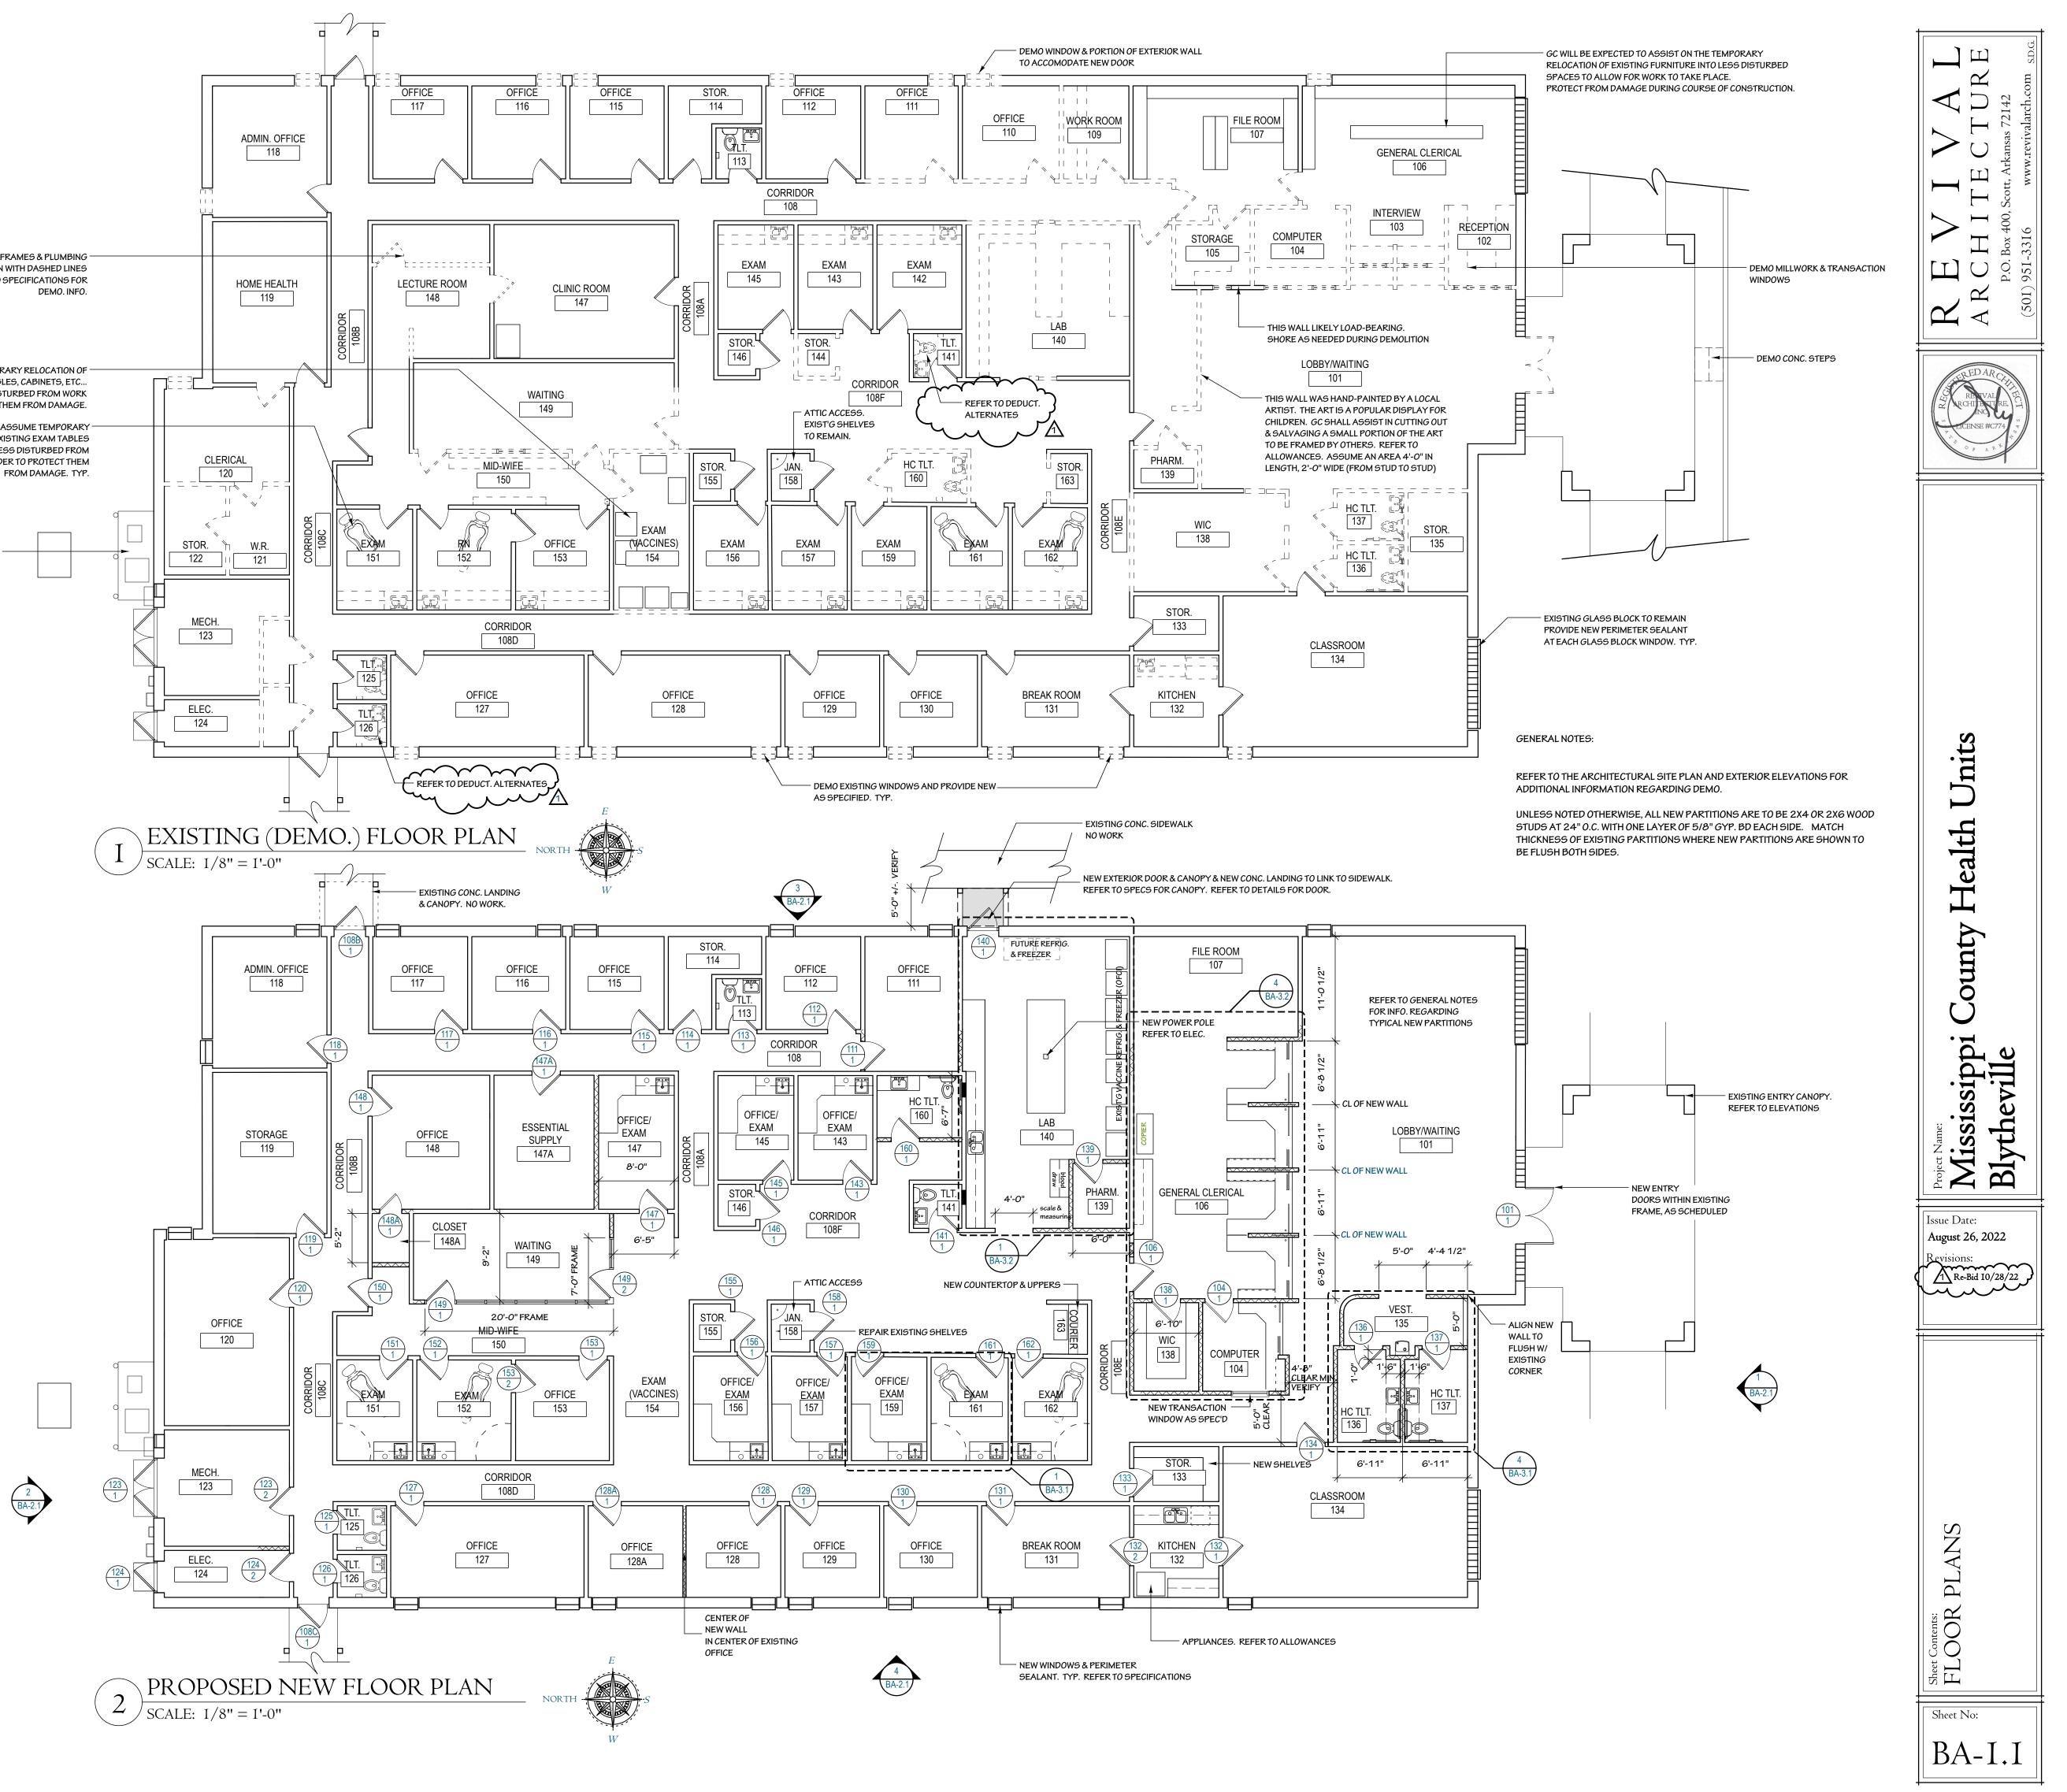

WALLS, DOORS, DOOR FRAMES & PLUMBING FIXTURES, MILLWORK SHOWN WITH DASHED LINES ARE TO BE DEMOLISHED. REFER TO SPECIFICATIONS FOR

> GC SHALL ASSUME TEMPORARY RELOCATION OF EXISTING FURNITURE, TABLES, CABINETS, ETC... INTO SPACES LESS DISTURBED FROM WORK IN ORDER TO PROTECT THEM FROM DAMAGE.

> > GC SHALL ASSUME TEMPORARY -RELOCATION OF EXISTING EXAM TABLES INTO SPACES LESS DISTURBED FROM WORK IN ORDER TO PROTECT THEM

REFER TO MECH. & ELEC. DRAWINGS FOR WORK RELATED TO OUTSIDE HVAC & GENERATOR

GENERAL NOTES:

1.) IN GENERAL, ALL EXISTING LIGHT FIXTURES ARE TO BE REMOVED AND REPLACED WITH NEW LED FIXTURES AS SCHEDULED (REFER TO ELECTRICAL) IN THEIR PRESENT LOCATION. WHERE ROOMS ARE BEING RECONFIGURED, SOME CEILING FINISH WORK WILL BE NECESSARY SO AS TO ALIGN NEW FIXTURES WITHIN NEW SPACE. THIS INCLUDES SOME NEW CONDUIT, BACK BOXES, GYP.BD. WORK, PATCHING AND RE-FINISHING.


CONTRACTOR SHALL STUDY AND COORDINATE THE WORK SHOWN BETWEEN ARCHITECTURAL AND ELECTRICAL DRAWINGS IN ORDER TO FULLY UNDERSTAND THE SCOPE OF WORK NECESSARY TO ACCOMPLISH INTENT.

- 2.) DEMO ANY EXISTING CEILING MOUNTED PRIVACY CURTAIN TRACKS IN EXAM ROOMS, IF PRESENT.
- 3.) SOME LIGHT FIXTURE LOCATIONS WILL CHANGE AS A RESULT OF MOVING OF PARTITIONS. CONTRACTOR SHALL DEMO BACK-BOXES AND PATCH SHEETROCK AND/OR INSTALL NEW BACK BOXES, NEW CONDUIT, AS NECESSARY, TO ACCOMMODATE. COORDINATE FINISH WORK WITH WORK SHOWN ON ELECTRICAL DRAWINGS.

LEGEND:

- NEW SURFACE MOUNTED FIXTURE (TYPE A) TO REPLACE EXISTING
- NEW SURFACE MOUNTED FIXTURE (TYPE A) IN NEW LOCATION. NOTE INTENTION TO ALIGN NEW FIXTURES WITH NEARBY EXISTING
- NEW WALL SCONCE (TYPE C) TO REPLACE EXISTING.
- NEW WALL SCONCE (TYPE D) IN NEW LOCATION.
- NEW PENDANT (TYPE E).
- \odot NEW PENDANT (TYPE F).
- NEW U/C LIGHT (TYPE G).



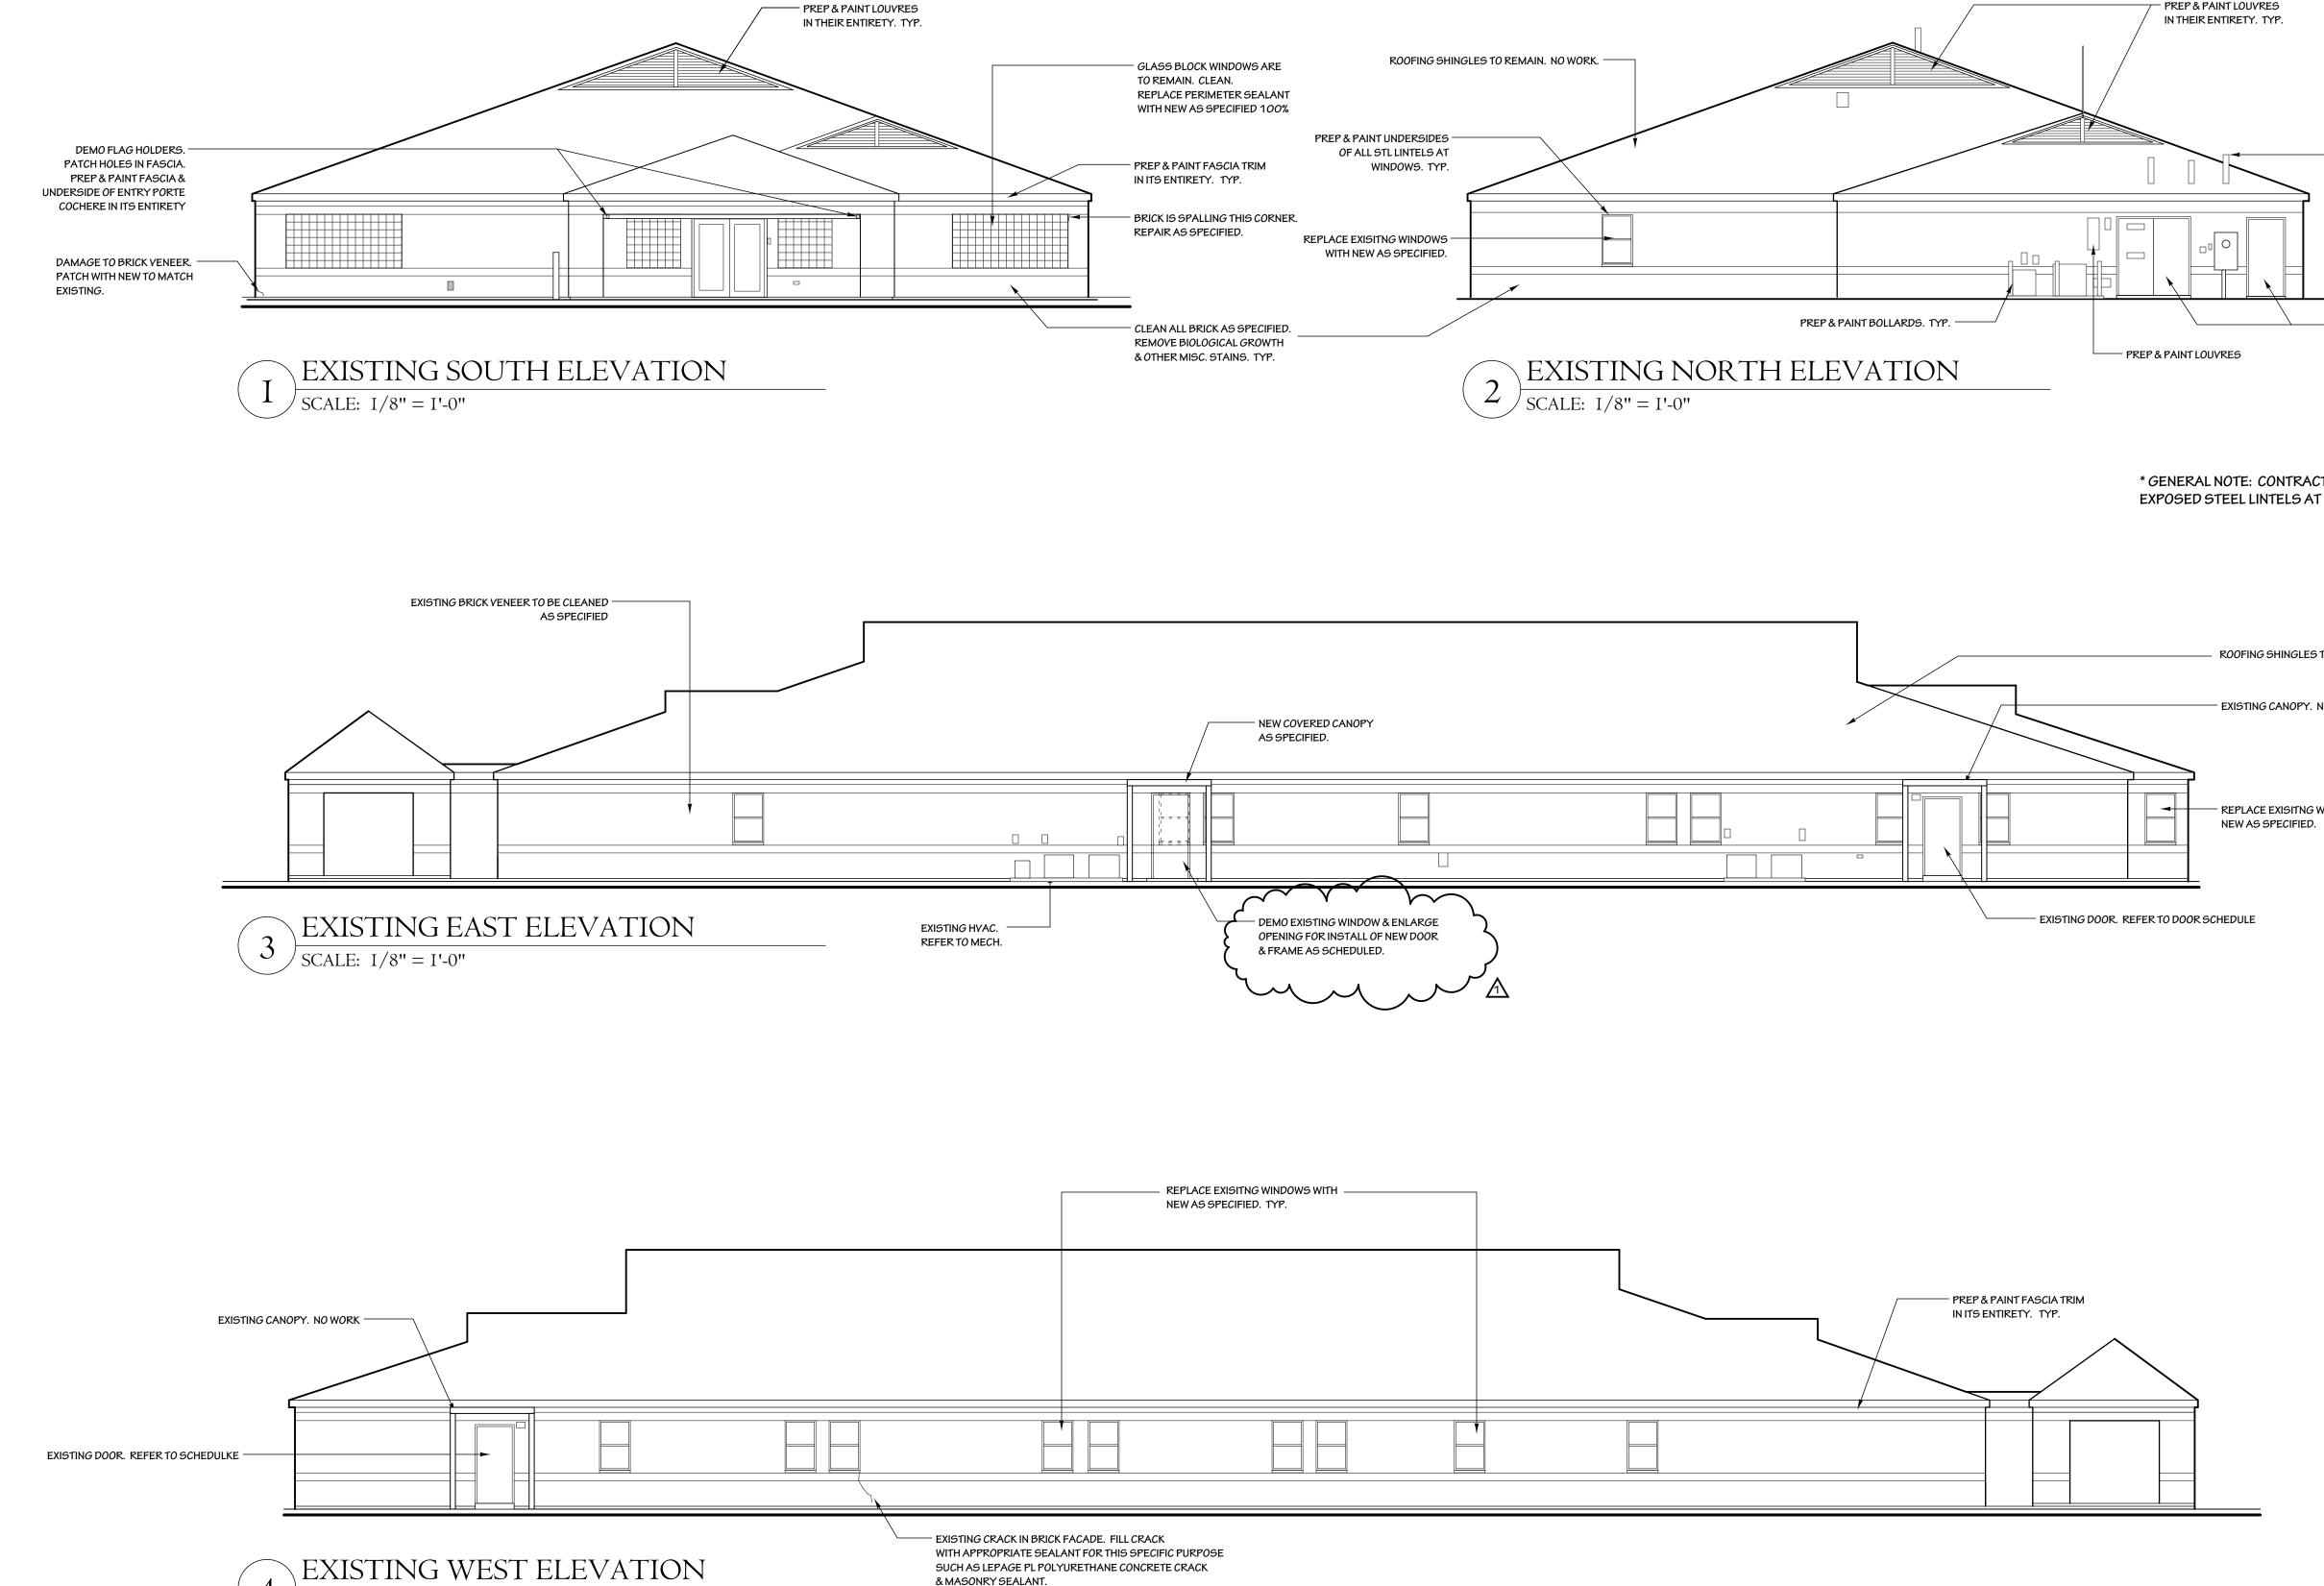

& MASONRY SEALANT.

COLOR TO BE SELECTED BY ARCHITECT

) SCALE: 1/8'' = 1'-0''

4

- PREP & PAINT LOUVRES

PENETRATIONS. REPLACE ANY DAMAGED

- CONTRACTOR INSPECT ALL ROOFTOP

SEALANT OR DEVICES

PREP & PAINT THESE REAR DOORS & FRAMES IN THEIR ENTIRETY. REPLACE LOCKS/KNOBS WITH NEW SIM. TO EXISTING.


* GENERAL NOTE: CONTRACTOR PREP & PAINT ALL EXPOSED STEEL LINTELS AT WINDOW & DOOR OPENINGS (TYP.)


ROOFING SHINGLES TO REMAIN. NO WORK.


- EXISTING CANOPY. NO WORK


- REPLACE EXISITNG WINDOWS WITH


Ц \mathbf{X} Ш \square Γ Q Т ЦU \mathbf{A} R A Inits Ď Health 5 ounty \bigcirc Mississippi (Blytheville Issue Date: August 26, 2022 Revisions: 1 Re-Bid 10/28/22 TONS \vdash \triangleleft ELE EXTERIOR EXTERIOR Sheet No: BA-2.1

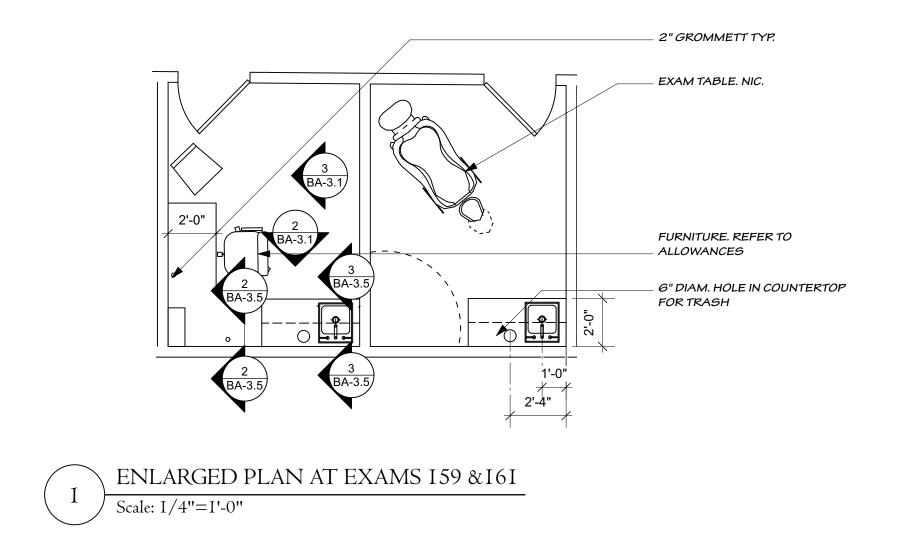

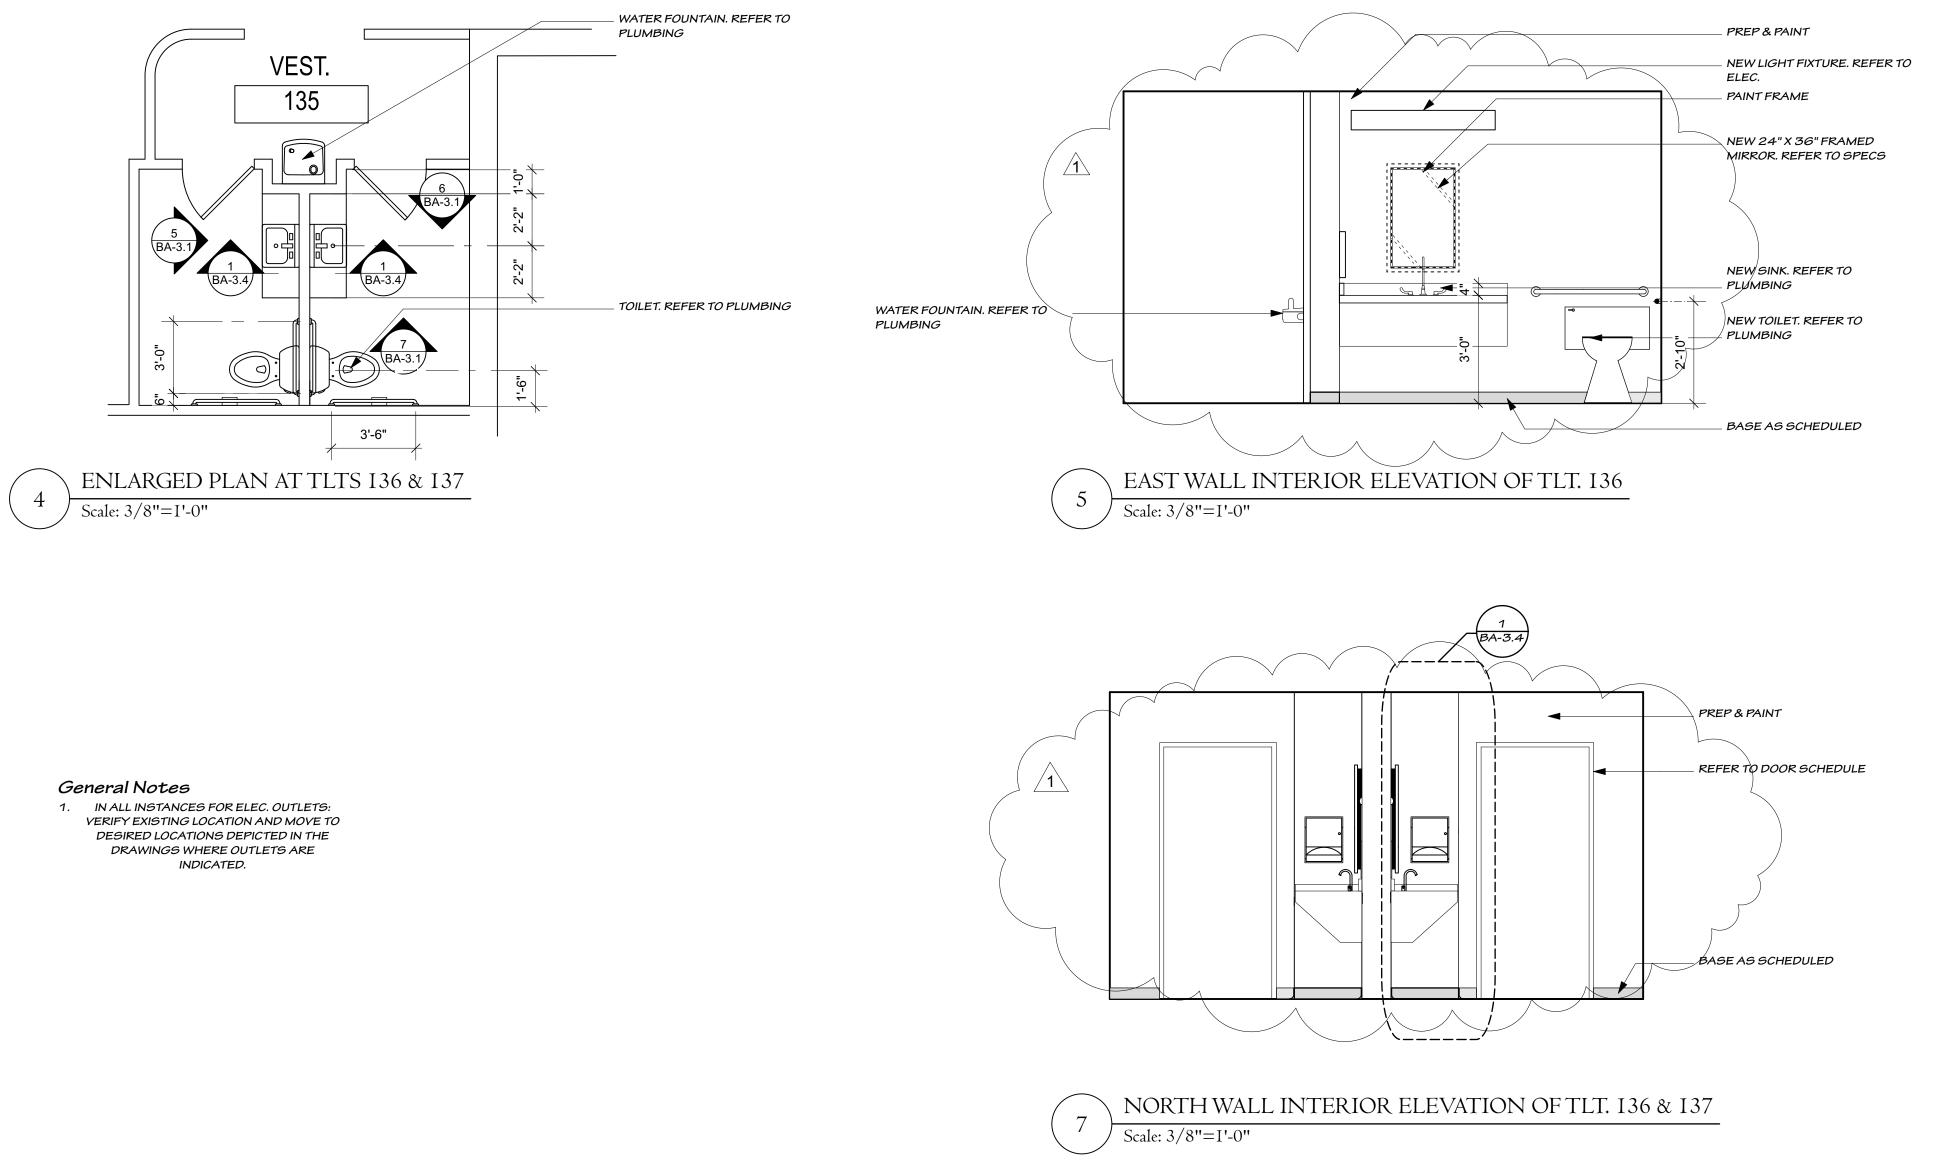

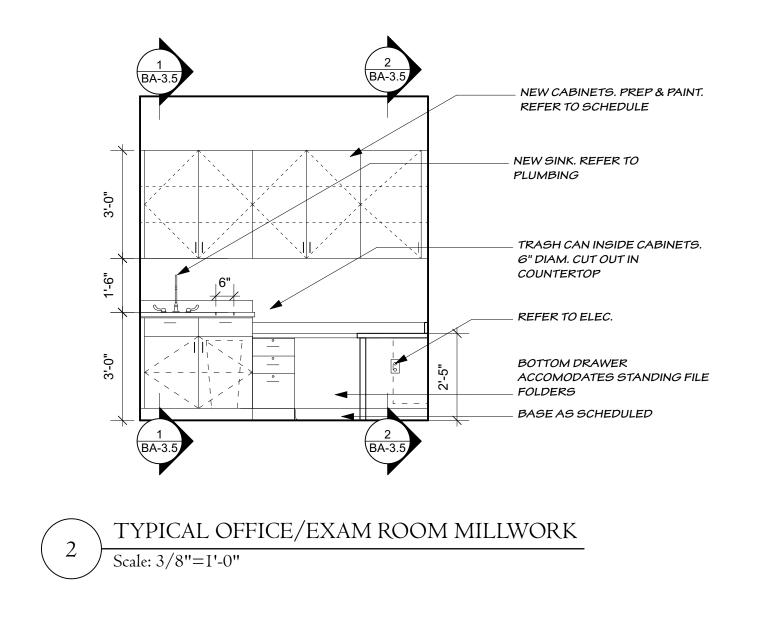

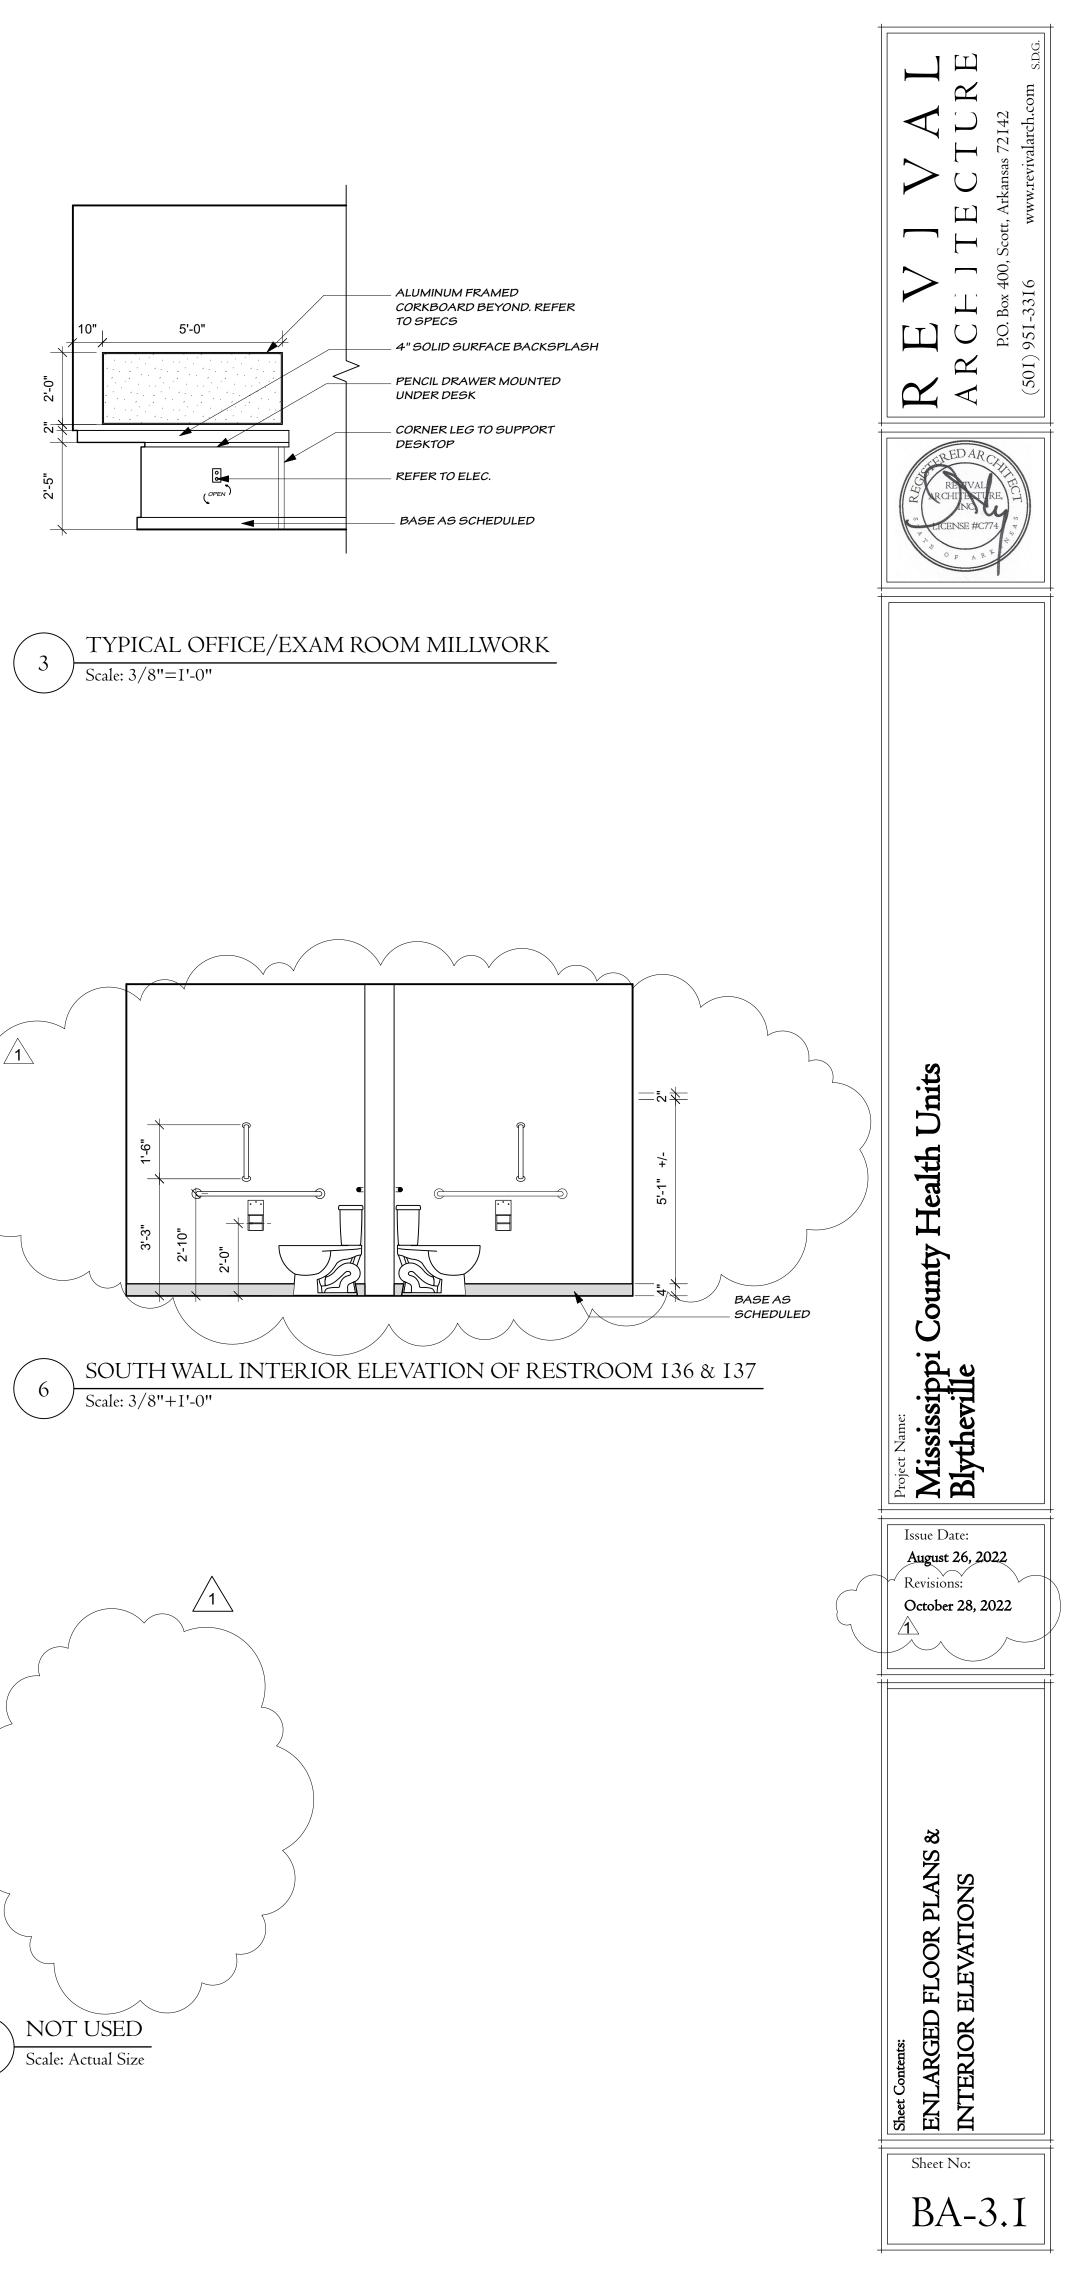

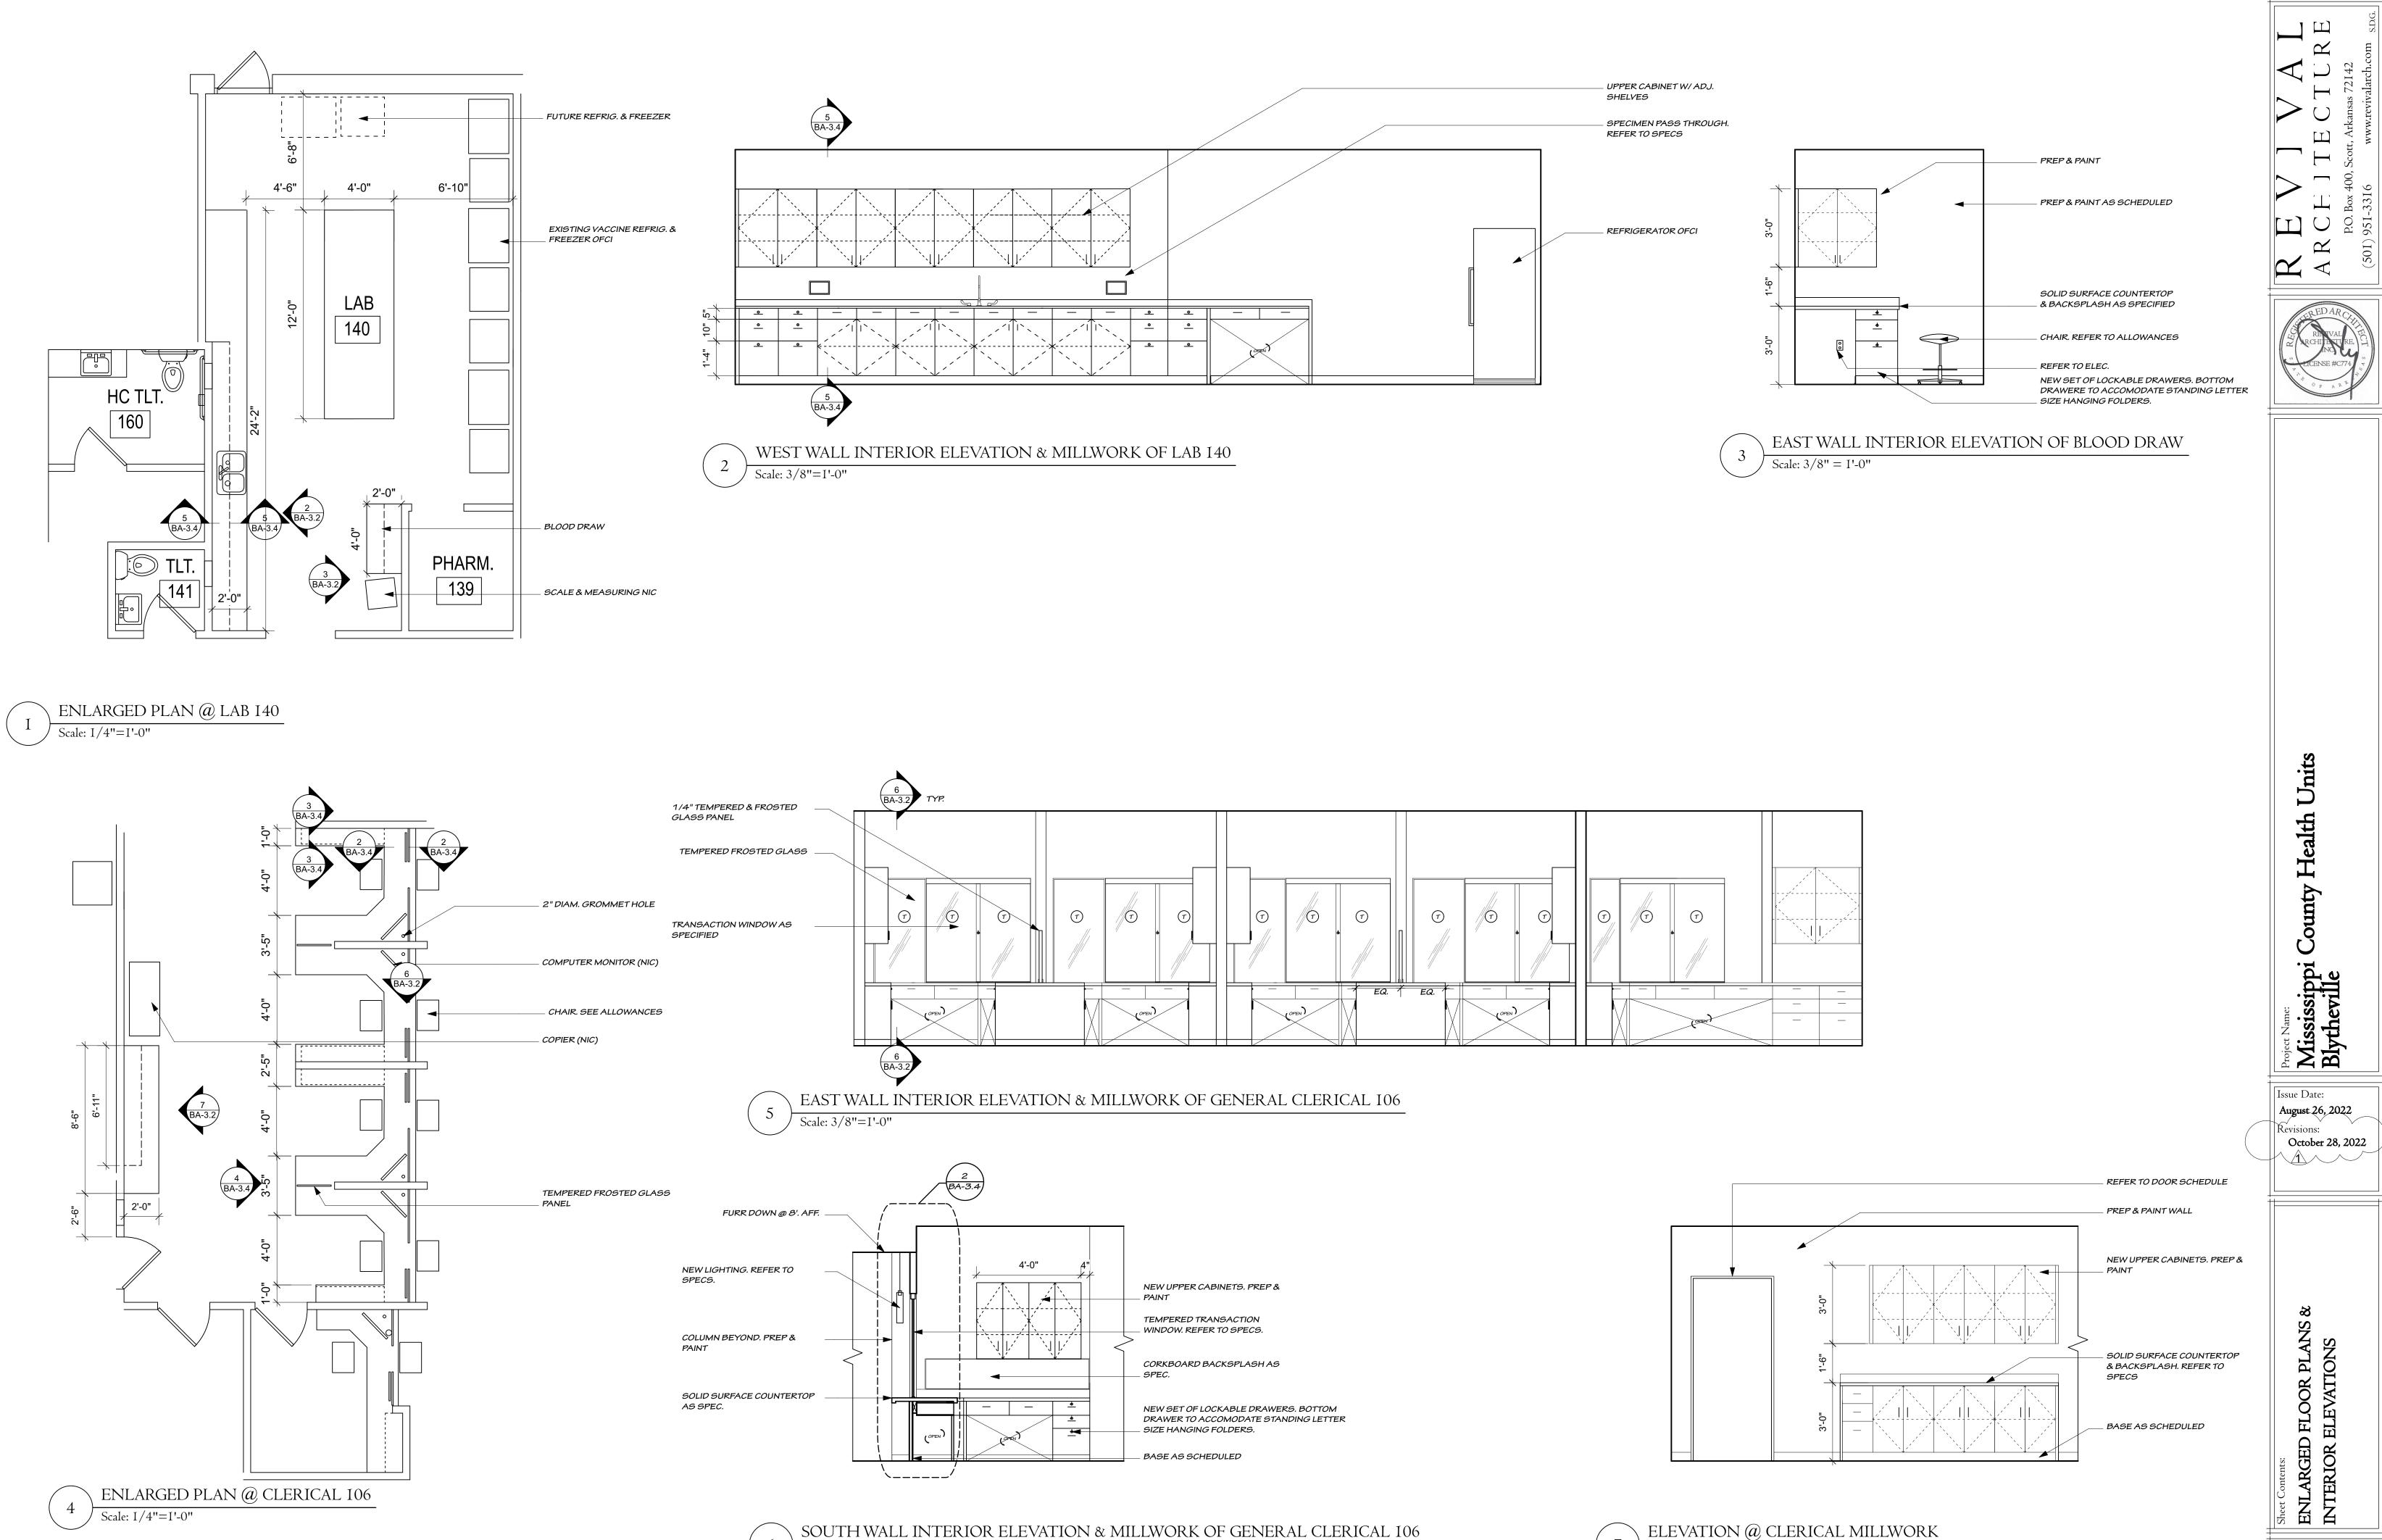


6


ELEVATION @ CLERICAL MILLWORK


Scale: 3/8" = I'-0"


Sheet No: BA-3.2

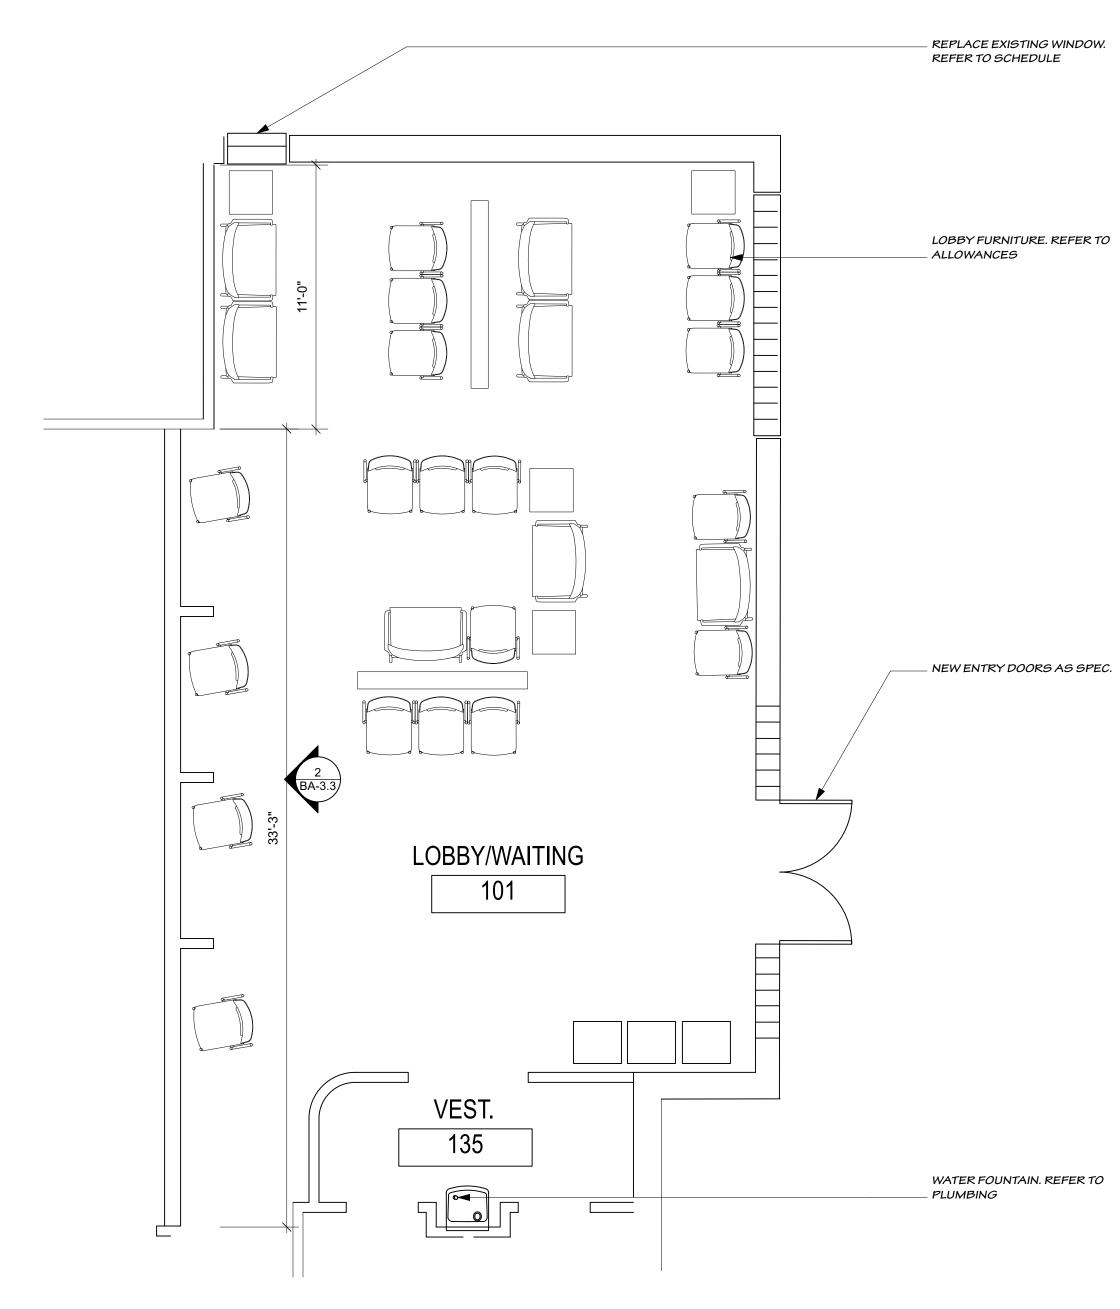



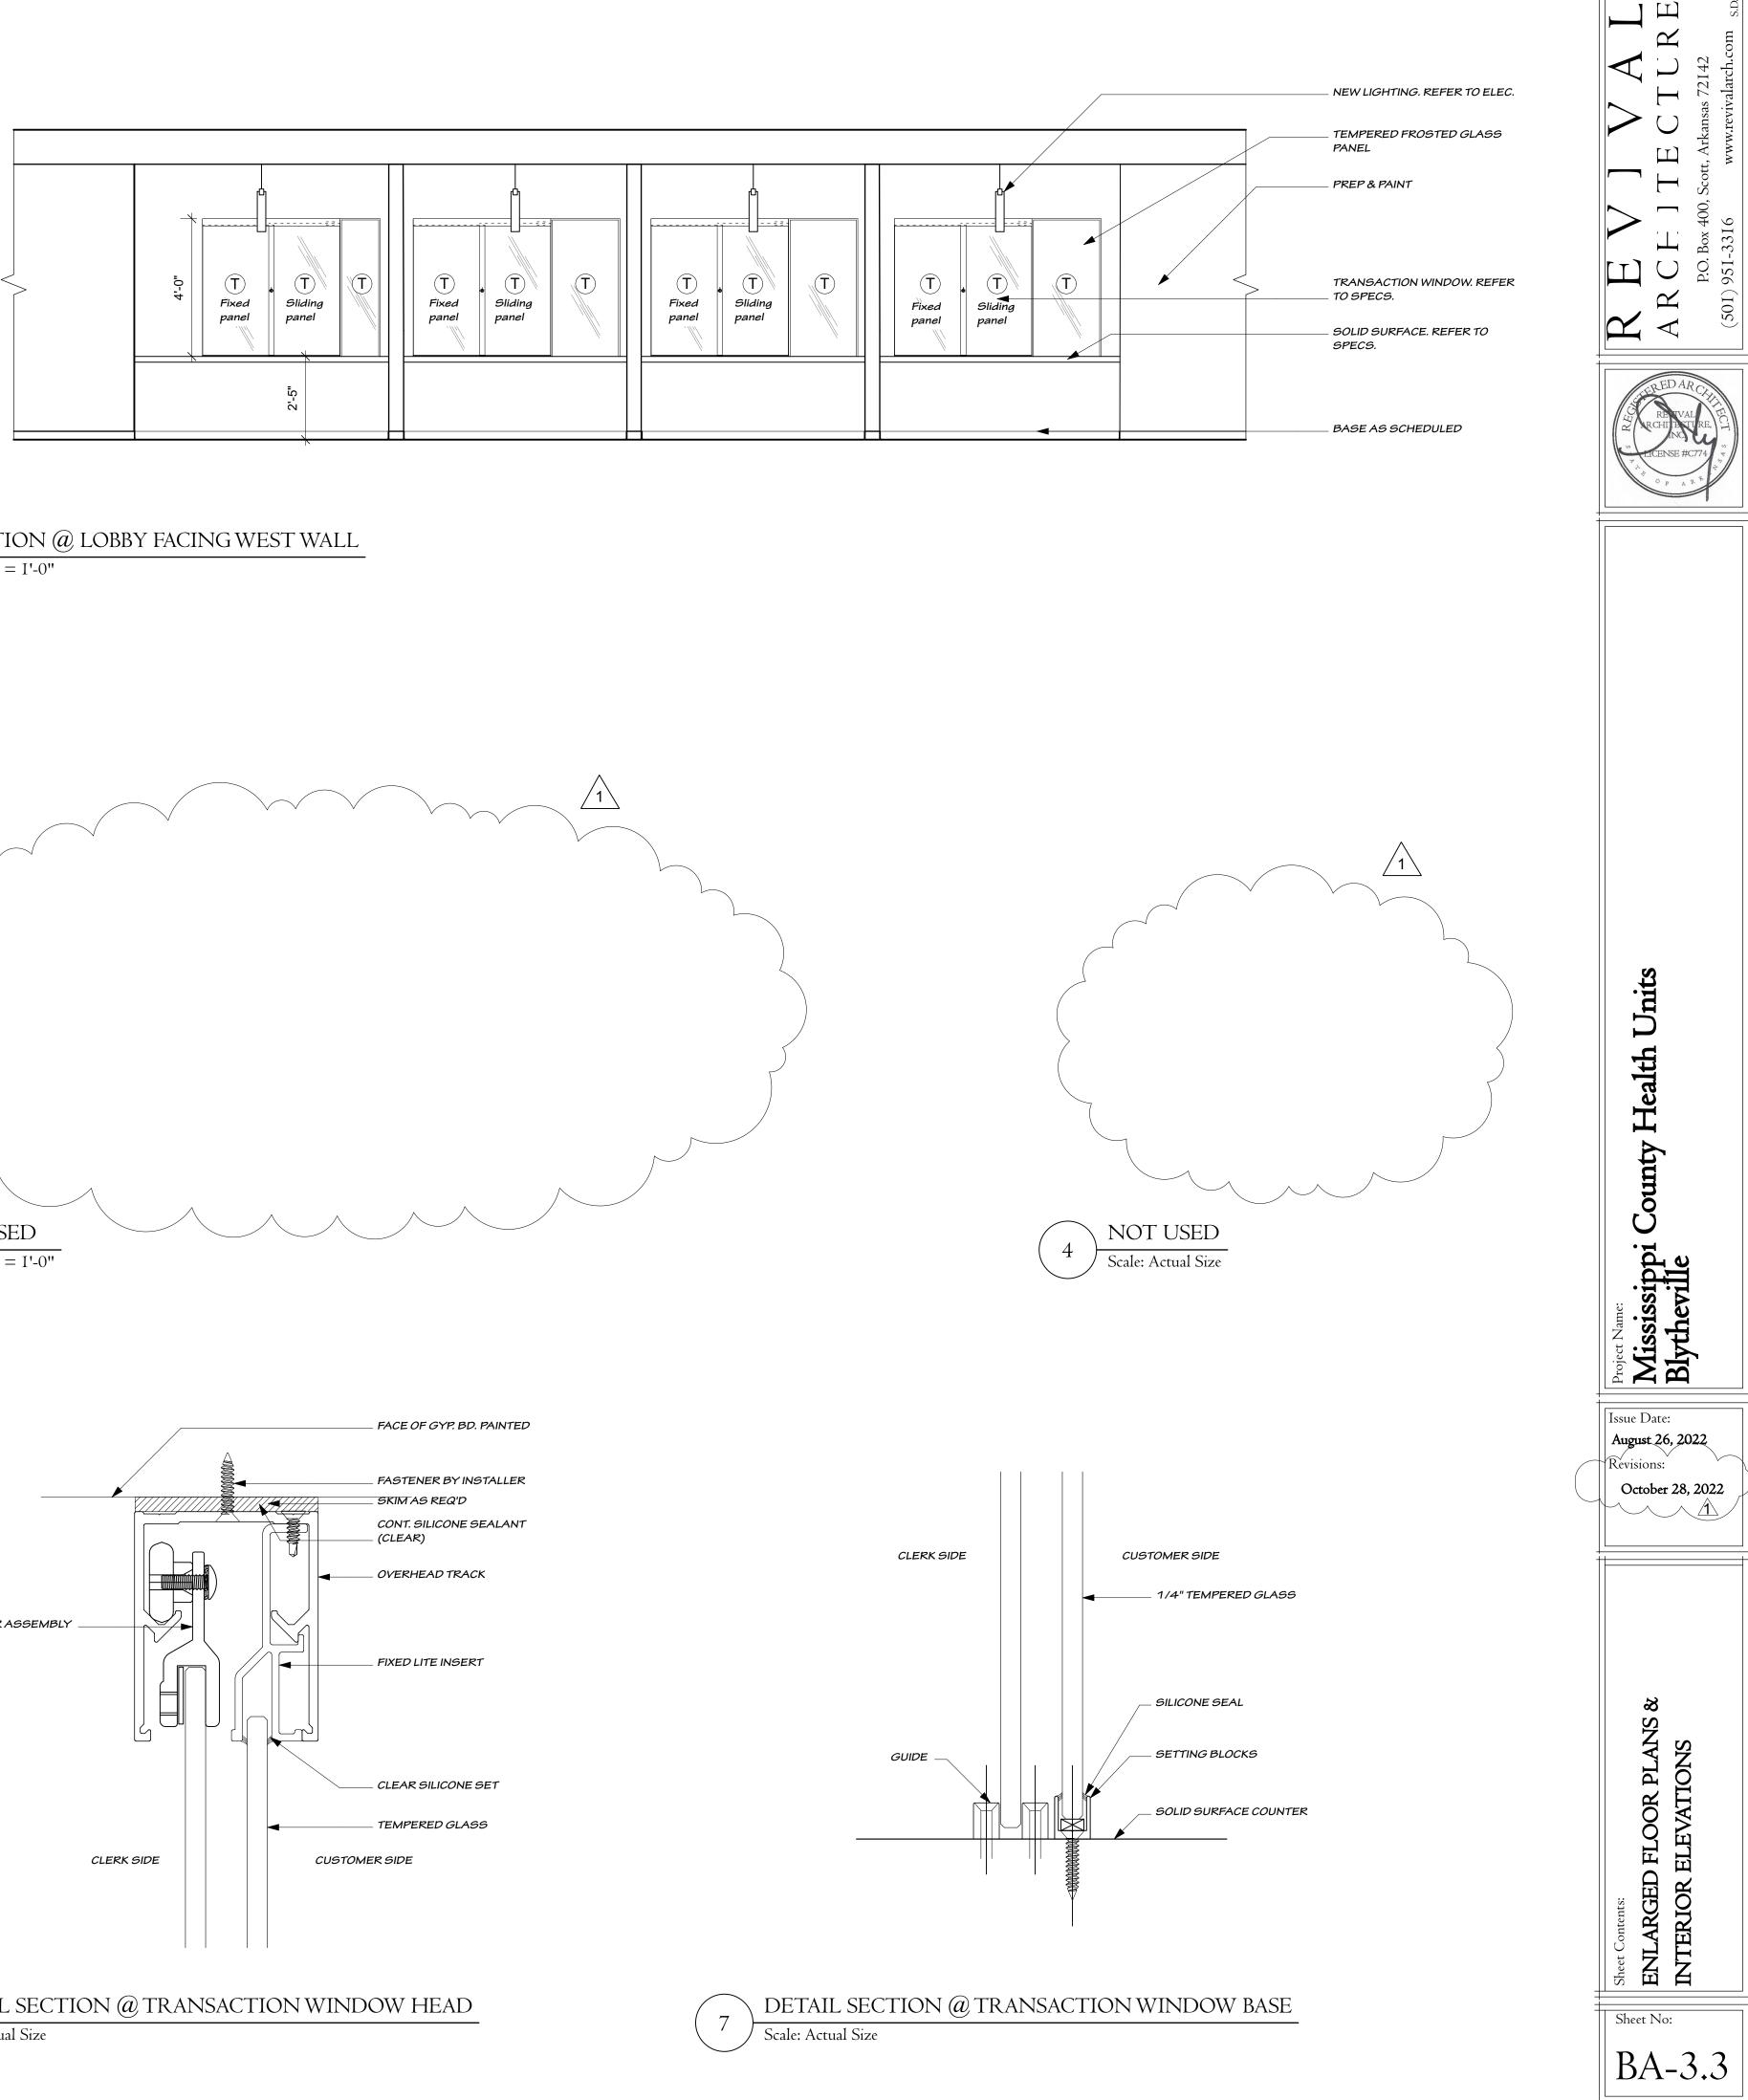


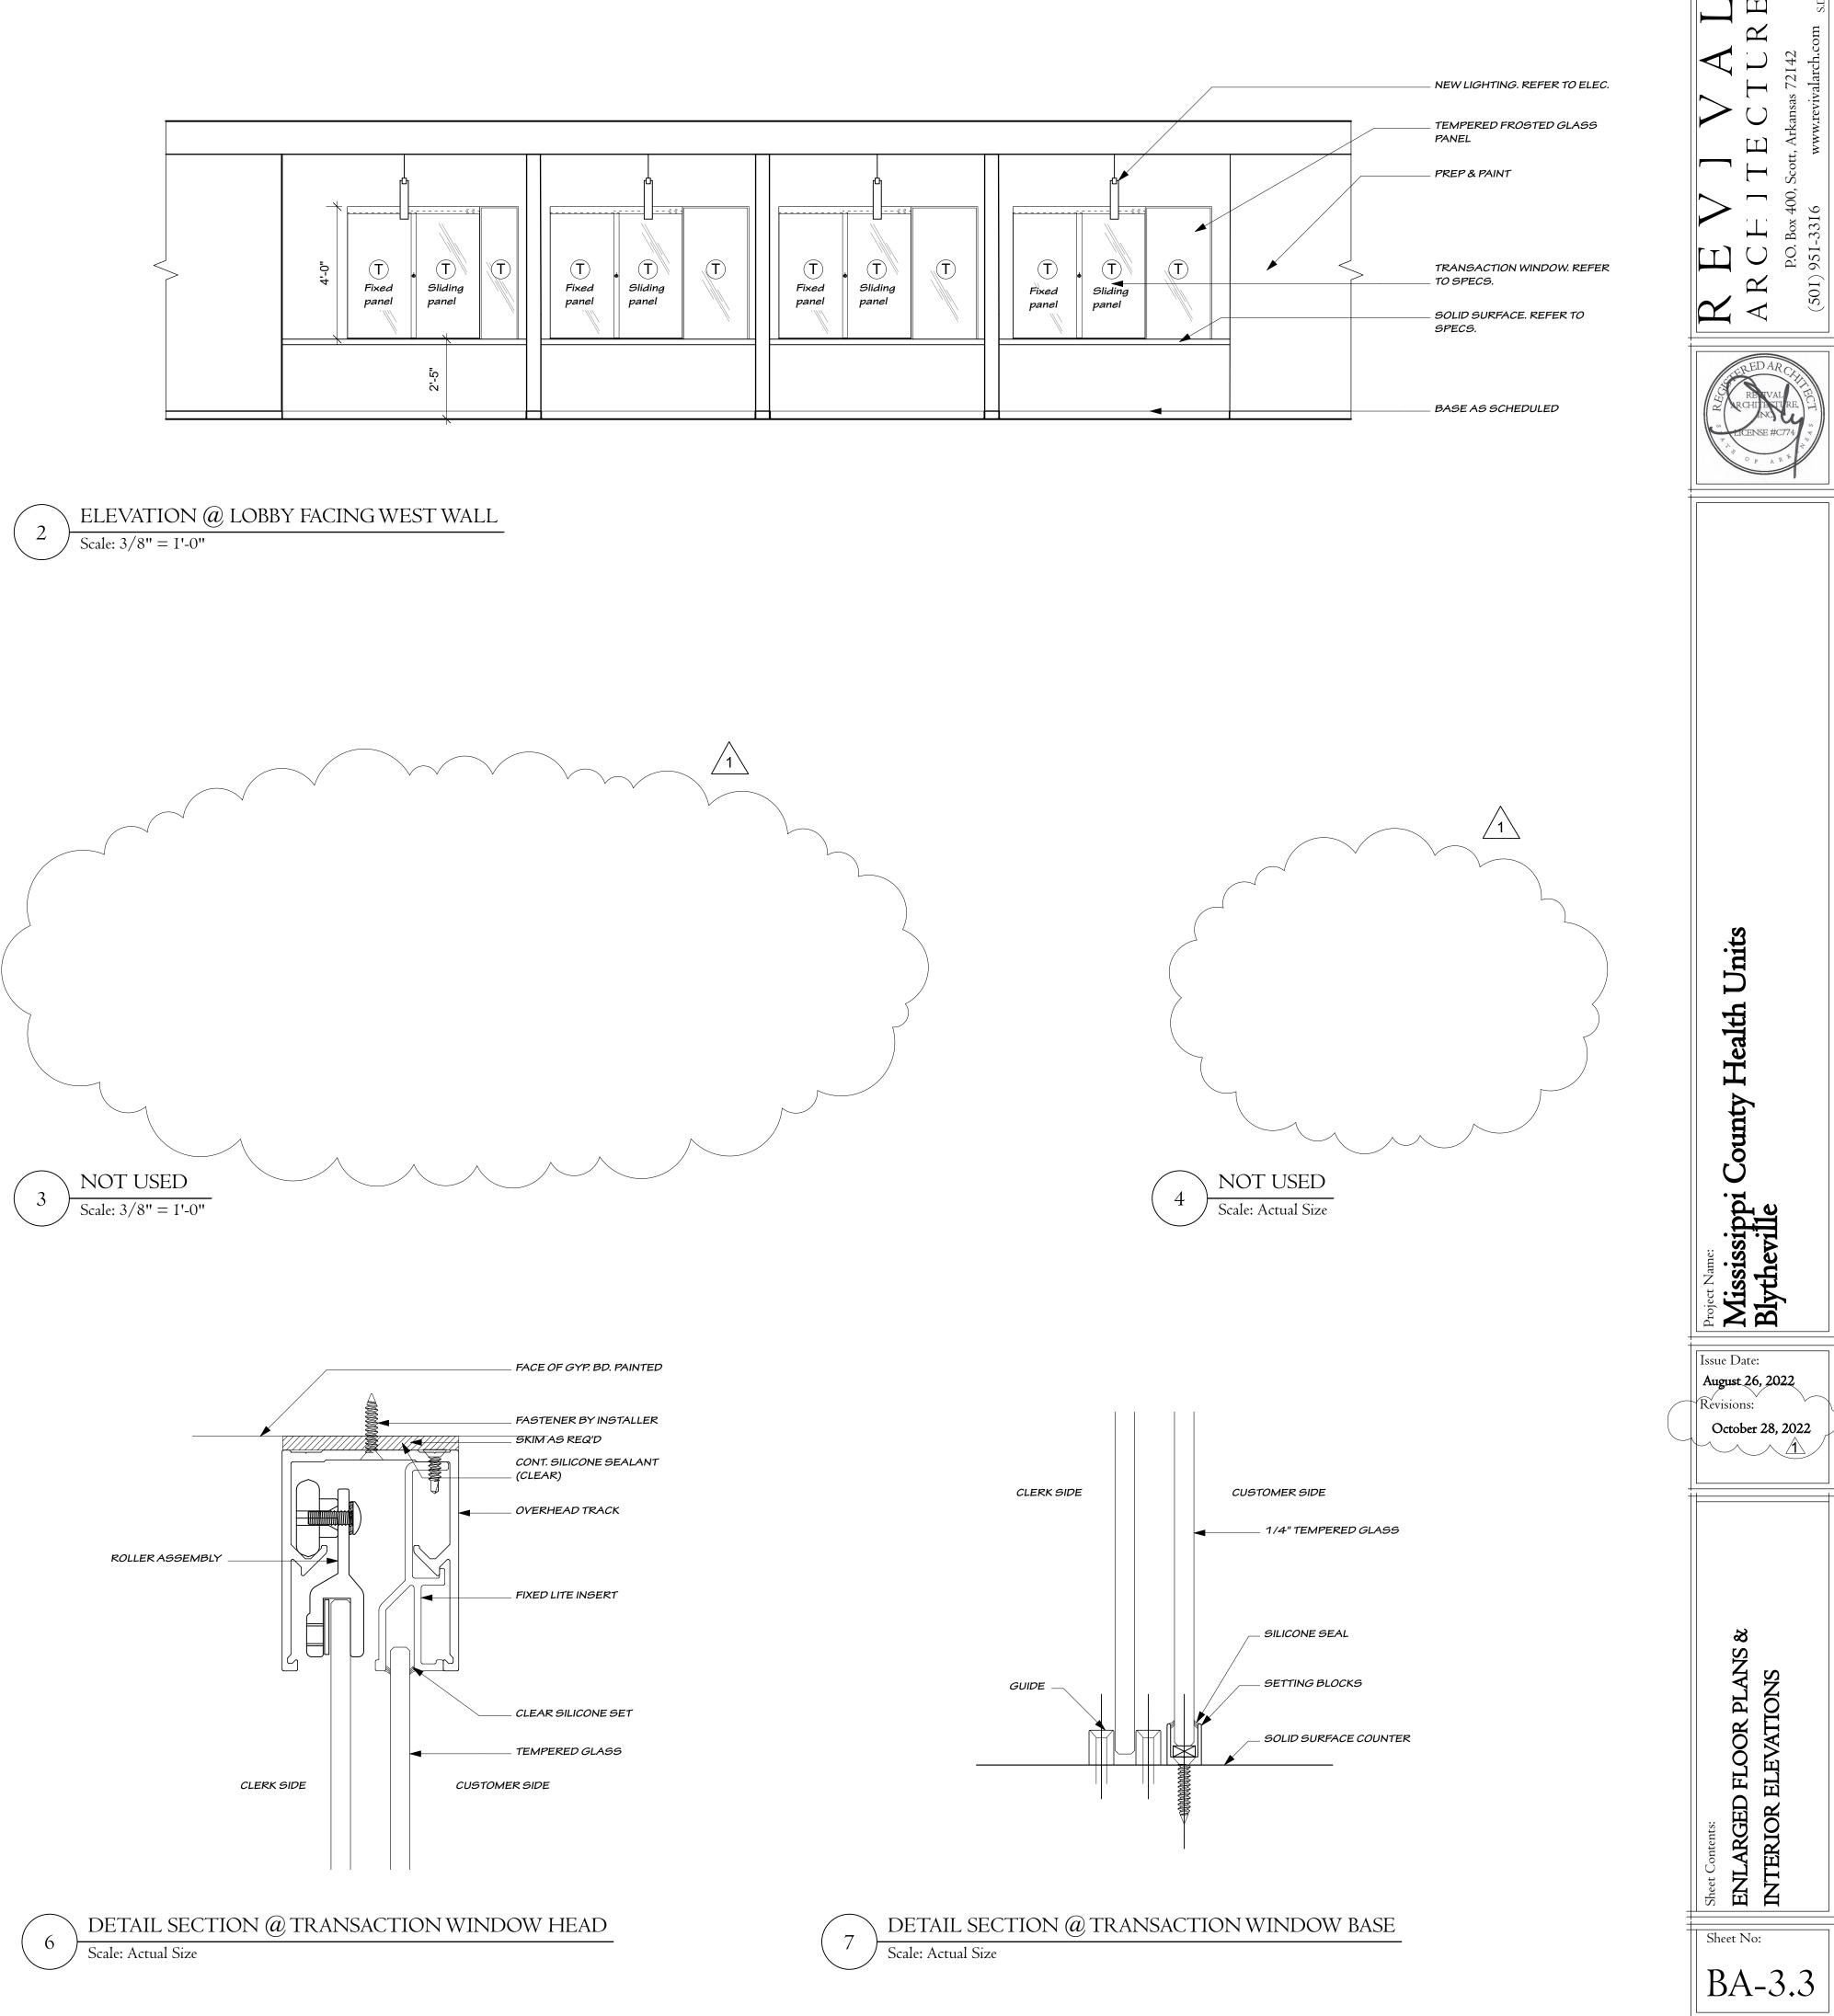


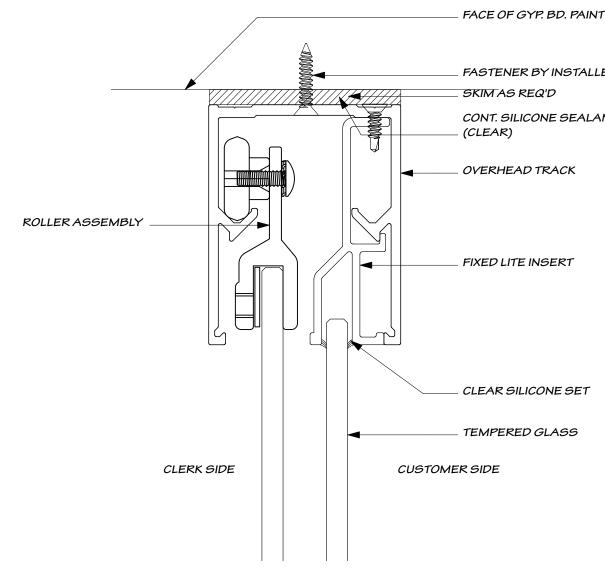






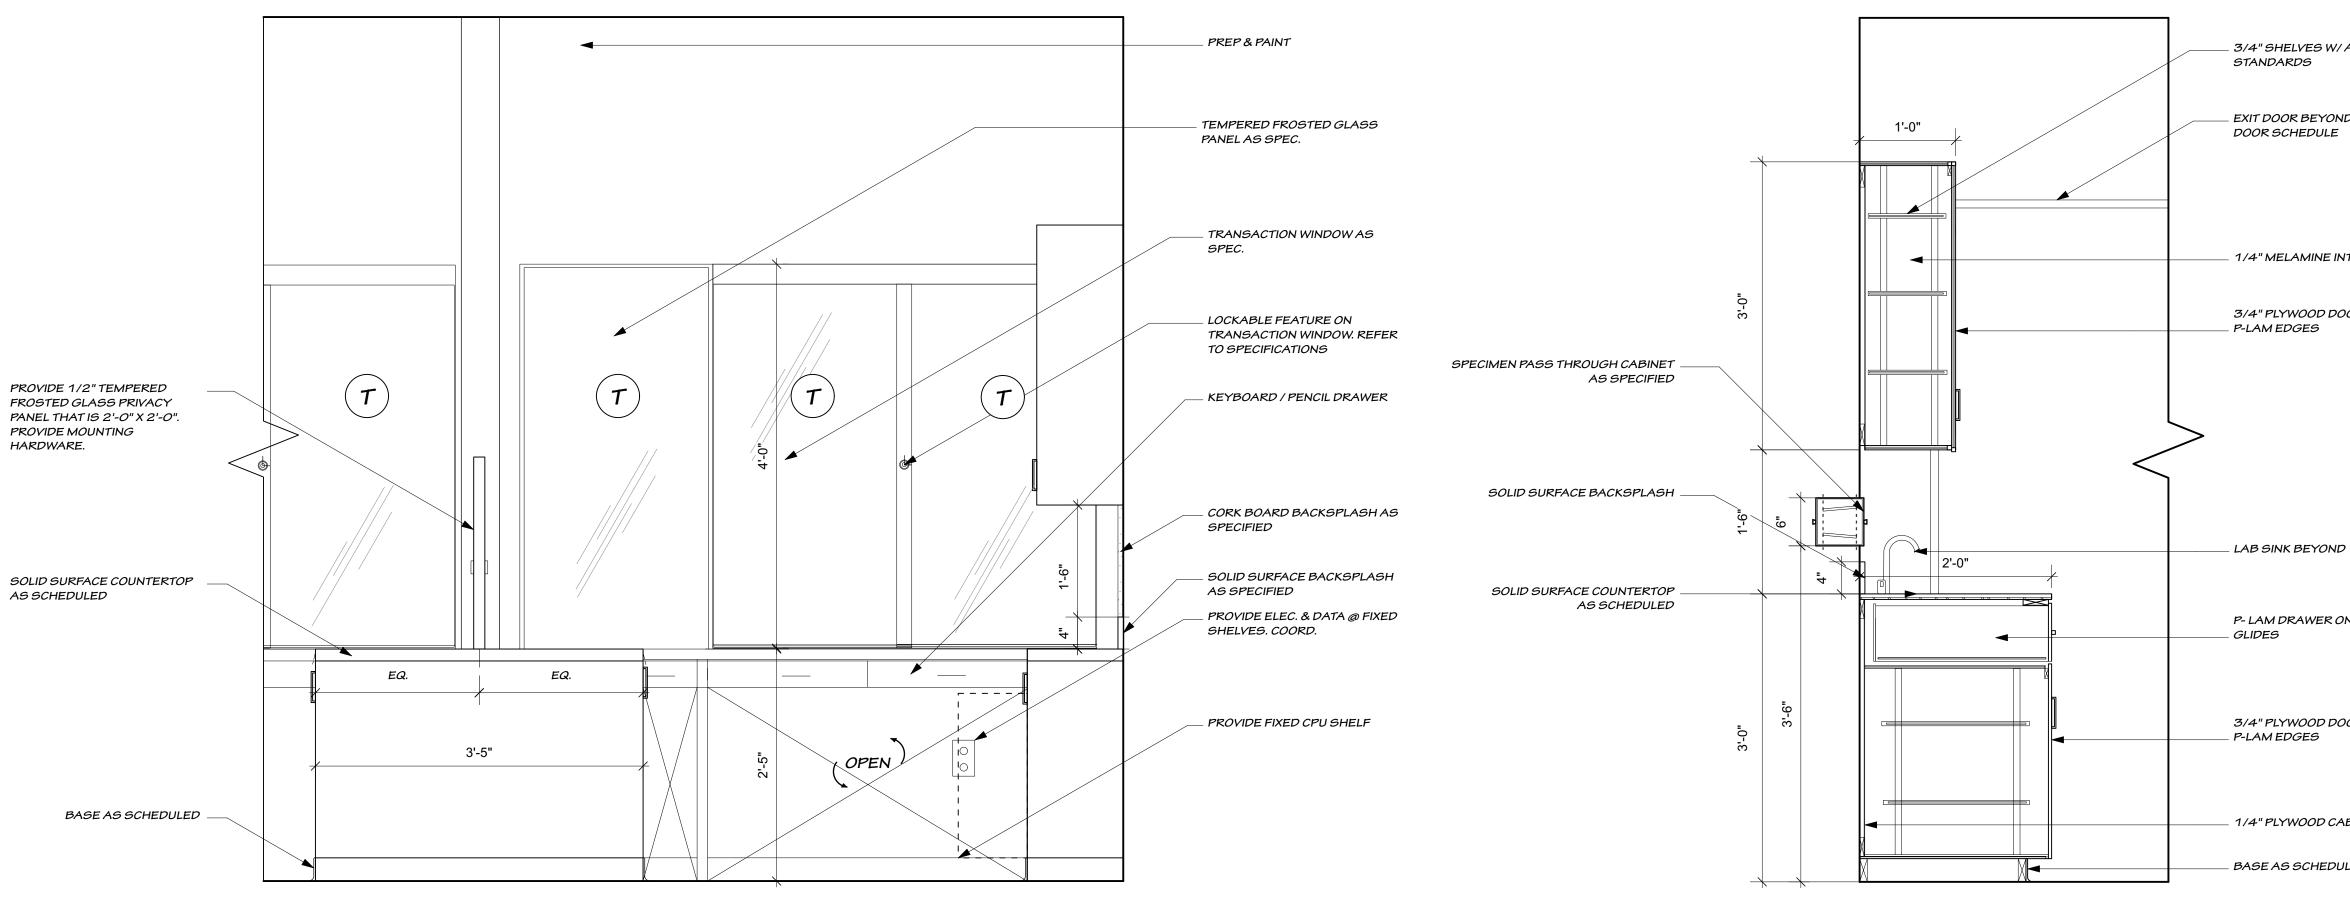


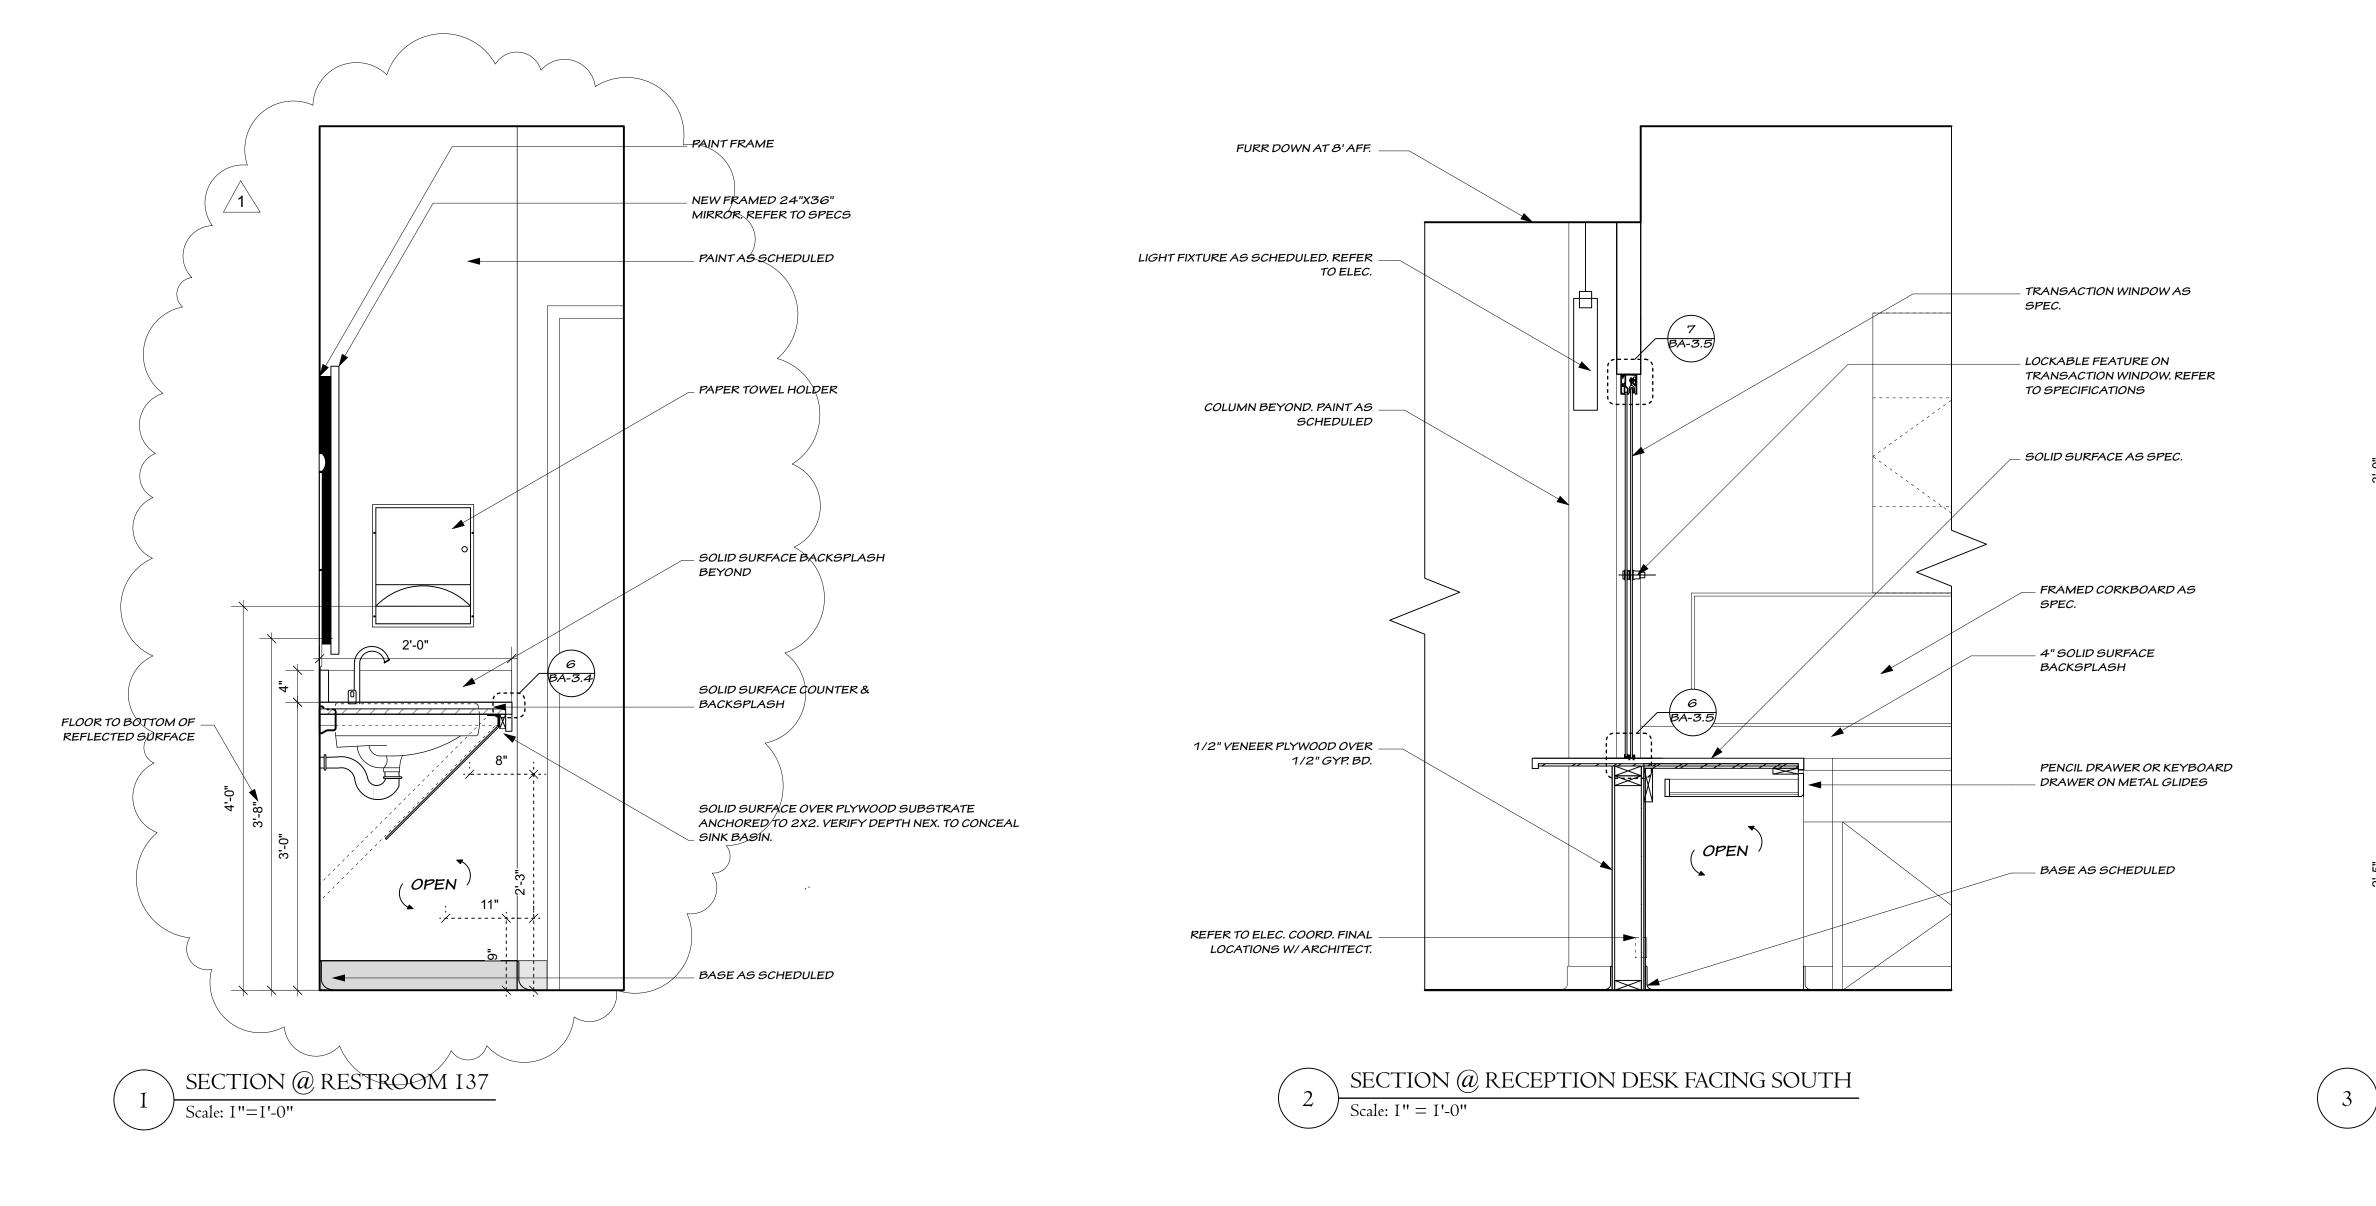

 \searrow SECTION @ LAB FACING NORTH

5 Scale: I'' = I'-0''

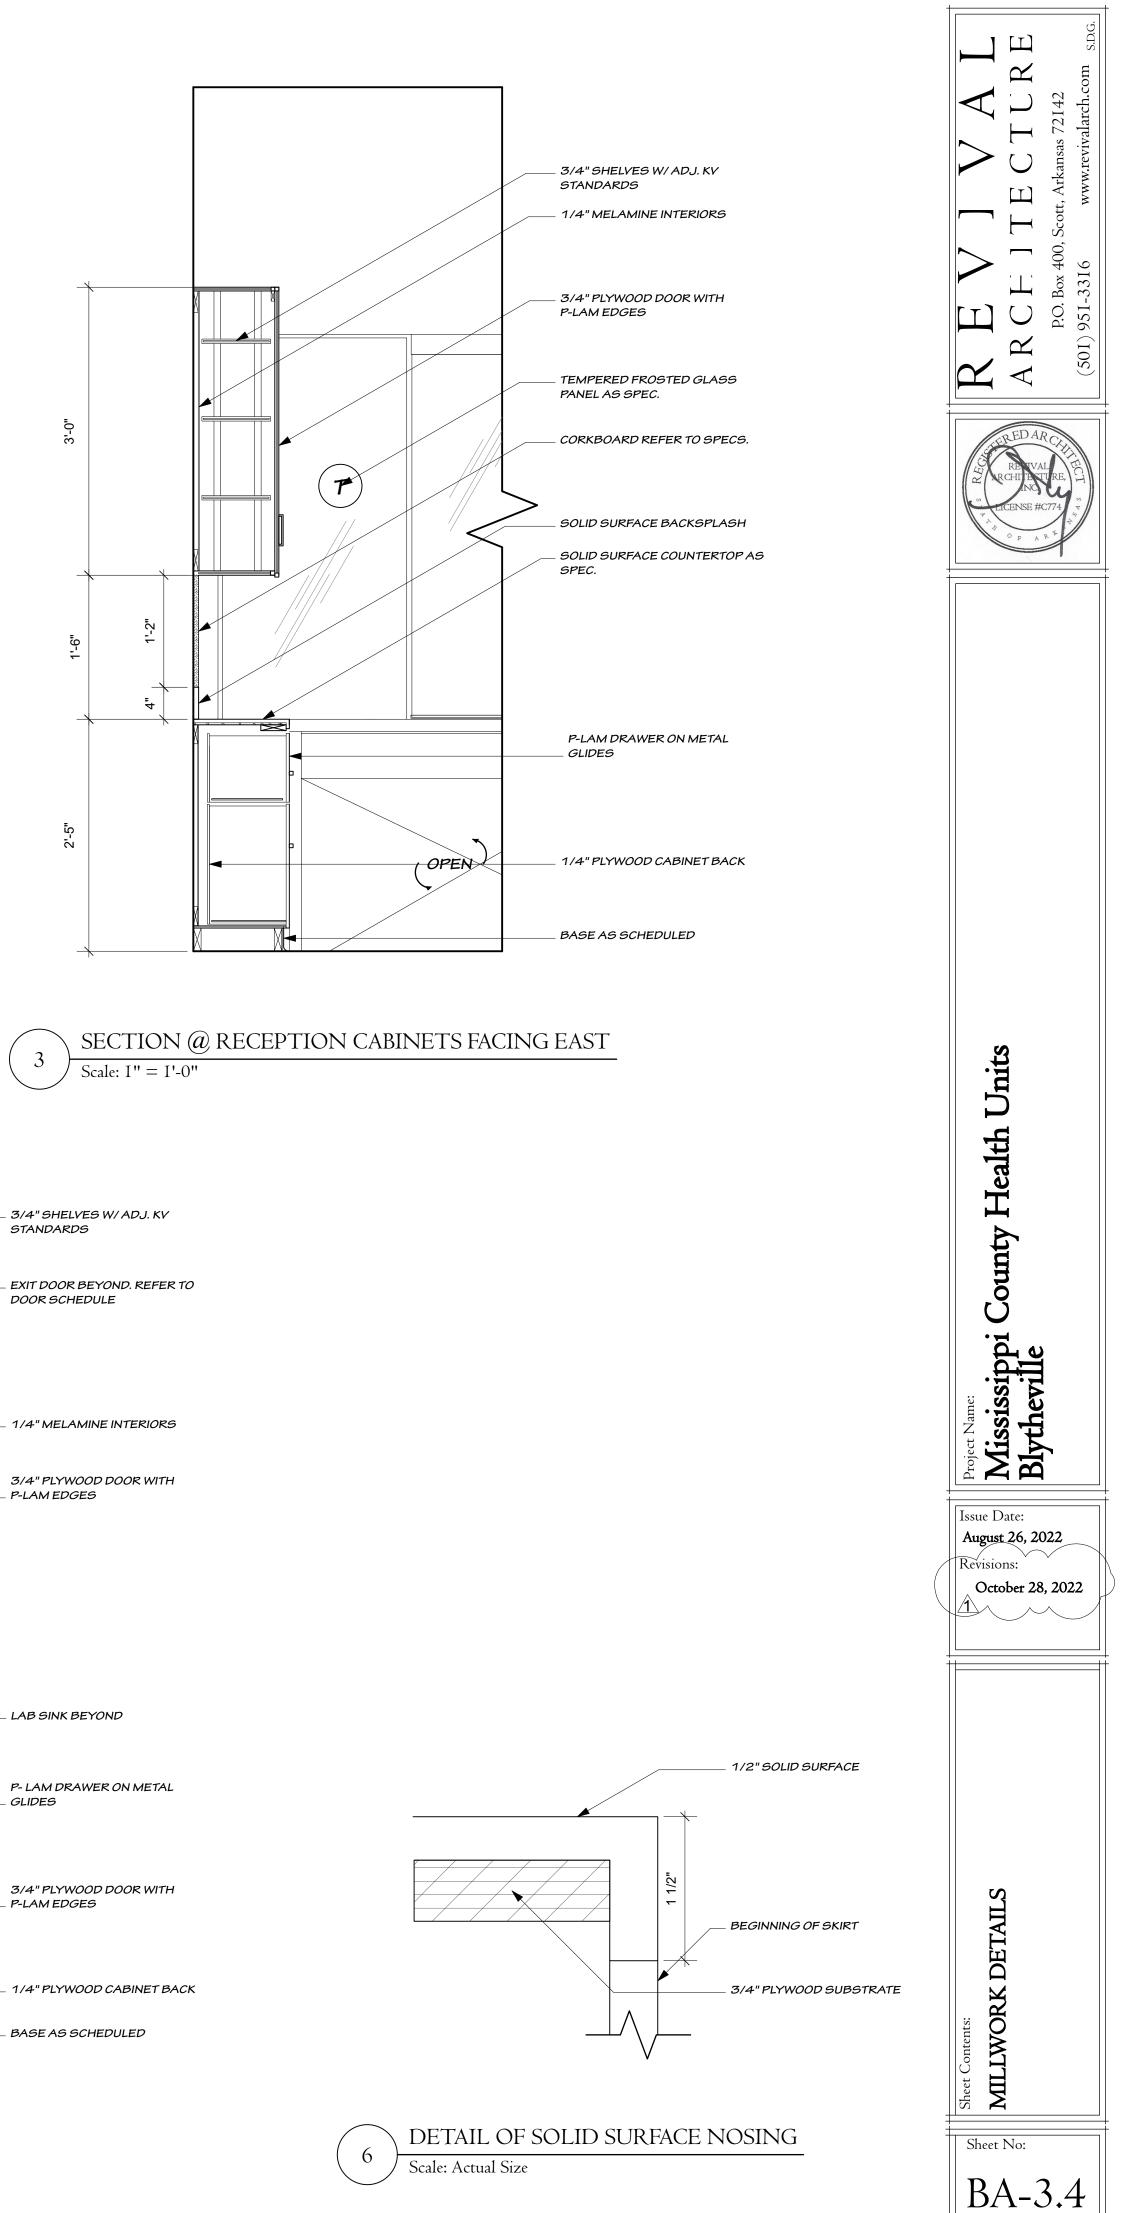

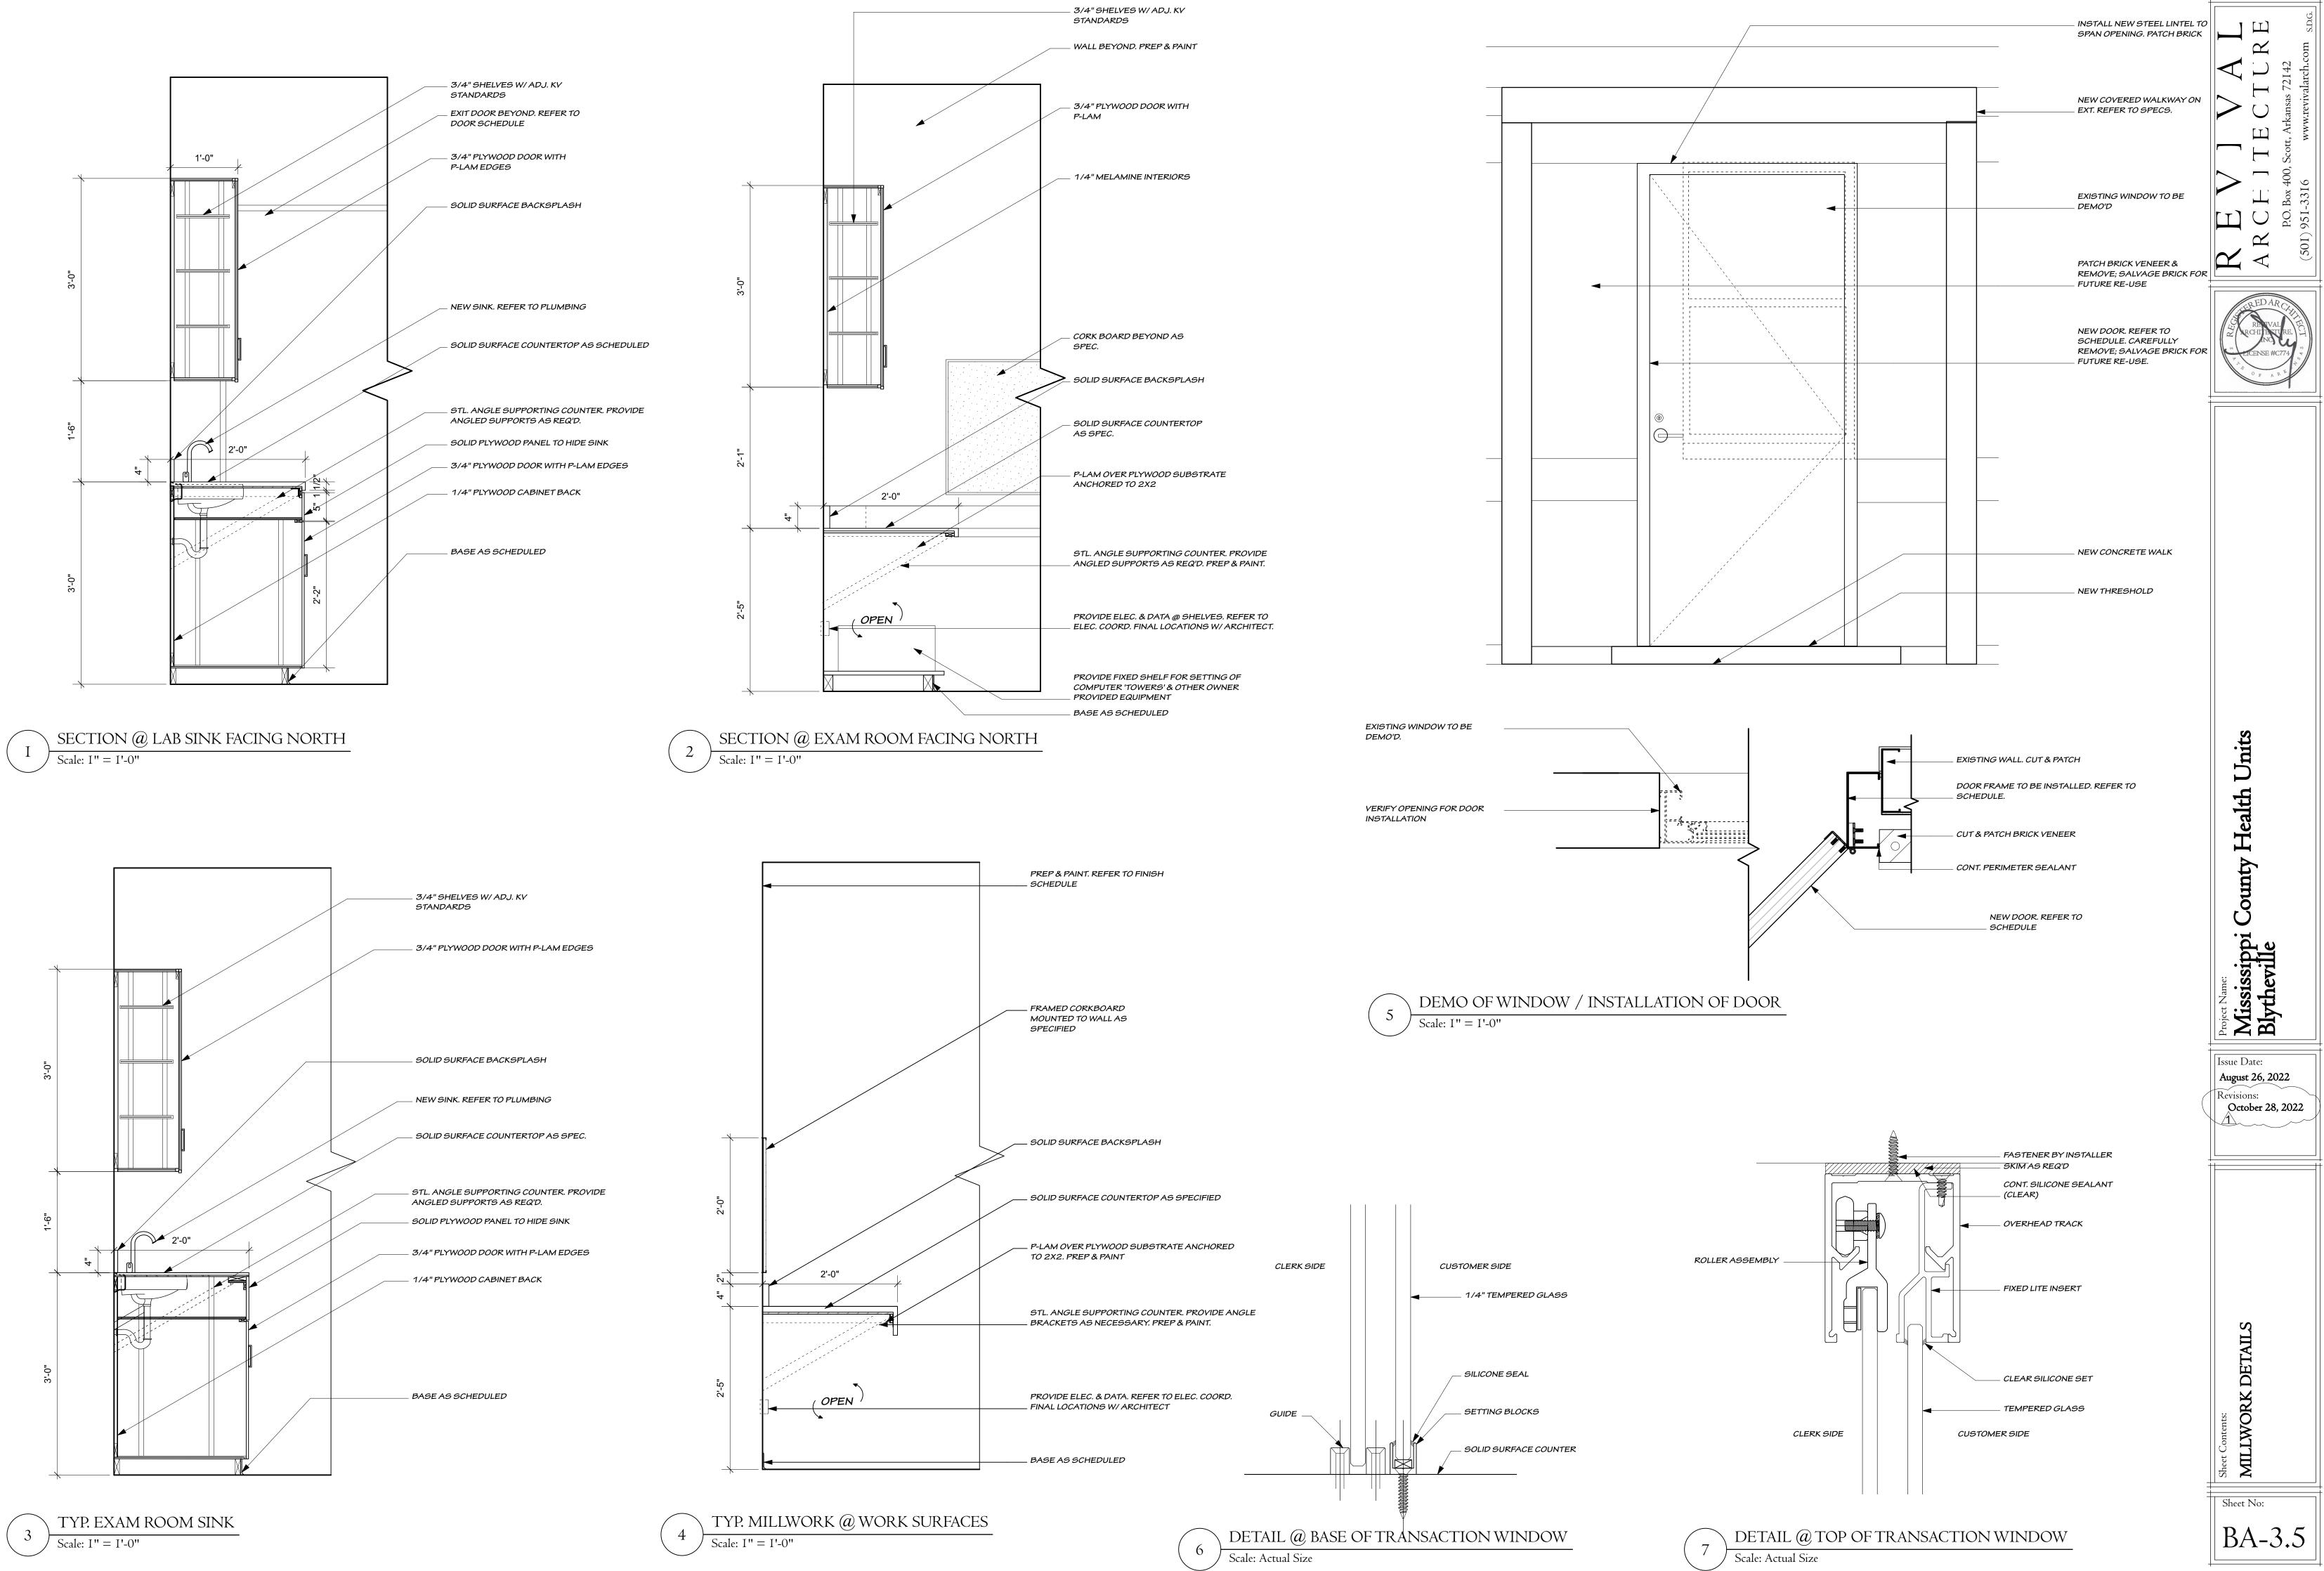



FI


FINISH SCHEDULE			DOOR SCHEDULE				VAL CTURE 1sas 72142
101LOBBY/WAITINGREFER TO CEILING PLAN102RECEPTIONREFER TO CEILING PLAN104COMPUTERREFER TO CEILING PLAN106ACHECK-OUTREFER TO CEILING PLAN	LOOR BASE WALLS LVT RUBBER PAINT LVT RUBBER PAINT LVT RUBBER PAINT LVT RUBBER PAINT LVT RUBBER PAINT	NOTES 5 REFER TO INT. ELEVATIONS. REFER TO FLOOR PLAN. ACCENT PAINT COLOR REFER TO INT. ELEVATIONS.	DOOR NUMBERDOOR LOCATION & TYPE LOCATIONDOOR101/1LOBBY/WAITING 101N104/1COMPUTER 104N106/1GENERAL CLERICAL 106N108B/1CORRIDOR 108BE108C/1CORDIDOR 108CF	R DOOR ELEVATION SIZE (WIDTH X HEIGHT) CONSTRUCTION A PAIR 3'-0" X 7'-0" AL E 3'-0" X 7'-0" HM E 3'-0" X 7'-0" SCW OK OK OK	E REFER TO EXISTING N HM E REFER TO EXISTING E REFER TO EXISTING	DWARE NOTES 1 COORD. DOOR & HARDWARE 3 5 2 PROVIDE PEEP HOLE & THRESHOLD SWEEPS. 3 DROVIDE DEEP HOLE & THRESHOLD SWEEPS.	7] T] T E C 00, Scott, Arkar
106GENERAL CLERICALREFER TO CEILING PLAN107FILE ROOMREFER TO CEILING PLAN108CORRIDORREFER TO CEILING PLAN108BCORRIDORREFER TO CEILING PLAN108CCORRIDORREFER TO CEILING PLAN108DCORRIDORREFER TO CEILING PLAN	LVT RUBBER PAINT LVT RUBBER PAINT LVT RUBBER PAINT LVT RUBBER PAINT LVT RUBBER PAINT	REFER TO INT. ELEVATIONS.	108C/1 CORRIDOR 108C E 111/1 OFFICE 111 N 112/1 OFFICE 112 N 113/1 TOILET 113 N 114/1 STORAGE 114 N 115/1 OFFICE 115 N	E 3'-0" X 7'-0" SCW D 3'-0" X 7'-0" SCW D 3'-0" X 7'-0" SCW D VERIFY SCW D 3'-0" X 7'-0" SCW D 3'-0" X 7'-0" SCW D 3'-0" X 7'-0" SCW	E REFER TO EXISTING N HM E REFER TO EXISTING	2 PROVIDE PEEP HOLE & THRESHOLD SWEEPS. 3	C F P.O. Box 40
100DCORRIDORREFER TO CEILING PLAN108ECORRIDORREFER TO CEILING PLAN108FCORRIDORREFER TO CEILING PLAN111OFFICEREFER TO CEILING PLAN112OFFICEREFER TO CEILING PLAN113TOILETREFER TO CEILING PLAN	LVT RUBBER PAINT LVT RUBBER PAINT LVT RUBBER PAINT LVT RUBBER PAINT LVT RUBBER PAINT LVT RUBBER PAINT	5. REFER TO INT. ELEVATIONS. 5. REFER TO INT. ELEVATIONS. REFER TO INT. ELEVATIONS.	115/1 OFFICE 115 N 116/1 OFFICE 116 N 117/1 OFFICE 117 N 118/1 ADMIN. OFFICE 118 N 119/1 STORAGE 119 N 120/1 OFFICE 120 N	D 3'-0" X 7'-0" SCW E 3'-0" X 7'-0" SCW	E REFER TO EXISTING E REFER TO EXISTING E REFER TO EXISTING E REFER TO EXISTING E REFER TO EXISTING	3 3 3 3 3 3 3	X Y Y
114 STORAGE REFER TO CEILING PLAN 115 OFFICE REFER TO CEILING PLAN 116 OFFICE REFER TO CEILING PLAN 117 OFFICE REFER TO CEILING PLAN 118 ADMIN. OFFICE REFER TO CEILING PLAN	LVT RUBBER PAINT LVT RUBBER PAINT LVT RUBBER PAINT LVT RUBBER PAINT LVT RUBBER PAINT	5. REFER TO INT. ELEVATIONS. 5. REFER TO INT. ELEVATIONS. 5. REFER TO INT. ELEVATIONS. 5. REFER TO INT. ELEVATIONS.	123/1 MECHANICAL 123 N 123/2 MECHANICAL 123 N 124/1 ELECTRIC 124 N 124/2 ELECTRIC 124 N 125/1 TOILET 125 N	C PAIR 3'-0" X 7'-0" HM D VERIFY SCW D 3'-0" X 7'-0" HM C (SIM.) VERIFY SCW D VERIFY SCW VERIFY SCW SCW	E REFER TO EXISTING N HM E REFER TO EXISTING N HM E REFER TO EXISTING	2 PROVIDE THRESHOLD SWEEPS 3 2 PROVIDE THRESHOLD SWEEPS 3 4 PRIVACY LATCH, REFER TO HARDWARE SCHEDULE	RETVAL C RETVAL 2 RCHITETTRE NG 4 7 LICENSE #C774
119STORAGEREFER TO CEILING PLAN120OFFICEREFER TO CEILING PLAN123MECH.REFER TO CEILING PLAN124ELEC.REFER TO CEILING PLAN125TOILETREFER TO CEILING PLAN	LVT RUBBER PAINT LVT RUBBER PAINT LVT RUBBER PAINT LVT RUBBER PAINT LVT RUBBER PAINT	5. REFER TO INT. ELEVATIONS.	126/1 TOILET 126 N 127/1 OFFICE 127 N 128/1 OFFICE 128 N 128A/1 OFFICE 128A N 129/1 OFFICE 129 N	D VERIFY SCW D 3'-0" X 7'-0" SCW E 3'-0" X 7'-0" SCW	E REFER TO EXISTING E REFER TO EXISTING N HM E REFER TO EXISTING E REFER TO EXISTING E REFER TO EXISTING	4 PRIVACY LATCH, REFER TO HARDWARE SCHEDULE 3 3 3 3 3 3 3 3 4 5 5 5 5 5 5 5 5 5 5 5	O F A B
126TOILETREFER TO CEILING PLAN127OFFICEREFER TO CEILING PLAN128AOFFICEREFER TO CEILING PLAN128OFFICEREFER TO CEILING PLAN129OFFICEREFER TO CEILING PLAN	LVT RUBBER PAINT LVT RUBBER PAINT LVT RUBBER PAINT LVT RUBBER PAINT LVT RUBBER PAINT	5. REFER TO INT. ELEVATIONS. 5. REFER TO INT. ELEVATIONS. 5. REFER TO INT. ELEVATIONS. 5. REFER TO INT. ELEVATIONS.	130/1 OFFICE 130 N 131/1 BREAKROOM 131 N 132/1 KITCHEN 132 N 132/2 KITCHEN 132 N 133/1 STORAGE 133 N	E 3'-0" X 7'-0" SCW D 3'-0" X 7'-0" SCW	E REFER TO EXISTING	3	
130OFFICEREFER TO CEILING PLAN131BREAK ROOMEREFER TO CEILING PLAN132KITCHENREFER TO CEILING PLAN133STORAGEREFER TO CEILING PLAN134CLASSROOMREFER TO CEILING PLAN	LVT RUBBER PAINT LVT RUBBER PAINT LVT RUBBER PAINT LVT RUBBER PAINT LVT RUBBER PAINT	5. REFER TO INT. ELEVATIONS. 5. REFER TO FLOOR PLAN. ACCENT PAINT COLOR REFER TO INT. ELEVATIONS. 5	134/1 CLASSROOM 134 N 136/1 HC TOILET 136 N 137/1 HC TOILET 137 N 138/1 WIC 138 N 139/1 PHARMACY 139 N	D 3'-0" X 7'-0" SCW E 3'-0" X 7'-0" SCW E 3'-0" X 7'-0" SCW E 3'-0" X 7'-0" SCW D 3'-0" X 7'-0" SCW D 3'-0" X 7'-0" SCW	EREFER TO EXISTINGNHMNHMNHMNHMNHM	3 3 4 PRIVACY LATCH, REFER TO HARDWARE SCHEDULE 4 PRIVACY LATCH, REFER TO HARDWARE SCHEDULE 3 PROVIDE LOCK, REFER TO HARDWARE SCHEDULE	
139 PHARMACY REFER TO CEILING PLAN	LVT RUBBER PAINT LVT RUBBER PAINT LVT RUBBER PAINT LVT RUBBER PAINT LVT RUBBER PAINT	REFER TO FLOOR PLAN. ACCENT PAINT COLOR REFER TO FLOOR PLAN. ACCENT PAINT COLOR	140/1 LAB 140 N 141/1 TOILET 141 N 143/1 OFFICE/EXAM 143 N 145/1 OFFICE/EXAM 145 N 146/1 STORAGE 146 N	B 3'-0" X 7'-0" HM D VERIFY SCW D 3'-0" X 7'-0" SCW D 3'-0" X 7'-0" SCW D 3'-0" X 7'-0" SCW D VERIFY SCW	NHMEREFER TO EXISTINGEREFER TO EXISTINGEREFER TO EXISTINGEREFER TO EXISTING	 2 PROVIDE PEEP HOLE & THRESHOLD SWEEPS & DEADBOLT 4 PRIVACY LATCH, REFER TO HARDWARE SCHEDULE 5 5 3 	
140LABREFER TO CEILING PLAN141TOILETREFER TO CEILING PLAN143OFFICE/EXAMREFER TO CEILING PLAN145OFFICE/EXAMREFER TO CEILING PLAN146STORAGEREFER TO CEILING PLAN147OFFICE/EXAMREFER TO CEILING PLAN	LVT RUBBER PAINT LVT RUBBER PAINT LVT RUBBER PAINT LVT RUBBER PAINT LVT RUBBER PAINT LVT RUBBER PAINT	REFER TO INT. ELEVATIONS. REFER TO INT. ELEVATIONS. REFER TO INT. ELEVATIONS. REFER TO INT. ELEVATIONS.	147/1 OFFICE/EXAM 147 N 147A/1 ESSENTIAL SUPPLY 147A N 148/1 OFFICE 148 N 148A/1 CLOSET 148A N 149/1 WAITING 149 N	E 3'-0" X 7'-0" SCW E 3'-0" X 7'-0" SCW E 3'-0" X 7'-0" SCW E 2'-4" X 7'-0" SCW G 3'-0" X 7'-0" SCW	N HM N HM N HM N HM N HM N ALUM.	5 3 PROVIDE LOCK, REFER TO HARDWARE SCHEDULE 3 5 6 REFER TO FRAME ELEVATION	
147OFFICE/EXAMREFER TO CEILING PLAN148AESSENTIAL SUPPLYREFER TO CEILING PLAN148OFFICEREFER TO CEILING PLAN149WAITING ROOMREFER TO CEILING PLAN150MID-WIFEREFER TO CEILING PLAN151EXAMREFER TO CEILING PLAN	LVT RUBBER PAINT LVT RUBBER PAINT LVT RUBBER PAINT LVT RUBBER PAINT LVT RUBBER PAINT LVT RUBBER PAINT	REFER TO FLOOR PLAN. ACCENT PAINT COLOR REFER TO INT. ELEVATIONS. REFER TO INT. ELEVATIONS. REFER TO FLOOR PLAN. ACCENT PAINT COLOR REFER TO INT. ELEVATIONS.	149/2 WAITING 149 N 150/1 MID-WIFE 150 N 151/1 EXAM 151 N 152/1 EXAM 152 N 153/1 EXAM 153 N 153/2 EXAM 153 N	G 3'-0" X 7'-0" SCW D 3'-0" X 7'-0" SCW	N ALUM. E REFER TO EXISTING E REFER TO EXISTING	6 REFER TO FRAME ELEVATION 3 5 5 5 5 5 5 5 5 5 5 5 5 5 5 5 5 5 5	L L L L L L L L L L L L L L L L L L L
152EXAMREFER TO CEILING PLAN153OFFICEREFER TO CEILING PLAN154EXAM (VACCINES)REFER TO CEILING PLAN155STORAGEREFER TO CEILING PLAN156OFFICE/EXAMREFER TO CEILING PLAN	LVT RUBBER PAINT LVT RUBBER PAINT LVT RUBBER PAINT LVT RUBBER PAINT LVT RUBBER PAINT	REFER TO INT. ELEVATIONS. REFER TO INT. ELEVATIONS. REFER TO FLOOR PLAN. ACCENT PAINT COLOR REFER TO INT. ELEVATIONS.	155/1 STORAGE 155 N 156/1 OFFICE/EXAM 156 N 157/1 OFFICE/EXAM 157 N 158/1 JANITOR'S CLOSET 158 N 159/1 OFFICE/EXAM 159 N	D VERIFY SCW D 3'-0" X 7'-0" SCW D 3'-0" X 7'-0" SCW D 3'-0" X 7'-0" SCW D VERIFY SCW D 3'-0" X 7'-0" SCW D VERIFY SCW D 3'-0" X 7'-0" SCW	E REFER TO EXISTING E REFER TO EXISTING	3 5 5 3 5 5 5 5 5 5 5 5 5 5 5 5 5	th Uni
157OFFICE/EXAMREFER TO CEILING PLAN158JANITORS CLOSETREFER TO CEILING PLAN159OFFICE/EXAMREFER TO CEILING PLAN160HC TOILETREFER TO CEILING PLAN161EXAMREFER TO CEILING PLAN	LVT RUBBER PAINT LVT RUBBER FRP LVT RUBBER PAINT LVT RUBBER PAINT LVT RUBBER PAINT	REFER TO INT. ELEVATIONS. FLOOR TO 4'-0" A.F.F. REFER TO INT. ELEVATIONS. REFER TO INT. ELEVATIONS.	160/1 HC TOILET 160 N 161/1 EXAM 161 N 162/1 FXAM 162 N GENERAL NOTES	D 3'-0" X 7'-0" SCW D 3'-0" X 7'-0" SCW D 3'-0" X 7'-0" SCW	NHMEREFER TO EXISTINGEREFER TO EXISTING	4 PRIVACY LATCH, REFER TO HARDWARE SCHEDULE 5 5	y Heal
162 EXAM REFER TO CEILING PLAN 163 COURIER REFER TO CEILING PLAN WINDOW SCHEDULE	LVT RUBBER PAINT LVT RUBBER PAINT	REFER TO INT. ELEVATIONS. REFER TO FLOOR PLAN. ACCENT PAINT COLOR	 COORDINATE DOOR & HARDWARE W/ EXISTING FRAME. MAKE NECESSARY REPAIRS OR ADJUSTMENTS TO FRAME AS MAY BE REQ'D TO ACCOM. NEW DOOR. PROVIDE NEW WEATHER STRIPPING. EXISTING DOOR TO REMAIN. CLEAN THOROUGHLY. ADJUST OR 				i Count
FAÇADELOCATIONTYPERAMENORTHLOBBY/WAITING 101A35.5"NORTHOFFICE 111A35.5"	SIZE (WIDTH X HEIGHT ROUGH OPENING " X 61.5" 36" X 62"	ABBREVIATIONS	 TIGHTEN EXISTING HARDWARE FOR BEST FUNCTION. 3. PROVIDE NEW HARDWARE. DRILL/PATCH EXISTING DOOR AS REQ'D. 4. REPLACE HARDWARE W/ NEW SIM. TO EXISTING. PROVIDE NEW WEATHERSTRIPPING. ADD PEEPHOLE. 				Vane: sissippi heville
NORTHOFFICE 115A35.5NORTHOFFICE 116A35.5NORTHOFFICE 118A35.5WESTOFFICE 118A35.5	" X 61.5" 36" X 62" " X 61.5" 36" X 62"	AL - ALUMINUM HM - HOLLOW METAL SCW - SOLID CORE WOOD E - EXISTING N - NEW T - TEMPERED	5. APPLY ROLLER-SHADES TO ALL WINDOWS. WITH THE EXCEPTION OF GLASS BLOCK WINDOWS.	6'-4" VERIFY 3'-0" 3'-0" VERIFY VERIFY io	3-0"	6'-4" VERIFY 3'-0" ZERIFY VERIFY	Project Nam Missii Issue Date:
SOUTHOFFICE 127A35.5SOUTHOFFICE 128AA35.5SOUTHOFFICE 128A35.5SOUTHOFFICE 129A35.5	" X 61.5" 36" X 62" " X 61.5" 36" X 62"	EQ - EQUAL SIM - SIMILAR	 HARDWARE NOTES 1. HARDWARE 1 - ENTRY DOORS W/ HANDLE AND LOCK. PUSH BAR ON INTERIOR SIDE. 2. HARDWARE 2 - EXT. METAL HANDLE W/ LOCK. NEW 	A A A A A A A A A A A A A A A A A A A	VERIFY VERIFY		August 26, 2022 Revisions: October 28, 2022
SOUTHBREAK ROOM 131A35.5SOUTHBREAK ROOM 131A35.5	" X 61.5" 36" X 62" " X 61.5" 36" X 62" " X 61.5" 36" X 62" " X 61.5" 36" X 62" PENING.		 WEATHERSTRIPPING 3. HARDWARE 3 - HARDWARE FOR INTERIOR DOOR W/ LOCK AND CORRESPONDING KEY 4. HARDWARE 4 - METAL HANDLE FOR INT. DOOR WITH BATHROOM PRIVACY LOCK 		2'-2' 2'-2' 2'-2' 2'-2' 2'-2' 2'-2'		
			 HARDWARE 5 - STANDARD METAL HANDLE FOR INT. DOOR HARDWARE BY STOREFRONT MANUF. 	NEW ALUM. DOORS IN EXISTING ALUM. FRAME	EXT. NEW DOOR & FRAME (HOLLOW METAL)	FINISH FLOOR ELEV.	
L	20'-0"	MATCHLINE			B) 3'-4"		
DOOR AS SCHEDULED	$\begin{array}{c ccccccccccccccccccccccccccccccccccc$	$\begin{array}{cccccccccccccccccccccccccccccccccccc$		VERIFY BA-4.1 SIM.	3'-0" 	3'-4" ALUM. STOREFRONT DOOR W/ TEMPERED GLASS	
		4-0	1 1	Z-2"	7'-0"	10"RAIL	t Contents:
		7 7 7 0 5 8 7 0 0		SH FLOOR ELEV.		FINISH FLOOR ELEV.	Sheet No:
	U	O O	DOOR AS SCHEDULED		E ALUM. STO	OREFRONT DOOR W/ TEMP. GLASS	BA-4.1


				\smile
FAÇADE	LOCATION	TYPE	RAME SIZE (WIDTH X HEIGH	ROUGH OPENING
NORTH	LOBBY/WAITING 101	Α	35.5" X 61.5"	36" X 62"
NORTH	OFFICE 111	A	35.5" X 61.5"	36" X 62"
NORTH	OFFICE 112	A	35.5" X 61.5"	36" X 62"
NORTH	OFFICE 115	Α	35.5" X 61.5"	36" X 62"
NORTH	OFFICE 116	A	35.5" X 61.5"	36" X 62"
NORTH	OFFICE 118	Α	35.5" X 61.5"	36" X 62"
WEST	OFFICE 118	Α	35.5" X 61.5"	36" X 62"
WEST	OFFICE 120	Α	35.5" X 61.5"	36" X 62"
SOUTH	OFFICE 127	A	35.5" X 61.5"	36" X 62"
SOUTH	OFFICE 127	A	35.5" X 61.5"	36" X 62"
SOUTH	OFFICE 128A	A	35.5" X 61.5"	36" X 62"
SOUTH	OFFICE 128	Α	35.5" X 61.5"	36" X 62"
SOUTH	OFFICE 129	A	35.5" X 61.5"	36" X 62"
SOUTH	OFFICE 130	A	35.5" X 61.5"	36" X 62"
SOUTH	BREAK ROOM 131	A	35.5" X 61.5"	36" X 62"
SOUTH	BREAK ROOM 131	A	35.5" X 61.5"	36" X 62"
SOUTH	CLASSROOM 134	A	35.5" X 61.5"	36" X 62"


AL - ALUMINUM HM - HOLLOW METAL SCW - SOLID CORE WOOI E - EXISTING N - NEW T - TEMPERED EQ - EQUAL
EQ - EQUAL SIM - SIMILAR

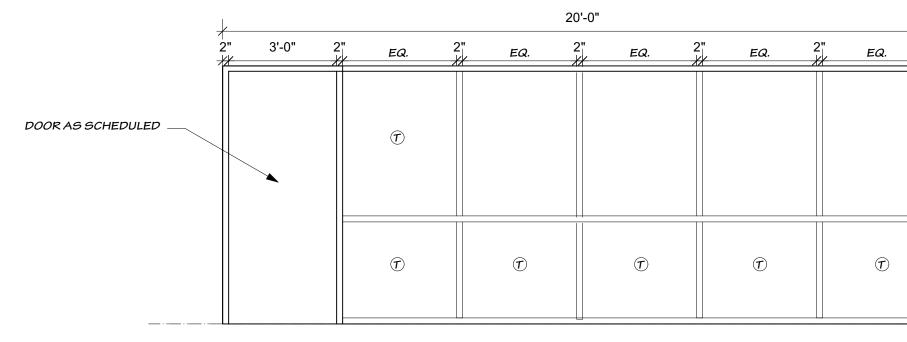

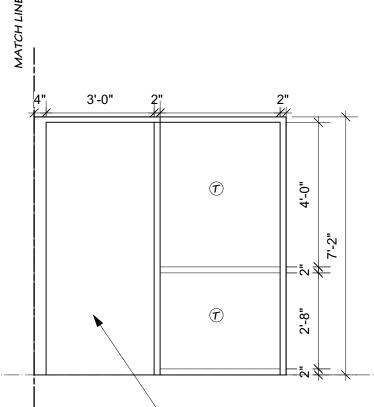

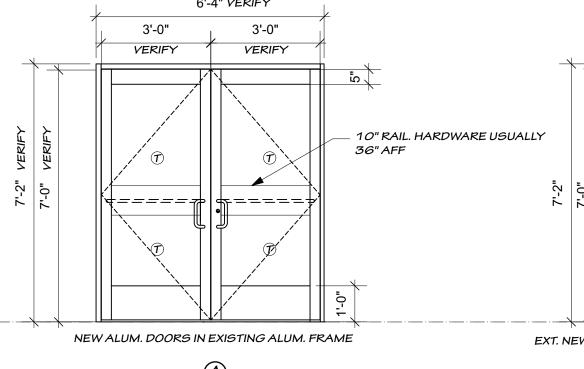


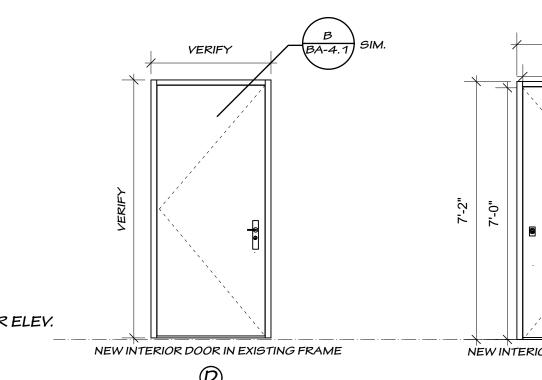

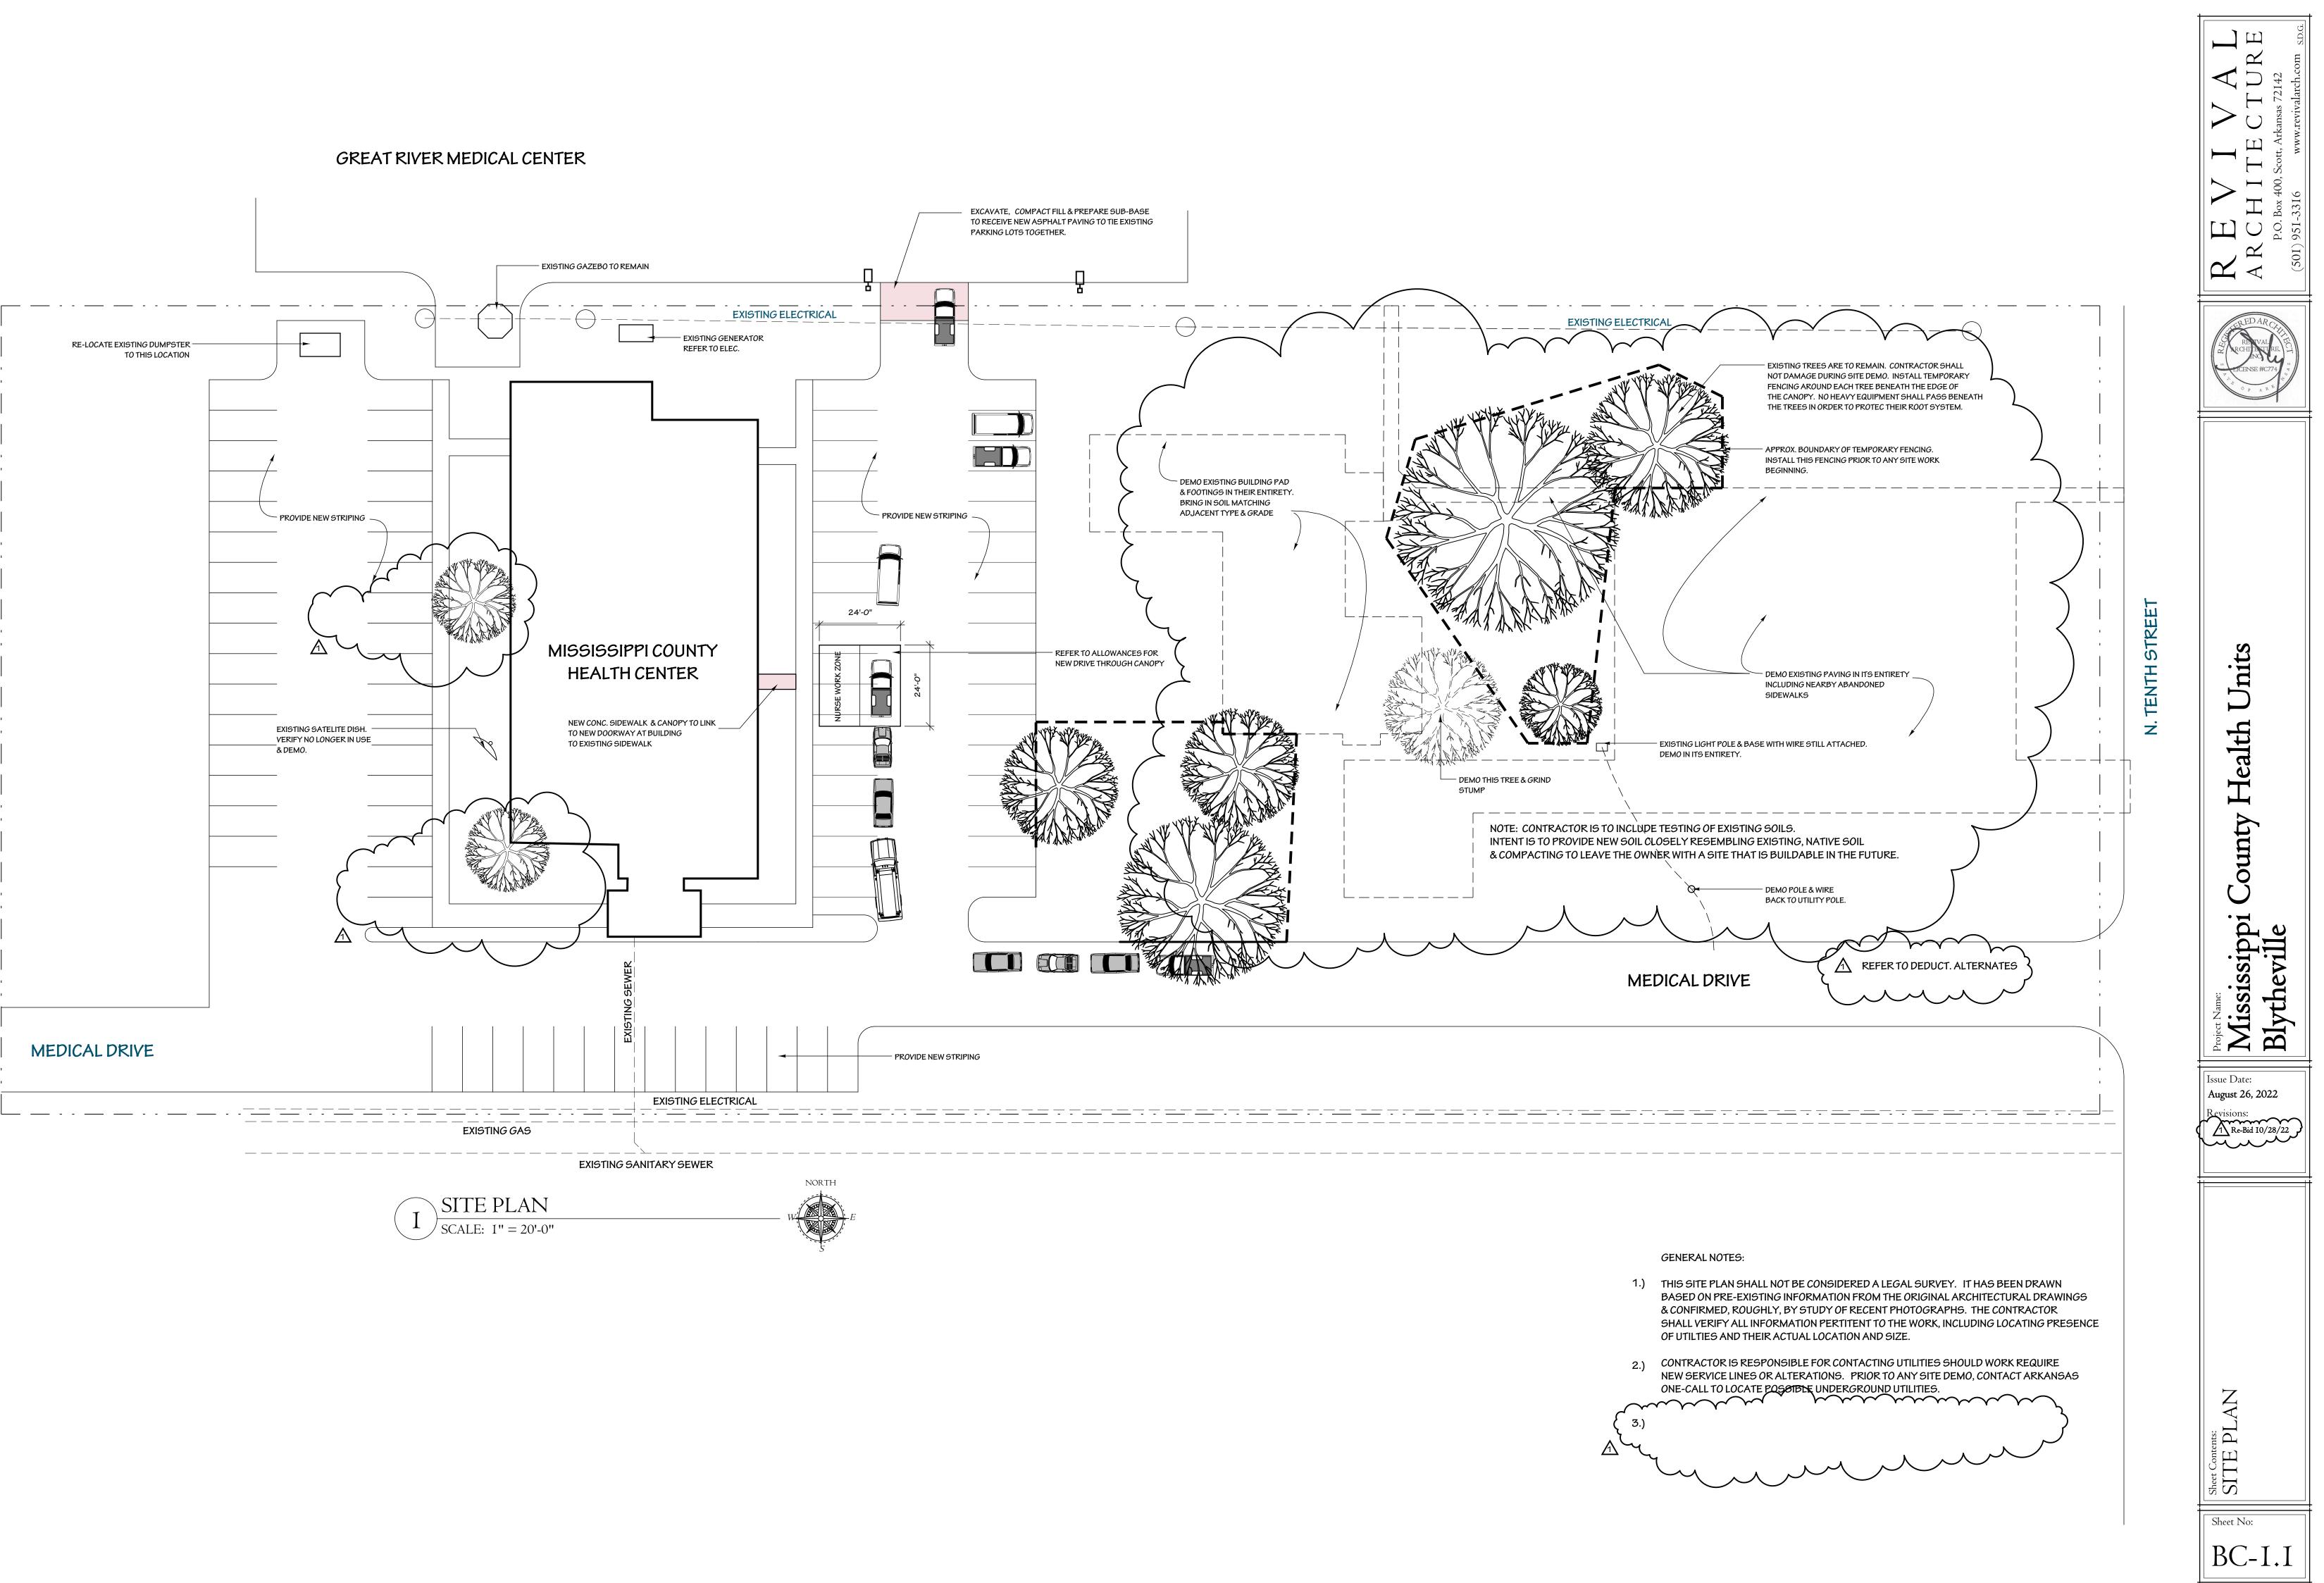





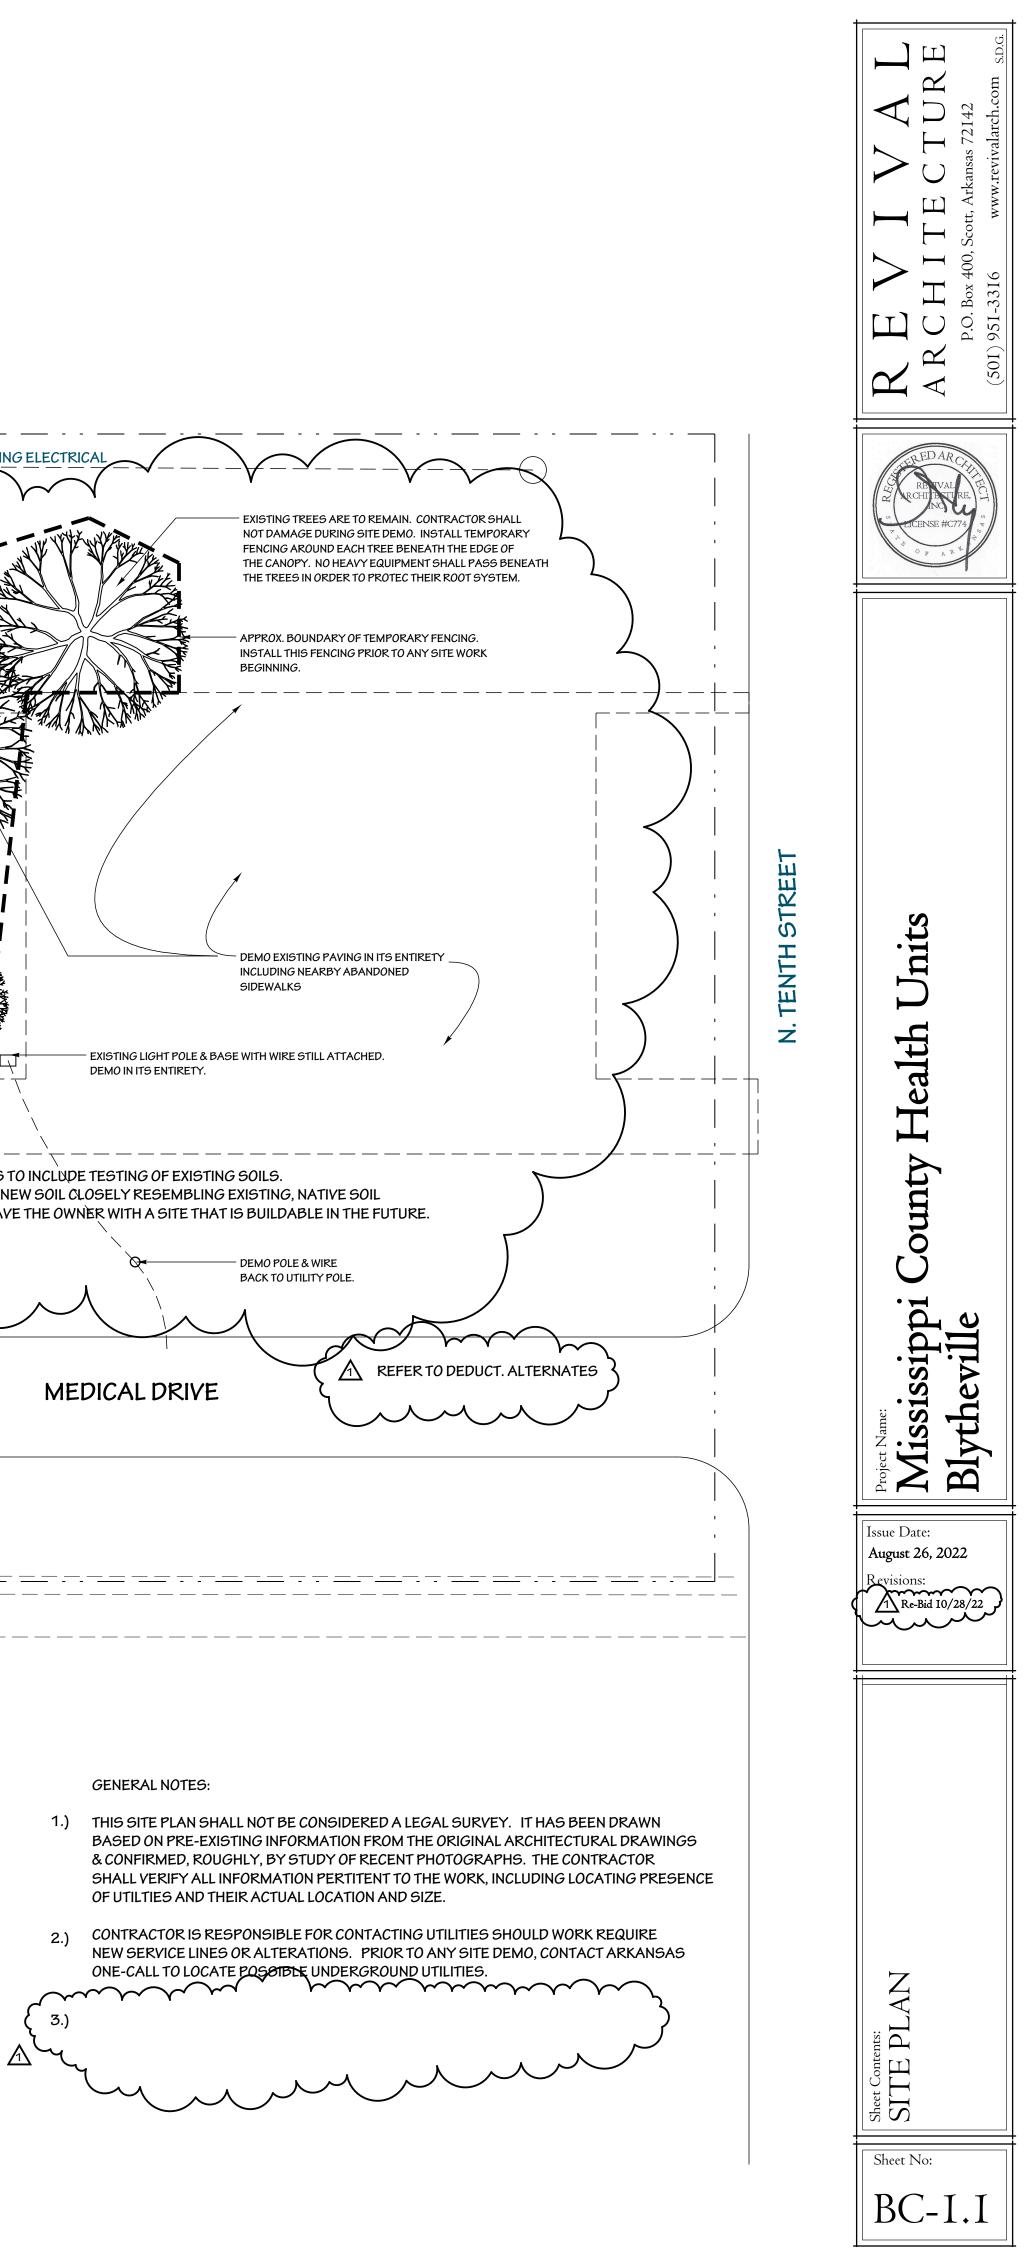

ALTERNATES

THE CONTRACTOR SHALL PRICE THE FOLLOWING ITEMS AS DEDUCTIVE ALTERNATE TO THE DRAWINGS.

- 1. EXISTING HVAC UNITS TO REMAIN.
- 2. AN ALTERNATE LIGHTING PACKAGE AS APPROVED BY THE ARCHITECT.

4. MC CABLE IN LIEU OF EMT THROUGHOUT THE INTERIOR OF THE BUILDING.

3. ALUMINUM WIRES FOR WIRE SIZE 1/0 AND LARGER. DRAWINGS ARE SIZED FOR COPPER, CONTRACTOR TO SIZE ALUMINUM PER NEC.

CONTRACTOR IS RESPONSIBLE FOR COORDINATING ALL INSTALLATION WITH THE WORK OF OTHER TRADES. FIELD MODIFICATIONS NEEDED DUE TO OBSTRUCTIONS OR INTERFERENCES SHALL BE PROVIDED AT NO ADDITIONAL COST. ALL WORK SHALL BE PERFORMED IN A NEAT AND WORKMANLIKE MANNER WITHIN STANDARD

WORK.

1.

- INFORMATION.
- 4. SERVICE TO THE OWNER. 5.
- 6 GOVERN.
- 7 PROCEEDING.
- 8. 9

- 12

- FUNCTIONING.
- 16.

GENERAL NOTES

OF CARE FOR PROFESSION. ALL LABOR, MATERIAL, TOOLS, PERMITS, INSPECTIONS, TESTING, CERTIFICATION, ETC. REQUIRED FOR A COMPLETE AND SATISFACTORY INSTALLATION TO DESIGN INTENT SHALL BE FURNISHED BY CONTRACTOR. PROVIDE, AT NO ADDITIONAL COST, INCLUDING INCIDENTAL ITEMS NOT SHOWN WHEN REQUIRED FOR TYPICAL COMPLETION OF

DRAWINGS NOT BEARING THE STAMP OR SEAL AND SIGNATURE OF A REGISTERED PROFESSIONAL ENGINEER SHALL NOT BE USED FOR BIDDING OR CONSTRUCTION PURPOSES UNLESS EXPRESSLY APPROVED IN WRITING BY THE ARCHITECT. THE CONTRACTOR SHALL BE RESPONSIBLE FOR ENSURING THAT ALL DRAWINGS AND SPECIFICATIONS BEING USED FOR BIDDING AND CONSTRUCTION PURPOSES ARE OF THE LATEST REVISION AVAILABLE AND ALL ADDENDUM DOCUMENTS HAVE BEEN INCORPORATED EITHER BY REVISION RELEASE OF DRAWINGS/SPECIFICATIONS OR ATTACHMENT OF SKETCHES OR OTHER ADDENDUM

THE CONTRACTOR SHALL FURNISH AND INSTALL NEW PRODUCTS OF ESTABLISHED AND REPUTABLE MANUFACTURERS. NO EQUIPMENT SUBSTITUTIONS SHALL BE MADE THAT WOULD LEAVE INADEQUATE OPERATING OR SERVICE SPACE. EQUIPMENT SHALL BE INSTALLED IN ACCORDANCE WITH MANUFACTURER'S RECOMMENDED INSTALLATION PROCEDURES AND IN AN ARRANGEMENT THAT WILL GIVE THE GREATEST PRACTICAL EASE OF OPERATION AND

ALL EQUIPMENT WHICH IS INDICATED TO BE FURNISHED AND/OR INSTALLED BY OTHERS OR BY OWNER IS INCLUDED FOR REFERENCE ONLY UNLESS NOTED OTHERWISE. CONTRACTOR SHALL BE RESPONSIBLE FOR COORDINATING AND VERIFYING INSTALLATION REQUIREMENTS OF THIS EQUIPMENT WITH THE APPLICABLE SUPPLIER OR THE OWNER. ANY DISCREPANCIES SHALL BE BROUGHT TO THE ATTENTION OF THE ENGINEER.

ALL WORK SHALL BE INSTALLED IN ACCORDANCE WITH THE REQUIREMENTS OF ALL APPLICABLE CODES AND REGULATIONS INCLUDING BUT NOT LIMITED TO NATIONAL, CITY, STATE, LOCAL ORDINANCES, AND UTILITY COMPANY REGULATIONS. ALL PLUMBING MATERIALS, INSTALLATION PROCEDURES, AND SYSTEM LAYOUTS SHALL BE APPROVED BY ALL APPLICABLE AUTHORITIES HAVING JURISDICTION. THE CONTRACTOR SHALL PROVIDE ALL MATERIALS AND LABOR NECESSARY TO COMPLY WITH THESE RULES, REGULATIONS, AND ORDINANCES. THESE CODES REPRESENT THE MINIMUM ACCEPTABLE REQUIREMENTS, THEREFORE, WHERE DRAWINGS AND/OR SPECIFICATIONS INDICATE MATERIALS OR CONSTRUCTION MORE STRINGENT THAT CODE REQUIREMENTS, THE DRAWINGS AND/OR SPECIFICATIONS SHALL

IF COMPLIANCE WITH STANDARDS, CODES, REGULATIONS AND CONTRACT DOCUMENTS ESTABLISH DIFFERENT OR CONFLICTING REQUIREMENTS FOR MINIMUM QUANTITIES OR QUALITY LEVELS, REFER CONFLICTING REQUIREMENTS TO ENGINEER FOR A DECISION BEFORE

THE CONTRACTOR SHALL BE RESPONSIBLE FOR ALL COSTS INCURRED BY ANY SERVING UTILITY, MUNICIPAL AUTHORITY, AND/OR OWNER FOR THE RELOCATION, REMOVAL, AND INSTALLATION OF TEMPORARY OR NEW SERVICES.

THE CONTRACTOR SHALL BE RESPONSIBLE FOR COORDINATING AND PROVIDING THE EXACT SERVICE EQUIPMENT AND INSTALLATION METHODS WITH THE SERVING UTILITY, MUNICIPAL AUTHORITY, AND/OR OWNER PRIOR TO BIDDING. FAILURE TO DO SO WILL NOT CONSTITUTE SUFFICIENT GROUNDS FOR AN AUTHORIZED CHANGE ORDER TO THE PROJECT.

10. CLOSEOUT SUBMITTALS SHALL INCLUDE, BUT NOT LIMITED TO, OPERATION AND MAINTENANCE MANUALS AND RECORD DRAWINGS. PROVIDE TRAINING WHERE REQUIRED.

11. THE CONTRACTOR SHALL VISIT THE SITE OF THE BUILDING BEFORE SUBMITTING A PROPOSAL ON THIS WORK AND SHALL THOROUGHLY FAMILIARIZE HIMSELF WITH THE EXISTING CONDITIONS AND OPERATIONS. FAILURE ON HIS PART TO DO THIS WILL NOT BE CAUSE OF EXTRAS AFTER THE CONTRACT IS SIGNED, BY REASON OF UNFORESEEN CONDITIONS.

NO PERSON SHALL PERFORM ELECTRICAL WORK ON THE CONTRACT WITHOUT POSSESSING A MASTER'S OR JOURNEYMAN'S LICENSE FROM THE STATE ELECTRICAL EXAMINERS BOARD. ALL ELECTRICAL WORK AND APPRENTICE ELECTRICIANS SHALL BE SUPERVISED BY A MASTER JOURNEYMAN ELECTRICIAN ON A ONE TO ONE RATIO.


13. PREPARE AND SUBMIT SUBMITTALS TO ARCHITECT AS SPECIFIED.

14. ALL AREAS USED AS RETURN AIR PLENUMS SHALL BE CONSTRUCTED WITH FIRE RESISTANT MATERIALS AND SHALL ONLY CONTAIN MATERIALS WHICH HAVE SMOKE DEVELOPED RATINGS NOT GREATER THAN 50 AND FLAME SPREAD RATINGS NOT GREATER THAN 25.

15. ALL ELECTRICAL EQUIPMENT, SUCH AS SWITCHES, CIRCUIT BREAKERS, ETC. SHALL BE TESTED BY OPERATING THE DEVICE TO VERIFY THAT THE MECHANICAL PORTIONS OF THE DEVICE ARE

THE CONTRACTOR SHALL ASSIST ALL OTHER TRADES IN PERFORMING ROTATIONAL TESTS ON ALL MOTORS PROVIDED UNDER THIS CONTRACT.

A	WALL MOUNT STRIP LIGHT.
A	WALL PACK LIGHT FIXTURE.
D	RECESSED DOWN LIGHT.
	2X4 LED TROFFER.
	2X4 LED TROFFER ON EMERGENCY POWER.
\bigcirc	2X2 LED TROFFER.
A _{EL}	2X2 LED TROFFER ON EMERGENCY POWER.
HAH	4' LED STRIP
H	WALL LIGHT
·)) · 이	RECESSING LIGHTING
\$ \$D \$3 \$4	SINGLE POLE SWITCH. "D" DENOTES DIMMER, "3" 3-WAY, "4" - 4 WAY. COORDINATE WITH FIXTURE/LAMP TYPE AND CIRCUIT WATTAGE.
⊅4 \$os	WALL MOUNTED DUAL TECH. MOTION SENSOR SWITCH WIRE PER MANUFACTURERS RECOMMENDATION. PROVIDE CONTACTORS TO CONTROL EXHAUST FAN WITH LIGHTS WHERE REQUIRED.
\$м	MOTOR RATED SWITCH USED FOR EQUIPMENT DISCONNECTING MEANS. S PHASE: PROVIDE MANUAL MOTOR STARTER WITH THERMAL OVERLOAD RI SIZED PER MOTOR LOAD.
PP	POWER POLE
\sim	BRANCH CIRCUIT HOMERUN. PANEL AND CIRCUIT NUMBER INDICATED.
OS	CEILING MOUNTED DUAL TECH. OCCUPANCY SENSOR EQUAL TO WATTSTO FT. PROVIDE AND INSTALL POWER PACKS AS REQUIRED. COORDINATE SW LOCATION AND QUANTITY WITH ACTUAL OCCUPANCY SENSOR USED. WIR MANUFACTURERS RECOMMENDATION.
Hos	WALL MOUNTED DUAL TECH. OCCUPANCY SENSOR. EQUAL TO WATTSTOF FT. PROVIDE AND INSTALL POWER PACKS AS REQUIRED. COORDINATE SW LOCATION AND QUANTITY WITH ACTUAL OCCUPANCY SENSOR USED. WIR MANUFACTURERS RECOMMENDATION.
θA	EXIT SIGN/COMBINATION EXIT/EMERGENCY LIGHT
t €t _A	EXIT SIGN/COMBINATION EXIT/EMERGENCY LIGHT (WITH DIRECTIONAL ARI
A	EXIT SIGN/COMBINATION EXIT/EMERGENCY LIGHT (WITH STROBES).
	WALL MOUNTED EXIT SIGN/COMBINATION EXIT/EMERGENCY LIGHT.

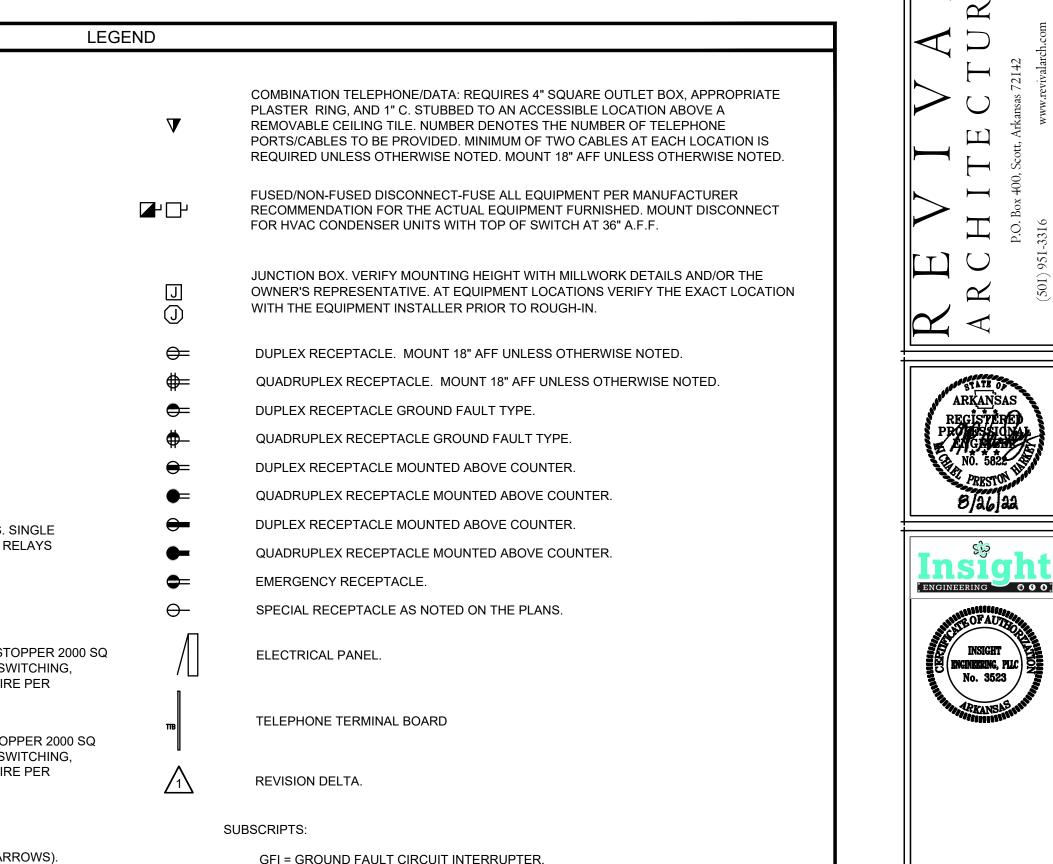


- GFI = GROUND FAULT CIRCUIT INTERRUPTER. WP = WEATHER RESISTANT RECEPTACLES ARE "GFI", WITH METAL WEATHER RESISTANT "WHILE-IN-USE" COVERS.
- EC = ELECTRICAL CONTRACTOR
- AFF = ABOVE FINISHED FLOOR
- AFG = ABOVE FINISHED GRADE NTS = NOT TO SCALE

+ ni ealth Т ounty Mississippi \mathbf{O} Blytheville ISSUE DATE:

JШ

August 26, 2022 evisions: NOT Sheet Contents: ELECTRICAL GENERAL AND LEGEND Sheet No: BE-1.0

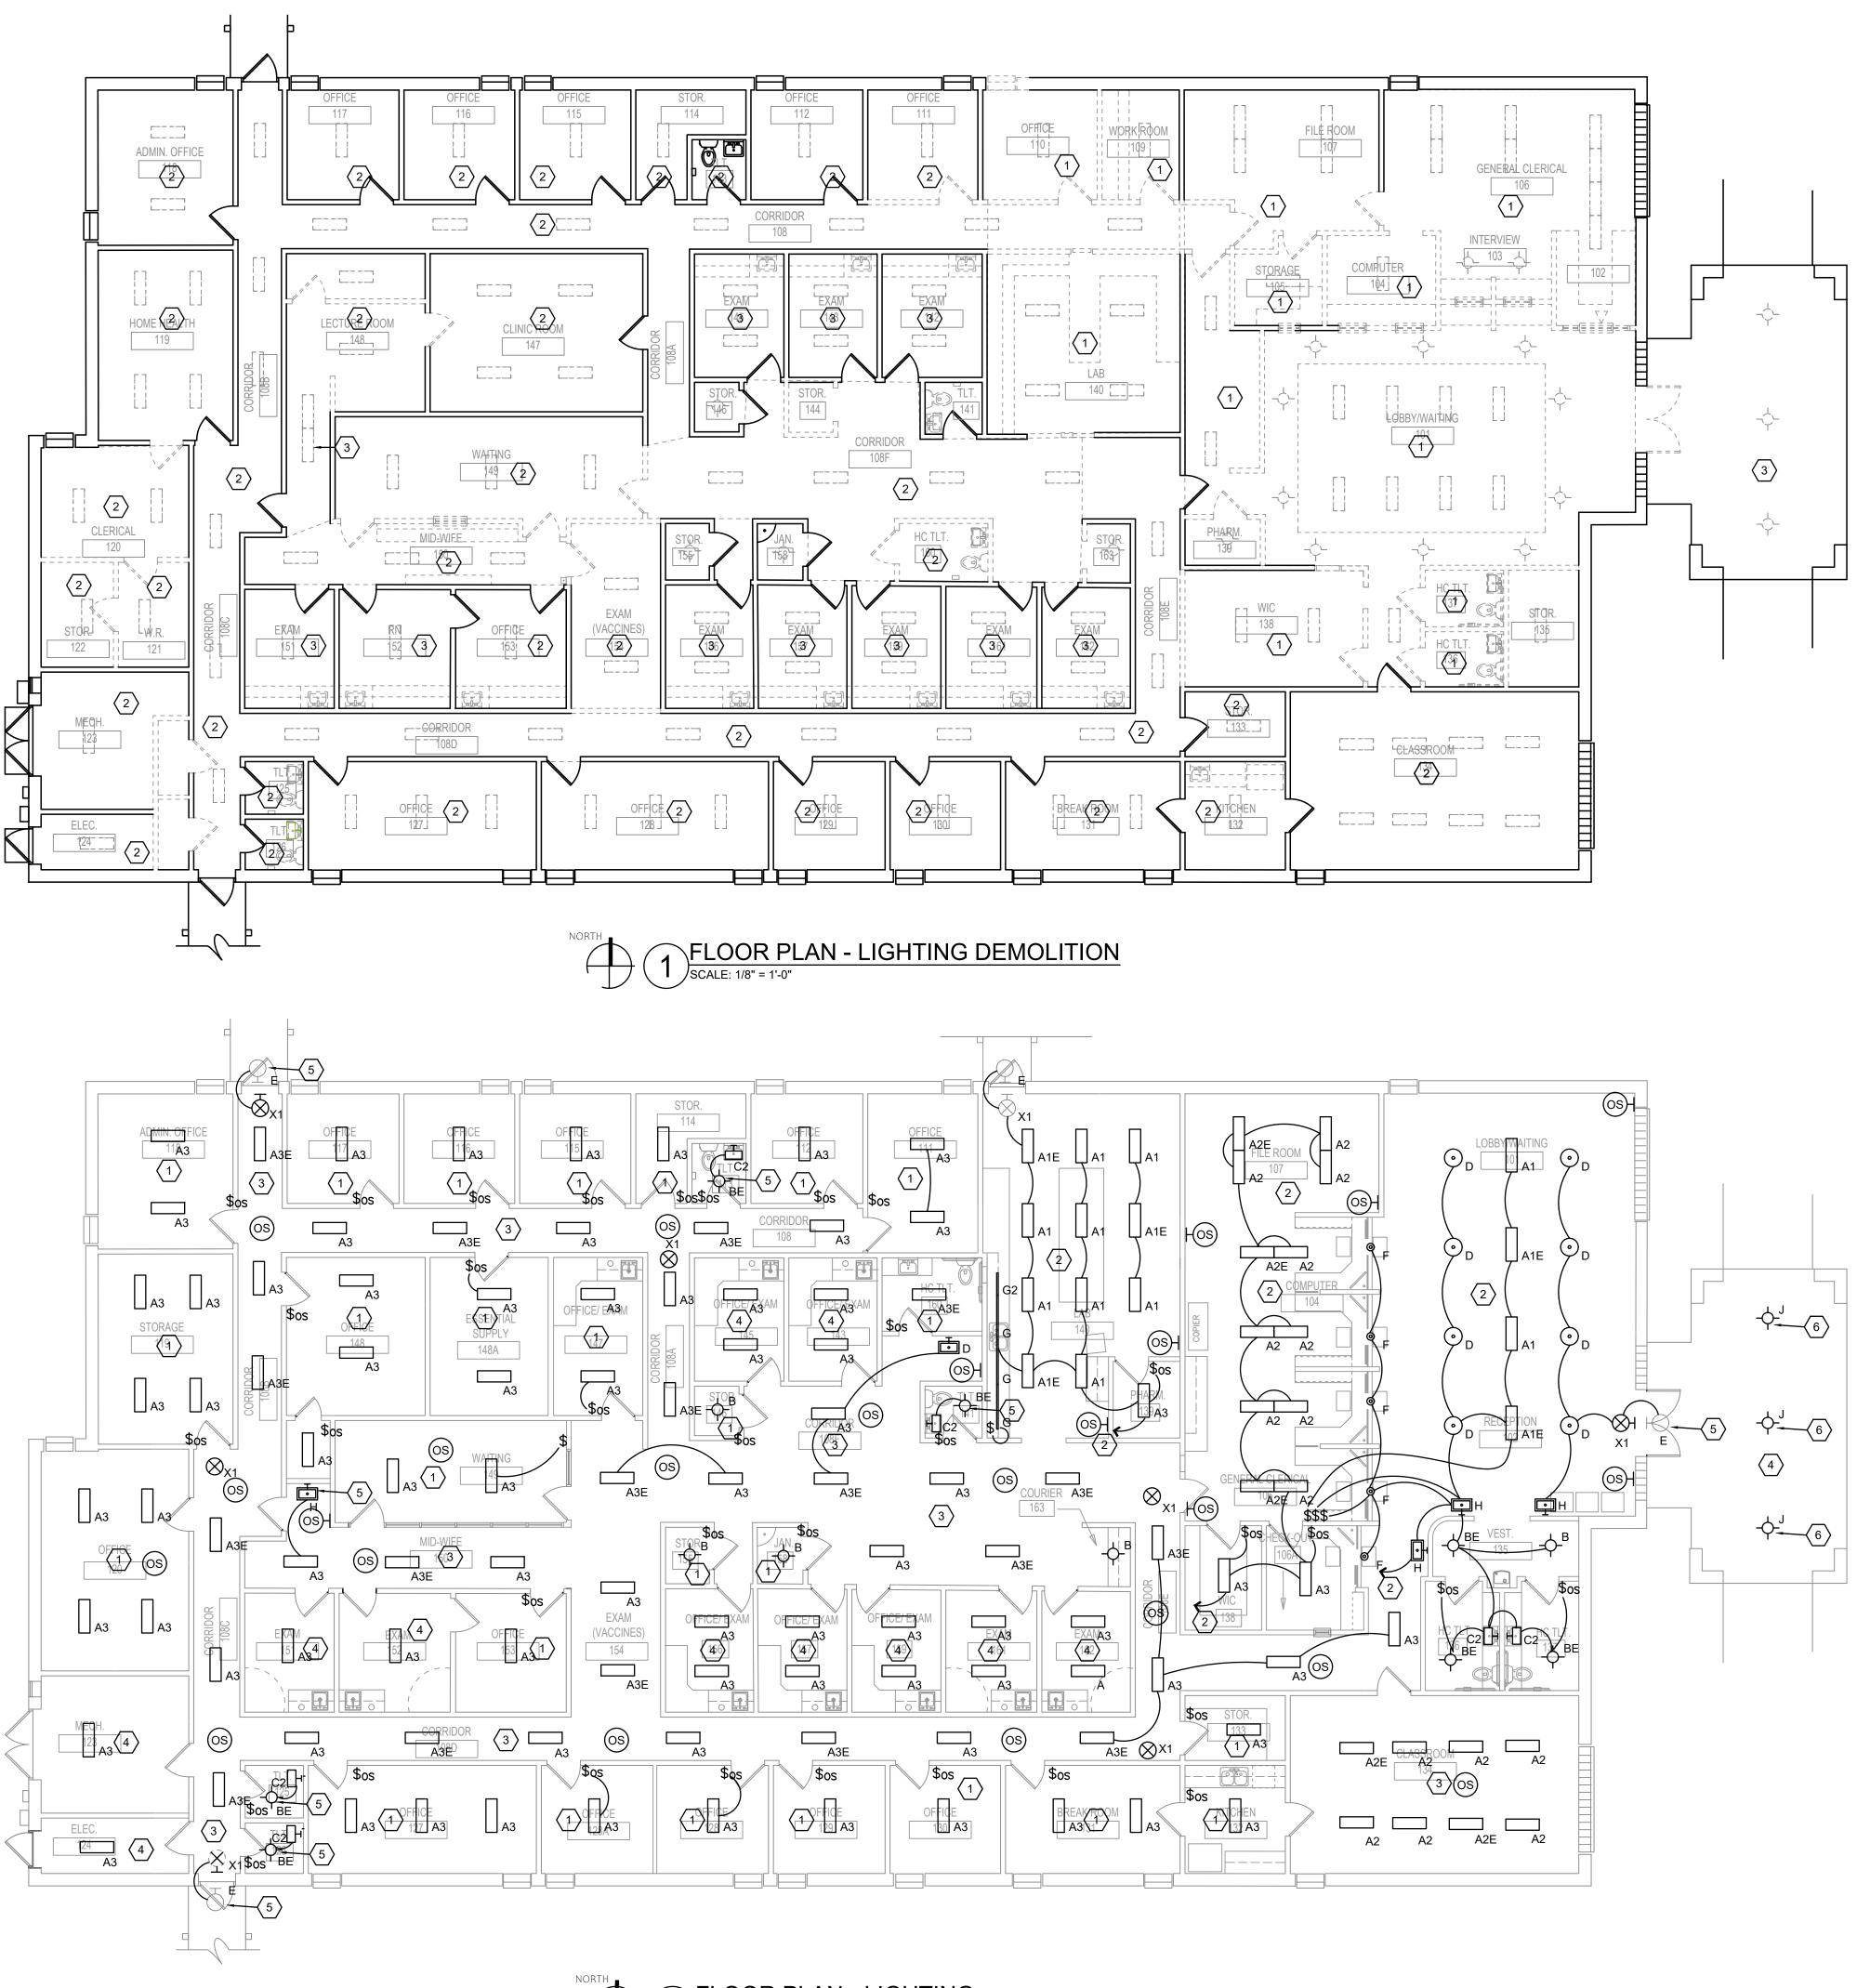


FLOOR PLAN - LIGHTING SCALE: 1/8" = 1'-0"

DEMOLITION KEYED NOTES:

(1) REMOVE EXISTING LIGHT FIXTURE, WIRE, AND CONDUIT IN THIS ROOM BACK TO NEAREST J-BOX. REMOVE EXISTING SWITCH(ES) AND PROVIDE BLANK COVERPLATE AS REQUIRED.


 $\langle 2 \rangle$ REMOVE EXISTING LIGHT FIXTURE IN THIS ROOM. BOX, CONDUIT, AND WIRE TO REMAIN. REMOVE EXISTING SWITCH, SWITCH JBOX AND CONDUIT TO REMAIN.

3 REMOVE EXISTING LIGHT FIXTURE IN THIS ROOM. JBOX, CONDUIT, AND WIRE TO REMAIN. EXISTING SWITCH TO REMAIN.

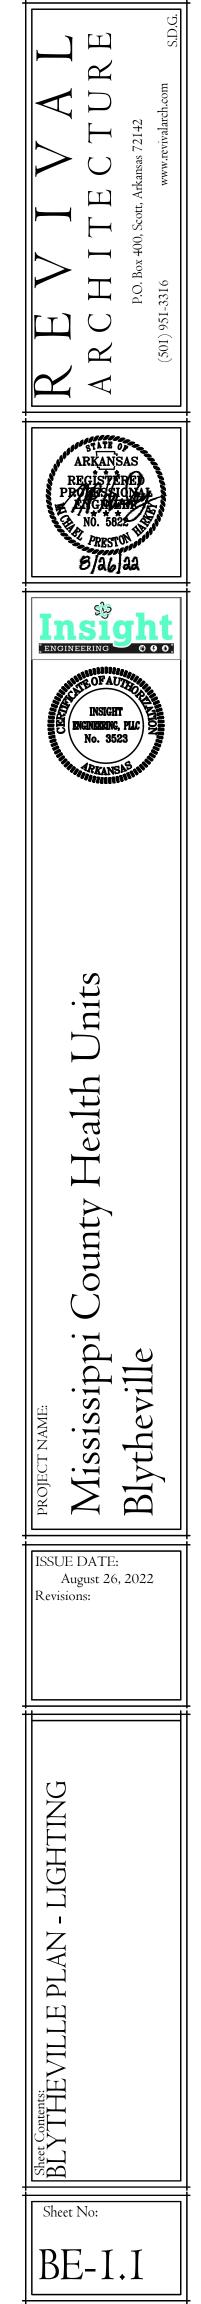

KEYED NOTES:

- (1) INSTALL NEW LIGHT FIXTURE IN EXISTING JBOX. RECONNECT TO EXISTING CIRCUIT AND SWITCHING. EXTEND HOT TO NEW EMERGENCY FIXTURES AS REQUIRED. INSTALL NEW SWITCHED OCCUPANCY SENSOR IN EXISTING BOX.
- INSTALL NEW LIGHT FIXTURES IN NEW CEILING. HOMERUN TO PANEL "P1" (2) TO SPARE LIGHTING CIRCUIT. INSTALL NEW OCCUPANCY SENSOR(S) AND POWER PACKS AS REQUIRED.
- $\langle 3 \rangle$ INSTALL NEW LIGHT FIXTURE IN EXISTING JBOX. RECONNECT TO EXISTING CIRCUIT AND SWITCHING. EXTEND HOT TO NEW EMERGENCY FIXTURES AS REQUIRED. INSTALL NEW OCCUPANCY SENSOR(S) AND POWER PACK AS REQUIRED, CONNECT TO EXISTING CIRCUIT. WIRE EXISTING SWITCH TO OVERRIDE OCCUPANCY SENSOR(S).
- (4) INSTALL NEW LIGHT FIXTURE IN EXISTING JBOX. RECONNECT TO EXISTING CIRCUIT AND SWITCHING. EXTEND HOT TO NEW EMERGENCY FIXTURES AS REQUIRED.
- 5 INSTALL NEW LIGHT FIXTURE IN NEW JBOX. CONNECT TO CIRCUIT AS SHOWN.
- $\langle 6 \rangle$ BLOCK AND PATCH EXISTING HOLE AS REQUIRED.

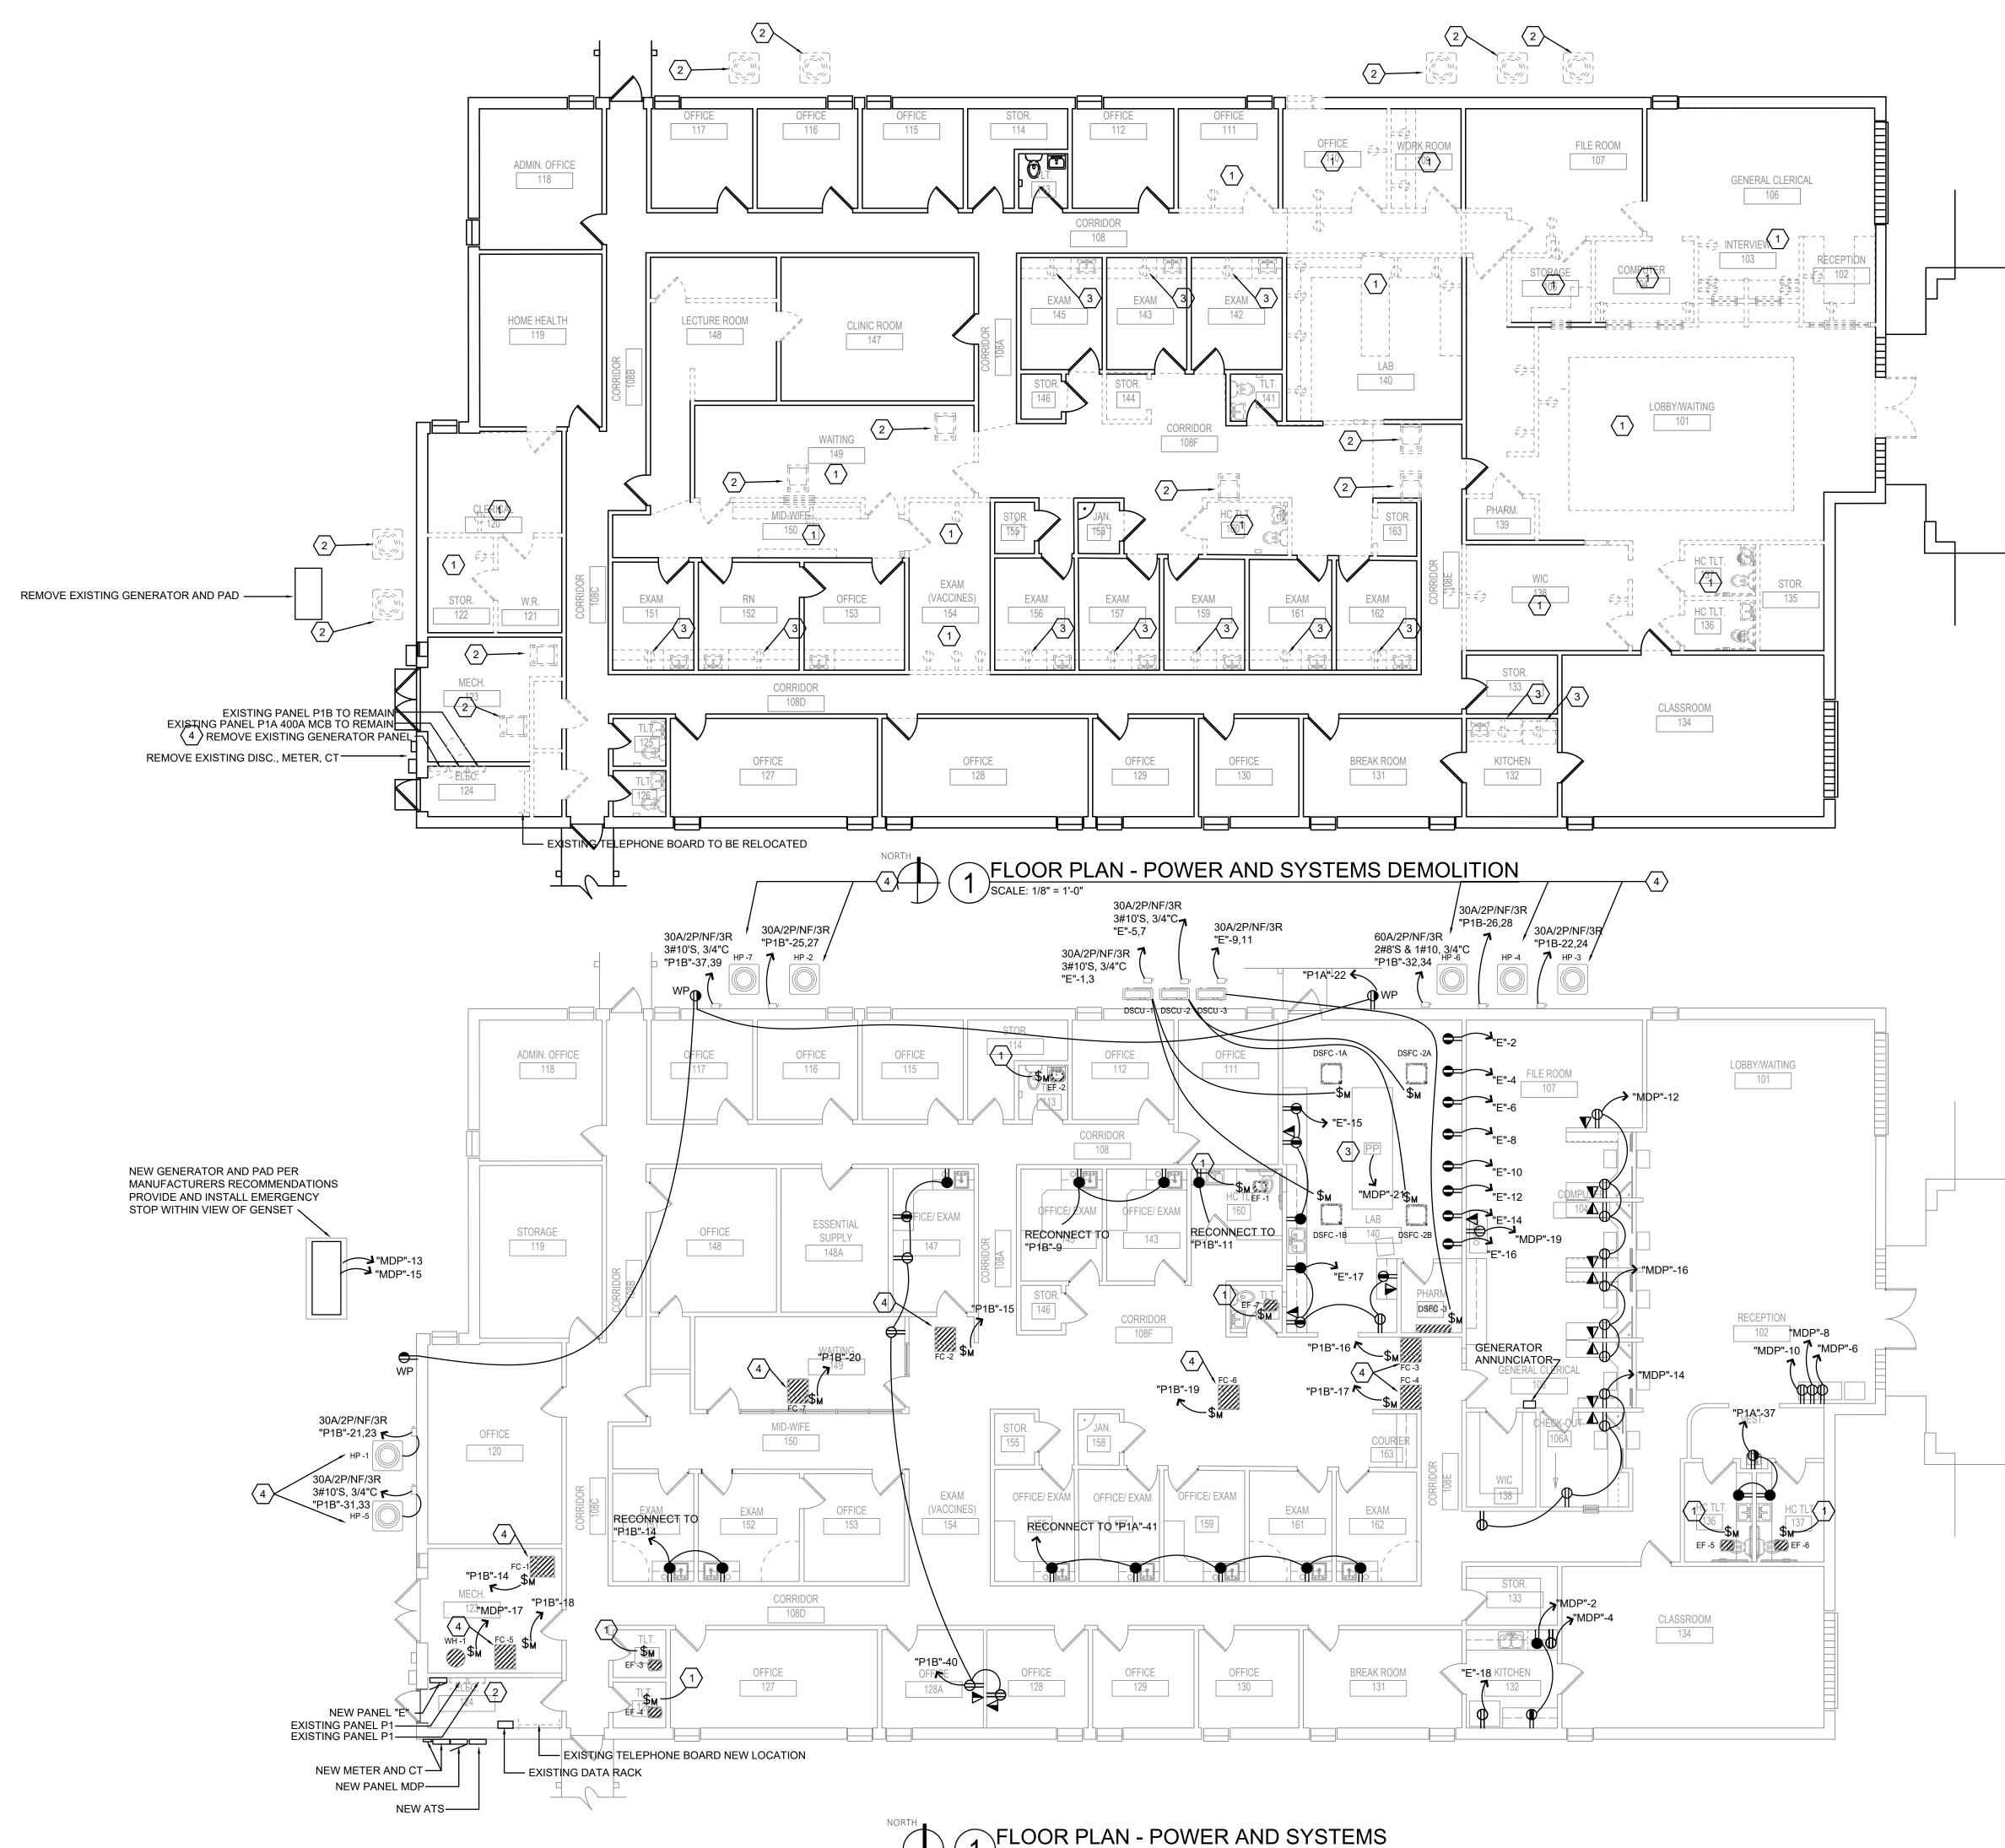

1 FLOOR PLAN - POWER AND SYSTEMS SCALE: 1/8" = 1'-0"



- (1) EXISTING RECEPTACLES IN WALLS TO BE DEMOLISHED TO BE REMOVED BACK TO NEAREST J-BOX. MAINTAIN CIRCUIT CONTINUITY.
- 2 REMOVE EXISTING HVAC DISCONNECT, CONDUIT, AND WIRE BACK TO PANEL.
- 3 EXISTING RECEPTACLE, WIRE, AND CONDUIT TO BE REMOVED TO NEAREST J-BOX. MAINTAIN CIRCUIT CONTINUITY. PATCH WALL AS REQUIRED.
- $\langle 4 \rangle$ RELOCATE EXISTING CIRCUITS TO NEW EMERGENCY PANEL.


KEYED NOTES:

 $\left< 1 \right>$ TO ROOM LIGHTS AND SWITCH.


- 2 INSTALL EXISTING COVERS BACK ON TO PANEL "P1"
- 3 NEW POWER POLE FROM CEILING TO COUNTER. CENTER IN ISLAND. POWER POLE EQUAL TO WIREMOLD 3000 SERIES. PAINT POLE PER ARCHITECTS DIRECTION. FIELD INSTALL 1-RECEPTACLE ON BOTH NORTH AND SOUTH SIDES OF POWER POLE (2 TOTAL).


4 REFER TO ALTERNATES BE-1.0


 REVIVAL ARCHITECTURE P.O. Box 400, Scott, Arkansas 72142 (501) 951-3316 www.revivalarch.com S.D.G.
ARKANSAS REGISTERED PROTOSSIONAL AGENANA AGENANA PRESTON PRESTON D/26 22
INSIGHT INSIGH
PROJECT NAME: Mississippi County Health Units Blytheville
ISSUE DATE: August 26, 2022 Revisions:
Sheet Contents: BLYTHEVILLE PLAN - POWER AND SYSTEMS Sheet No

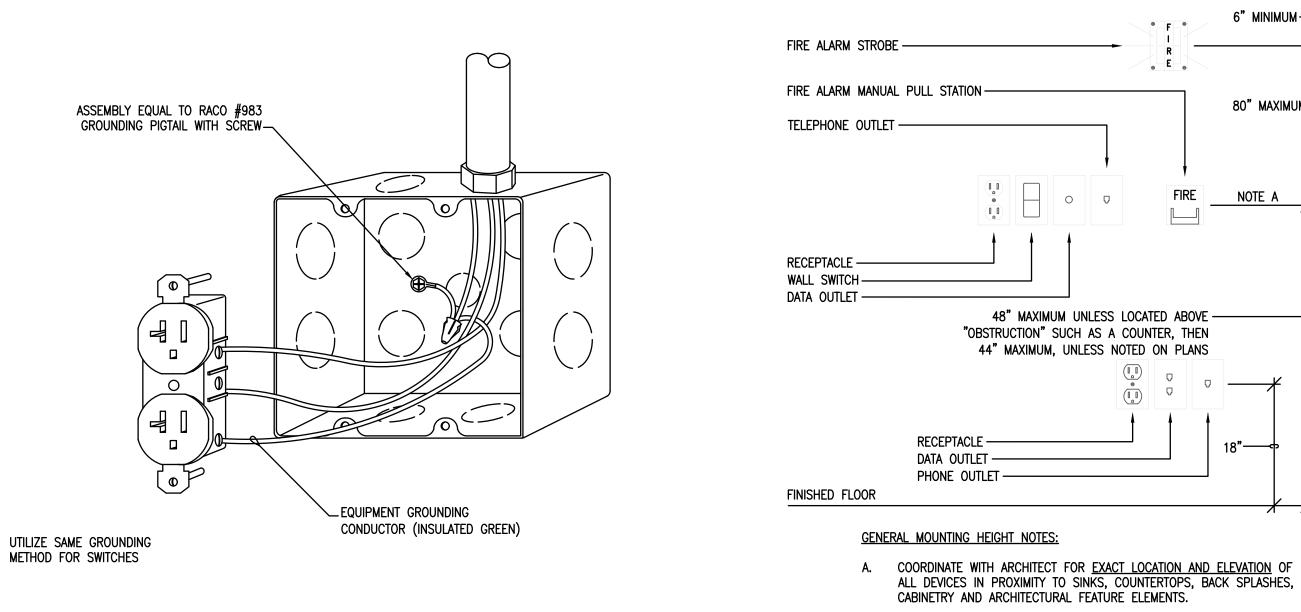


1 JUNCTION BOX GROUNDING DETAIL SCALE: NONE

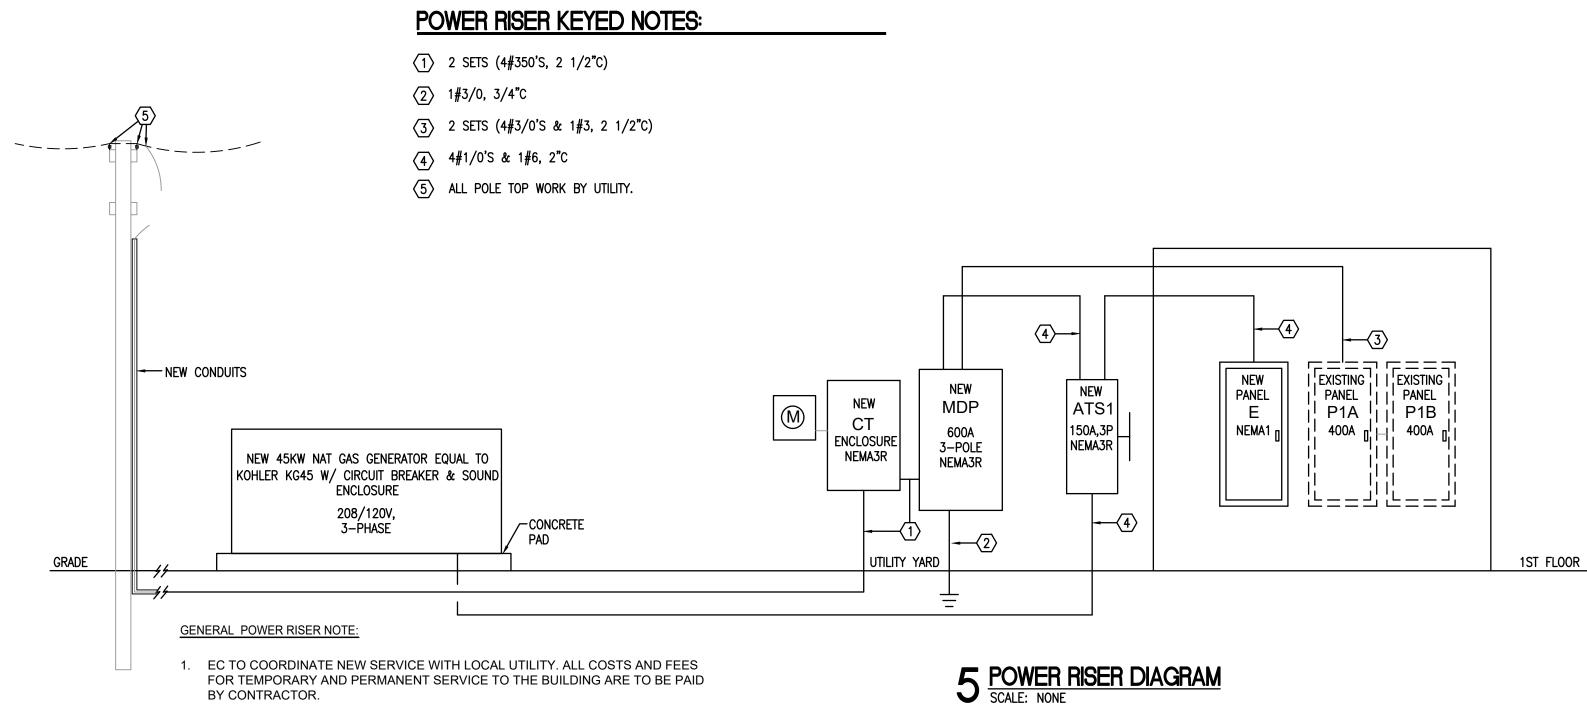

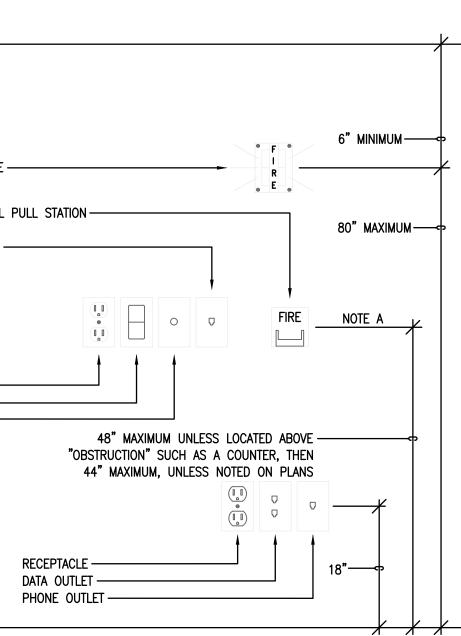

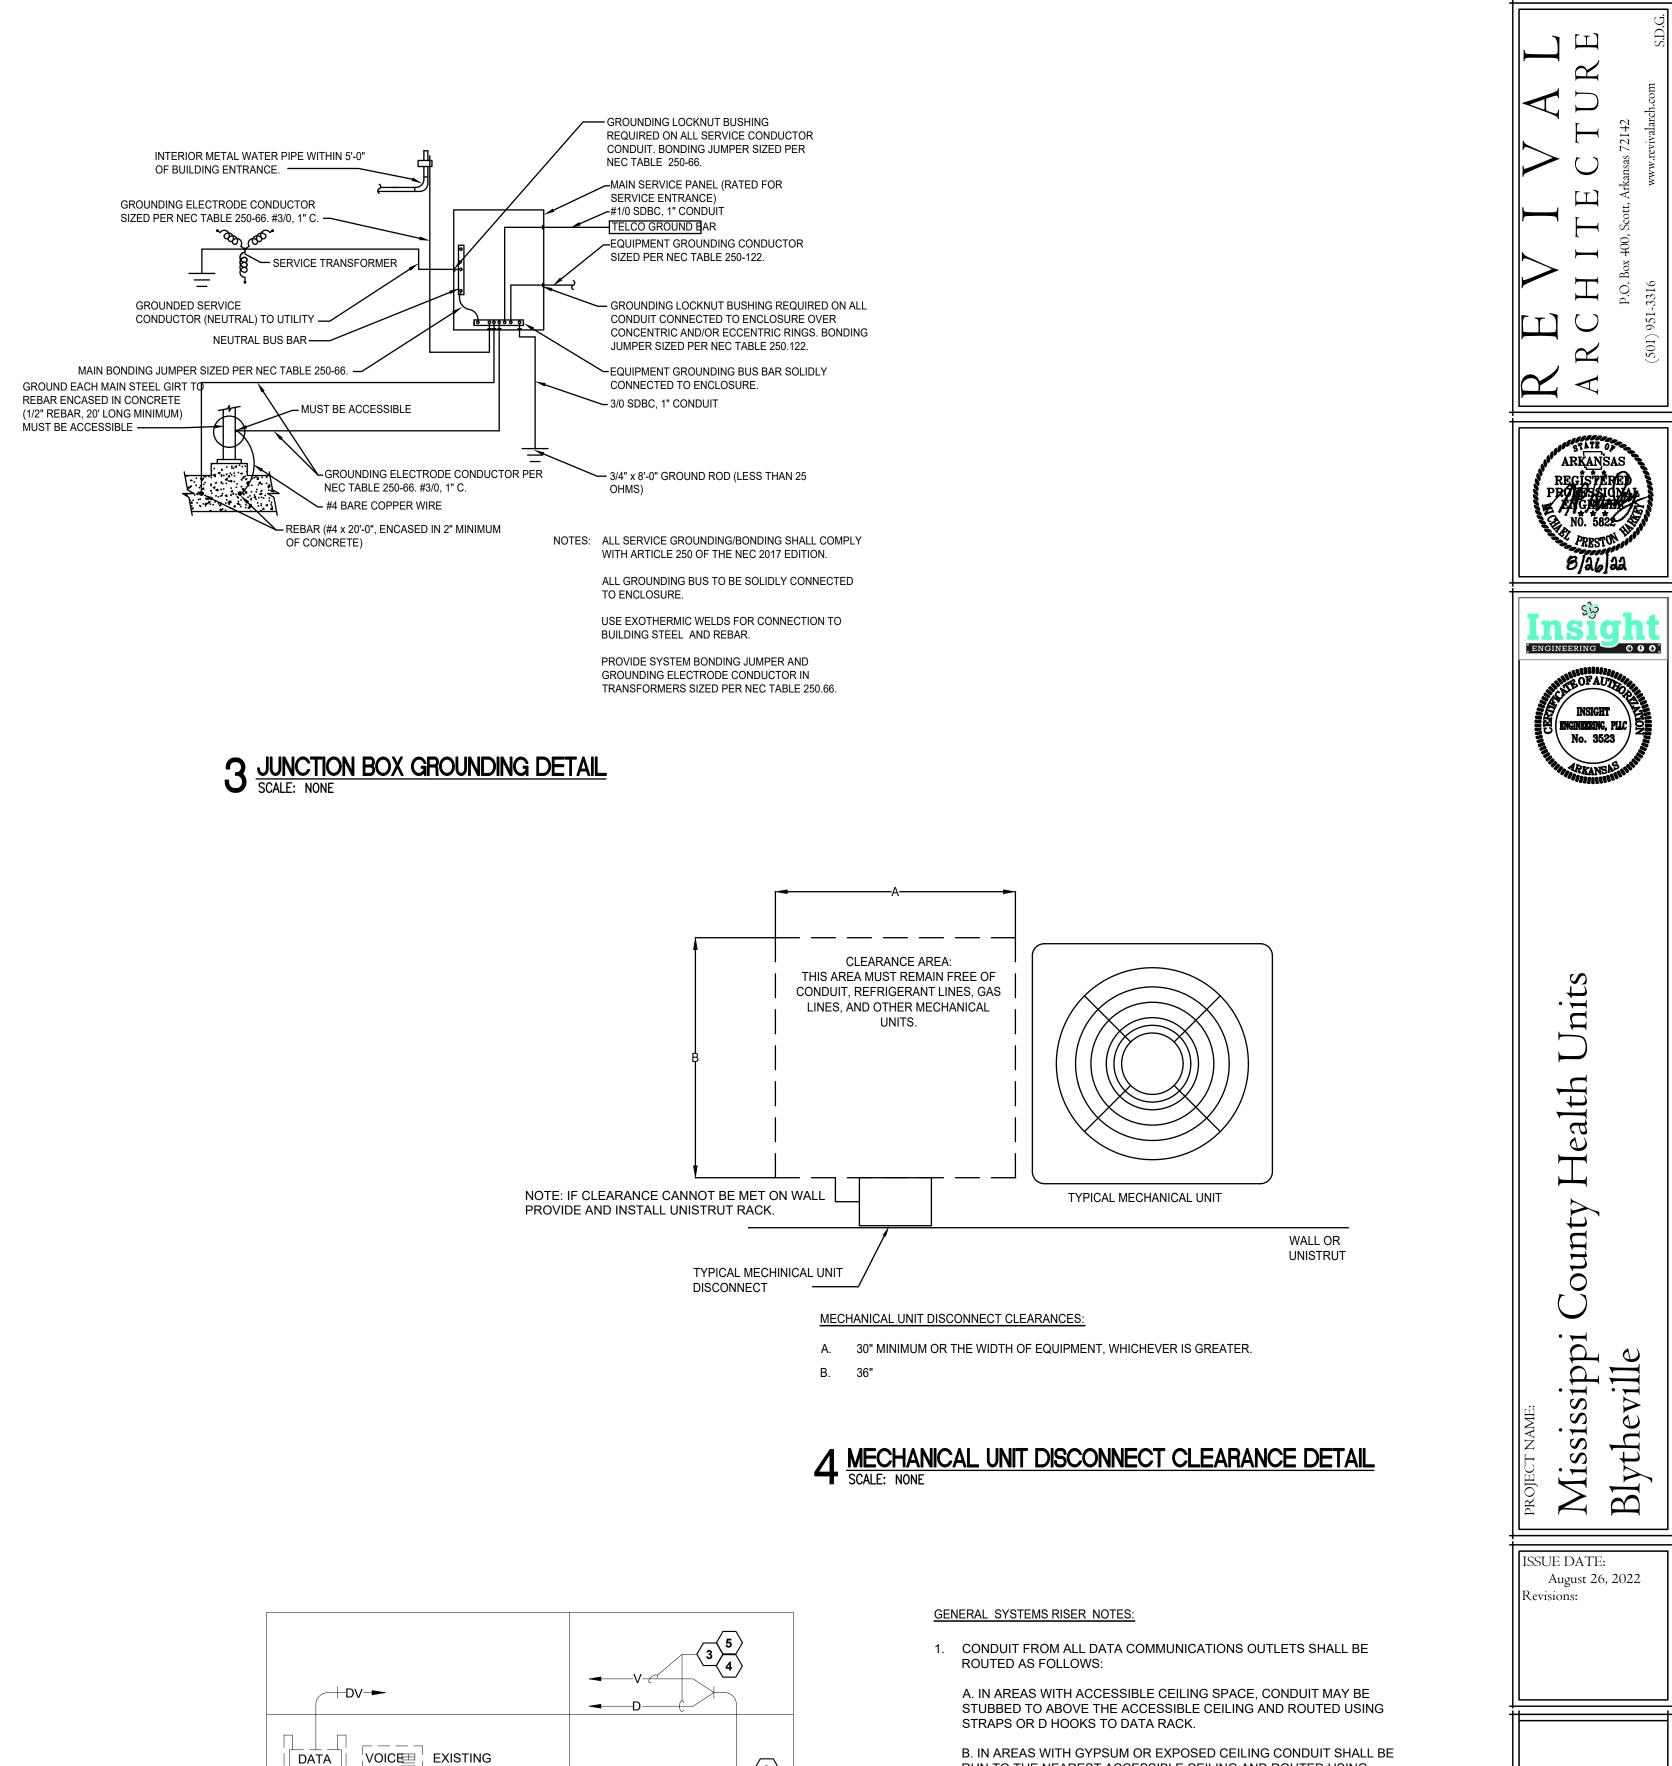

2 DEVICE MOUNTING HEIGHTS DETAIL SCALE: NONE

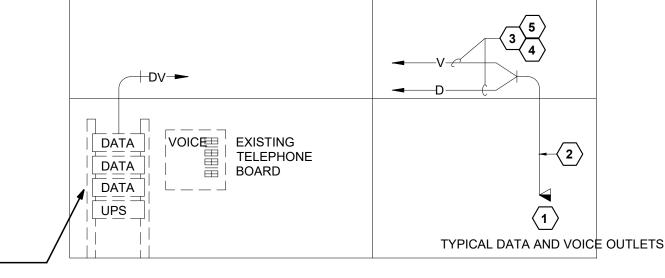



EXISTING

DATA

RACK-

RUN TO THE NEAREST ACCESSIBLE CEILING AND ROUTED USING STRAPS OR D HOOKS TO DATA RACK.

AND

Sheet Contents: ELECTRICAL DETAILS DIAGRAMS

Sheet No:

BE-2.1

2. PROVIDE APPROPRIATE 6'-0" (OR 2 METER) TERMINATED CATEGORY 6 JUMPER CABLE FOR EACH FIELD WIRED PORT IN PATCH PANELS

DATA / VOICE RISER KEYED NOTES:

- TYPICAL OUTLET. 1 VOICE AND 1 DATA OUTLET. PUNCH DOWNS AS REQUIRED.
- (2) MINIMUM CONDUIT DROP SIZE TO ALL DATA AND VOICE OUTLETS SHALL BE 1" AND SHALL EXTEND FROM OUTLET BOX TO ACCESSIBLE CEILING.
- 3 ROUTE ALL CABLES IN A NEAT & ORDERLY FASHION.
- $\langle 4 \rangle$ All voice conductors shall be category 6 and shall be routed to EXISTING PATCH PANELS IN RACKS. ALL VOICE CONDUCTORS SHALL BE CONNECTED TO VOICE PATCH PANELS IN RACKS AND CROSS CONNECTED TO EXISTING 110 BLOCKS. ALL CABLES SHALL BE PLENUM RATED. CABLE TO BE ROUTED IN STRAPS OR D HOOKS.
- 5 ALL DATA CONDUCTORS SHALL BE CATEGORY 6 AND SHALL BE HOME RUN TO EXISTING PATCH PANEL LOCATED IN EXISTING DATA RACK. SEE PLANS FOR LOCATION. ALL CABLES SHALL BE PLENUM RATED. CABLE TO BE ROUTED IN STRAPS OR D HOOKS.

PANELBOARD	MDP		·																I											Panel Am	perage:	600A
Voltage	120/208													ŀ	PANEL S	CHEDUI	LE													Panel A.I.	.C. Rating:	65kAIC
Phase	3-Y																				_									Main	600AMCB	
Mounting:	SURFACE								S:	S											S	S										
						S.	g	Ŋ	VIRE	SET	AWG				щ	щ				Ŋ	SET	VIRE	AWG	g	ទ							
						H	AM	SIZE AWG	P+N WIRES	P+N SETS	N N N	WIRES			MBE	MBE			RES	SIZE AWG	P+N SETS	P+N WIRES	E A/	AWG	GHE							
						<u>∠</u>	SIZE AWG	SIZ			SIZE	M	POLES		NN.	NN.	≞	POLES	MIN	SIZ			SIZE	SIZE	SIZE INCHES							
Rating	NEMA 3R					/ SIZ		NEUTRAL	СF ГОГ	NUMBER OF	GROUND	TOTAL	PC	R TRIP	CIRCUIT NUMBER	CIRCUIT NUMBER	R TR	P	TOTAL WIRES	GROUND :	NUMBER OF	N OF	NEUTRAL	Ы. S	/ SIZ							
	TTE IN COL		<u> </u>	LOAD		MA	PHASE	IEU1	BEF	MBE	BROI	ΙΎ		KEF	CIR	CIR	KEF		μ	ION:	MBE	BEF	EU	PHASE	WAY	· · · ·	LOAD		<u> </u>	,		
	DESCRIPTION		A	В	С	RACEWAY SIZE INCHES		Z	NUMBER	INN				BREAKER			BREAKER TRIP				I N	NUMBER			RACEWAY				-	D	ESCRIPTION	
			15908			<u> </u>									1	2	20	1	3	12	1	2	12	12	3/4	400			KITCHEN	AC RECE	PTACLES	
ATS				11932		1 1/4	1/0	1/0	4	1	6	5	3	150	3	4	20	1	3	12	1	2	12	12	3/4		1000		DISHWAS	HER		
					12192	1									5	6	20	1	3	12	1	2	12	12	3/4			1500	VENDING	MACHINE	1	
			37504												7	8	20	1	3	12	1	2	12	12	3/4	1500			VENDING	MACHINE	1	
PANEL P1				39288		2 1/2	3/0	3/0	4	2	3	5	3	400	9	10	20	1	3	12	1	2	12	12	3/4		1500		VENDING	MACHINE		
					28784]									11	12	20	1	3	12	1	2	12	12	3/4			1200	RECEPTA	CLES - CI	HECK IN	
GENSET BLOC	K HEATER		1500			3/4	12	12	2	1	12	3	1	20	13	14	20	1	3	12	1	2	12	12	3/4	1000			RECEPTA	CLES - RI	ESTROOM	
GENSET BATT	ERY CHARGER			500		3/4	12	12	2	1	12	3	1	20	15	16	20	1	3	12	1	2	12	12	3/4		1000		RECEPTA	CLES - CI	HECK IN	
WATER HEATE	ER					3/4	12	12	2	1	12	3	1	20	17	18	20	1	3	12	1	2	12	12	3/4			1500	RECEPTA	CLES -AT	TIC	
COPIER						3/4	12	12	2	1	12	3	1	20	19	20	20	1	3	12	1	2	12	12	3/4	1500			EXISTING	GENERA	TOR LIGHTING	3 CIRCUIT
NEW POWER	POLE					3/4	12	12	2	1	12	3	1	20	21	22	20	1											SPARE			
SPARE													1	20	23	24	20	1											SPARE			
SPARE													1	20	25	26	20	1											SPARE			
SPARE													1	20	27	28																
															29	30																
		TOTALS	54912	51720	40976																					4400	3500	4200	TOTALS			
PHASE A LOA PHASE B LOA PHASE C LOA TOTAL	D 55220 D 45176					MPS @	DAD		443																					_		

EXISTING	P1 120/208	-												PA	ANEL S	CHEDUL	E												F	Panel Am		400A 22K
Voltage Phase	3-Y	_										L																	F	Panel A.I. Main	400A MCB	22K
Mounting:	SURFACE	-						- T	ő				- 1					1				Ś							Ē			
						0	(5	g	WIRES	SETS	g				<u>س</u>	~				g	SETS	/IRE:	ğ	(5	G				Į			
						INCHES	AWG	E AWG	A N N+A	Z,	AM	ES			NUMBER	ABEI			WIRES	AWG	P+N S	P+N WIRES	E AWG	AWG	INCHES				ļ			
		_				Ц Ш	SIZE	SIZE	ف		SIZE	. WIRES	LES	₽.	NUN	MUN	۵.	LES	MN.	SIZE		ď	SIZE	SIZE	ЙШ				-			
Rating	NEMA 1	-				' SIZE		-RAL	ΥOF	ROF	ND	TOTAL	8	R TRIP	CIRCUIT	CIRCUIT	R TRI	P G	TOTAL	an	R OF	3 OF	-RAL		' SIZE				ŀ			
				LOAD		MA	PHASE	NEUT	NUMBER	NUMBER	GROUND	Ĕ		KE	CIR	CIR	AKEF		Ĕ	GROUND	NUMBER	NUMBER	NEUT	PHASE	MA		LOAD					
E	DESCRIPTION		Α	В	с	RACEWAY		-	NN	R				BREAKER			BREAKER				NN	NUN	-		RACEWAY	A	В	с	1	D	ESCRIPTION	
LIGHTS - FRON	T HALL LOBBY	,	1500			<u> </u>							1	20	1	2	20	1							-	1500			LIGHTING -	105,106,	107,112	
LOBBY - RECES	SS LIGHTING			1500									1	20	3	4	20	1									1500		LIGHTING 1	110-117		
FRONT LIGHTS					1500								1	20	5	6	20	1							-			1500	LIGHTING -	120-124		
LIGHTING - 108			1500										1	20	7	8	20	1							-	1500			LIGHTING -	125-130		
LIGHTING - 108	, 151-154			1500									1	20	9	10	20	1									1500		LIGHTING -	131-134	· · · · · ·	
LIGHTING - 108	0 HALL AT ATT	ïC			1500								1		11	12	20	1										1500	LIGHTING 1	140-147		
LIGHTING - 147	,148,149,150,1	65	1500										1		13	14	20	1							- 1	1500			RECEPTAC	LES - CL	ERICAL	4
LIGHTING - 156	-163			1500									1		15	16	20	1							-		1500		RECEPTAC	LES -		
RECEPTACLES	- N LOBBY				1500			_					1	20	17	18	20	1										1500	RECEPTAC	LES - 10		
RECEPTACLES			1500										1		19	20	20	1							-1	1500			RECEPTAC			· · · · ·
RECEPTACLES		,		1500				-		-+			1		21	22	20	1							-		1500		RECEPTAC			
RECEPTACLES	- 102				1500			-+					1		23	24	20	1										1500	RECEPTAC	LES - 112	,114,115	
RECEPTACLES	- 118		1500					-+					1		25	26	20	1							-1	1500			RECEPTAC			
RECEPTACLES				1500									1		27	28	20	1									1500		RECEPTAC			
RECEPTACLES	- 119				1500								1	20	29	30	20	1										1500	RECEPTAC	LES - 130	,131	
RECEPTACLES	- 118		1500		-								1	20	31	32	20	1							_	1500			RECEPTAC	LES - 127	,128,129,130	
RECEPTACLES	- 120,121, 122			1500									1	20	33	34	20	1									1500		RECEPTAC	LES - 13	,132,134	
RECEPTACLES	- 131,132,151,	152,153			1500								1	20	35	36	20	1										1500	RECEPTAC	LES - KIT	CHEN	
RECEPTACLES	- WEST 121		1500										1	20	37	38	20	1							_	1500			RECEPTAC	LES - KIT	CHEN	
RECEPTACLES	- 136, 137, 138	3		1500									1	20	39	40	20	1									1500		RECEPTAC	LES - 154	,156,157	
RECEPTACLES	- 154-162				1500								1	20	41	42	20	1										1500	RECEPTAC	LES - 159	,161,162	
RECEPTACLES	- 150,154,156		1500		-								1	20	1	2	20	1							_	1500			RECEPTAC	LES - SE	LAB	
RECEPTACLES	- 154-164			1500									1	20	3	4	20	1							-		1500		RECEPTAC	LES - RE	FRIG LAB	
RECEPTACLES	· · · · ·				1500								1	20	5	6	20	1							-			1500	RECEPTAC		·	
RECEPTACLES			1500		1000						-		1	20	7	8	20	1							-	1500		1000	RECEPTAC			
RECEPTACLES			1500	1500									1	20	9	10	20	1							-	1300	1500		RECEPTAC			
				1500											-										-		1500					
RECEPTACLES					1500	_							1		11	12	20	1							_			1500	TELEPHON	IE RECEP	TACLES	
RECEPTACLES	- 154-169		1500										1		13	14	20	1	3	12	1	2	12	12	3/4	1500			FC-1			
FC-2		;		1500									1	20	15	16	20	1	3	12	1	2	12	12	3/4		1500		FC-3			
FC-4					1500								1	20	17	18	20	1	3	12	1	2	12	12	3/4			1500	FC-5			
FC-6			1500										1	20	19	20	20	1	3	12	1	2	12	12	3/4	1500			FC-7			
-IP-1				2392		3/4	10		2	1	10	3	2	30	21	22	30	2	3	10	1	2	10		3/4		2392		HP-3			
					2392	3/4			۲	'	10	5	4	30	23	24	30			10	'	2	10		3/4			2392	1 -3			
	4. A	÷	2392												25	26		_				_				2392						s
HP-2				2392		3/4	10		2	1	10	3	2	35 -	27	28	35	2	3	10	1	2	10		3/4		2392		HP-4			
-								-+		-+					29	30													<u> </u>			
			3328					-+		-+		-+			31	32									-				<u> </u>			
HP-5				3328		3/4	10		2	1	10	3	2	40	33	34	70	2	3	10	1	1		8	3/4				HP-6			
- I				5020		<u> </u>	$\left \right $		\rightarrow				-		35	34	20/1								-				<u> </u>			
- 1			00000			<u> </u>							_					-							-				RECEPTAC			
HP-7			2392			3/4	10		2	1	10	3	2	35 -	37	38	20	1	<u> </u>											,∟E9 - AI		
k	1			2392											39	40	20	1							_				SPARE			
					ļ										41	42	20	1							_				SPARE			
		TOTALS	21612	22504	14392	J																			L	15892	16784	14392	TOTALS			
	WATTS	-			TOTAL A	MPS @	LOAD		293																							
PHASE A LOA PHASE B LOA	D 3750																															
PHASE C LOA TOTAL	D 2878	4																														
TOTAL	S 10557	ы																														


EXISTING BREAKER

+

NEW BREAKER	

TYPE	MANUFACTURER	CATALOG NUMBER	VOLTAGE	LAMP	COLOR	MOUNTING	NOTES
A1	COLUMBIA	RLW-4-35-XW-FA-W-EU	UNV	LED	35K	SURFACE	LED LINEAR WRAP
A1E	COLUMBIA	RLW-4-35-XW-FA-W-EU-ELL14	UNV	LED	35K	SURFACE	LED LINEAR WRAP
A2	COLUMBIA	RLW-4-35-MW-FA-W-EU	UNV	LED	35K	SURFACE	LED LINEAR WRAP
A2E	COLUMBIA	RLW-4-35-MW-FA-W-EU-ELL14	UNV	LED	35K	SURFACE	LED LINEAR WRAP
A3	COLUMBIA	RLW-4-35-LW-FA-W-EU	UNV	LED	35K	SURFACE	LED LINEAR WRAP
A3E	COLUMBIA	RLW-4-35-LW-FA-W-EU-ELL14	UNV	LED	35K	SURFACE	LED LINEAR WRAP
В	PRESCOLITE	LTR-4RD-H-SL15L-DM1 W/ LTR-4RD-T-SL-35K-WDS	UNV	LED	35K	RECESSED	4" ROUND LED DOWNLIGHT
BE	PRESCOLITE	LTR-4RD-H-SL15L-DM1-EM W/ LTR-4RD-T-SL-35K-WDS	UNV	LED	35K	RECESSED	4" ROUND LED DOWNLIGHT WITH EMERGENCY
C 1	BROWNLEE	5160-48-XX-H32-35K	UNV	LED	35K	WALL	48" LED VANITY
C2	BROWNLEE	5160-13-XX-H10-35K	UNV	LED	35K	WALL	13" LED VANITY
D	BROWNLEE	2680-30-50L-XX-XX-XX-35K	UNV	LED	35K	SURFACE	LED DRUM PENDANT
E	CURRENT	RWL1-48L-10-4K7-4W-120-XX-EH-PC	UNV	LED	40K	WALL	WALL MOUNT LED
F	BROWNLEE	2690-12-XX-H15-XXX-35K+DL6	UNV	LED	35K	PENDANT	LED PENDANT
G	AFX	KNLU40XX-35K	UNV	LED	35K	SURFACE	LED UNDERCABINET
Н	BROWNLEE	1260-XX-H10-EC1-35K	UNV	LED	35K	WALL	LED SCONCE
J	AFX	EGRF2440LAJD2WH	UNV	LED	40K	SURFACE	24" ROUND SURFACE MOUNT
X1	COMPASS	CELS1RNE	UNV	LED	NA	WALL	EXIT SIGN WITH BATTERY

LOAD B C		Main	A.I.C. Rating: MLO	
			MLO	
	_			
B C			DESCRIPTION	NC
	REFRIGE	ERATOR		
1500	REFRIGE	ERATOR		
1500) REFRIGE	ERATOR		
	REFRIGE	REFRIGERATOR		
1500	REFRIGE	ERATOR		
1500	REFRIGE	REFRIGERATOR		
	REFRIGE	ERATOR		·
1500	REFRIGE	ERATOR		
1500) REFRIGE	ERATOR		
	SPARE			
1440	EXISTINC	IG GEN LI	INDA CIRCUI	T
1440		IG GEN EX	XAM 44 CIRC	JUIT
	EXISTING	IG GEN OI	LD 43 CIRCL	ЛТ
	SPARE	,		
	SPARE			
5940 5940) TOTALS	5	1 1	
	1440	1440 EXISTIN EXISTIN SPARE SPARE	1440 EXISTING GEN E EXISTING GEN C SPARE SPARE	1440 EXISTING GEN EXAM 44 CIRC EXISTING GEN OLD 43 CIRCU SPARE SPARE

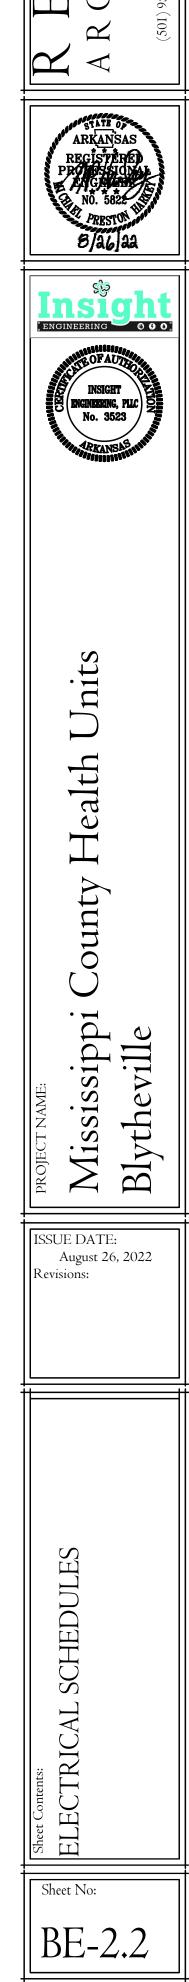


ГШ

К

 $[\mathbf{T}]$

			H\	AC LEGE	END
ABBREVIA	TION OR SYMBOL	DESCRIPTION	ABBREVIATION	OR SYMBOL	DESCRIPTION
AHU AFF AP BHP BTUH CFM CRAC D DB DN EA EAT ESP EWT FCU FLR FO FPM GPM HP KW LAT LWT MAU MAX MIN MHP NTS OSA PSI RA RH RPM RTU SA SP TYP VAV WB XFR ''' Ø	DRAIN DRY BULB TEMPERAT DOWN EXHAUST AIR ENTERING AIR TEMP EXTERNAL STATIC PI ENTERING WATER TH FAN COIL UNIT FLOOR FLAT OVAL FEET PER MINUTE (V GALLONS PER MINUT HORSEPOWER KILOWATT	DOR R NIT PER HOUR UTE R CONDITIONING UNIT URE ERATURE OF THE COIL RESSURE ENDERATURE R R E INCH NUTE DITIONING) UNIT ME	 24/24 RA 	GRILLE OR REGI DUCTWORK SIDEWALL SUPP RECTANGULAR E ROUND DUCT W	V/EXHAUST GRILLE STER ON BOTTOM OF LY (RETURN SIMILAR) DUCT WITH DUCT SIZE TAG ITH DUCT SIZE TAG H DUCT SIZE TAG OWN P OWN
2 M1.1	IEET NUMBER	N DESIGNATION R SENSOR. (SUBSCRIPT NTROLLED EQUIPMENT)	$ \begin{array}{c ccccccccccccccccccccccccccccccccccc$	RECTANGULAR/F FLEXIBLE DUCT (1) FIRE DAMPEI (2) SMOKE DAM (3) MOTORIZED (4) CONTROL DA (1) BALANCING (2) SMOKE DETE	R PER DAMPER AMPER DAMPER

* NOT ALL SYMBOLS MAY APPLY TO THIS PROJECT

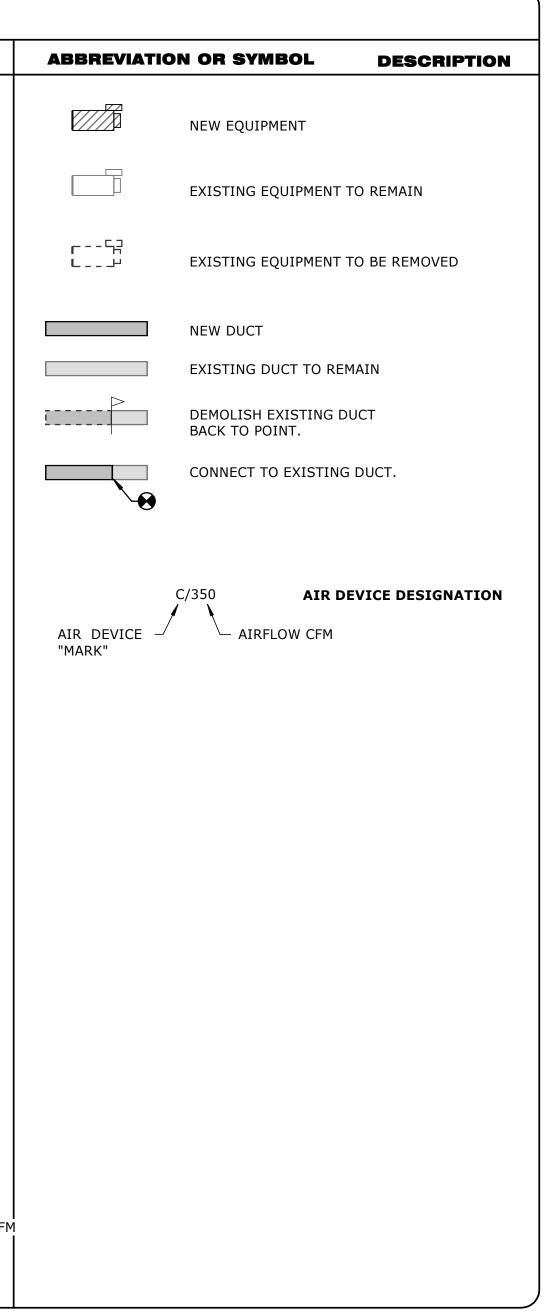

MECHANICAL GENERAL NOTES:

ALL MECHANICAL WORK SHALL COMPLY WITH ALL LOCAL CODES, DRAWINGS, SPECIFICATIONS, AND AUTHORITIES HAVING JURISDICTION. IF DISCREPANCIES ARE FOUND, THE MOST STRINGENT REQUIREMENT SHALL GOVERN WORK. WHERE INSPECTIONS ARE REQUIRED BY AUTHORITIES HAVING JURISDICTION, WORK MUST NOT BE CONCEALED UNTIL INSPECTIONS AND TESTING ARE COMPLETE AND WORK IS ACCEPTED.

REFER TO SPECIFICATION SHEETS FOR ADDITIONAL PROJECT INFORMATION.

REFER TO ALL PROJECT DRAWINGS FOR DETAILS OF CONSTRUCTION AND INSTALLATION REQUIREMENTS. PRIOR TO BID, CONTRACTOR SHALL BECOME THOROUGHLY FAMILIAR WITH THE REQUIREMENTS OF THESE NOTES AS WELL AS OTHER NOTES SHOWN ON THE CONTRACT DOCUMENTS. THESE DRAWINGS REFLECT A SYSTEM DESIGNED AROUND SPECIFIED REFERENCE PRODUCTS, THE SELECTION OF WHICH HAS INFLUENCED THE DESIGNS OF OTHER TRADES. IF SUBSTITUTE MANUFACTURERS, SIZES, OR MODEL NUMBERS ARE BID OR SUBMITTED, IT IS THE RESPONSIBILITY OF THE CONTRACTOR TO COORDINATE ALL DIFFERENCES PRIOR TO BID. ALL COSTS OF ALL TRADES ASSOCIATED WITH THE SUBSTITUTION SHALL BE INCLUDED IN THE BID. COORDINATION OF ALL MODIFICATIONS TO EACH DISCIPLINE WHICH RESULT FROM SUBSTITUTION OF EQUIPMENT OR MATERIALS SHALL BE THE RESPONSIBILITY OF THE CONTRACTOR.

SUBSTITUTIONS WHICH ARE INSTALLED AND SUBSEQUENTLY ARE PROVEN UNSATISFACTORY BY OWNER AND/OR ENGINEER WITHIN THE WARRANTY PERIOD, SHALL BE REMOVED COMPLETELY BY THE CONTRACTOR AND REPLACED WITH THE ORIGINAL DESIGN OR CORRECTED AS DIRECTED BY THE ENGINEER WITHOUT ADDITIONAL COST TO THE OWNER. ALL DRAWINGS ARE DIAGRAMMATIC AND INDICATE THE GENERAL ARRANGEMENTS OR GEOMETRICAL RELATIONSHIPS OF EQUIPMENT AND SERVICES. THEY ARE NOT INTENDED TO SPECIFY OR SHOW EVERY OFFSET, SEQUENCE, DEVICE, OPTION, FITTING, OR COMPONENT.

INFORMATION AND COMPONENTS ON DETAILS OR IN SPECIFICATIONS, BUT NOT SHOWN ON PLANS, AND VICE VERSA, SHALL BE PROVIDED AS IF EXPRESSLY REQUIRED BY BOTH CONTRACTOR SHALL NOT SCALE DRAWINGS. DRAWINGS SPECIFIC TO THIS DISCIPLINE DO NOT LIMIT THE RESPONSIBILITY OF WORK REQUIRED BY THE CONTRACT DOCUMENTS. EXACT LOCATIONS OF ALL EQUIPMENT, ROOF CURBS, DUCTS, DIFFUSERS, AND PIPING SHALL BE COORDINATED WITH OTHER TRADES. CEILING MOUNTED SPRINKLER, LIGHTING, AND 10. ELECTRICAL REQUIREMENTS TAKE PRECEDENCE OVER CEILING MOUNTED MECHANICAL REQUIREMENTS. SEE ARCHITECTURAL REFLECTED CEILING PLANS FOR CEILING GRID AND LIGHTING

LAYOUT FOR COORDINATION OF FINAL DIFFUSER LOCATIONS. SEE ARCHITECTURAL AND STRUCTURAL DRAWINGS FOR BUILDING DETAILS AND DIMENSIONS. COORDINATE PLACEMENT OF MECHANICAL SYSTEMS WITH ARCHITECTURAL AND STRUCTURAL 11. TRADES.

CONTRACTOR SHALL BE RESPONSIBLE FOR COORDINATING ALL WORK WITH THAT OF OTHER TRADES. REFER TO ALL CONSTRUCTION DOCUMENTS FOR COMPLETE INFORMATION PRIOR TO BID. ALL MECHANICAL CONSTRUCTION DETAILS SHALL BE AS SHOWN AND AS REQUIRED TO MAINTAIN "UL" ASSEMBLY RATINGS AS SHOWN ON ARCHITECTURAL SHEETS. SEAL AROUND ALL 13. PENETRATIONS THOROUGH UL RATED ASSEMBLIES, FIRE AND SMOKE WALLS. COORDINATE WITH GENERAL CONTRACTOR.

NO OTHER TRADES, I.E., ELECTRICAL, CEILING, PLUMBING, OR OTHER SYSTEMS SHALL BE SUSPENDED, HUNG, OR SUPPORTED FROM DUCTWORK OR PIPING. 14. CLOSELY COORDINATE FINAL LOCATIONS OF INSTALLED EQUIPMENT TO ACHIEVE THE GREATEST ACCESSIBILITY FOR MAINTENANCE PURPOSES. 15. CONTRACTOR SHALL VISIT THE SITE TO ESTABLISH THE EXISTING CONDITIONS PRIOR TO DUCT, PIPE OR EQUIPMENT FABRICATION. SYSTEMS SHALL BE ERECTED USING FIELD MEASUREMENTS 16. FOR COORDINATION WITH THE EXISTING EQUIPMENT, STRUCTURE, FIRE PROTECTION AND ELECTRICAL IN THE SPACE. CORE DRILL ALL PIPING PENETRATIONS OF CONCRETE WALLS AND FLOORS. 17.

CONTRACTOR SHALL FIELD VERIFY ALL PIPE ROUTING AND ADJUST ELEVATIONS AS REQUIRED TO AVOID CONFLICTS. FINAL PLACEMENT OF PIPING SHALL BE DETERMINED BY FIELD 18. MEASUREMENT AND VERIFICATION. ELEVATIONS ARE REFERENCED TO PIPE CENTERLINE UNLESS OTHERWISE NOTED. ALL EQUIPMENT, DEVICES, AND FIXTURES SHALL BE INSTALLED AS PER MANUFACTURER'S RECOMMENDATION.

- 20. OF NEW EQUIPMENT AS REQUIRED FOR A COMPLETE INSTALLATION.
- PROVIDE FLEXIBLE CONNECTIONS AND TRANSITIONS ON DUCT INLET AND OUTLET CONNECTIONS TO ALL EQUIPMENT WITH MOVING PARTS. 22. DETAILS TO PROVIDE COMPLETE PIPING SYSTEMS.
- COORDINATE WORK CLOSELY WITH CONTROL REQUIREMENTS. PROVIDE ALL NECESSARY DUCT TAPS, PIPE TAPS, WELLS, AND OTHER APPURTENANCES REQUIRED BY CONTROL SYSTEM. PROVIDE SPARE PIPE WELL ADJACENT TO EACH TEMPERATURE SENSOR IN PIPING.
- DEVICES WITH MOUNTING SYSTEM DESIGNED FOR MOUNTING SURFACE TYPE. 25.
- REQUIRED TO BE MOUNTED ON AN EXTERIOR WALL SHALL BE MOUNTED ON AN INSULATED PAD. PROVIDE CONCRETE PADS FOR ALL GROUND MOUNTED EQUIPMENT 26.
- 27. REPLACE ALL ARCHITECTURAL FEATURES REMOVED OR DAMAGED DURING THE COURSE OF THE WORK. 28.
- REFER TO SPECIFICATION SHEET FOR INSULATION AND R-VALUES FOR MECHANICAL PIPING AND DUCTWORK INSULATION. 29.
- 30. SPECIFICALLY SHOWN ON ELECTRICAL SCHEDULE, HVAC FIXTURES REQUIRING ELECTRICAL SERVICE SHALL BE FED FROM BREAKER OF ADEQUATE CAPACITY.

ALL CONTROL WIRING SHALL BE INSTALLED IN CONDUIT. 31. 32. PROVIDE ALL HVAC UNITS WITH AN EXTRA SET OF MANUFACTURER'S RECOMMENDED FILTERS AFTER PROJECT COMPLETION.

DEMOLITION/RENOVATION GENERAL NOTES

- DEMOLITION DRAWINGS FOR ADDITIONAL INFORMATION AND DEMOLITION SCOPE OF WORK.
- IF, DURING DEMOLITION, IT BECOMES NECESSARY TO TEMPORARILY REMOVE ANY EQUIPMENT, PIPING, OR OTHER SYSTEM WHICH IS NOT SPECIFICALLY NOTED TO BE REMOVED (THEREBY
- PATCH ALL OPENINGS IN WALLS, FLOORS, AND CEILINGS WHERE DUCT, PIPING, AND CONTROLS HAVE BEEN REMOVED TO MATCH EXISTING.
- CONTRACTOR TO THE SATISFACTION OF THE OWNER AND ENGINEER WITHOUT ADDITIONAL COST TO THE OWNER. MAINTAIN THE SECURITY OF THE BUILDING AT ALL TIMES. REMOVE ALL EXISTING SUPPORTS ASSOCIATED WITH EQUIPMENT, DUCTWORK, AND PIPE BEING REMOVED UNLESS NOTED OTHERWISE.
- DISPOSE OF ALL REMOVED EQUIPMENT AS DIRECTED BY THE OWNER. 8 CONTRACTOR SHALL COORDINATE REMOVAL OF UTILITY SERVICES WITH UTILITY COMPANIES AND LOCAL AUTHORITIES AND PAY ALL FEES. 9.

SCHEDULE UTILITY WORK WITH OWNER TO KEEP TO A MINIMUM ACCEPTABLE DOWNTIME AND TO NOT INTERFERE WITH THE BUILDING OPERATIONAL SCHEDULE, IF POSSIBLE. 10. MAINTAIN THE FIRE AND SMOKE CONSTRUCTION INTEGRITY OF THE EXISTING BUILDINGS. 11. DO NOT VENT REFRIGERANT TO ATMOSPHERE. RECOVER REFRIGERANT FOR REUSE USING ASHRAE RECOMMENDED PROCEDURES. 12.

- 13. THE ARCHITECT.
- DEMOLITION AND SHUTDOWN OF EXISTING HVAC SYSTEMS THAT WILL AFFECT PORTIONS OF THE BUILDING OUTSIDE OF PROJECT AREA SHALL BE COORDINATED WITH OWNER'S 14. WORK REQUIRED IN OCCUPIED AREAS OUTSIDE OF THE FLOOR AREA SHALL BE SCHEDULED WITH THE OWNER 48 HOURS IN ADVANCE.
- 15. WITH STRUCTURAL DRAWINGS. 16.
- REPRESENTATIVE IMMEDIATELY. 17.
- ALL CONNECTIONS TO EXISTING SYSTEMS AND SYSTEM SHUT-DOWNS WITH OWNER'S REPRESENTATIVE.
- SATISFACTION OF THE OWNER WITHOUT ADDITIONAL COST TO THE OWNER.

CONTRACTOR SHALL VERIFY CLOSELY AT SITE TRANSPORTATION OF NEW HVAC EQUIPMENT INTO MECHANICAL AREAS BEFORE BIDDING. PROVIDE COMPLETE DISASSEMBLY AND RE-ASSEMBLY

NOT ALL REQUIRED PIPING, VALVES, OR FITTINGS ARE SHOWN ON DRAWINGS FOR CLARITY. COORDINATE PLAN DETAILS WITH SPECIFICATIONS, SCHEMATICS, FLOW DIAGRAMS, AND OTHER

REFER TO ARCHITECTURAL PLANS FOR CEILING GRILLE AND DIFFUSER LOCATIONS, FOR CEILING TYPE, AND FOR MOUNTING REQUIREMENTS. CONTRACTOR SHALL PROVIDE AND INSTALL ALL AIR

COORDINATE FINAL PLACEMENT OF ALL THERMOSTATS WITH WALL-MOUNTED DEVICES AND OWNER'S REPRESENTATIVE. MOUNT PER A.D.A. REQUIREMENTS. ANY THERMOSTAT THAT IS

CONTRACTOR SHALL PATCH ALL WALLS, FLOORS, AND CEILINGS TO MATCH NEW FOR ALL OPENINGS CREATED BY INSTALLATION OF EQUIPMENT AND HVAC SERVICE PENETRATIONS. ALL HVAC COMPONENTS WITH ELECTRICAL REQUIREMENTS SHALL BE INSTALLED WITH ELECTRICAL INFRASTRUCTURE NECESSARY TO PROVIDE A FULLY FUNCTIONING SYSTEM. IF NOT

THE MECHANICAL RELATED DEMOLITION WORK INDICATED ON THE PLANS, SPECIFICATIONS, AND NOTES IS TO BE CLOSELY COORDINATED WITH THE OWNER'S REPRESENTATIVE. NO DEMOLITION SHALL TAKE PLACE IN ANY AREA OR BUILDING UNTIL THE CONTRACTOR HAS BEEN GIVEN APPROVAL TO PROCEED IN THAT SPECIFIC LOCATION. REFER TO ARCHITECTURAL

IMPLYING THAT THEY ARE TO BE LEFT FOR FUTURE USE), THE CONTRACTOR SHALL REINSTALL SAID SYSTEMS TO FULLY OPERABLE CONDITION IN THEIR ORIGINAL LOCATIONS. ALL DEMOLITION WORK SHALL BE SCHEDULED WITH THE OWNER'S REPRESENTATIVE AT LEAST 48 HOURS PRIOR TO THE WORK.

ANY DAMAGE TO THE OWNER'S PROPERTY, BUILDING, EXISTING SYSTEMS, OR EOUIPMENT RESULTING FROM THE CONTRACTOR'S OPERATIONS SHALL BE REPAIRED OR REPLACED BY THE


EXISTING EQUIPMENT SHALL BE RELOCATED AS NECESSARY FOR THE INSTALLATION OF THE NEW SYSTEMS. METHODS AND POSITIONS OF THE RELOCATIONS SHALL HAVE PRIOR APPROVAL OF

REPRESENTATIVE AND PLANNED TO LIMIT INCONVENIENCE AND DISRUPTION OF BUILDING OPERATIONS AS MUCH AS POSSIBLE. WORK SHALL BE PHASED ACCORDINGLY. PLUMBING OR HVAC THE EQUIPMENT LOCATIONS SHOWN ON THE DRAWINGS ARE APPROXIMATE. THE FINAL LOCATIONS SHALL BE ESTABLISHED IN THE FIELD TO BEST FIT THE AVAILABLE SPACE. COORDINATE

INSPECT THE EXISTING SYSTEM; ANY EXISTING EQUIPMENT, DUCTS, OR PIPING FOUND TO BE DAMAGED OR NON-OPERABLE SHALL BE BROUGHT TO THE ATTENTION OF THE OWNER'S

PHASE DEMOLITION AND RENOVATION WORK TO MAINTAIN EXISTING BUILDING AS REQUIRED BY BUILDING OWNER/OCCUPANTS. PROVIDE TEMPORARY SERVICES AS REQUIRED. 18. WORK REQUIRED IN THE AREAS OUTSIDE OF THE FLOOR AREA FOR PLUMBING OR HVAC WORK SHALL BE SCHEDULED WITH THE OWNER 48 HOURS IN ADVANCE. COORDINATE AND SCHEDULE 19. ANY DAMAGE TO THE EXISTING BUILDING, STRUCTURE, FINISHES, OR ARCHITECTURAL FEATURES CAUSED BY THE CONTRACTOR'S OPERATIONS SHALL BE REPAIRED OR REPLACED TO THE

<u> </u>	-
REUTECTURE ARCHITECTURE P.O, Box 400, Scott, Arkansas 72142 501-951-3316 www.revivalarch.com SD.G.	+
STATE OF ARKANSAS HICENSED JU PROFESSIONAL ENGINEER No. 20514 No. 20514	
Protections Prote	
ISSUE DATE August 26, 2022 REVISIONS 1 10/28/22 REBID	
SHEET CONTENTS: MECHANICAL NOTES AND LEGEND SHEET NO.	+

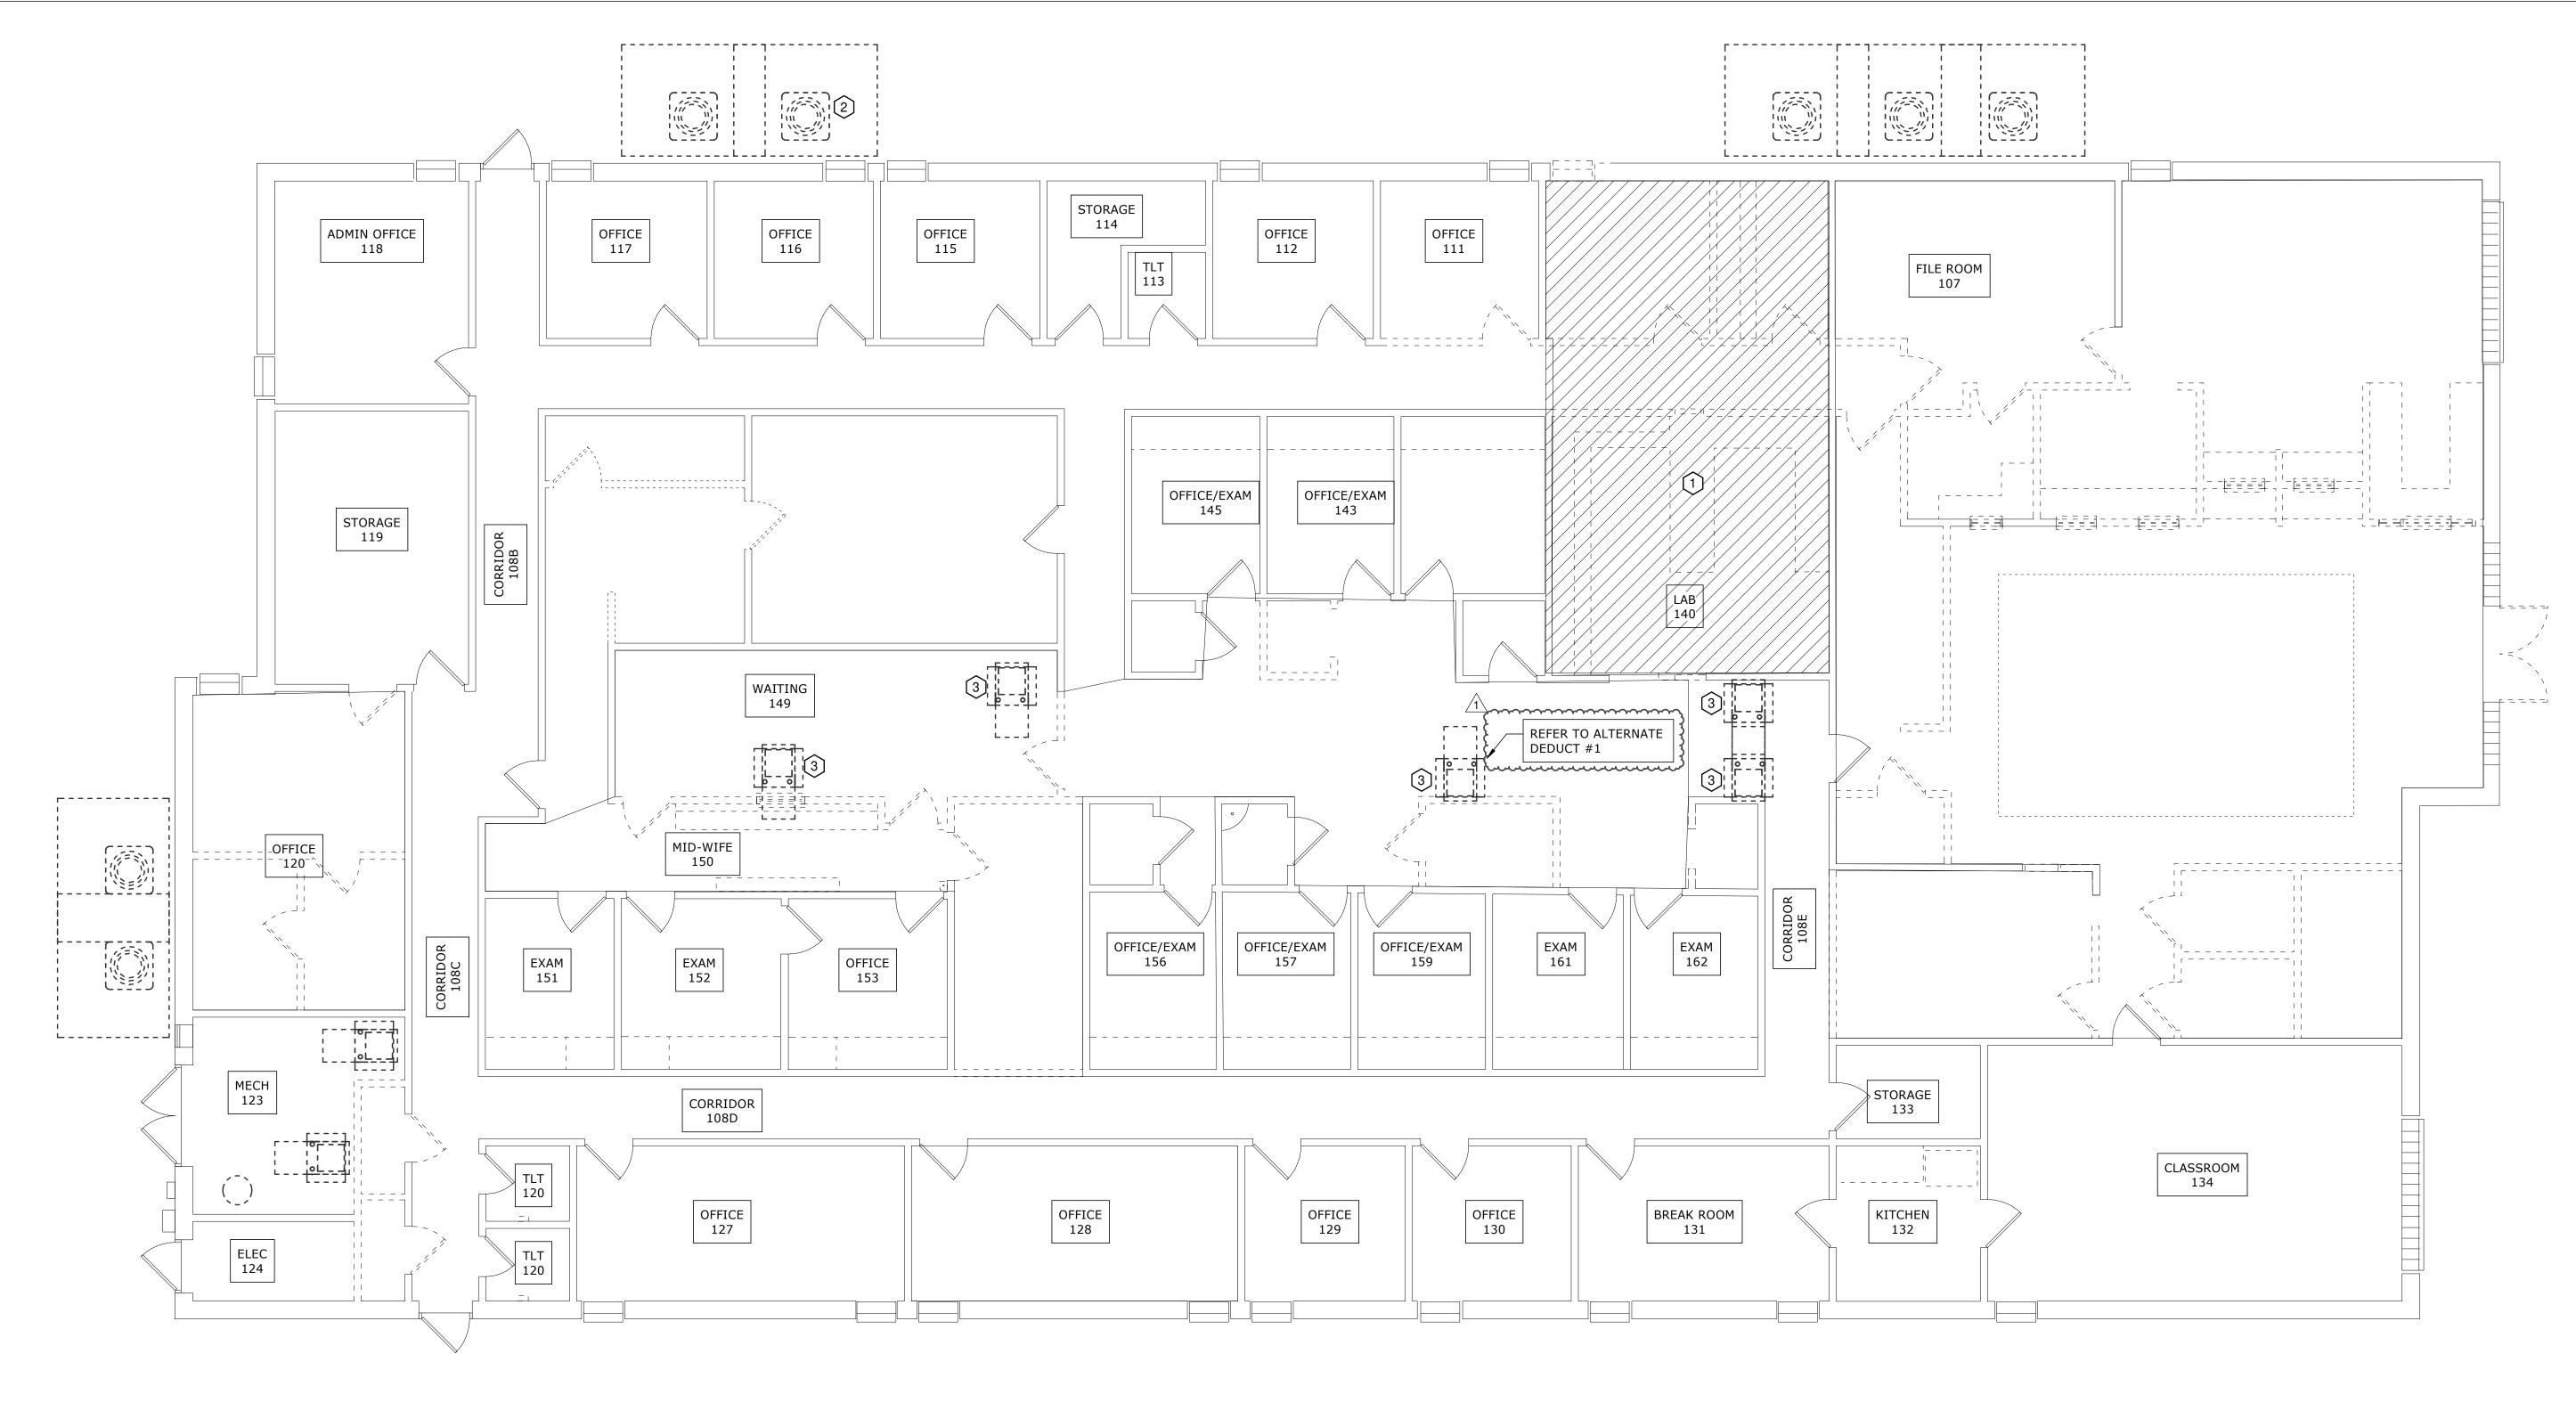

DEMO HVAC PLAN - BLYTHEVILLE 1 3/16" = 1'-0"




GENERAL NOTES

1.


KEYED NOTES

- 2. 3.

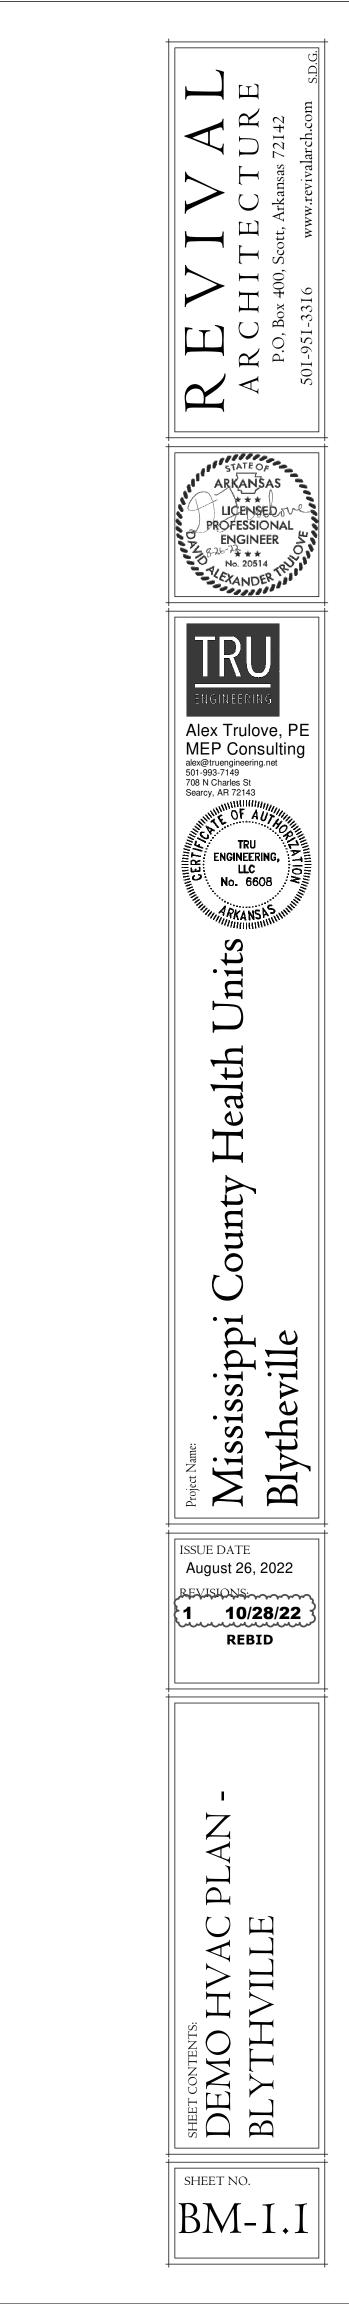

REMOVE COMPLETE EXISTING CONDENSING UNITS AND FURNACES. REMOVE ALL ASSOCIATE CONTROL WIRING, THERMOSTATS, REFRIGERANT PIPING. ALL DUCTWORK AND PLENUMS SHALL REMAIN. CAP EXISTING NATURAL GAS LINES FEEDING FURNACE UNIT.

1. AREA TO BE SERVED BY NEW EQUIPMENT. REMOVE AIR TERMINALS AND ASSOCIATED BRANCH DUCTWORK BACK TO MAIN. CAP EXISTING DUCTWORK AT DUCT MAIN. EXISTING EQUIPMENT TO BE DEMOLISHED, TYPICAL ALL. FURNACE UNITS LOCATED IN ATTIC ABOVE.

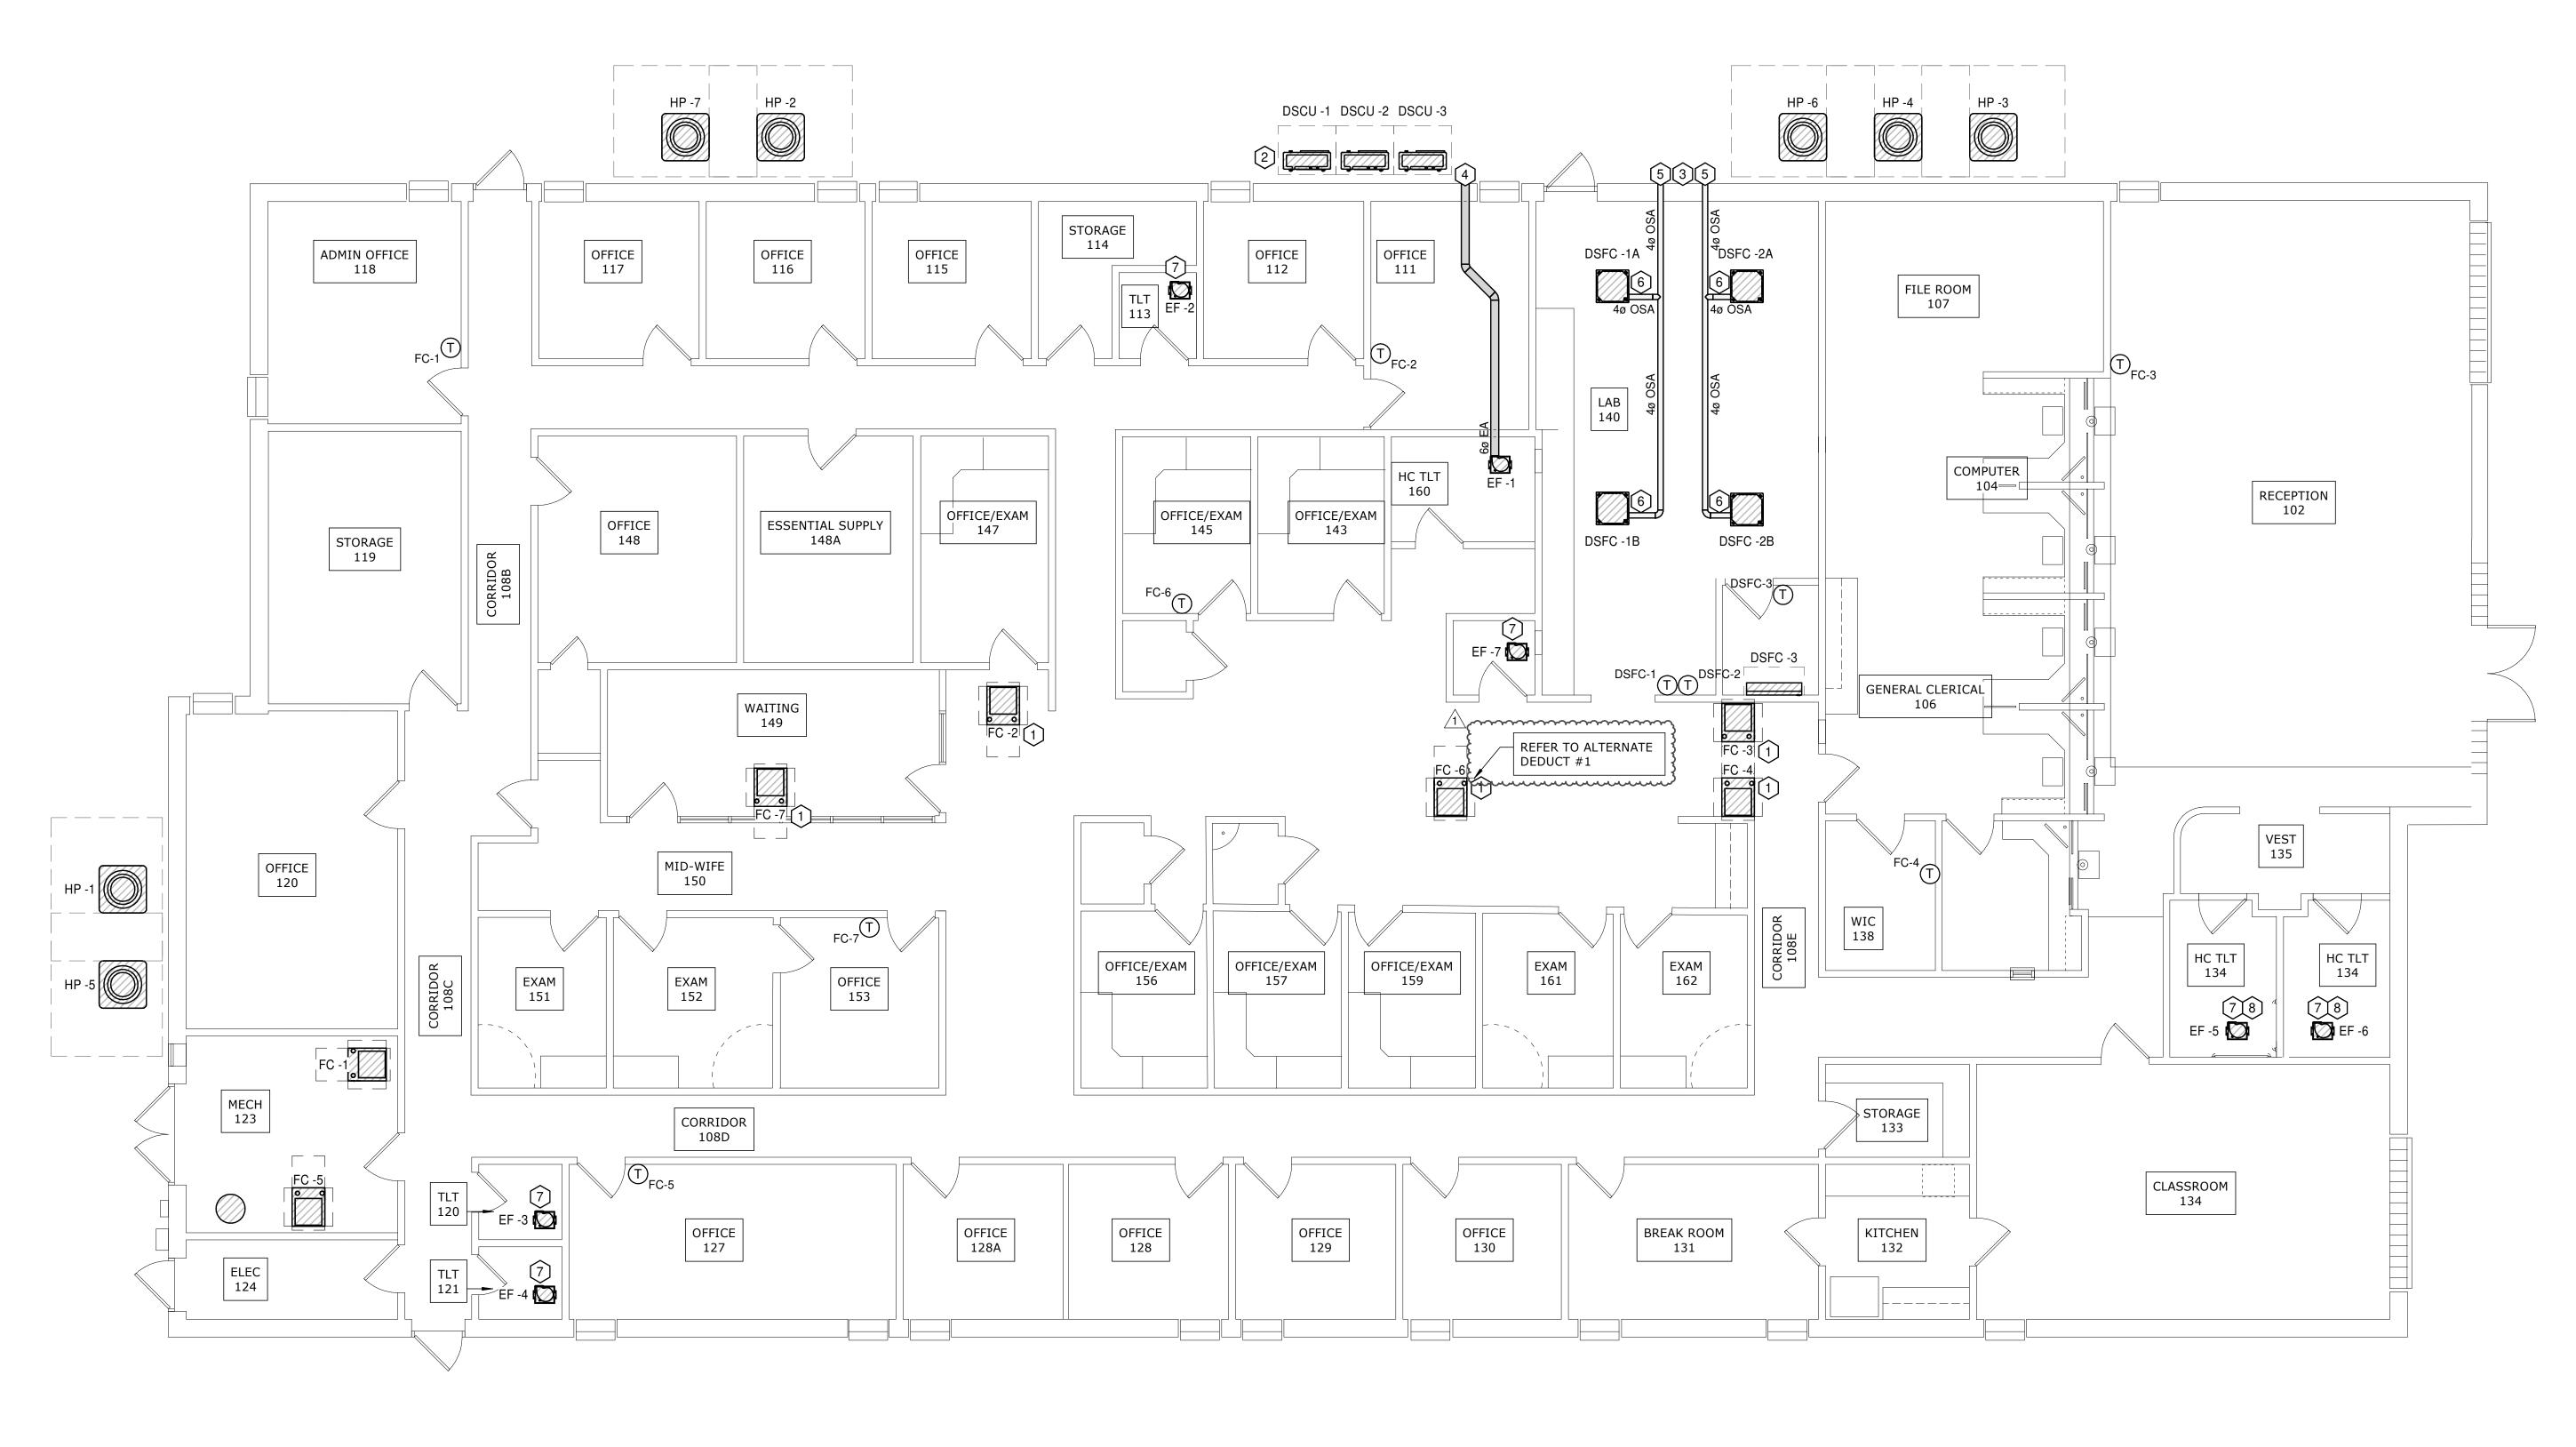



GENERAL NOTES

- 1. NEW UNIT CONDENSATE SHALL DISCHARGE TO EXISTING DRAIN LOCATIONS.
- 2. NEW THERMOSTATS SHALL BE MOUNTED NEXT TO LIGHT SWITCH OF ASSOCIATED ROOM. TOP OF THERMOSTAT SHALL BE ALIGNED WITH TOP OF LIGHT SWITCH FACE PLATE.


CONTROL NOTES


ALL CONTROLS SHALL BE STAND-ALONE. THERMOSTATS SHALL BE PER EQUIPMENT MANUFACTURER'S RECOMMENDATION, 7-DAY PROGRAMMABLE, WALL-MOUNTED (NON-REMOTE), AND WI-FI ACCESSIBLE. THERMOSTAT SHALL BE INITIALLY SET TO READ OFF OF RETURN DUCT TEMPERATURE SENSOR.

KEYED NOTES

- 1. UNIT MOUNTED IN ATTIC SPACE.
- 2. PROVIDE NEW 6" CONCRETE SERVICE PAD FOR MINI-SPLIT CONDENSERS.
- 3. ROUTE DSFC CONDENSATE TO 1" GRAVITY MAIN IN ATTIC SPACE. GRAVITY MAIN SHALL BE ROUTED TO EXTERIOR WALL, ROUTED DOWN INSULATED SIDE OF WALL, AND DISCHARGE TO LANDSCAPED AREA 18" ABOVE GRADE.
- 4. ROUTE EXHAUST DUCTWORK TO WALL CAP. REFER TO MECHANICAL DETAILS FOR ROOF JACK REQUIREMENTS.
- 5. ROUTE NEW OSA DUCTWORK TO EXTERIOR WALL AND TERMINATE WITH WALL CAP WITH INSECT SCREEN EQUAL TO COOK. PAINT PER ARCHITECT.
- BALANCE TO 15 CFM.
 REPLACE EXISTING EXHAUST FAN WITH NEW. NEW EXHAUST FAN TO CONNECT TO EXISTING EXHAUST
- DUCTWORK. 8. EXTEND EXISTING DUCTWORK AS REQUIRED TO NEW EXHAUST FAN LOCATION.



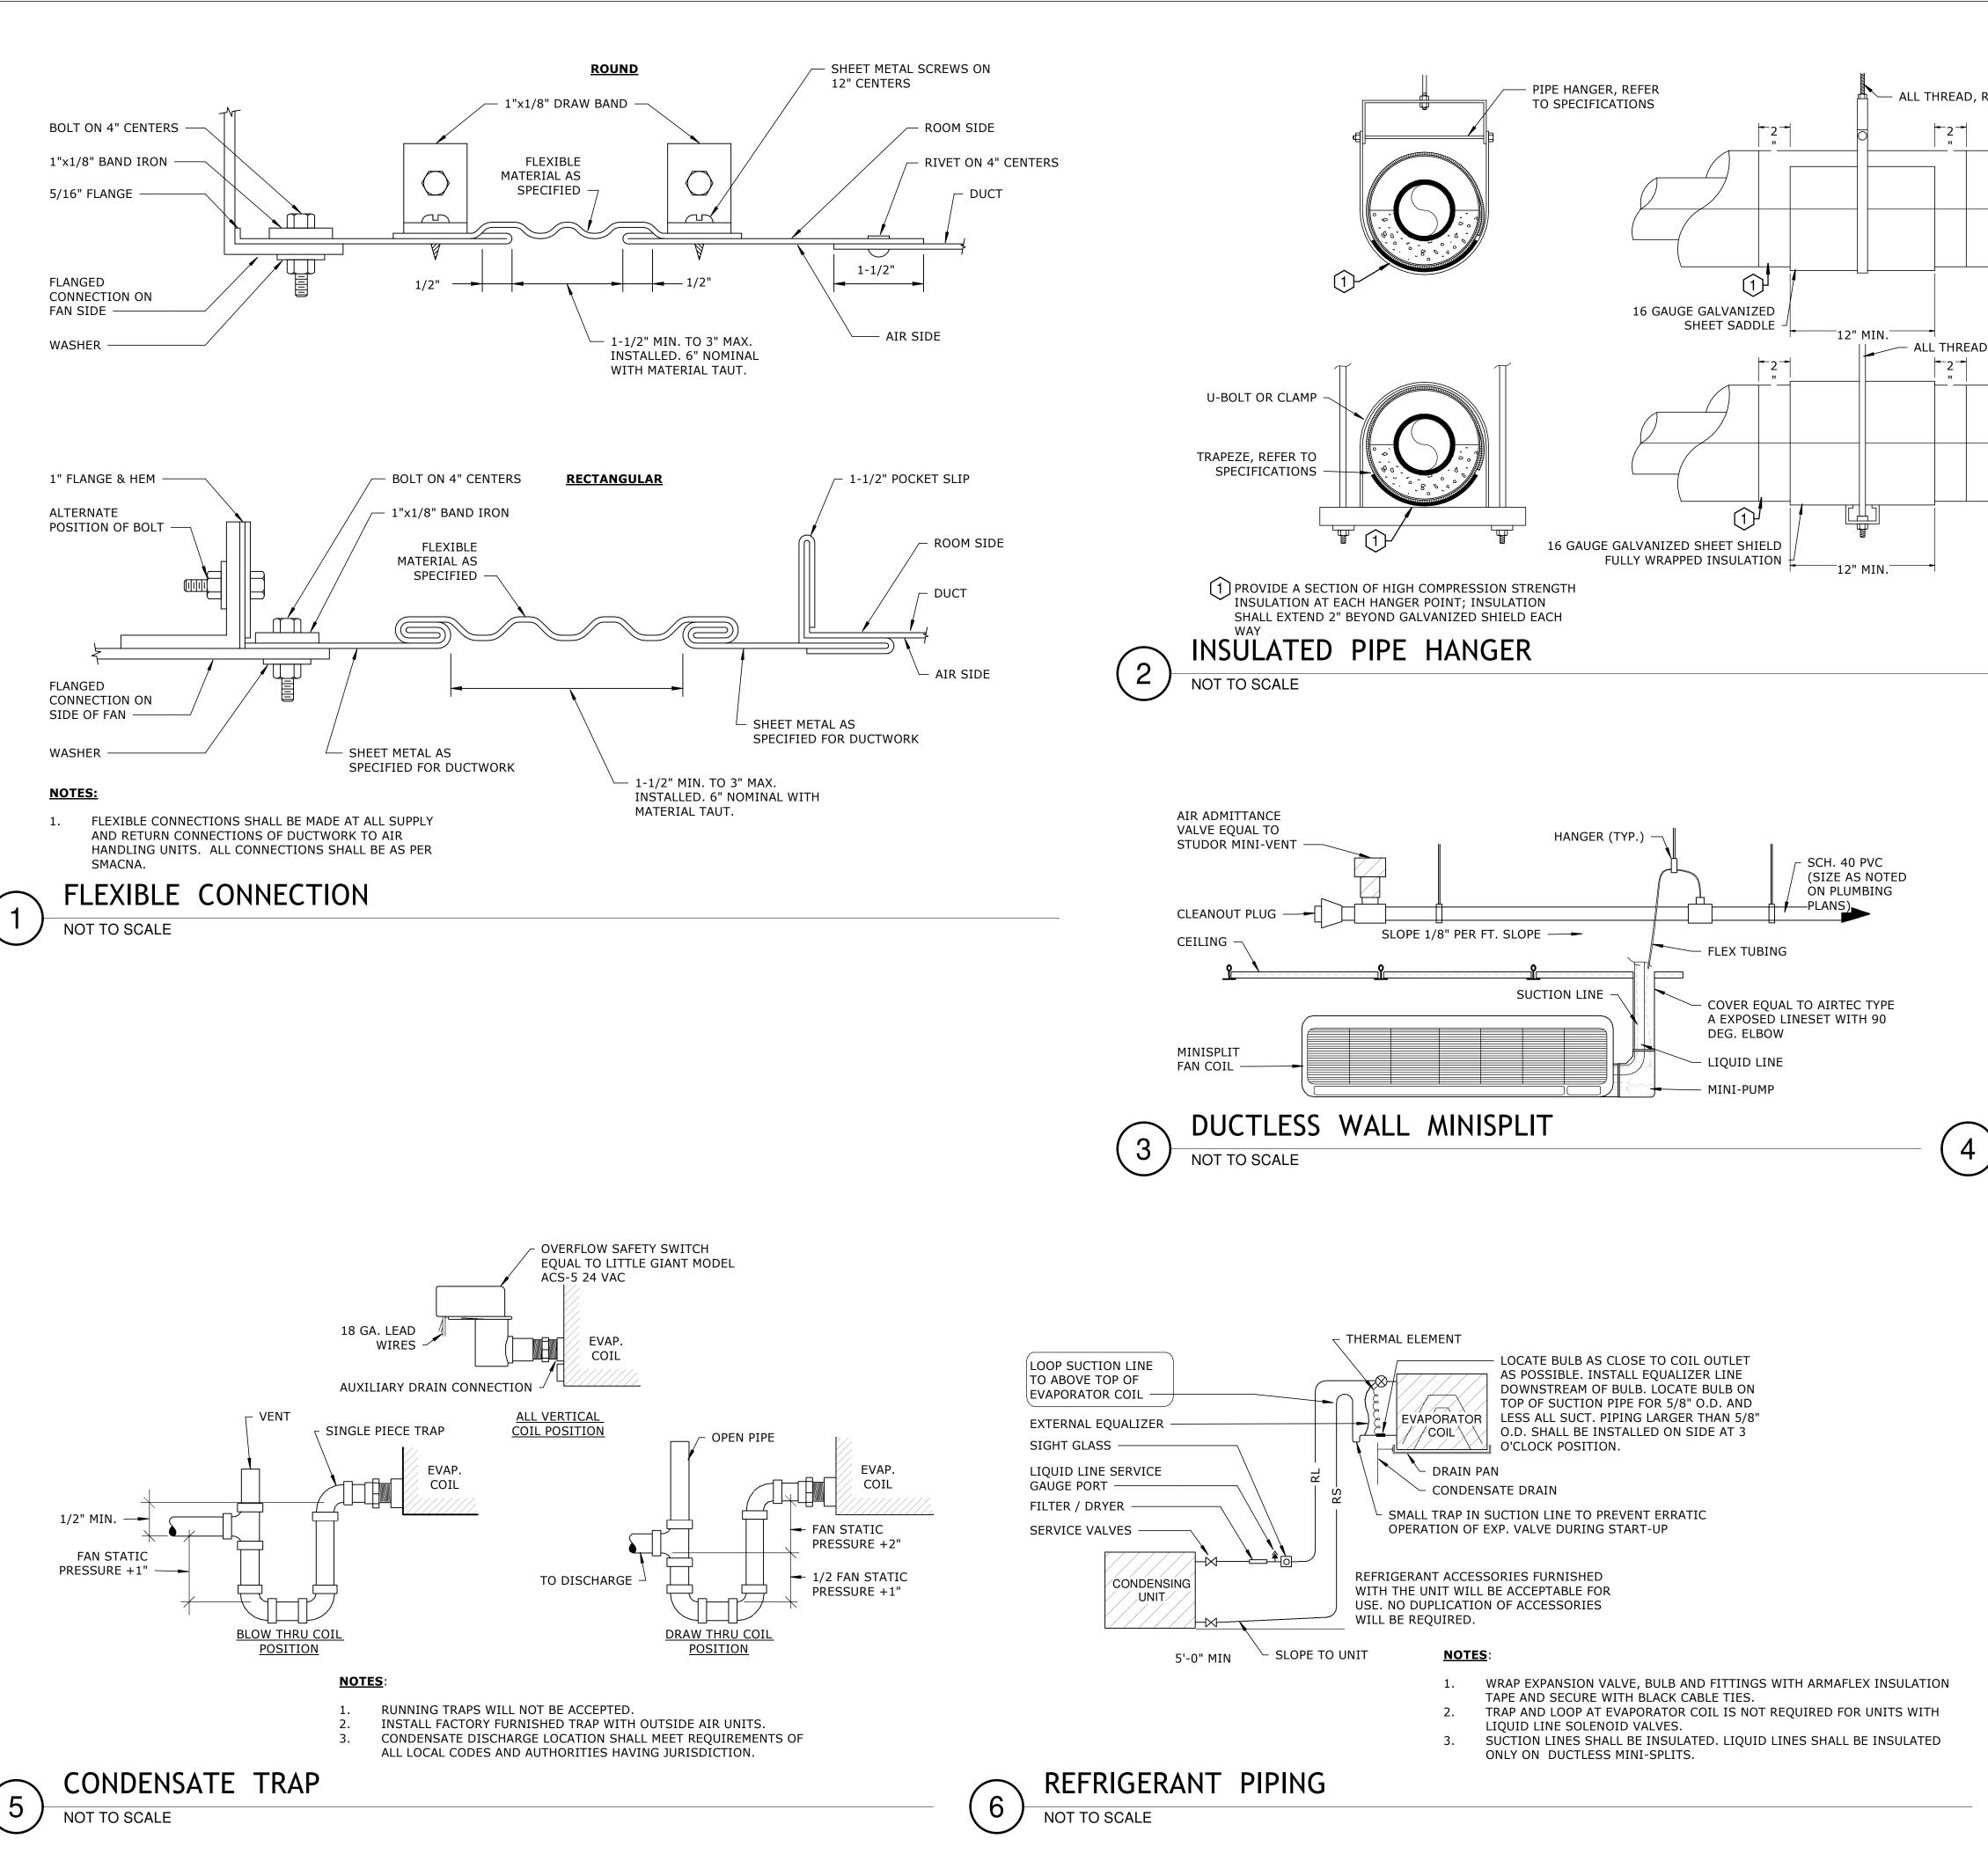

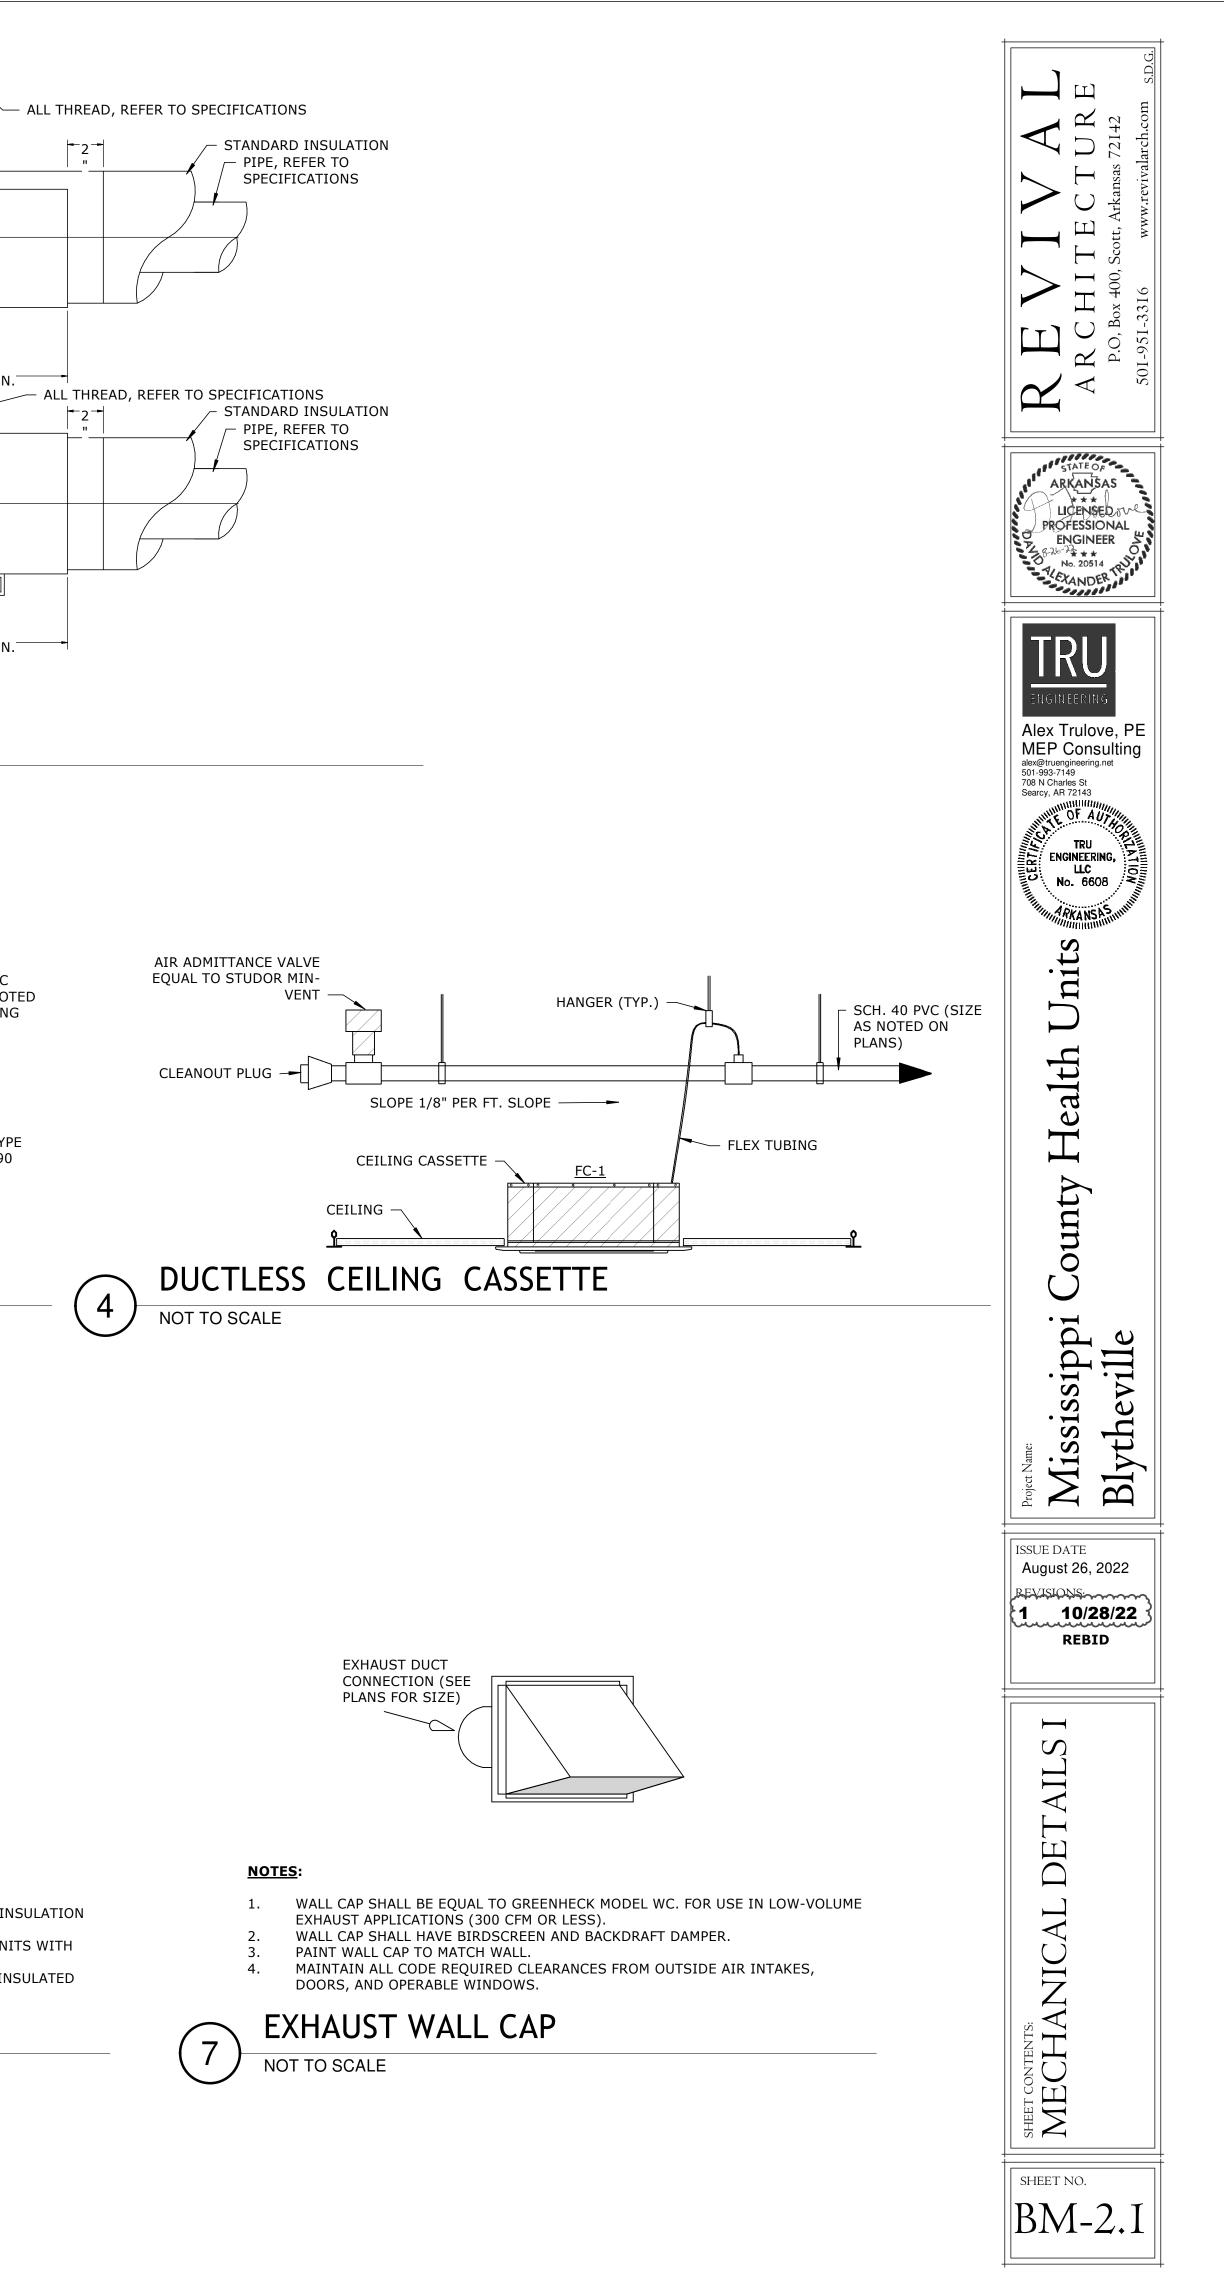

\wedge	
$\overline{1}$	

			HVAC -	- AHU - INI	DOOR SC	CHEDULE	E - B	BLYTHE\	/ILLE								
DESIG	NATION					HEATI	NG	ELECTRIC	AL DATA								
TYPE	MARK	DESCRIPTION	MANUFACTU	RER MODEI	_ NOMI	NAL TYPI	E 🗌	VOLTAGE	PHASE			REMARKS					
FC	1	MULTIPOSITION FAN COIL	. SAMSUNG	AC024KNZ	DCH 2.0 t	ton HEAT P	UMP	208 V	1	INDOOF	UNIT	SHALL BE POWERED THROUGH OUTDOOR UNI					
FC	2	MULTIPOSITION FAN COIL	. SAMSUNG	AC036KNZ	DCH 3.0 t	ton HEAT P	UMP	208 V	1	INDOOF	UNIT	SHALL BE POWERED THROUGH OUTDOOR UNI					
FC	3	MULTIPOSITION FAN COIL	SAMSUNG	AC024KNZ	DCH 2.0 t	ton HEAT P	UMP	208 V	1	INDOOF	UNIT	SHALL BE POWERED THROUGH OUTDOOR UNI					
FC	4	MULTIPOSITION FAN COIL	. SAMSUNG	AC036KNZ	DCH 3.0 t	ton HEAT P	UMP	208 V	1	INDOOF	UNIT	SHALL BE POWERED THROUGH OUTDOOR UNI					
FC	5	MULTIPOSITION FAN COIL	. SAMSUNG	AC048KNZ	DCH 4.0 t	ton HEAT P	UMP	208 V	1	INDOOF	UNIT	SHALL BE POWERED THROUGH OUTDOOR UNI					
FC	6	MULTIPOSITION FAN COIL	. SAMSUNG	AC054KNZ	DCH 4.5 t	ton HEAT P	UMP	208 V	1	INDOOF	UNIT	SHALL BE POWERED THROUGH OUTDOOR UNI					
FC	7	MULTIPOSITION FAN COIL	SAMSUNG	AC036KNZ	DCH 3.0 t	ton HEAT P	UMP	208 V	1	INDOOF	UNIT	SHALL BE POWERED THROUGH OUTDOOR UNI					
DESIG	NATION	HVAC CO	NDENSER S	GREDULE	- BLYIN	EVILLE	ELE	CTRICAL DA	ГА			PROVIDE WITH 2" PLEATED FILTER BASE EQUAL TO EZ FILTER. PROVIDE WITH MINIMUM MERV 8 FILTERS. PROVIDE WITH					
TYPE	MARK	DESCRIPTION	MANUFACTURER	MODEL	CAPACITY	VOLTAGE	PHA	SE MC	CA A	МОСР		EXTRA SET OF FILTERS AT TEST AND BALAN					
HP	1	VARIABLE SPEED HEAT PUMP	SAMSUNG	AC024BXADCH	2.0 ton	208 V	1	. 23.0	A C	30.0 A	2.	AND AT PROJECT COMPLETION. PROVIDE WITH AUXILIARY DRAIN PAN WITH					
HP	2	VARIABLE SPEED HEAT PUMP	SAMSUNG	AC036BXADCH	3.0 ton	208 V	1	1 23.0 A		35.0 A	Ζ.	WET SWITCH TO DEENERGIZE UNIT UPON					
HP	3	VARIABLE SPEED HEAT PUMP	SAMSUNG	AC024BXADCH	2.0 ton	208 V 1 23.0		23.0 A 30.0 A			DETECTION OF WATER.						
HP	4	VARIABLE SPEED HEAT PUMP	SAMSUNG	AC036BXADCH	3.0 ton	208 V	1	. 23.0	A	35.0 A	3.	PROVIDE WITH ELOSTOMERIC VIBRATION					
HP	5	VARIABLE SPEED HEAT PUMP	SAMSUNG	AC048BXADCH	4.0 ton	208 V	1	. 31.0) A	40.0 A		ISOLATION PADS EQUAL TO AMBER BOOTH					
HP	6	VARIABLE SPEED HEAT PUMP	SAMSUNG	AC054KXADCH	4.5 ton	208 V	1	. 42.0		70.0 A		PADS SHALL BE INSTALLED PER MANUFACTURER'S RECOMMENDATIONS. UN					
HP	7	VARIABLE SPEED HEAT PUMP	SAMSUNG	AC036BXADCH	3.0 ton	208 V	1	. 23.0) A	35.0 A		SHALL BE SUPPORTED FROM ALL FOUR					
INDO	OR AND OUTE	N AMBIENT COOLING, HARD-STA DOOR UNITS SHALL BE PROVIDE ELECTED AT AMBIENT CONDITIO	D FROM SAME MANU	JFACTURER.	ISCONNECT.						4.	CORNERS. PROVIDE WITH DISCONNECT SWITCH, REF TO ELECTRICAL FOR COORDINATION.					

DESIG	NATION				COOLI	NG DATA	ELECTRIC	AL DATA	
TYPE	MARK	DESCRIPTION	MANUFACTURER	MODEL	MAX SUPPLY AI	TOTAL COOLING	VOLTAGE	PHASE	REMARKS
DSFC	1A	1.5 TON CEILING CASSETTE	SAMSUNG	AC018BNNDCH	400 CFM	18,000 Btu/h	208 V	1	INDOOR UNIT SHALL BE POWERED THROUGH OUTDOOR UN
DSFC	1B	1.5 TON CEILING CASSETTE	SAMSUNG	AC018BNNDCH	400 CFM	18,000 Btu/h	208 V	1	INDOOR UNIT SHALL BE POWERED THROUGH OUTDOOR UN
DSFC	2A	1.5 TON CEILING CASSETTE	SAMSUNG	AC018BNNDCH	400 CFM	18,000 Btu/h	208 V	1	INDOOR UNIT SHALL BE POWERED THROUGH OUTDOOR UN
DSFC	2B	1.5 TON CEILING CASSETTE	SAMSUNG	AC018BNNDCH	400 CFM	18,000 Btu/h	208 V	1	INDOOR UNIT SHALL BE POWERED THROUGH OUTDOOR UN
DSFC	3	12 MBH WALL COIL UNIT	SAMSUNG	AR12TSFABWKNCV	600 CFM	12,000 Btu/h	240 V	1	INDOOR UNIT SHALL BE POWERED THROUGH OUTDOOR UN
ITTAG DOGTELGG GFETT GONDENGEN GOTTEDGEE - DETTTTETTEE								PROVIDE WITH INTEGRAL CONDENSATE PUMP.	
TYPE	MARK	DESCRIPTION	MANUFACTURER	MODEL		LECTRICAL DATA	МОСР	_	
DSCU		3 TON MULTI-SPLIT HEAT PUM		AJ036BXJ4CH	208 V	1 26.0 A	30.0 A	_	
DSCU	2	3 TON MULTI-SPLIT HEAT PUM		AJ036BXJ4CH	208 V	1 26.0 A	30.0 A		
		1.5 TON HEAT PUMP	SAMSUNG	AC018BXSCCC	240 V	1 12.0 A	15.0 A		


UNITS SHALL BE SELECTED AT AMBIENT CONDITIONS OF: 100 F DB AND 77 F WB. UNITS SHALL MEET CURRENT ENERGY CODE MINIMUM EFFICIENCY REQUIREMENTS. 4.

	HVAC EXHAUST FAN SCHEDULE - BLYTHEVILLE									
DESIG	NATION				EXTERNAL		ELECTRIC M	OTOR DATA		
		MANUFACTUR		EXHAUST AIR	STATIC	MOTOR				
TYPE	MARK	ER	MODEL	CFM	PRESSURE	WATTS	VOLTAGE	PHASE	DRIVE	REMARKS
EF	1	COOK	GCVF	75 CFM	0.25 in-wg	150 W	120 V	1	DIRECT	INTERLOCK WITH LIGHTS IN ASSOCIATED ROOM
EF	2	COOK	GCVF	75 CFM	0.25 in-wg	150 W	120 V	1	DIRECT	INTERLOCK WITH LIGHTS IN ASSOCIATED ROOM
EF	3	COOK	GCVF	75 CFM	0.25 in-wg	150 W	120 V	1	DIRECT	INTERLOCK WITH LIGHTS IN ASSOCIATED ROOM
EF	4	COOK	GCVF	75 CFM	0.25 in-wg	150 W	120 V	1	DIRECT	INTERLOCK WITH LIGHTS IN ASSOCIATED ROOM
EF	5	COOK	GCVF	75 CFM	0.25 in-wg	150 W	120 V	1	DIRECT	INTERLOCK WITH LIGHTS IN ASSOCIATED ROOM
EF	6	COOK	GCVF	75 CFM	0.25 in-wg	150 W	120 V	1	DIRECT	INTERLOCK WITH LIGHTS IN ASSOCIATED ROOM
EF	7	COOK	GCVF	75 CFM	0.25 in-wg	150 W	120 V	1	DIRECT	INTERLOCK WITH LIGHTS IN ASSOCIATED ROOM

1.

PROVIDE WITH SOLID STATE SPEED CONTROLLER, DISCHARGE BACKDRAFT DAMPER, ISOLATOR KIT, DISCONNECT SWITCH. PROVIDE WITH MANUFACTURER'S METAL GRILLE OPTION. EXHAUST FAN SHALL BE SUPPORTED BY STRUCTURE BY MEANS OF ALL THREAD RODS AND MANUFACTURER'S MOUNTING BRACKETS. EXHAUST FAN SHALL BE INTERLOCKED WITH LIGHTS IN ASSOCIATED ROOM. 2. 3.

4.

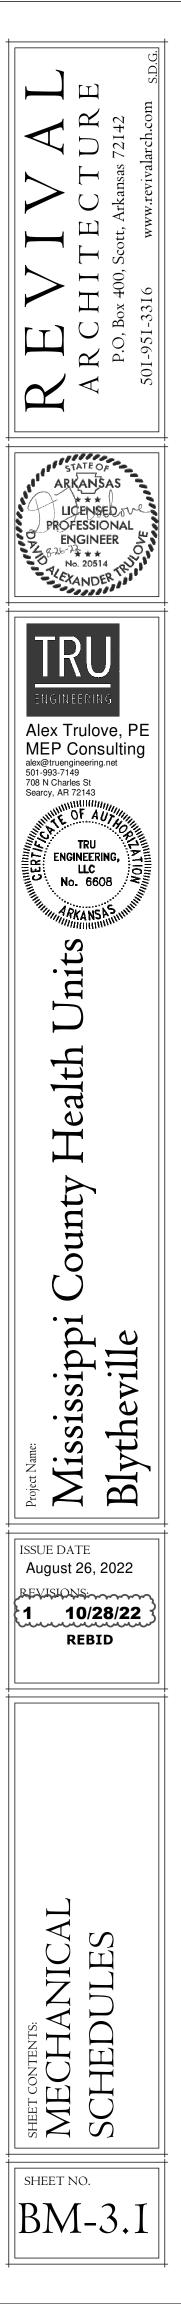

BREVIATION OR SYMBOL	DESCRIPTION	ABBREVIATION OR SYMBOL	DESCRIPTION	АВ
BREVIATION OR STMBOL	DESCRIPTION	ABBREVIATION OR STMIBUL	DESCRIPTION	
81 DCM 13	DOMESTIC COLD WATER	HHHHHHHHH	FLEXIBLE PIPING	
8	DOMESTIC HOT WATER			
5 <u>DHMC</u> 13	DOMESTIC HOT WATER RETURN	8	EXISTING PIPING TO REMAIN (refer to line designation)	
<u>81 SS 13</u>	SANITARY SEWER		EXISTING TO BE REMOVED	
81 GW 13	SANITARY - GREASE WASTE	•	(back to point indicated)	
SI WA IS	SANITARY - ACID WASTE	2	CONNECT TO EXISTING	
E SD 13	STORM DRAIN		BELOW GRADE PIPING (fine dash)	
	VENT			
<u>2 G S</u>	NATURAL GAS	THREADED WATER	& GAS PIPING	
8 CD 13	CONDENSATE DRAIN			
			PIPE DOWN	
VALVING			PIPE UP	
	BUTTERFLY VALVE		THREADED TEE DOWN	
BFV BFV	(lever operator)		THREADED TEE UP	
T	BUTTERFLY VALVE		BRANCH - BOTTOM OF PIPE	
8 <u> </u>	(wheel operator)	لم مناطق	BRANCH - TOP OF PIPE	
GV GV	GATE VALVE	5		
e di e e	CHECK VALVE		90 DEGREE ELBOW	
снк т			45 DEGREE ELBOW	
GB GB	GLOBE VALVE			
	STRAINER (Y-TYPE)		TEE	
ST ST				
BV BV	BALL VALVE	د بالا	UNION	

					PLUMBING F			
TAG	DESCRIPTION	MANUFACTURER	MODEL	ACCESSORIES	FAUCETS & FITTINGS			
FCO	FLOOR CLEANOUT	ZURN	ZN1400	-	-			
FD1	FLOOR DRAIN - 5" STRAINER	ZURN	Z415B	PROSET TRAP GUARD	-			
P1	WATER CLOSET - FLUSH TANK - ADA	ZURN	Z5551-K	ADA ELONGATED SEAT	-			
P2A	WALL HUNG LAVATORY	ZURN	Z5310	GRID DRAIN	ZURN 831B4-XL			
P3	SINK - ADA - SINGLE COMPARTMENT	ELKAY	LR2022	-	ZURN 831B4-XL			
P4	KITCHEN SINK - SINGLE COMPARTMENT	ELKAY	DLRS332210	BADGER 5XP GARBAGE DISPOSAL	ZURN 831B4-XL			
P5	SINGLE STATION WATER COOLER	ELKAY	LZS8WSLK	BOTTLE FILLER	-			
1 ALL	1 ALL FIXTURES SHALL BE INSTALLED AS PER MANUFACTURER'S RECOMMENDATION.							
2 CON	TRACTOR IS RESPONSIBLE FOR	COORDINATING FAUC	ET SPACING AND STYLE	WITH MOUNTING HOLES	S IN FIXTURE.			
	FIXTURES WITH HOT WATER FE TRACTOR SHALL INSTALL ALL P							

Image: Constraint of the second se	PLUMBING EQUIPMENT SCHEDULE - BLYTHEVILLE						
TAG MARK DESCRIPTION MANUFACTURER MODEL MOUNTING DCW DHW HTG INPUT DESIGN EWT SETPOINT VOLTAGE (V) PHASE	AG MARK DESCRIPTION						
WH 1 LIGHT COMMERCIAL TANK ELECTRIC WATER HEATER AO SMITH G12-FDT5040NVR FLOOR 3/4" 40000 Btu/h 55.0 °F 120.0 °F 208 V 1 REFER TO WATER HEATER	/H 1 LIGHT COMMERCIAL TANK ELECTRIC WAT						

IATION OR SYMBOL	DESCRIPTION
FFE AFF AFG	FINISH FLOOR ELEVATION ABOVE FINISH FLOOR ABOVE FINISH GRADE
	PIPE PENETRATION (through floor/wall/etc) _{IN}
	DHW ROUGH-IN
DNG RADIUS SEWER	& VENT PIPING
0	PIPE DOWN
0	PIPE UP
	PIPE WYE DOWN
	PIPE WYE UP
	BRANCH - BOTTOM OF PIPE
	BRANCH - TOP OF PIPE
	ELBOW
	45 DEGREE ELBOW
	WYE WITH EIGHTH BEND
	UNION

PLUMBING GENERAL NOTES:

2.

- REQUIREMENT SHALL GOVERN WORK.
- REFER TO PLUMBING SCHEDULES AND SPECIFICATIONS FOR BASIS OF DESIGN, ACCEPTABLE MANUFACTURERS, AND MODELS OF PLUMBING FIXTURES AND EQUIPMENT. PROVIDE CLEANOUTS IN ALL SANITARY LINES, WHETHER SHOWN OR NOT, AT INTERVALS NOT TO EXCEED 100' AND AT EACH CHANGE IN DIRECTION GREATER THAN 45 DEGREES. PROVIDE A TWO-WAY CLEANOUT AT THE JUNCTION OF ALL BUILDING DRAINS AND BUILDING SEWERS. REFER TO SPECIFICATIONS FOR INSULATION REQUIREMENTS.
- SANITARY LINE ELEVATIONS AND COORDINATE INSTALLATION TO ASSURE PROPER FLOW. SEAL ALL PIPE PENETRATIONS THROUGH WALLS, ROOF, AND FLOOR AIR AND WATER TIGHT. 10.
- RECOMMENDATIONS FOR ALL FLOOR DRAINS. 11. ALL PIPE DROPS FROM CEILING PLENUM TO BELOW FLOOR SHALL BE MADE IN FURR-OUTS AT COLUMNS, IN WEBB OF BEAMS AT COLUMNS, OR IN WALLS UNLESS SHOWN OTHERWISE. 12. ALL EXPOSED OR ACCESSIBLE P-TRAPS SHALL BE CHROME PLATED AND PROVIDED WITH BOTTOM CLEANOUT PLUGS. ALL EXPOSED PLUMBING TRIM SHALL BE CHROME PLATED. 15. MAINTAIN A MINIMUM OF 10' BETWEEN ALL HVAC FRESH AIR INTAKES AND PLUMBING VENTS. COORDINATE WITH MECHANICAL BEFORE INSTALLATION OF VTRs. 16. CONTRACTOR SHALL VISIT SITE AND VERIFY CONDITIONS PRIOR TO BIDDING.
- 17. CONTRACTOR SHALL PAY ALL UTILITY FEES AND CHARGES IN THE CONTRACT.
- AND PLUMBING EQUIPMENT. 19. FIRE STOP ALL PIPE PENETRATIONS THROUGH RATED WALLS. REFER TO SPECIFICATIONS.
- 20. PIPING SHALL NOT BE ROUTED OVER ELECTRICAL ROOMS, COMPUTER ROOMS, ELECTRICAL PANELS, OR ELECTRICAL EQUIPMENT UNLESS OTHERWISE NOTED. ROOM BELOW.
- 22. PAINT EXPOSED PIPING AND PIPE INSULATION. COORDINATE WITH OWNER FOR FINAL COLOR. 23. ALL UNDER FLOOR WATER PIPING SHALL BE PROVIDED WITH A POLYETHYLENE SLEEVE. EXTEND SLEEVE UP THROUGH FLOOR SLAB AND SEAL AIR AND WATER TIGHT. 24. PLASTIC PIPE IS PROHIBITED IN RETURN AIR PLENUMS. ALL PIPING AND PIPE CONNECTIONS IN RETURN AIR PLENUMS SHALL BE PLENUM RATED. 25. PIPING THROUGH FOUNDATION WALLS AND FOOTINGS SHALL BE SLEEVED AS PER STRUCTURAL DETAILS.
- 26. ALL PIPE CONNECTIONS BETWEEN DISSIMILAR METALS SHALL BE MADE THROUGH DIELECTRIC UNIONS. SPECIFICALLY SHOWN ON ELECTRICAL SCHEDULE, PLUMBING FIXTURES REQUIRING ELECTRICAL SERVICE SHALL BE FED FROM BREAKER OF ADEQUATE CAPACITY. REFER TO PLUMBING SPECIFICATIONS FOR PIPE MATERIAL AND INSULATION REQUIREMENTS.
- MECHANICAL REQUIREMENTS. PROVIDE FABRICATED EXPANSION LOOP OR MANUFACTURED EXPANSION DEVICE ON ALL PIPING SYSTEMS CROSSING BUILDING EXPANSION JOINTS.

DEMOLITION/RENOVATION GENERAL NOTES

- ADDITIONAL INFORMATION AND DEMOLITION SCOPE OF WORK.
- THEY ARE TO BE LEFT FOR FUTURE USE), THE CONTRACTOR SHALL REINSTALL SAID SYSTEMS TO FULLY OPERABLE CONDITION IN THEIR ORIGINAL LOCATIONS. ALL DEMOLITION WORK SHALL BE SCHEDULED WITH THE OWNER'S REPRESENTATIVE AT LEAST 48 HOURS PRIOR TO THE WORK. PATCH ALL OPENINGS IN WALLS, FLOORS, AND CEILINGS WHERE DUCT, PIPING, AND CONTROLS HAVE BEEN REMOVED TO MATCH EXISTING.
- THE SATISFACTION OF THE OWNER AND ENGINEER WITHOUT ADDITIONAL COST TO THE OWNER. MAINTAIN THE SECURITY OF THE BUILDING AT ALL TIMES.
- REMOVE ALL EXISTING SUPPORTS ASSOCIATED WITH EQUIPMENT, DUCTWORK, AND PIPE BEING REMOVED UNLESS NOTED OTHERWISE. DISPOSE OF ALL REMOVED EQUIPMENT AS DIRECTED BY THE OWNER.
- CONTRACTOR SHALL COORDINATE REMOVAL OF UTILITY SERVICES WITH UTILITY COMPANIES AND LOCAL AUTHORITIES AND PAY ALL FEES. SCHEDULE UTILITY WORK WITH OWNER TO KEEP TO A MINIMUM ACCEPTABLE DOWNTIME AND TO NOT INTERFERE WITH THE BUILDING OPERATIONAL SCHEDULE, IF POSSIBLE. 10. MAINTAIN THE FIRE AND SMOKE CONSTRUCTION INTEGRITY OF THE EXISTING BUILDINGS. DO NOT VENT REFRIGERANT TO ATMOSPHERE. RECOVER REFRIGERANT FOR REUSE USING ASHRAE RECOMMENDED PROCEDURES. 12. 13.
- ARCHITECT. 14. AREAS OUTSIDE OF THE FLOOR AREA SHALL BE SCHEDULED WITH THE OWNER 48 HOURS IN ADVANCE.
- THE EQUIPMENT LOCATIONS SHOWN ON THE DRAWINGS ARE APPROXIMATE. THE FINAL LOCATIONS SHALL BE ESTABLISHED IN THE FIELD TO BEST FIT THE AVAILABLE SPACE. COORDINATE WITH 15. STRUCTURAL DRAWINGS.
- INSPECT THE EXISTING SYSTEM; ANY EXISTING EQUIPMENT, DUCTS, OR PIPING FOUND TO BE DAMAGED OR NON-OPERABLE SHALL BE BROUGHT TO THE ATTENTION OF THE OWNER'S REPRESENTATIVE 16. IMMEDIATELY. PHASE DEMOLITION AND RENOVATION WORK TO MAINTAIN EXISTING BUILDING AS REQUIRED BY BUILDING OWNER/OCCUPANTS. PROVIDE TEMPORARY SERVICES AS REQUIRED. 17.
- 18. CONNECTIONS TO EXISTING SYSTEMS AND SYSTEM SHUT-DOWNS WITH OWNER'S REPRESENTATIVE.
- OF THE OWNER WITHOUT ADDITIONAL COST TO THE OWNER.

FIXTURE SCHEDULE - BLYTHEVILLE BRANCH CONNECTIONS MOUNTING STOPS TRAPS DCW DHW SS REMARKS FLOOR 4" MATCH SIZE TO SANITARY LINE SERVED. -CAST IRON FLOOR 2" MCGUIRE COMMERCIAL INTEGRAL FLOOR 1/2" 4" MCGUIRE COMMERCIAL MCGUIRE COMMERCIAL WALL MOUNT AT ADA HEIGHT 1/2" 1/2" 2" COUNTER 1/2" 2" MCGUIRE COMMERCIAL MCGUIRE COMMERCIAL 1/2" MCGUIRE COMMERCIAL MCGUIRE COMMERCIAL COUNTER 1/2" 1/2" 2" MCGUIRE COMMERCIAL MCGUIRE COMMERCIAL WALL 1/2" 2"

ER'S RECOMMENDATION.

IG JURISDICTION.

ALL PLUMBING WORK SHALL COMPLY WITH ALL LOCAL CODES, AUTHORITIES HAVING JURISDICTION, DRAWINGS AND SPECIFICATIONS. IF DISCREPANCIES ARE FOUND - THE MOST STRINGENT

ALL DRAWINGS ARE DIAGRAMMATIC AND INDICATE THE GENERAL ARRANGEMENTS OR GEOMETRIC RELATIONSHIPS OF EQUIPMENT AND SERVICES. THEY ARE NOT INTENDED TO SPECIFY OR SHOW EVERY OFFSET, FITTING, OR COMPONENT. CONTRACTOR SHALL NOT SCALE DRAWINGS. EQUIPMENT SCHEDULES SHALL TAKE PRECEDENCE OVER CONFLICTING DRAWING INFORMATION. DRAWINGS SPECIFIC TO THIS DISCIPLINE DO NOT LIMIT THE RESPONSIBILITY OF WORK REQUIRED BY CONTRACT DOCUMENTS. REFER TO COMPLETE PROJECT DOCUMENTS FOR COORDINATION WITH OTHER DISCIPLINES. EXCEPT WHERE MODIFIED BY SPECIFIC NOTATION TO THE CONTRARY, IT SHALL BE UNDERSTOOD THAT THE INDICATION AND/OR DESCRIPTION OF ANY ITEM IN THE DRAWINGS OR SPECIFICATIONS CARRIES WITH IT THE INSTRUCTION TO PROVIDE THE ITEM, REGARDLESS OF WHETHER OR NOT THIS INSTRUCTION IS EXPLICITLY STATED AS PART OF THE INDICATION OR DESCRIPTION.

ALL SANITARY LINES 2 1/2" AND SMALLER SHALL HAVE A MINIMUM SLOPE OF 1/4" PER FOOT. ALL SANITARY LINES 3" AND LARGER SHALL HAVE A MINIMUM SLOPE OF 1/8" PER FOOT. VERIFY EXISTING

ALL FLOOR DRAINS SHALL HAVE DEEP SEAL TRAPS, 4" DEEP SEAL MINIMUM UNLESS NOTED OTHERWISE. PROVIDE A TRAP GUARD EQUAL TO PROSET OR SURE SEAL SIZED ACCORDING TO MANUFACTURER'S

13. PROVIDE TIGHT-FITTED MOLDED PLASTIC INSULATION AT ALL EXPOSED WATER AND DRAIN PIPING FOR ADA FIXTURES PER ANSI A117.1 AND ADA REQUIREMENTS. FINISH SHALL BE WHITE. 14. ALL DOMESTIC WATER SHALL BE ROUTED ABOVE CEILING. ALL DOMESTIC WATER ROUTED IN EXTERIOR WALLS SHALL BE INSTALLED ON CONDITIONED SIDE OF ROOM INSULATION.

18. PROVIDE ALL FITTINGS, TRANSITIONS, COUPLINGS, ADAPTORS, UNIONS, AND OTHER ACCESSORIES NEEDED TO COMPLETE CONNECTIONS AND PROVIDE FOR PROPER OPERATION OF PLUMBING FIXTURES

21. EACH FIXTURE GROUP OR BATTERY OF FIXTURES SHALL BE PROVIDED WITH A SHUTOFF VALVE IN THE DOMESTIC HOT AND COLD WATER SUPPLY LINES ABOVE CEILING. VALVES SHALL BE ACCESSIBLE FROM

27. ALL PLUMBING COMPONENTS WITH ELECTRICAL REQUIREMENTS SHALL BE INSTALLED WITH THE ELECTRICAL INFRASTRUCTURE NECESSARY TO PROVIDE A FULLY FUNCTIONING SYSTEM. IF NOT

29. EXACT LOCATION OF ALL EQUIPMENT AND PIPING SHALL BE COORDINATED WITH OTHER TRADES. CEILING MOUNTED SPRINKLER AND LIGHTING SHALL TAKE PRECEDENCE OVER CEILING MOUNTED

31. WATER SUPPLY CONNECTIONS TO COFFEE MACHINES AND NONCARBONATED BEVERAGE DISPENSERS SHALL BE PROVIDED WITH A BACKFLOW PREVENTER OR AN AIR GAP.

THE MECHANICAL RELATED DEMOLITION WORK INDICATED ON THE PLANS, SPECIFICATIONS, AND NOTES IS TO BE CLOSELY COORDINATED WITH THE OWNER'S REPRESENTATIVE. NO DEMOLITION SHALL TAKE PLACE IN ANY AREA OR BUILDING UNTIL THE CONTRACTOR HAS BEEN GIVEN APPROVAL TO PROCEED IN THAT SPECIFIC LOCATION. REFER TO ARCHITECTURAL DEMOLITION DRAWINGS FOR

IF, DURING DEMOLITION, IT BECOMES NECESSARY TO TEMPORARILY REMOVE ANY EQUIPMENT, PIPING, OR OTHER SYSTEM WHICH IS NOT SPECIFICALLY NOTED TO BE REMOVED (THEREBY IMPLYING THAT

ANY DAMAGE TO THE OWNER'S PROPERTY, BUILDING, EXISTING SYSTEMS, OR EQUIPMENT RESULTING FROM THE CONTRACTOR'S OPERATIONS SHALL BE REPAIRED OR REPLACED BY THE CONTRACTOR TO

EXISTING EQUIPMENT SHALL BE RELOCATED AS NECESSARY FOR THE INSTALLATION OF THE NEW SYSTEMS. METHODS AND POSITIONS OF THE RELOCATIONS SHALL HAVE PRIOR APPROVAL OF THE


DEMOLITION AND SHUTDOWN OF EXISTING HVAC SYSTEMS THAT WILL AFFECT PORTIONS OF THE BUILDING OUTSIDE OF PROJECT AREA SHALL BE COORDINATED WITH OWNER'S REPRESENTATIVE AND PLANNED TO LIMIT INCONVENIENCE AND DISRUPTION OF BUILDING OPERATIONS AS MUCH AS POSSIBLE. WORK SHALL BE PHASED ACCORDINGLY. PLUMBING OR HVAC WORK REQUIRED IN OCCUPIED

WORK REQUIRED IN THE AREAS OUTSIDE OF THE FLOOR AREA FOR PLUMBING OR HVAC WORK SHALL BE SCHEDULED WITH THE OWNER 48 HOURS IN ADVANCE. COORDINATE AND SCHEDULE ALL

19. ANY DAMAGE TO THE EXISTING BUILDING, STRUCTURE, FINISHES, OR ARCHITECTURAL FEATURES CAUSED BY THE CONTRACTOR'S OPERATIONS SHALL BE REPAIRED OR REPLACED TO THE SATISFACTION

REVIVAL		501-951-3316 www.revivalarch.com S.D.G.
PROF PROF Z gale 3	ESSION IGINEER 20514 ANDER	ove
Project Name: Misciscinni County Halth I Inite 2 3	rulove Consultation of the state of the sta	ting
mun	26, 20	\mathbb{M}
SHEET CONTENTS: PLUMBING NOTES,	SCHEDULES, AND	LEGENDS

BP-0

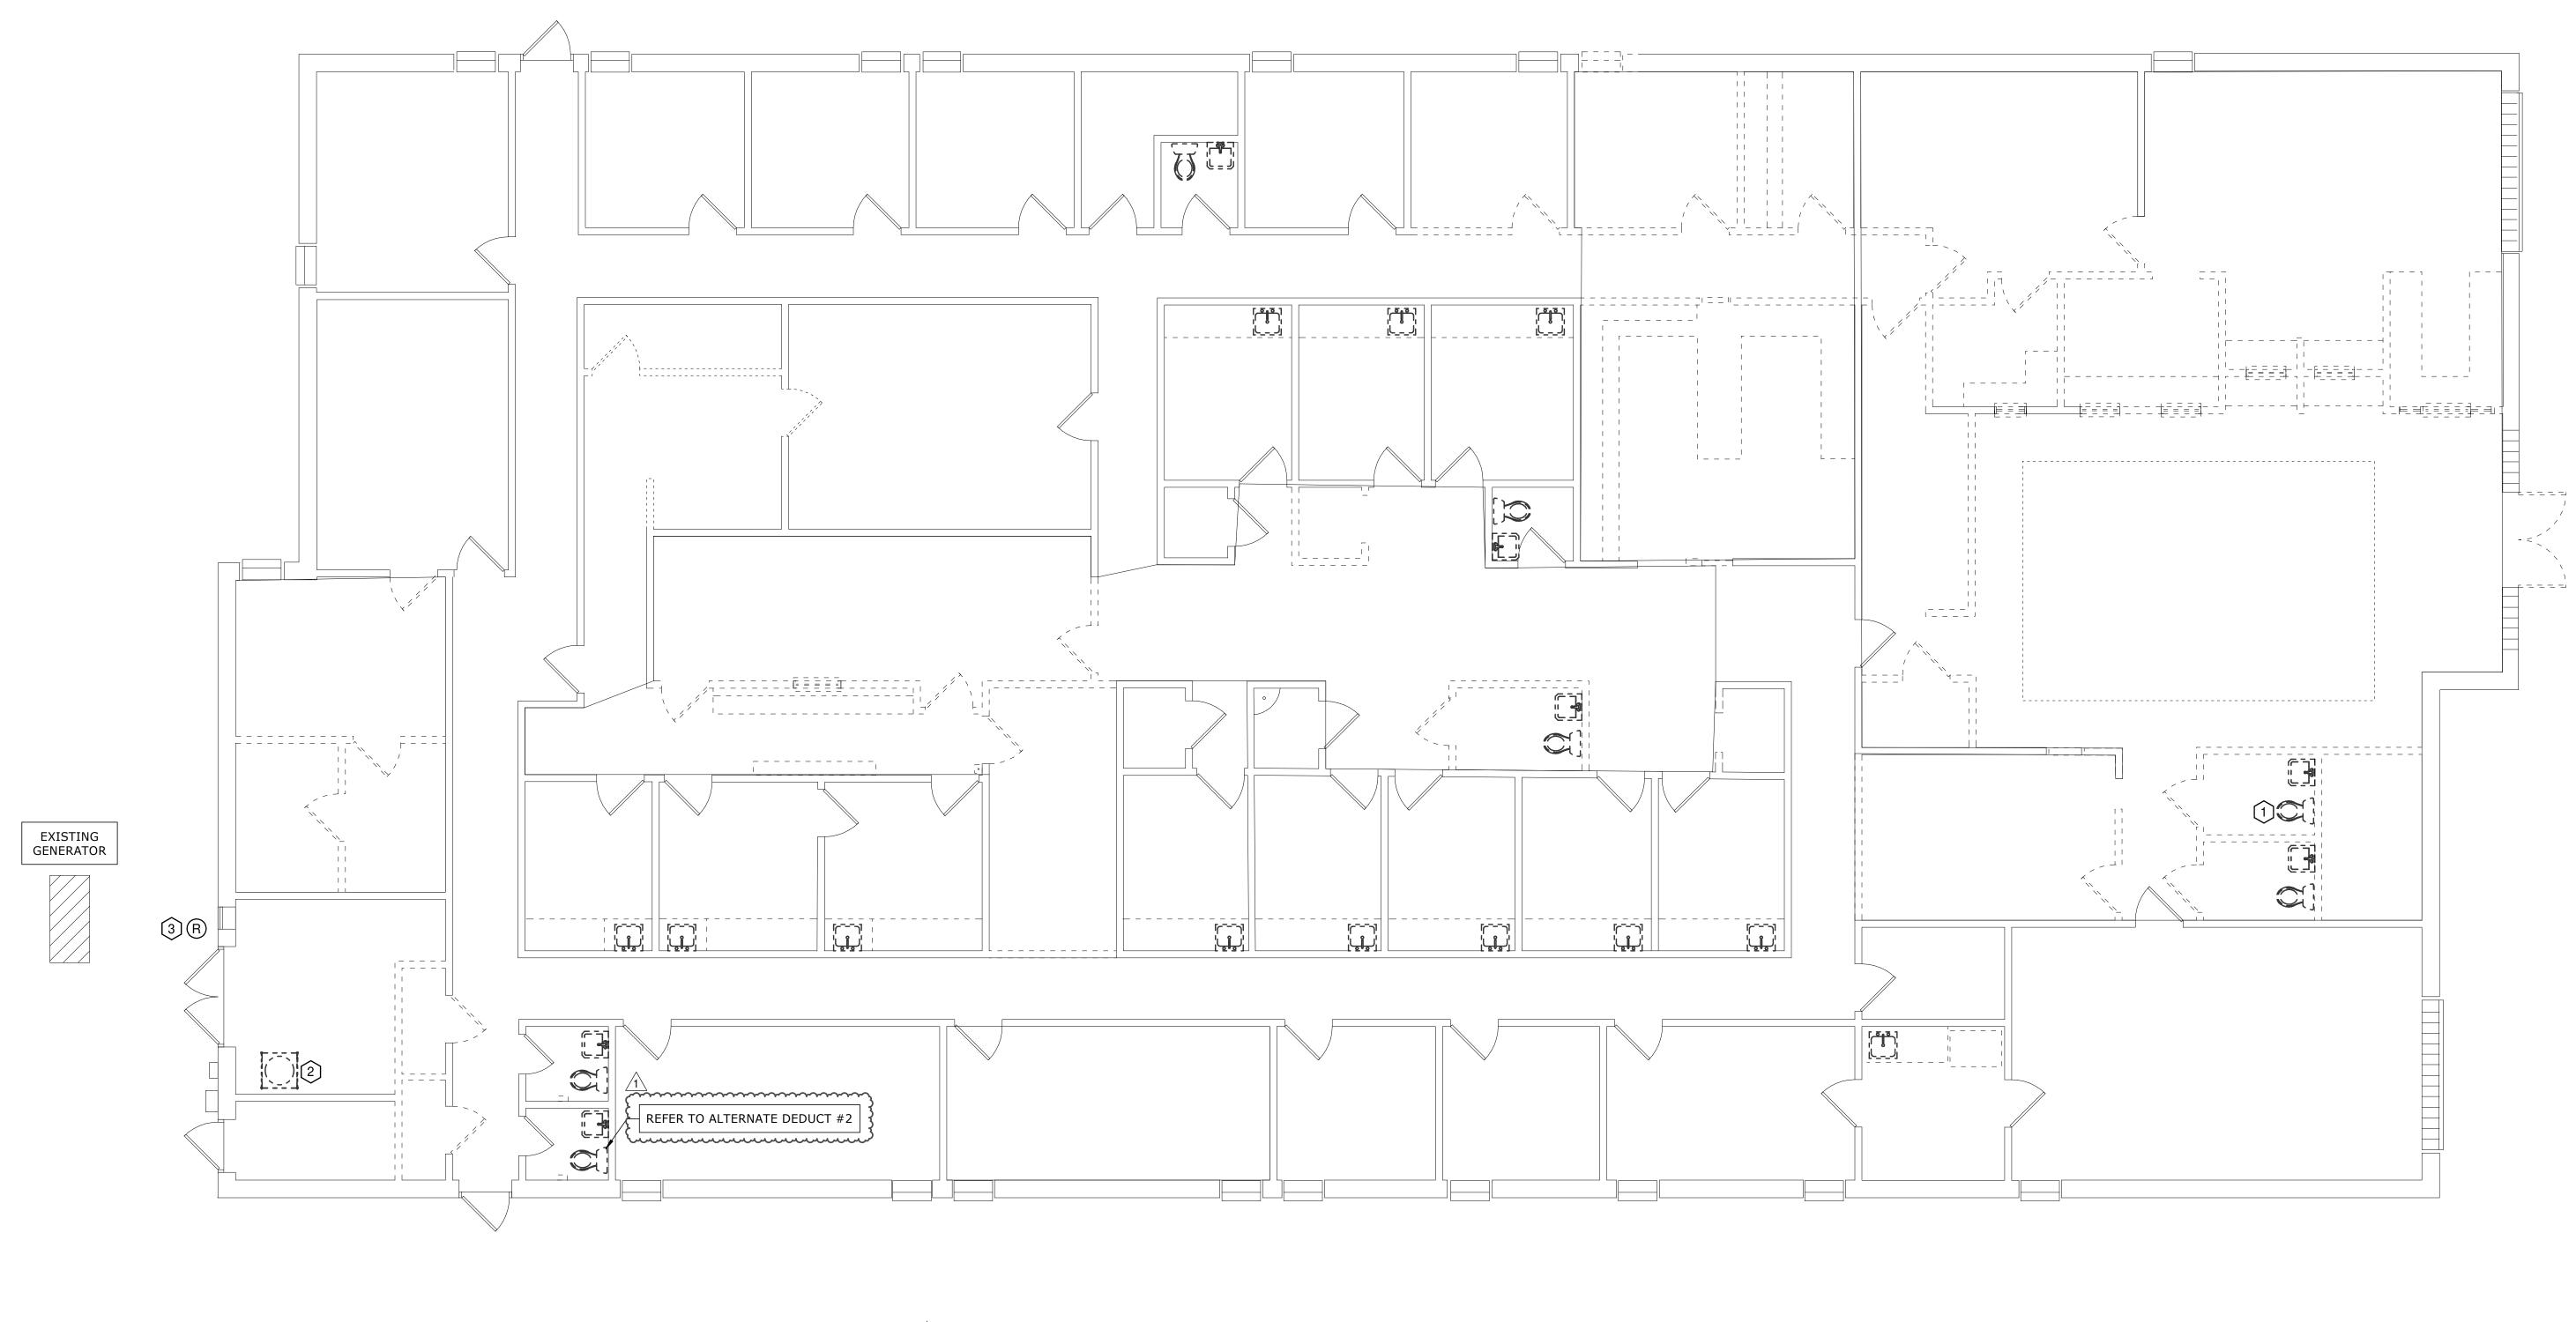

DEMO PLUMBING PLAN - BLYTHEVILLE 3/16" = 1'-0"


1



<u>KEYED NOTES</u>

- 1. REMOVE EXISTING PLUMBING FIXTURES COMPLETE BACK
- TO STOP, TYPICAL ALL.2. REMOVE EXISTING WATER HEATER AND ASSOCIATE RECIRC PUMP COMPLETE.
- 3. EXISTING NATURAL GAS REGULATOR. REMOVE ALL EXISTING PIPING WITH EXISTING GERNATOR TO BE DEMOLISHED.



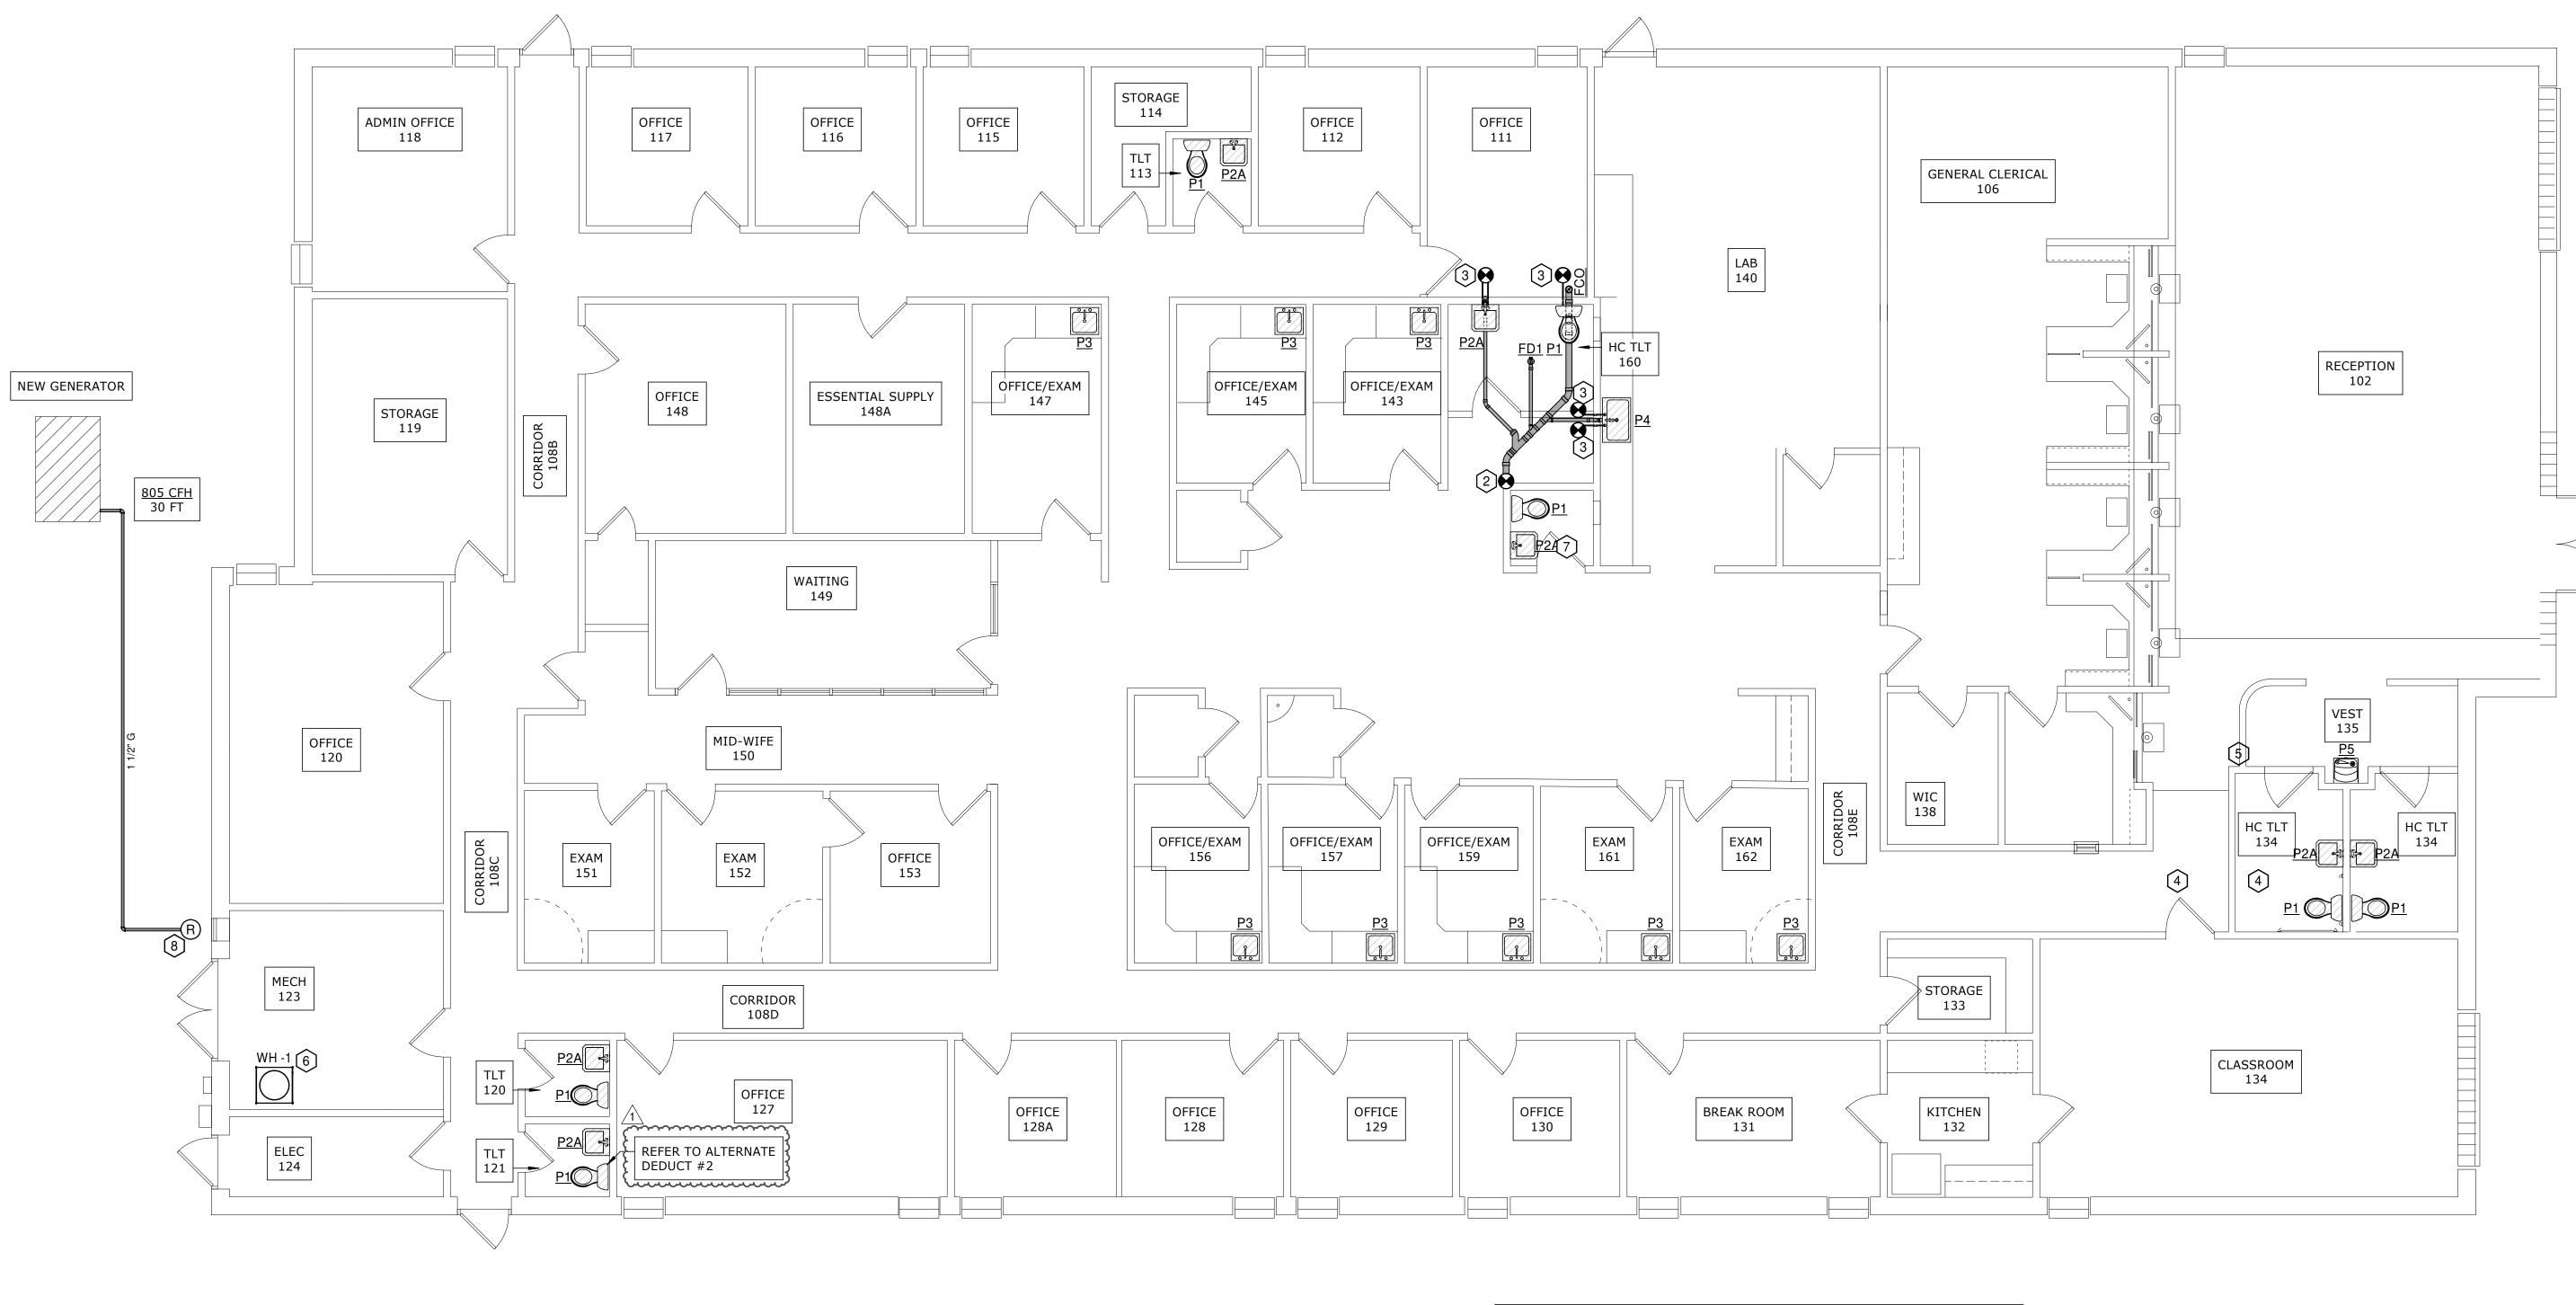








FIXTURE CONNECTION Ø - BLYTHVILLE							
		BRANCH	I CONNECT	IONS			
TAG	DESCRIPTION	DCW	DHW	SS			
FCO	FLOOR CLEANOUT			4"			
FD1	FLOOR DRAIN - 5" STRAINER			2"			
P1	WATER CLOSET - FLUSH TANK - ADA	1/2"		4"			
P2A	WALL HUNG LAVATORY	1/2"	1/2"	2"			
Р3	SINK - ADA - SINGLE COMPARTMENT	1/2"	1/2"	2"			
P4	KITCHEN SINK - SINGLE COMPARTMENT	1/2"	1/2"	2"			
P5	SINGLE STATION WATER COOLER	1/2"		2"			

KEYED NOTES

- 1. NEW PLUMBING FIXTURE TO CONNECT TO EXISTING SANITARY/DCW/DHW SUPPLIES. TYPICAL ALL EXCEPT IN NEW RESTROOM, SEE KEYED NOTES 2 AND 3. NEW SANITARY SHALL BE TRENCHED TO EXISTING SANITARY MAIN.
- CONNECT TO EXISTING SANITARY MAIN.
 CONNECT TO EXISTING DCW/DHW MAIN.
- EXTEND SANITARY TO NEW FIXTURE LOCATIONS. TRENCH AS REQUIRED.
 ROUTE NEW DRINKING FOUNTAIN SANITARY/VENT/DCW
- ADJECNT RESTROOM PLUMBING MAINS.
 6. NEW WATER HEATER AND RECIRC PUMP. SEE WATER
 HEATER DETAIL FOR FULL REQUIREMENTS.
- HEATER DETAIL FOR FULL REQUIREMENTS.GC SHALL VERIFY NEW WALL HUNG FIXTURES FITS IN EXISTING LOCATION.
- 8. PROVIDE 1.5" GAS LINE BELOW GRADE TO NEW GENERATOR. BALANCE REGULATOR AS REQUIRED FOR INCREASED CAPACITY.

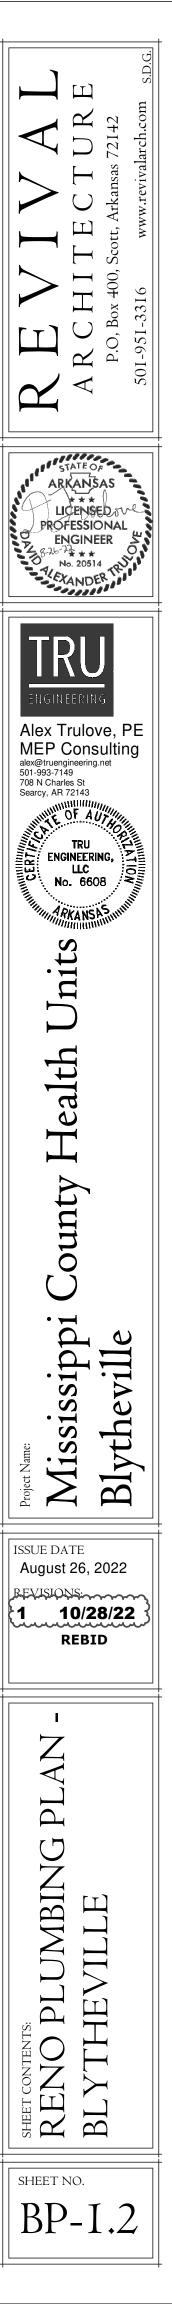

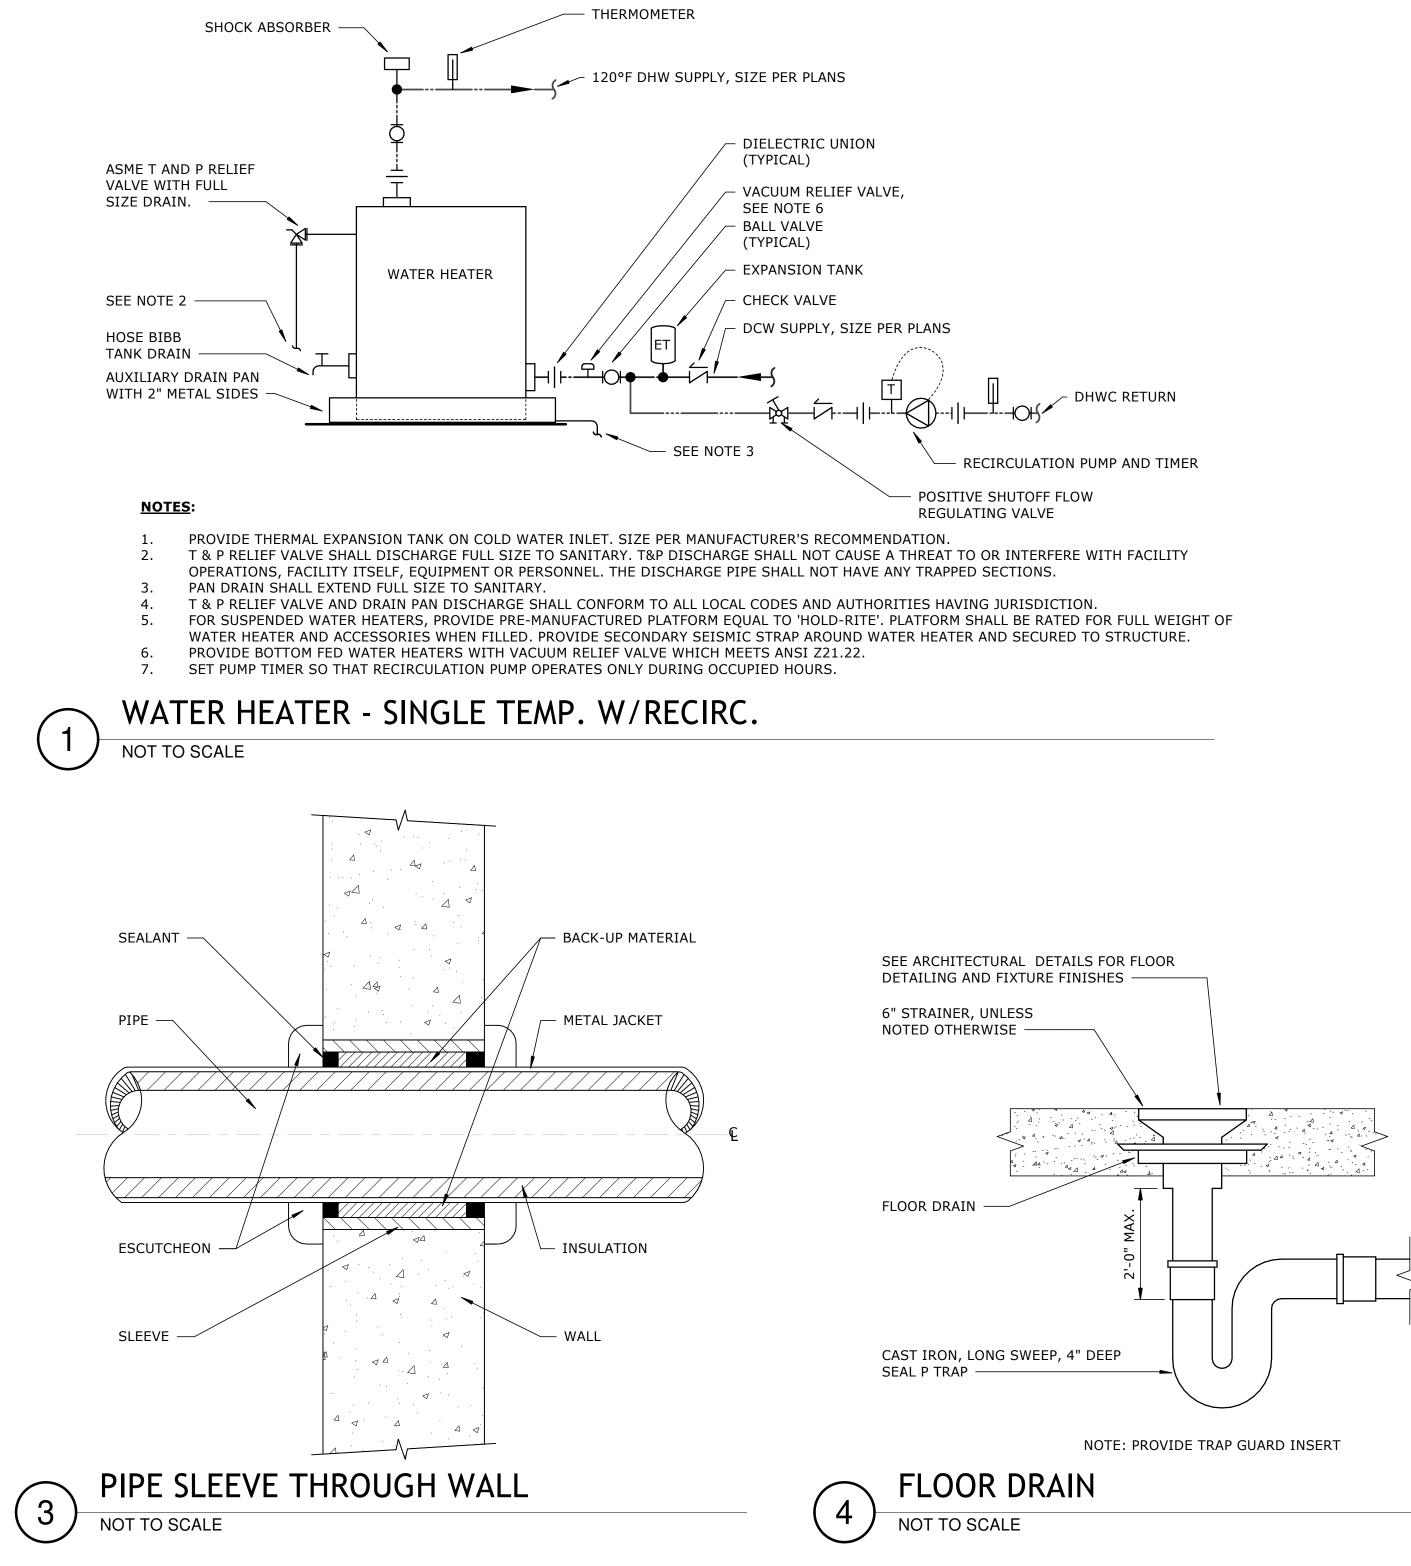

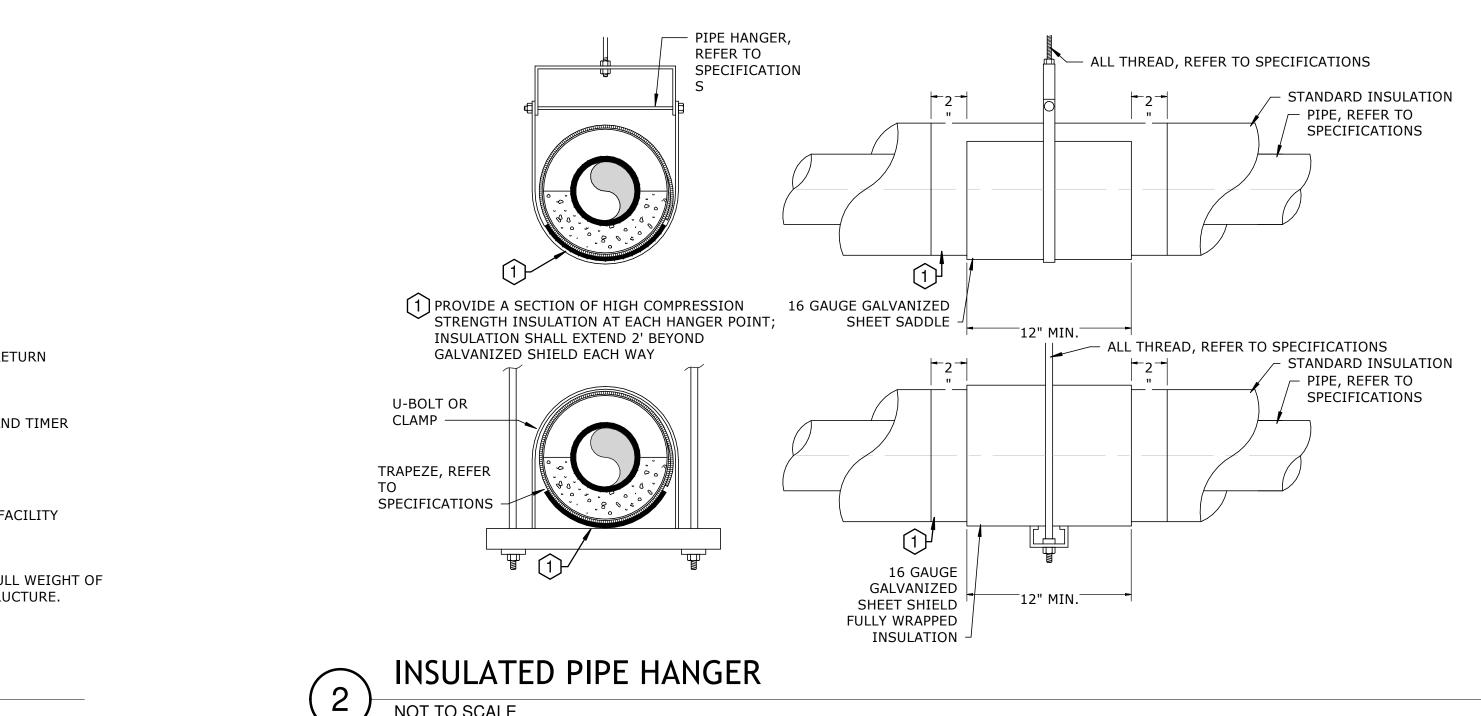

HAMMER ARRESTOR SCHEDULE SUPPLY HAMMER FIXTURE BRANCH ARRESTOR UNITS SIZE CONNECTIONS 1/2" - 1" 1/2" 1-11 1-1/4" 3/4" 12-32 1-1/2" 33-60 1"

1"

1"

1"

NOTES:

2"

2-1/2"

3"

NOT TO SCALE

ALL BATHROOM GROUPS SHALL INCLUDE A MINIMUM OF ONE DCW 1. ARRESTOR AND ONE HW ARRESTOR SIZED PER HAMMER ARRESTOR SCHEDULE. ADDITIONAL ARRESTORS SHALL BE INSTALLED WHERE INDICATED.

61-113

114-154

155-330


ARRESTORS SHALL BE P.D.I.-WH201 APPROVED AND CERTIFIED. ARRESTORS SHALL HAVE WROUGHT COPPER SHELL WITH THREADED CONNECTIONS AND HYDRO-PNEUMATIC AIR CUSHION.

PROVIDE ACCESS TO ARRESTORS. FURNISH AND INSTALL WITH ISOLATION VALVES INDEPENDENT OF ASSEMBLY.





VENT ABOVE ROOF SHALL BE PAINTED TO 1. MATCH ROOF. COORDINATE WITH ARCHITECT. IF ARCHITECTURAL PIPE PENETRATION DETAIL 2. IS AVAILABLE, IT SHALL SUPERCEDE THIS DETAIL.

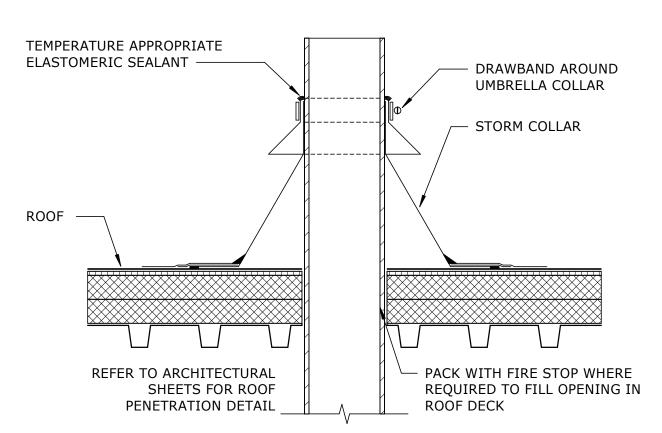


VENT THROUGH ROOF

NOT TO SCALE

6



1

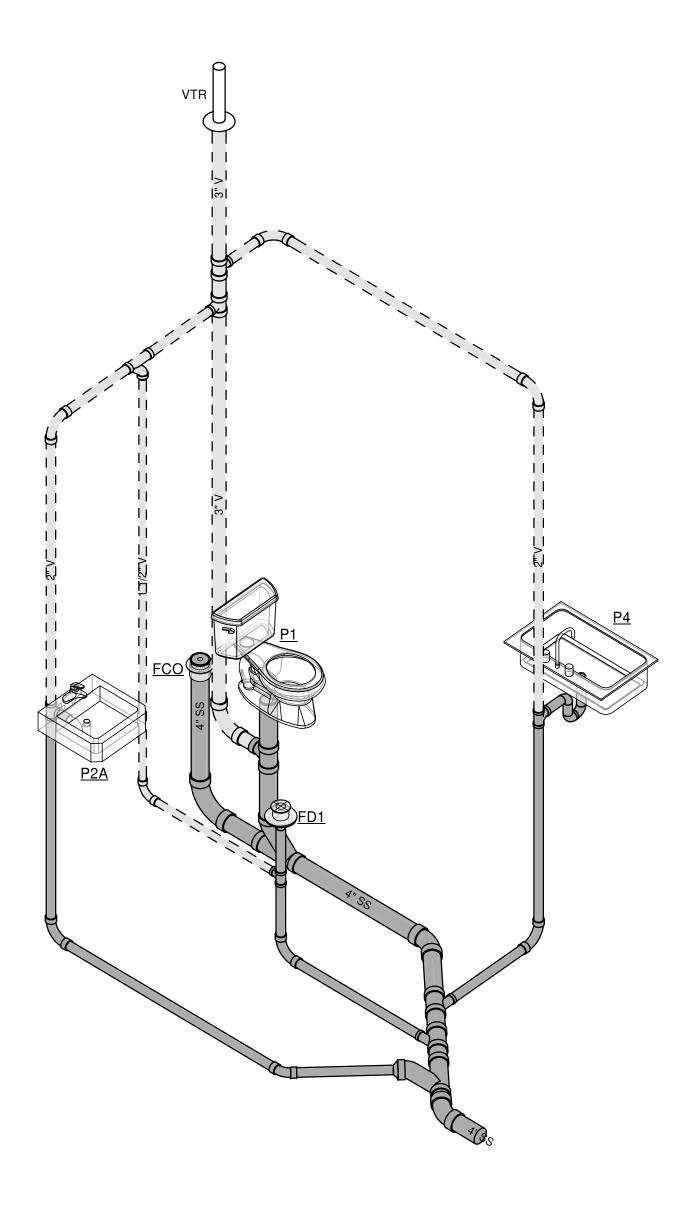

1.	
_	
2.	
n	
3.	,
4.	
+.	

	F
TAG	
FCO	
FD1	
P1	
P2A	
P3	
P4	
P5	


SANITARY WASTE AND VENT RISER NOT TO SCALE


SANITARY RISER GENERAL NOTES

SANITARY RISERS ARE DIAGRAMMATIC. RISERS INDICATE GENERAL PIPE ROUTES AND SIZES FOR SYSTEM. CONTRACTOR SHALL PROVIDE ALL NECESSARY OFFSETS TO PROVIDE A FULLY FUNCTIONING SYSTEM. SOME P-TRAPS FOR FIXTURES ARE NOT SHOWN FOR CLARITY OF RISER. ALL PLUMBING FIXTURES WITH SANITARY CONNECTIONS SHALL BE PROVIDED WITH EITHER INTEGRAL OR ANCILLARY P-TRAPS. CONTRACTOR SHALL INSTALL ALL PLUMBING FIXTURES IN ACCORDANCE WITH ALL APPLICABLE CODES AND AUTHORITIES HAVING JURISDICTION. CLOSELY COORDINATE ALL VTR ROOF PENETRATIONS WITH ABOVE CEILING DUCTWORK AND STRUCTURE. COORDINATE WITH ARCHITECT FOR FINAL LOCATION.

F	IXTURE CONNECTION Ø -	BLYTH	VILLE	
		BRANCH	I CONNECT	IONS
	DESCRIPTION	DCW	DHW	SS
	FLOOR CLEANOUT			4"
	FLOOR DRAIN - 5" STRAINER			2"
	WATER CLOSET - FLUSH TANK - ADA	1/2"		4"
	WALL HUNG LAVATORY	1/2"	1/2"	2"
	SINK - ADA - SINGLE COMPARTMENT	1/2"	1/2"	2"
	KITCHEN SINK - SINGLE COMPARTMENT	1/2"	1/2"	2"
	SINGLE STATION WATER COOLER	1/2"		2"



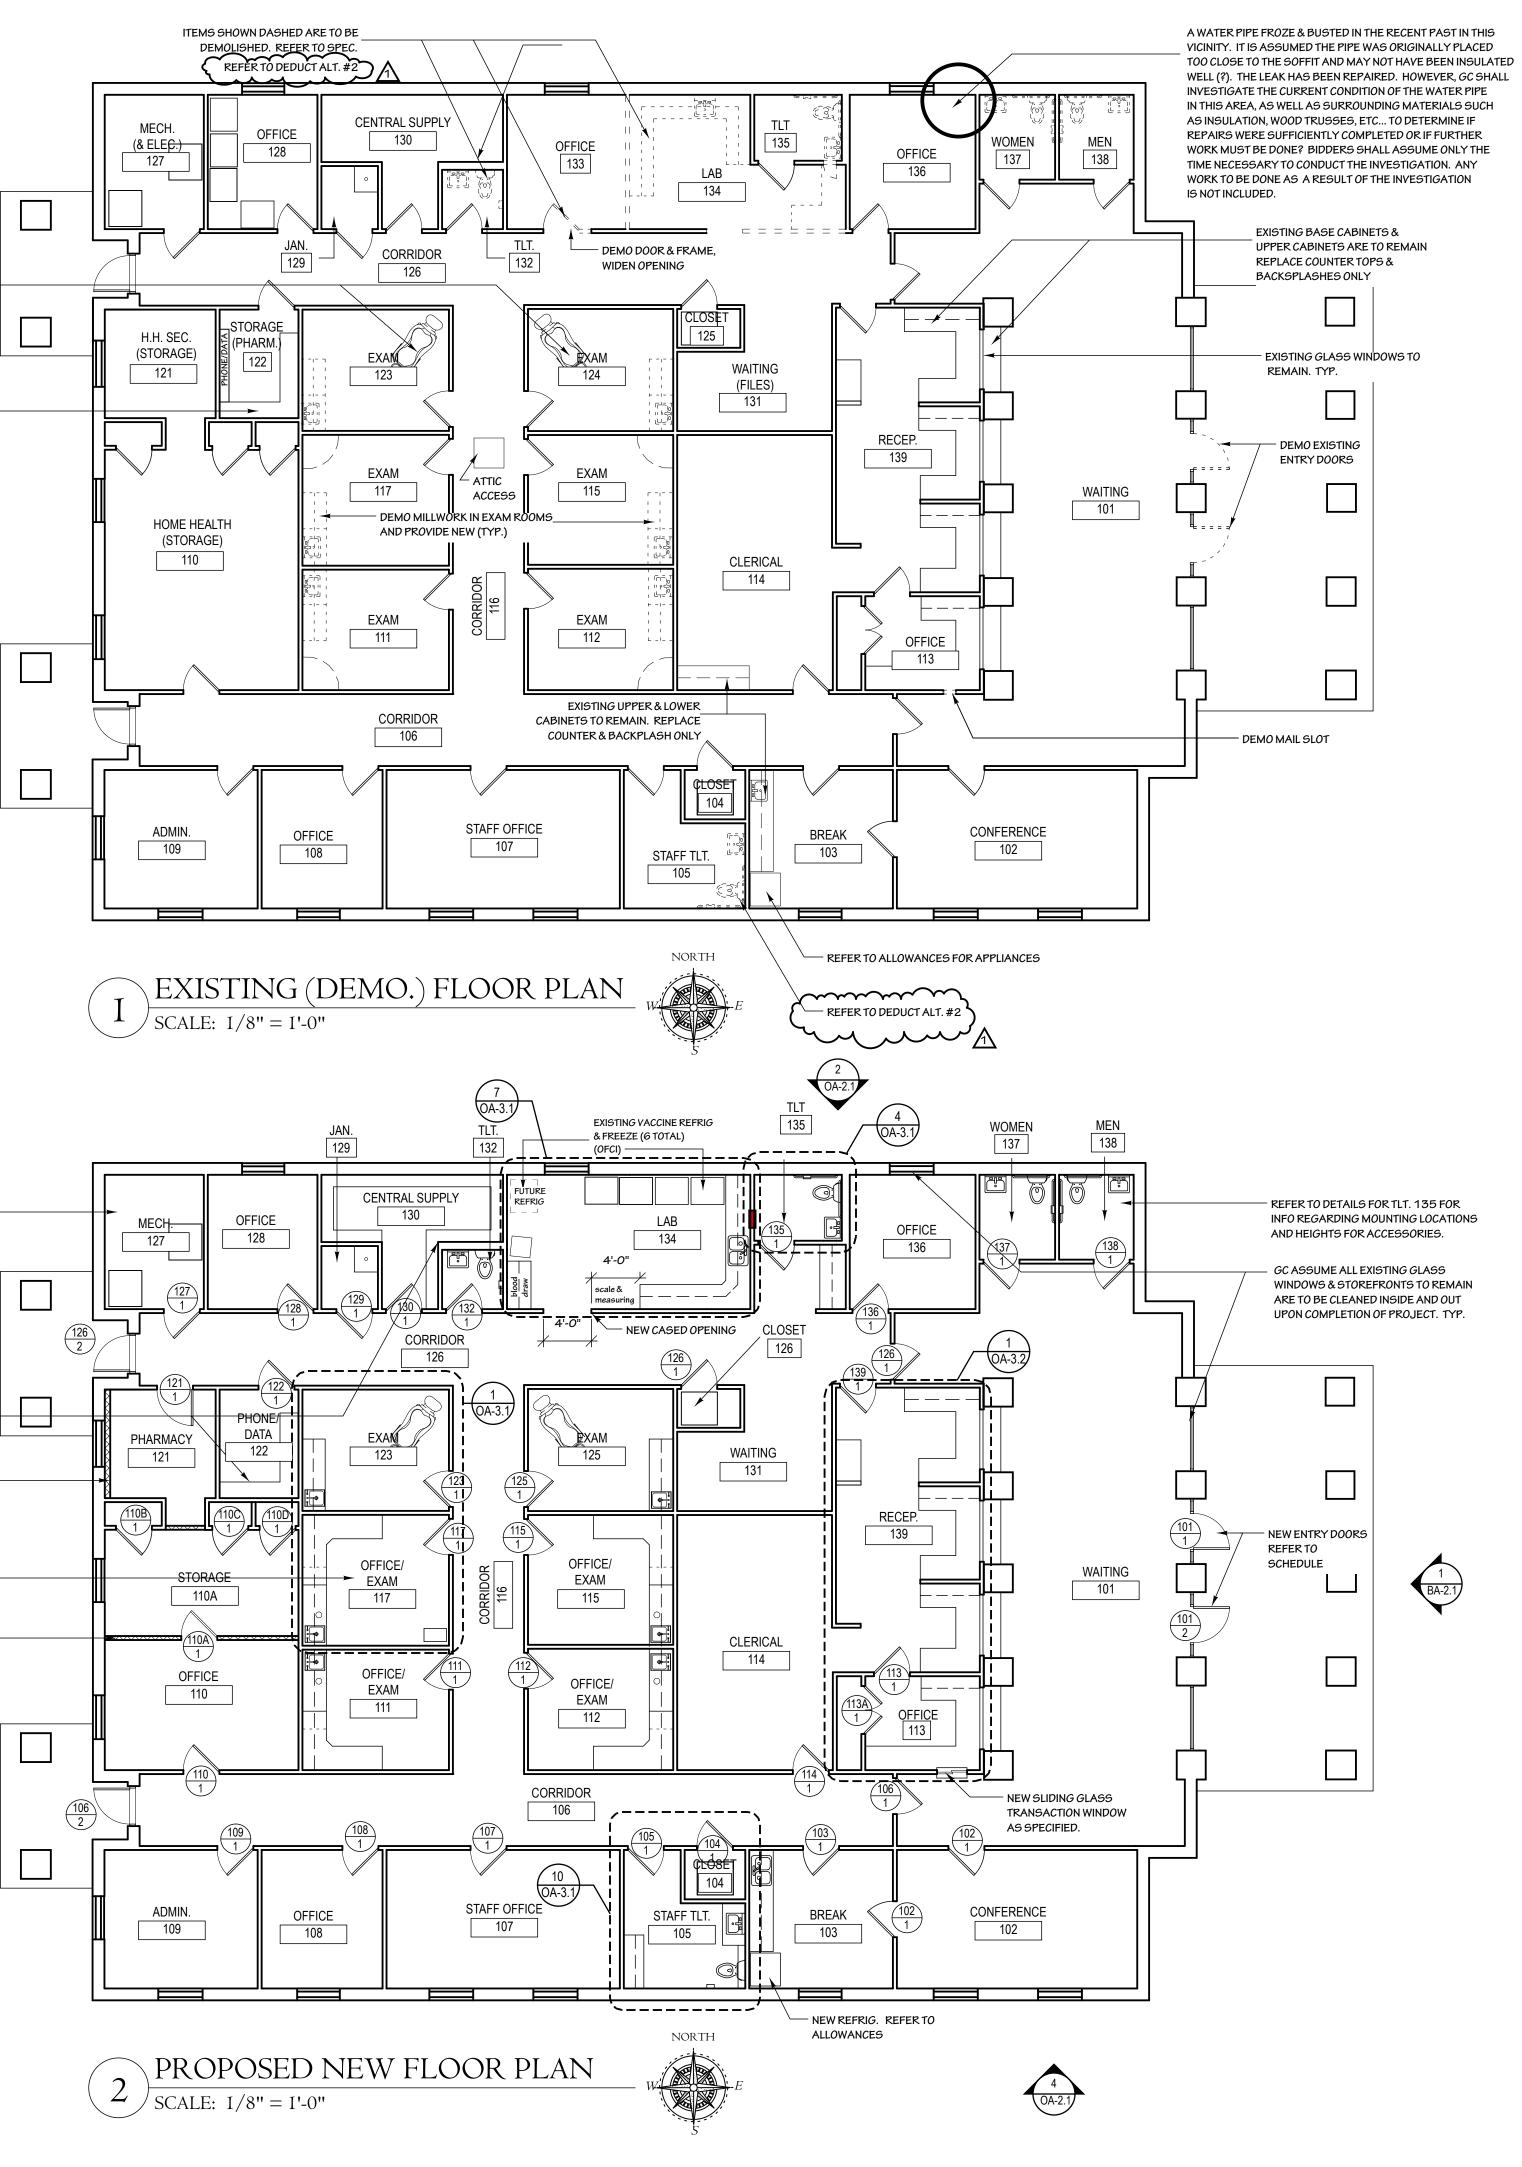

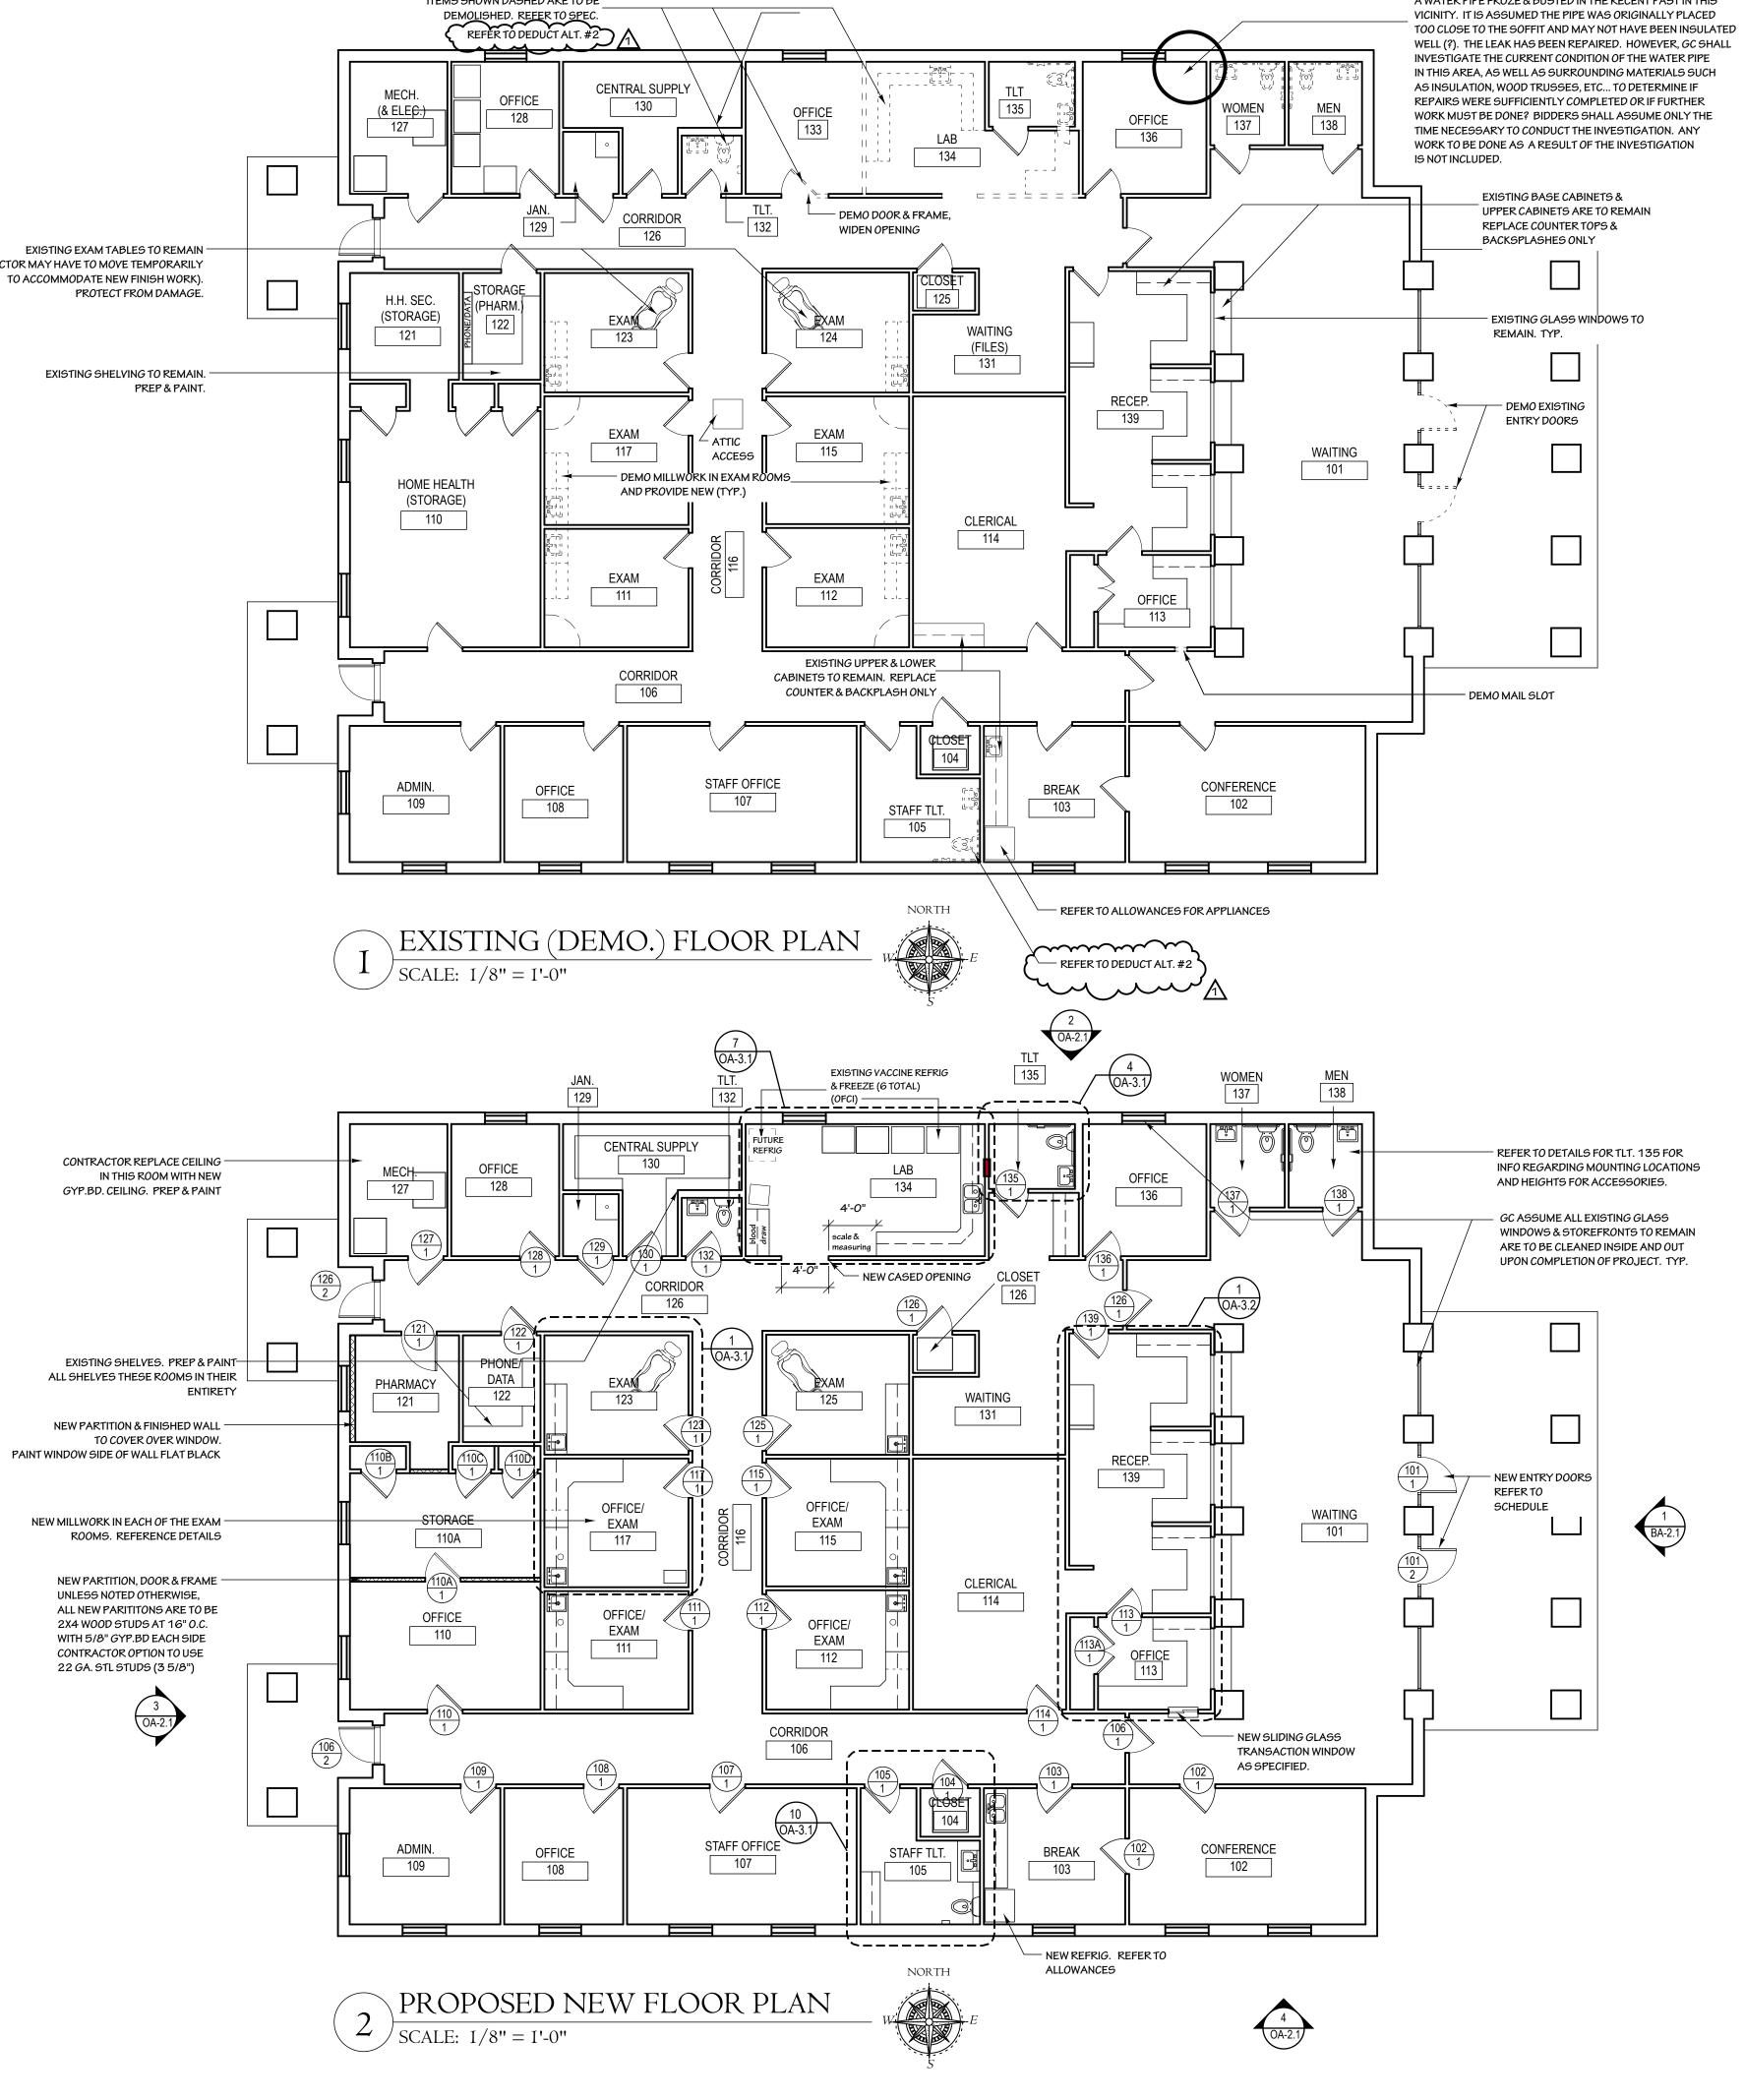

EXISTING EXAM TABLES TO REMAIN -(CONTRACTOR MAY HAVE TO MOVE TEMPORARILY TO ACCOMMODATE NEW FINISH WORK).

EXISTING SHELVING TO REMAIN. -

LEGEND:



(VACCINES)


154

NEW THRU-WALL SPECIMEN

EXAM < ORIG. ROOM NAME FROM ORIG.

ARCH. DRAWINGS - CURRENT USE OF ROOM SHOWN IN PARENTHESIS IF USE IS SIGNIFCANTLY DIFFERENT FROM ORIG. PLAN.



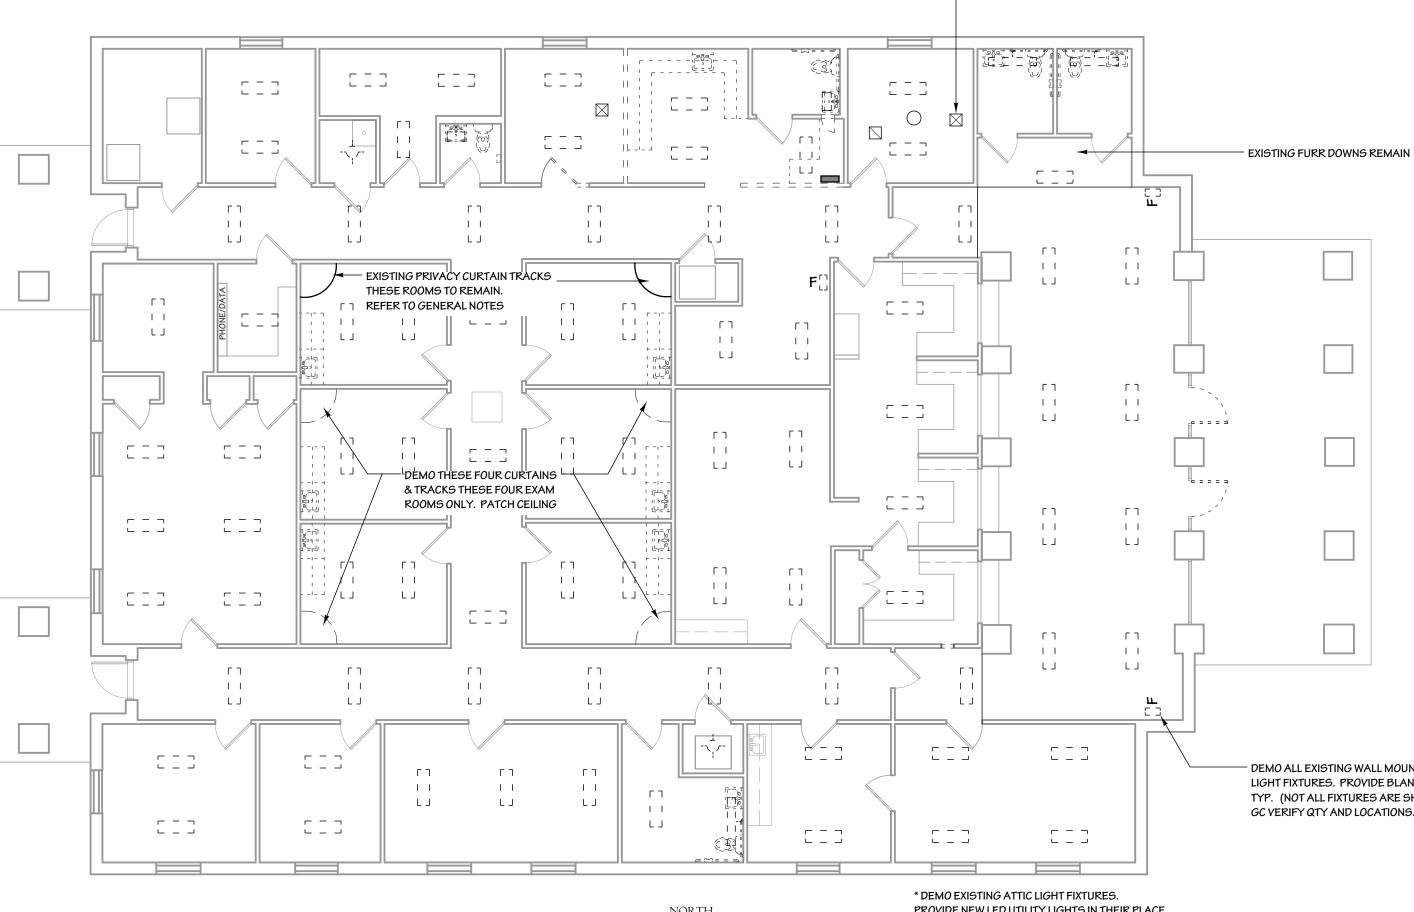


EXISTING (DEMO.) RCP SCALE: 1/8'' = 1'-0''




 $2 \xrightarrow{PROPOSED NEW RCP}_{SCALE: 1/8'' = 1'-0''}$



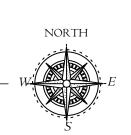



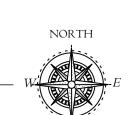

PROVIDE NEW LED UTILITY LIGHTS IN THEIR PLACE CONTRACTOR VERIFY QTY. PRIOR TO BID.

- DEMO ALL EXISTING WALL MOUNTED U/V LIGHT FIXTURES. PROVIDE BLANK COVER PLATE. TYP. (NOT ALL FIXTURES ARE SHOWN ON THIS PLAN) GC VERIFY QTY AND LOCATIONS.

- NOTE: EXISTING CEILING DEVICES SUCH AS SUPPLY & RETURN AIR, SPEAKERS, SMOKE DETECTORS, ETC... ARE NOT SHOWN. UNLESS NOTED OTHERWISE, THEY ARE TO REMAIN IN PLACE AND TO BE CLEANED ONLY (NOT PAINTED). REFERENCE MECH & ELEC. DRAWINGS FOR ADDITIONAL INFORMATION.



1.) IN GENERAL, ALL EXISTING LIGHT FIXTURES ARE TO BE REMOVED AND REPLACED WITH NEW LED FIXTURES AS SCHEDULED (REFER TO ELECTRICAL) IN THEIR PRESENT LOCATION. WHERE ROOMS ARE BEING RECONFIGURED, SOME CEILING FINISH WORK WILL BE NECESSARY SO AS TO ALIGN NEW FIXTURES WITHIN NEW SPACE. THIS INCLUDES SOME NEW CONDUIT, BACK BOXES, GYP.BD. WORK, PATCHING AND RE-FINISHING.

CONTRACTOR SHALL STUDY AND COORDINATE THE WORK SHOWN BETWEEN ARCHITECTURAL AND ELECTRICAL DRAWINGS IN ORDER TO FULLY UNDERSTAND THE SCOPE OF WORK NECESSARY TO ACCOMPLISH INTENT.

- 2.) EXISTING CEILING MOUNTED PRIVACY CURTAIN TRACKS IN THE EXAM ROOMS SHALL REMAIN. ONLY EXAM ROOMS 123 & 124 WILL HAVE EXAM TABLES AND WILL USE PRIVACY CURTAINS. INSTALL NEW "MODO-MED" ANTIMICROBIAL NEW SHADOW CUBE CURTAINS IN STANDARD COLOR TO BE SELECTED BY ARCHITECT (WWW.MODOMED.COM). PROVIDE SAMPLES, EXISTING CURTAIN TRACKS IN REMAINING EXAM ROOMS SHALL REMAIN AS-IS (NO WORK).
- 3.) SOME LIGHT FIXTURE LOCATIONS WILL CHANGE AS A RESULT OF MOVING OF PARTITIONS. CONTRACTOR SHALL DEMO BACK-BOXES AND PATCH SHEETROCK AND/OR INSTALL NEW BACK BOXES, NEW CONDUIT, AS NECESSARY, TO ACCOMMODATE. COORDINATE FINISH WORK WITH WORK SHOWN ON ELECTRICAL DRAWINGS.
- 4.) ALL CEILINGS ARE TO BE PAINTED NEW THROUGHOUT. SOME CEILINGS MAY HAVE TO BE PATCHED. MATCH TEXTURE. CONTRACTOR VERIFY FULL SCOPE. 4

LEGEND:

- NEW SURFACE MOUNTED FIXTURE (TYPE A) TO REPLACE EXISTING NEW SURFACE MOUNTED FIXTURE (TYPE A) IN NEW LOCATION. NOTE INTENTION TO
 - NEW RECESSED OF THE TO REPLACE EXISTING. NEW RECESSED CAN LIGHT (TYPE B)


ALIGN NEW FIXTURES WITH NEARBY EXISTING

- NEW WALL SCONCE (TYPE C) TO REPLACE EXISTING.
- NEW WALL SCONCE (TYPE D) IN NEW LOCATION.
- NEW PENDANT (TYPE E). NOT USED
- NEW PENDANT (TYPE F). NOT USED
- NEW U/C LIGHT (TYPE G).

EXISTING GYP. BD CEILING HAS SOME DAMAGE AT TAPE JOINTS. REPAIR JOINTS, APPLY TEXTURE TO MATCH ADJACENT, PREP & PAINT ENTIRE

	REVICATION RECUTIVAL ARCHITECTURE P.O. Box 400, Scott, Arkansas 72142 (501) 951-3316 www.revivalarch.com SDC	
	Project Name: Project Name: Mississippi County Health Units Osceola Issue Date: Argunt 26, 2022 Revisions: Mississippi County Health Units August 26, 2025	
11	Sheet Contents: REFLECTED CEILING PLANS	
-	Sheet No: OA-I.2	



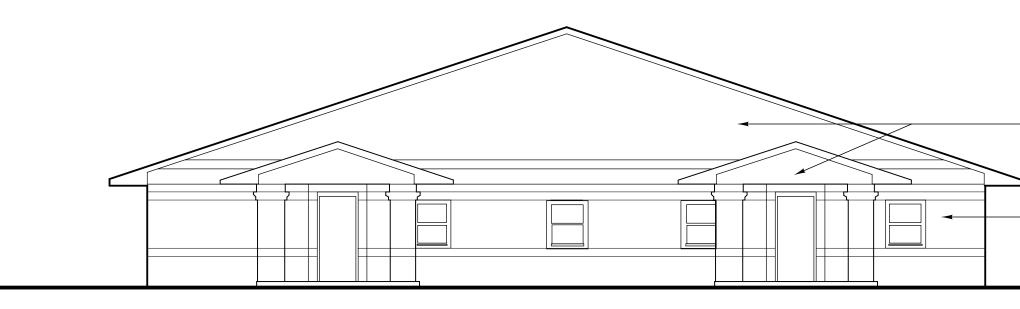




TO REMAIN. NO WORK.


- REPLACE ENTRY DOORS WITH NEW ALUM., NEW HARDWARE.


_ل____ل__




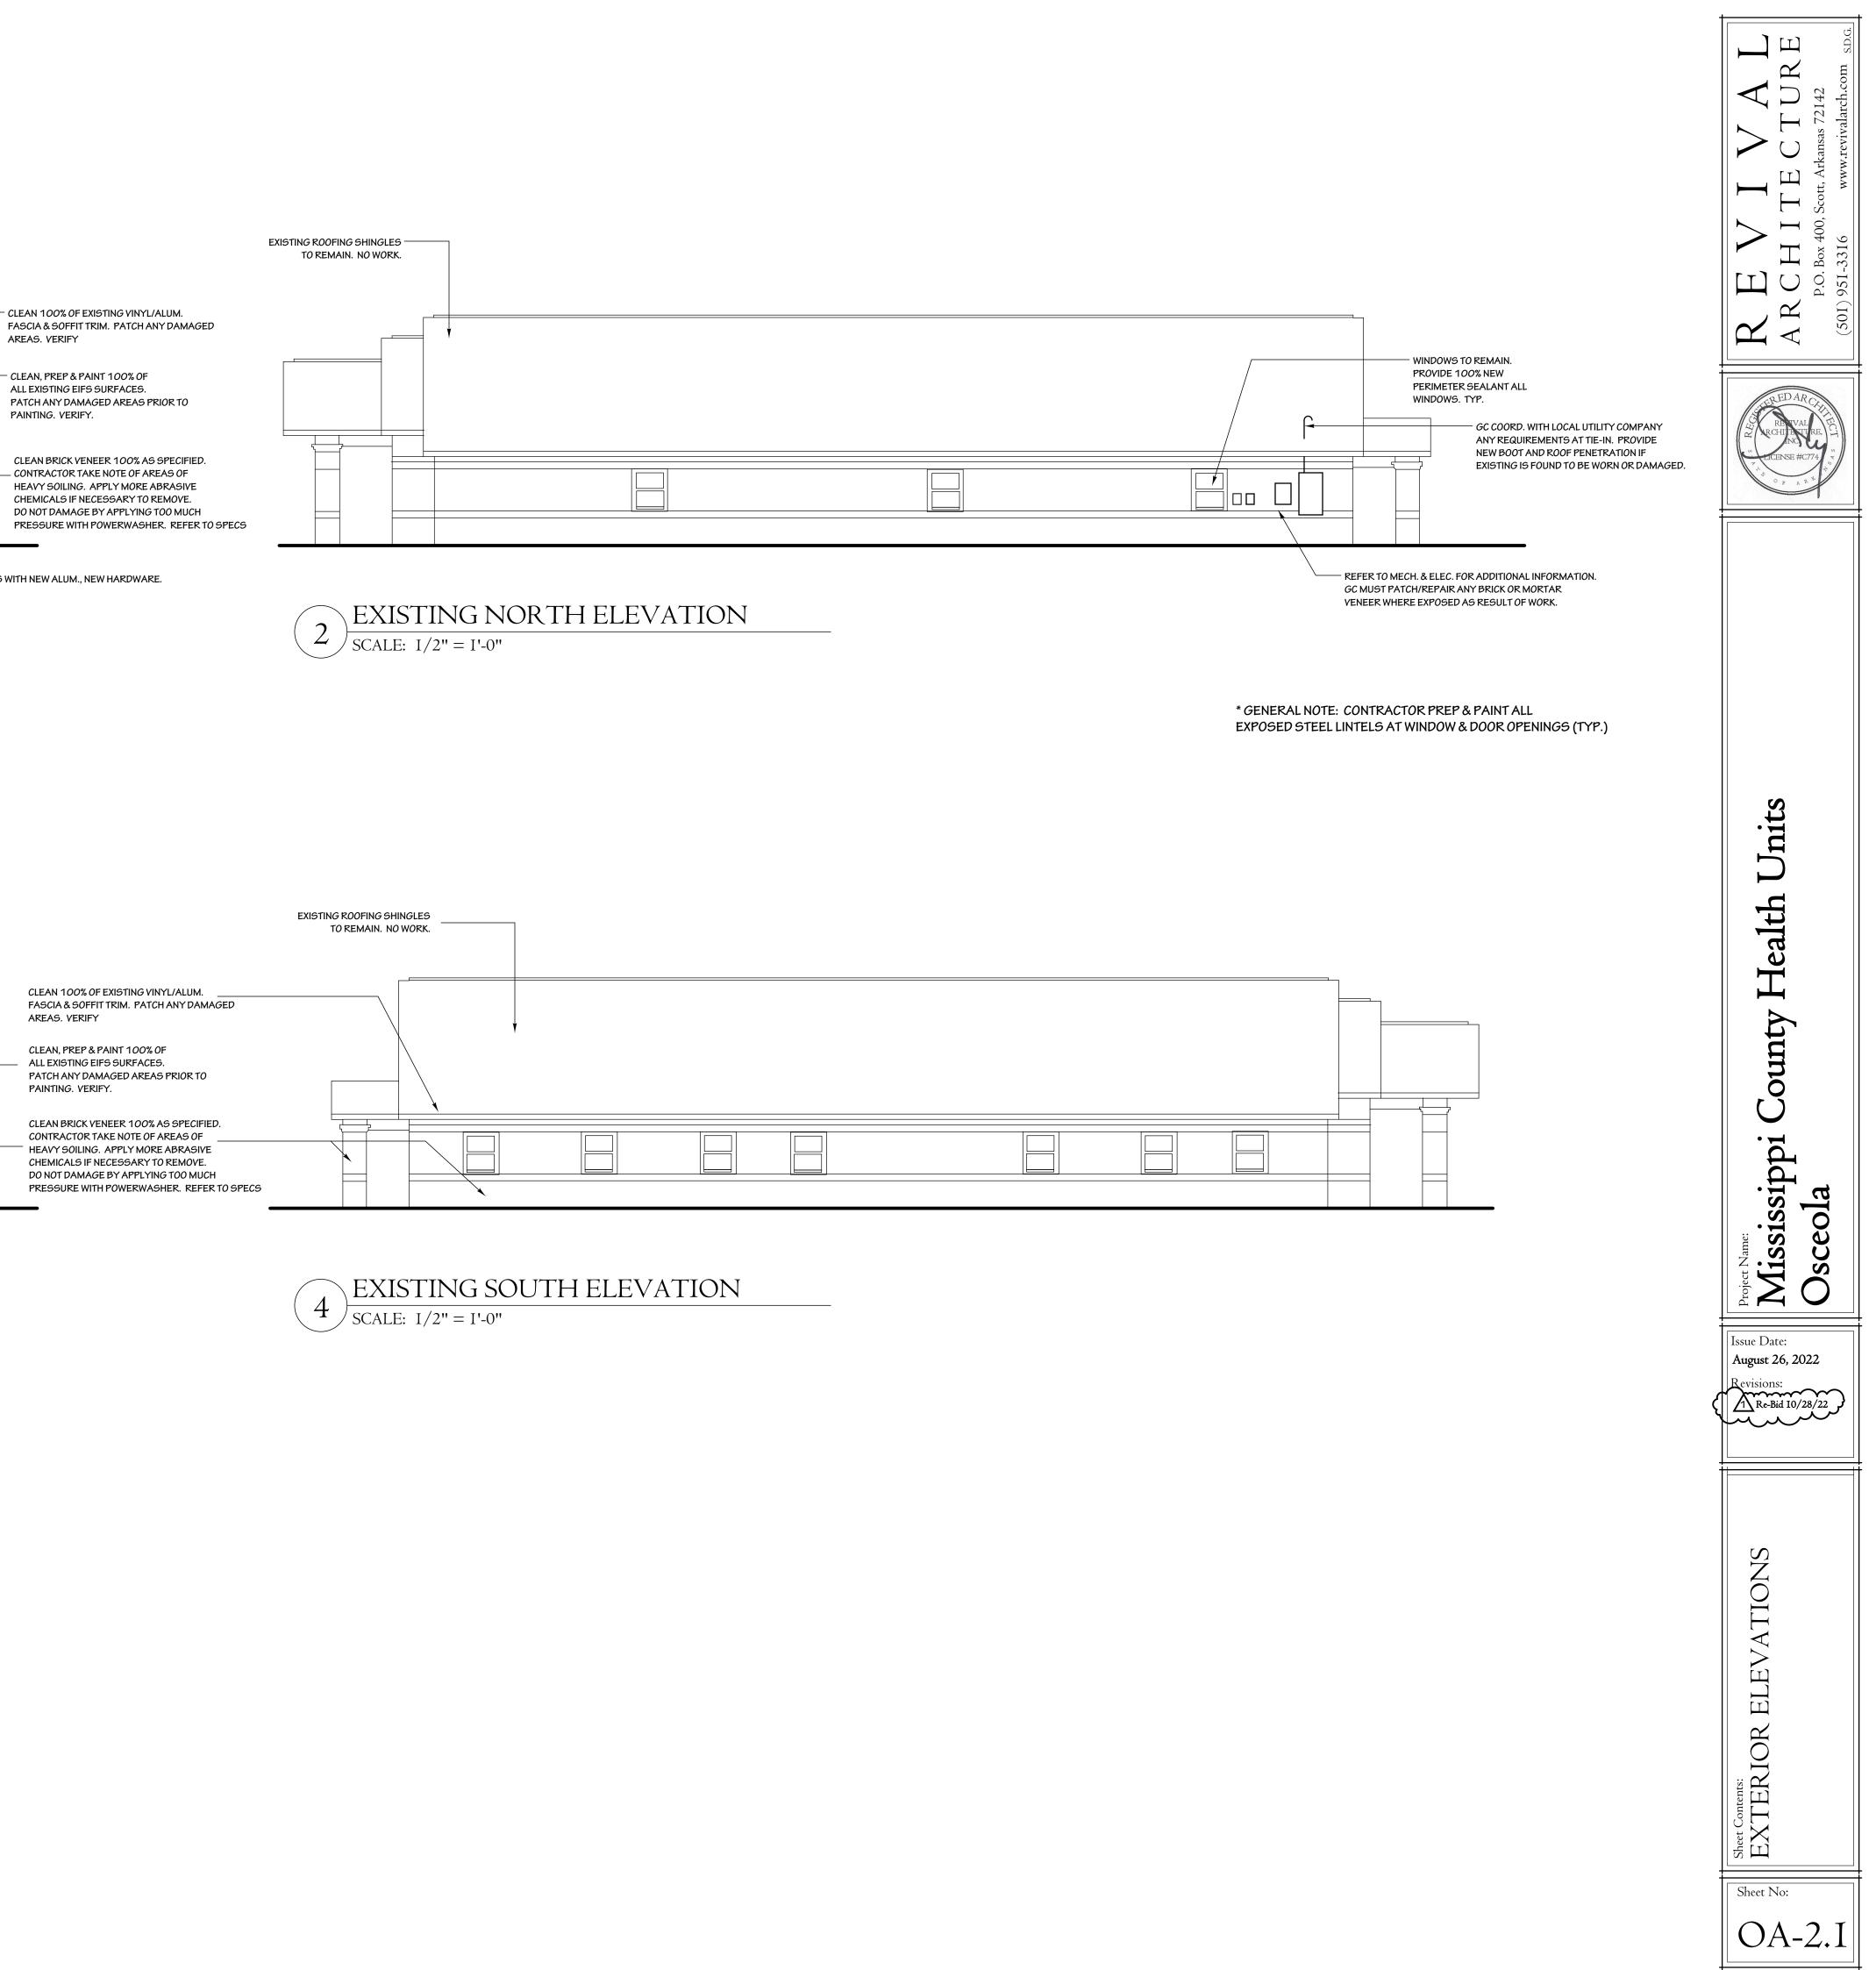



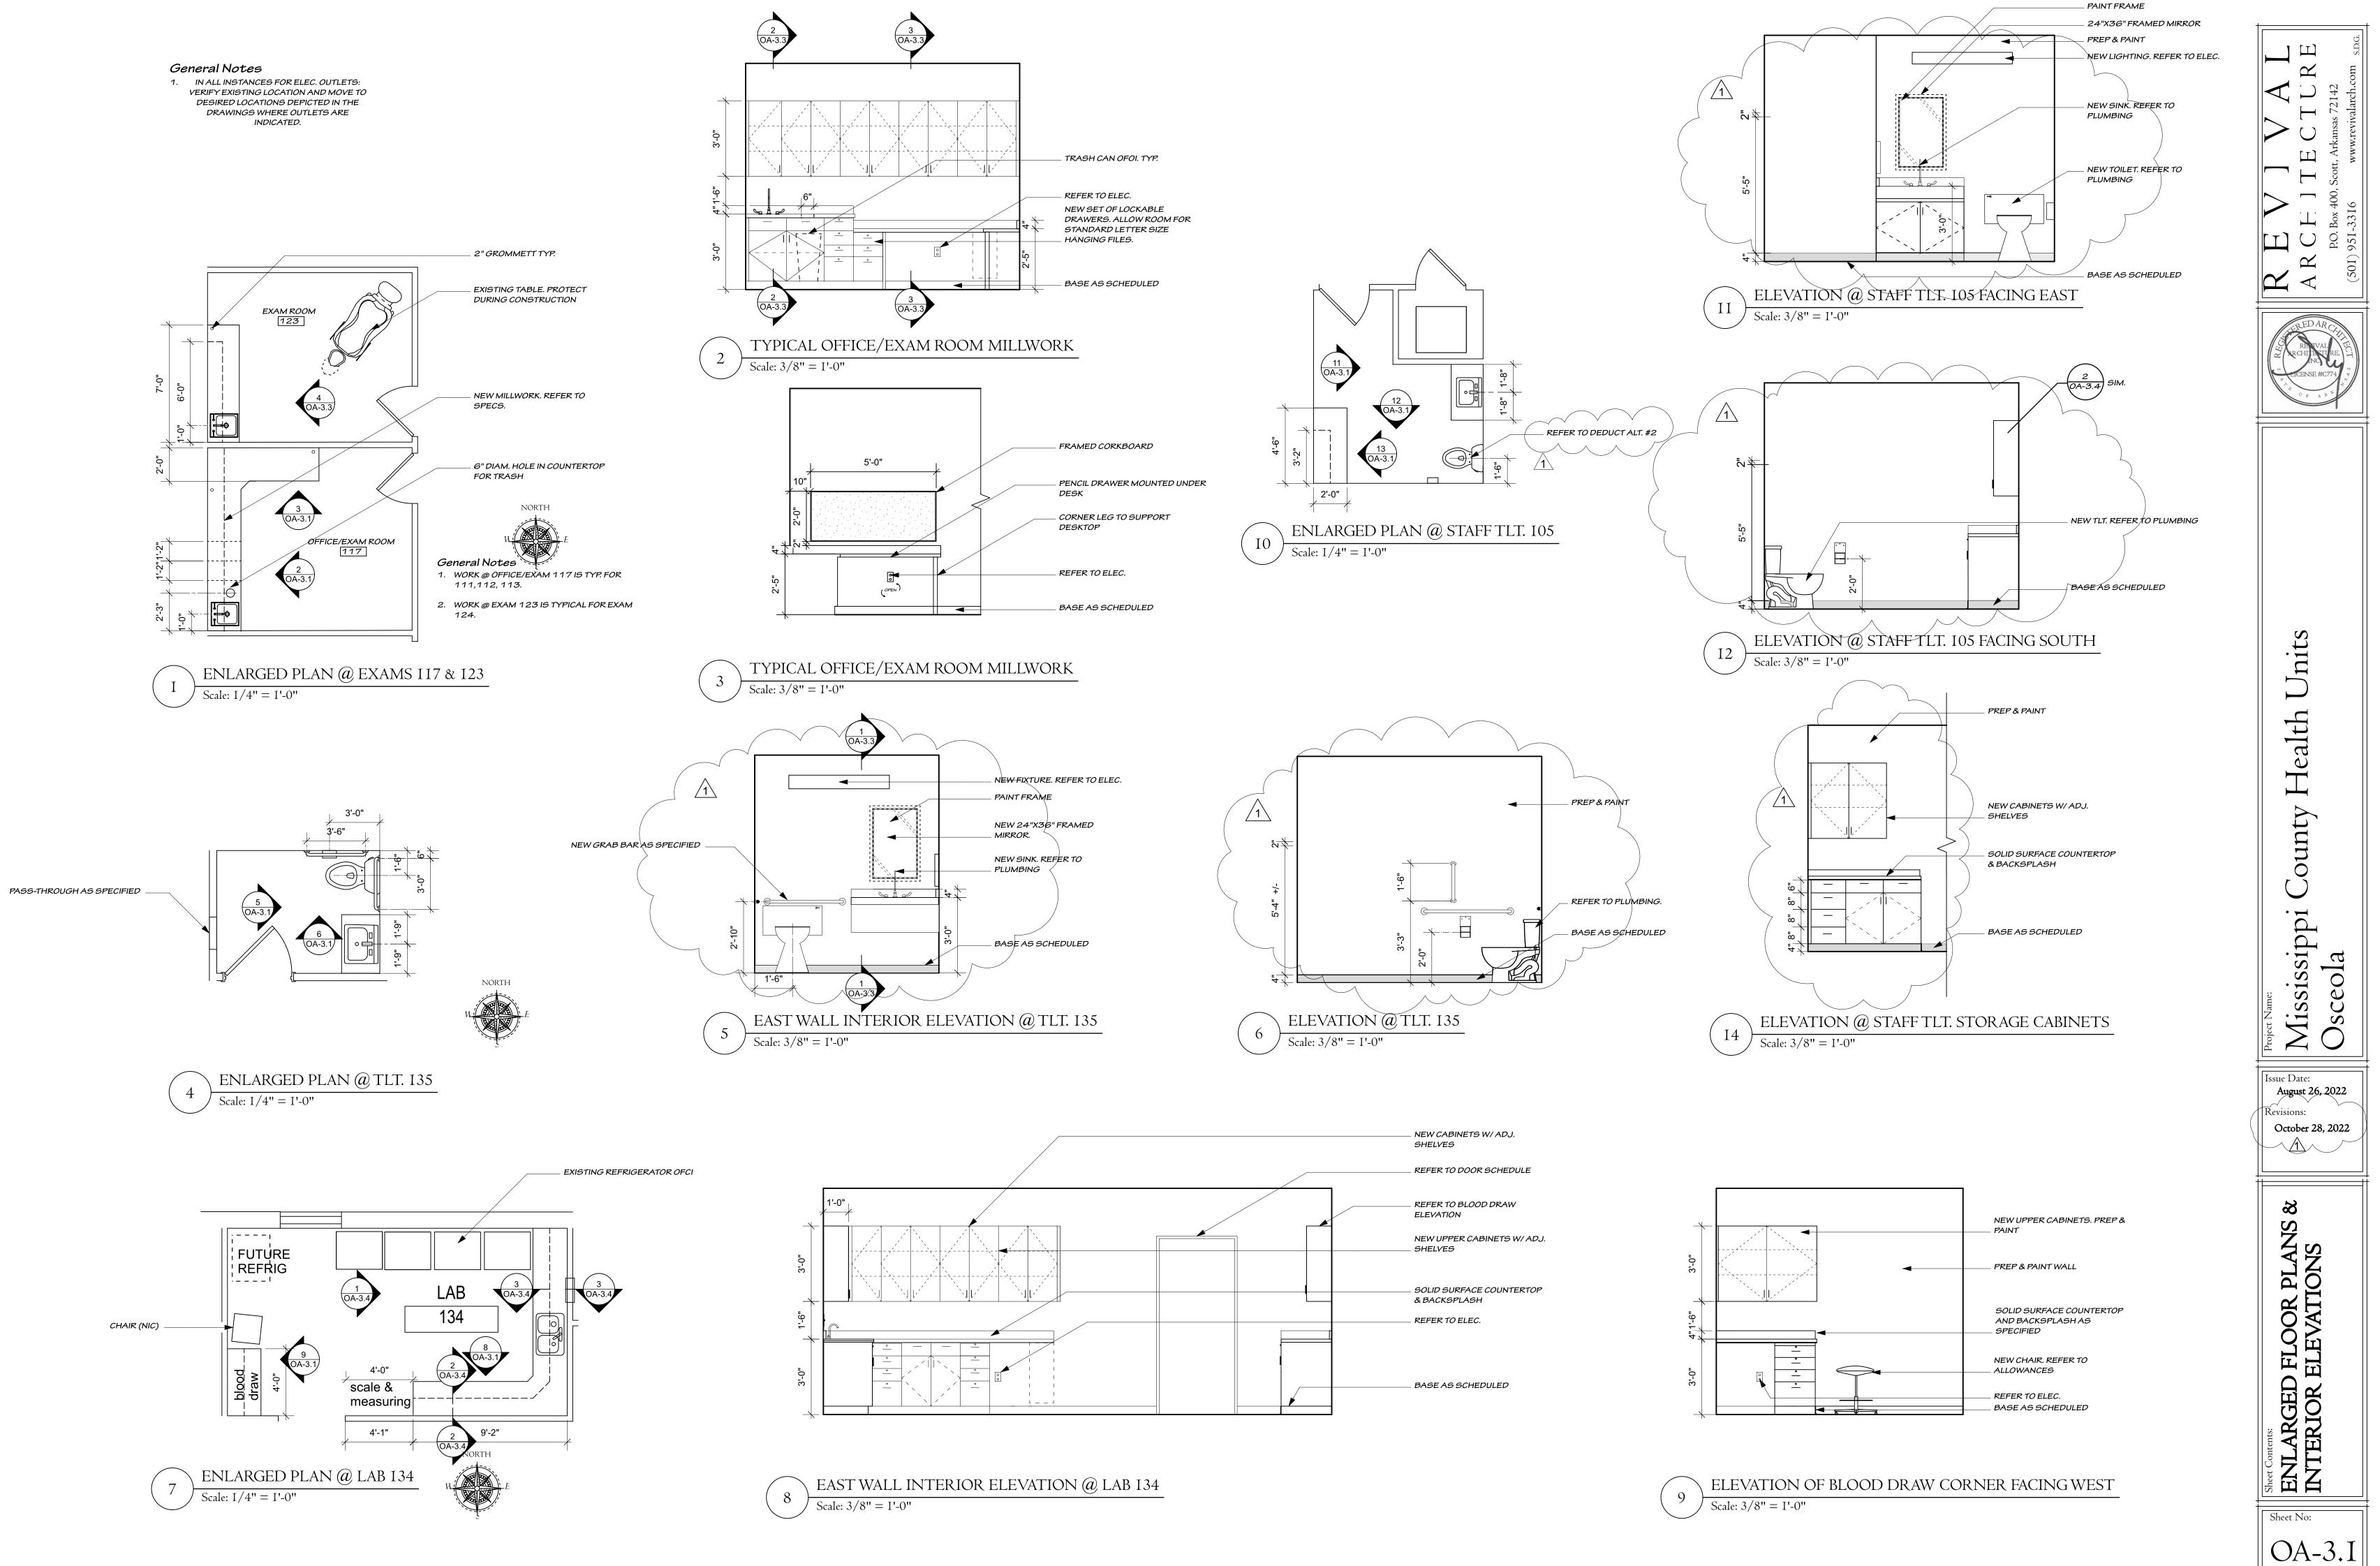

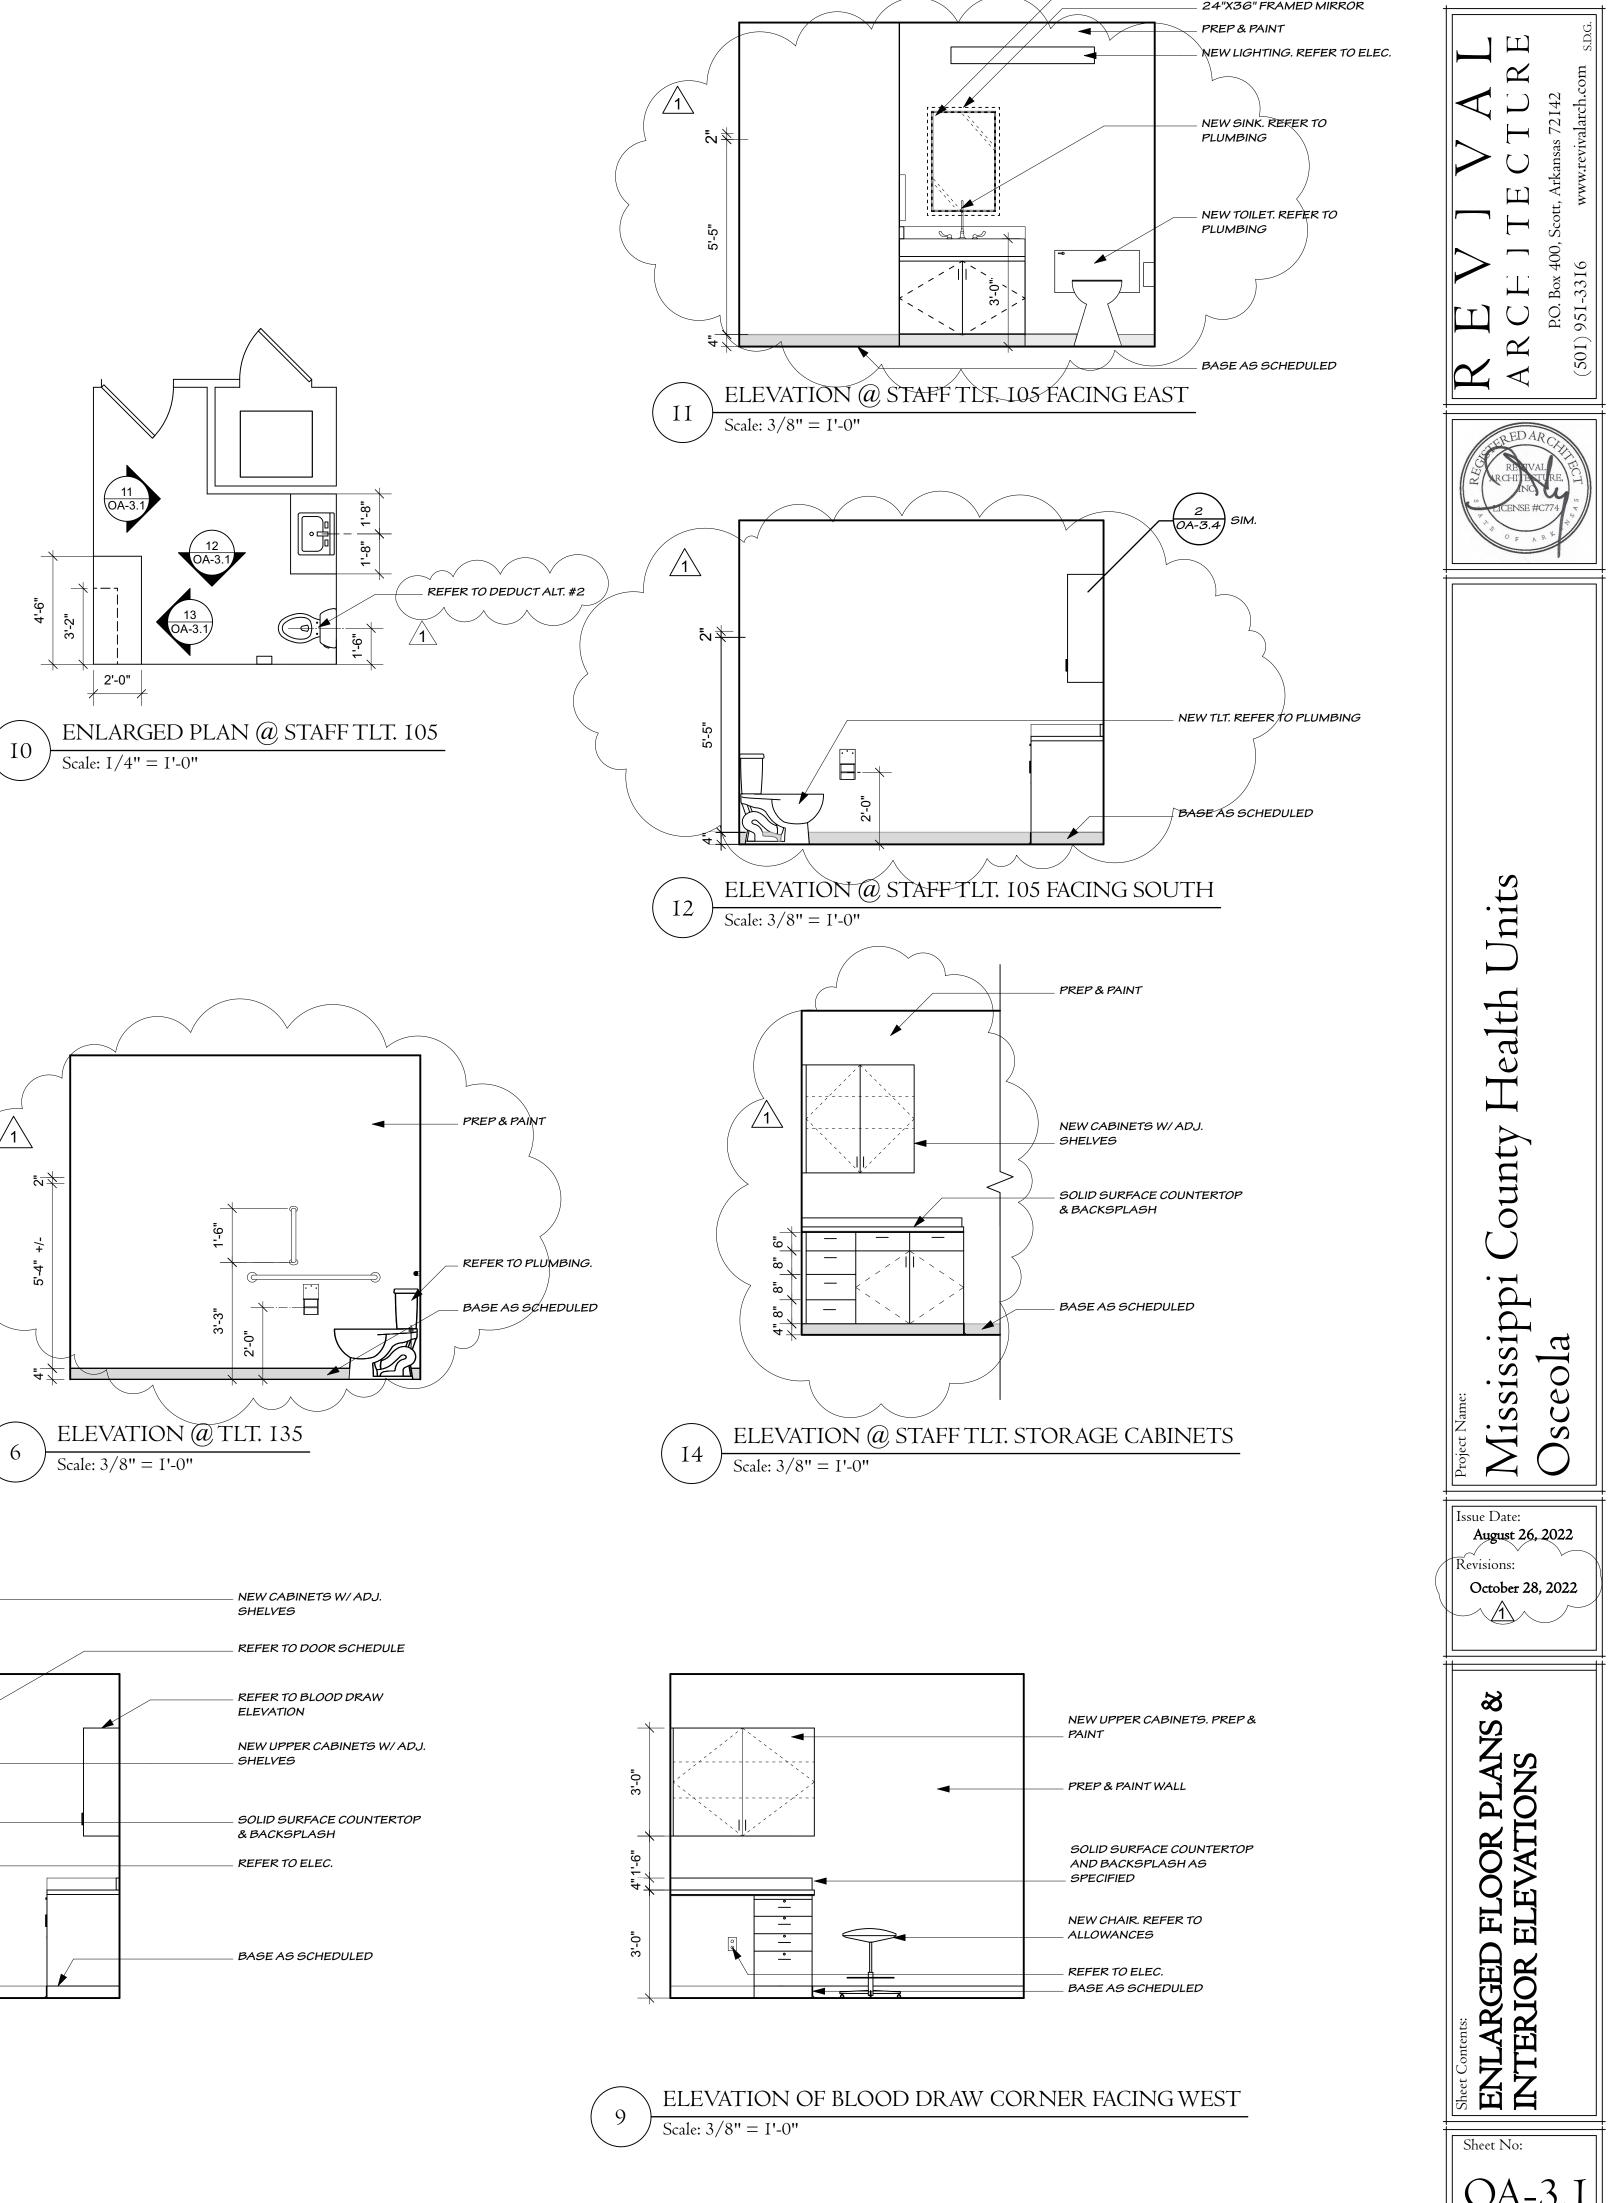

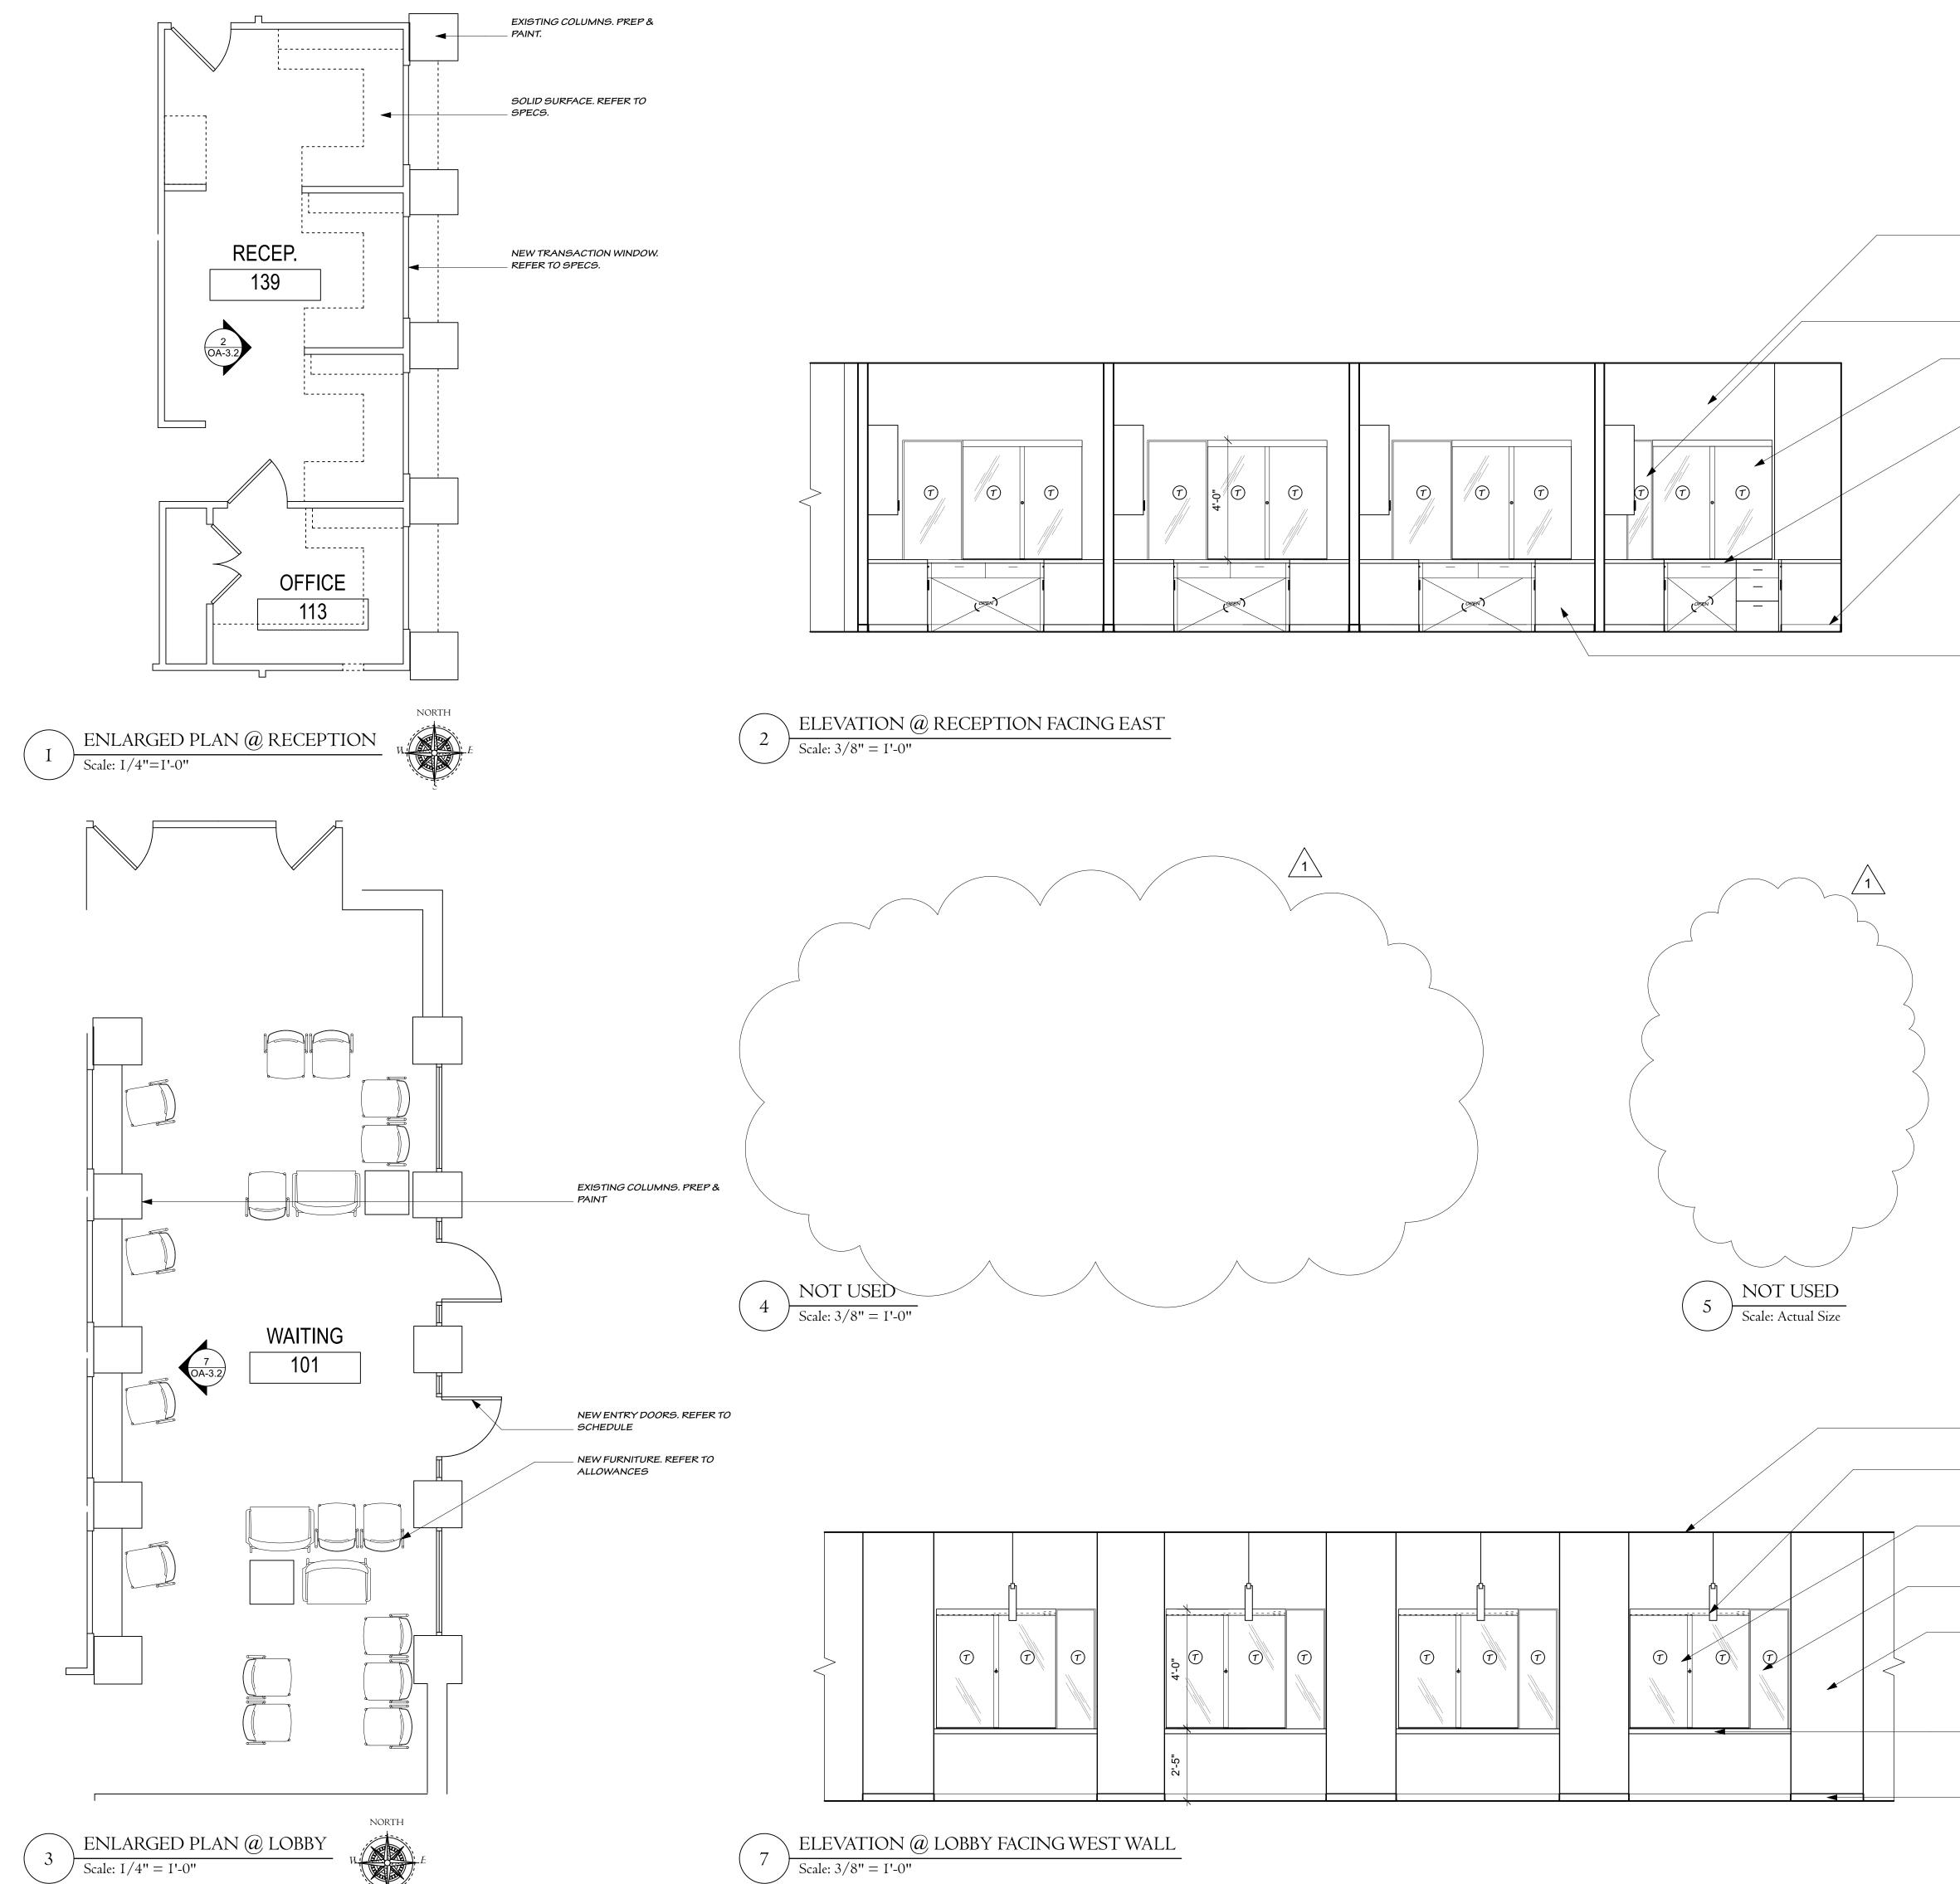

_ NEW PAINT. REFER TO SPECS.

_ TEMPERED FROSTED GLASS


TRANSACTION WINDOW

– SOLID SURFACE COUNTERTOPS AND BACKSPLASH

_ BASE AS SCHEDULED

EXISTING MILLWORK TO

REMAIN. REPLACE COUNTERTOPS & BACKSPLASH — ONLY.

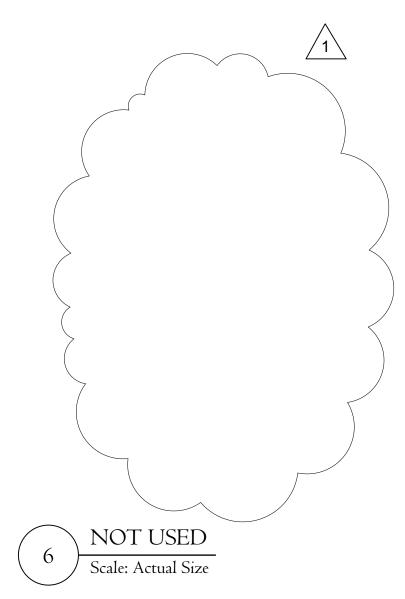

_ VERIFY CEILING HEIGHT

— NEW LIGHT FIXTURE. REFER TO ELEC.


TRANSACTION WINDOW. REFER TO SPECS.


– TEMPERED FROSTED GLASS. REFER TO SCHEDULE.


– EXISTING COLUMNS. PREP & PAINT. REFER TO SPECS.

SOLID SURFACE AS SPECIFIED


BASE AS SCHEDULED

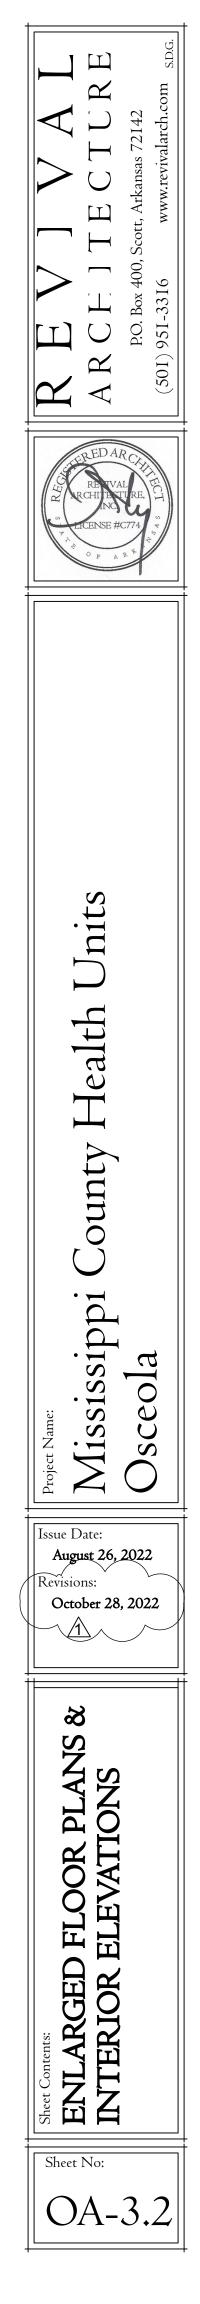

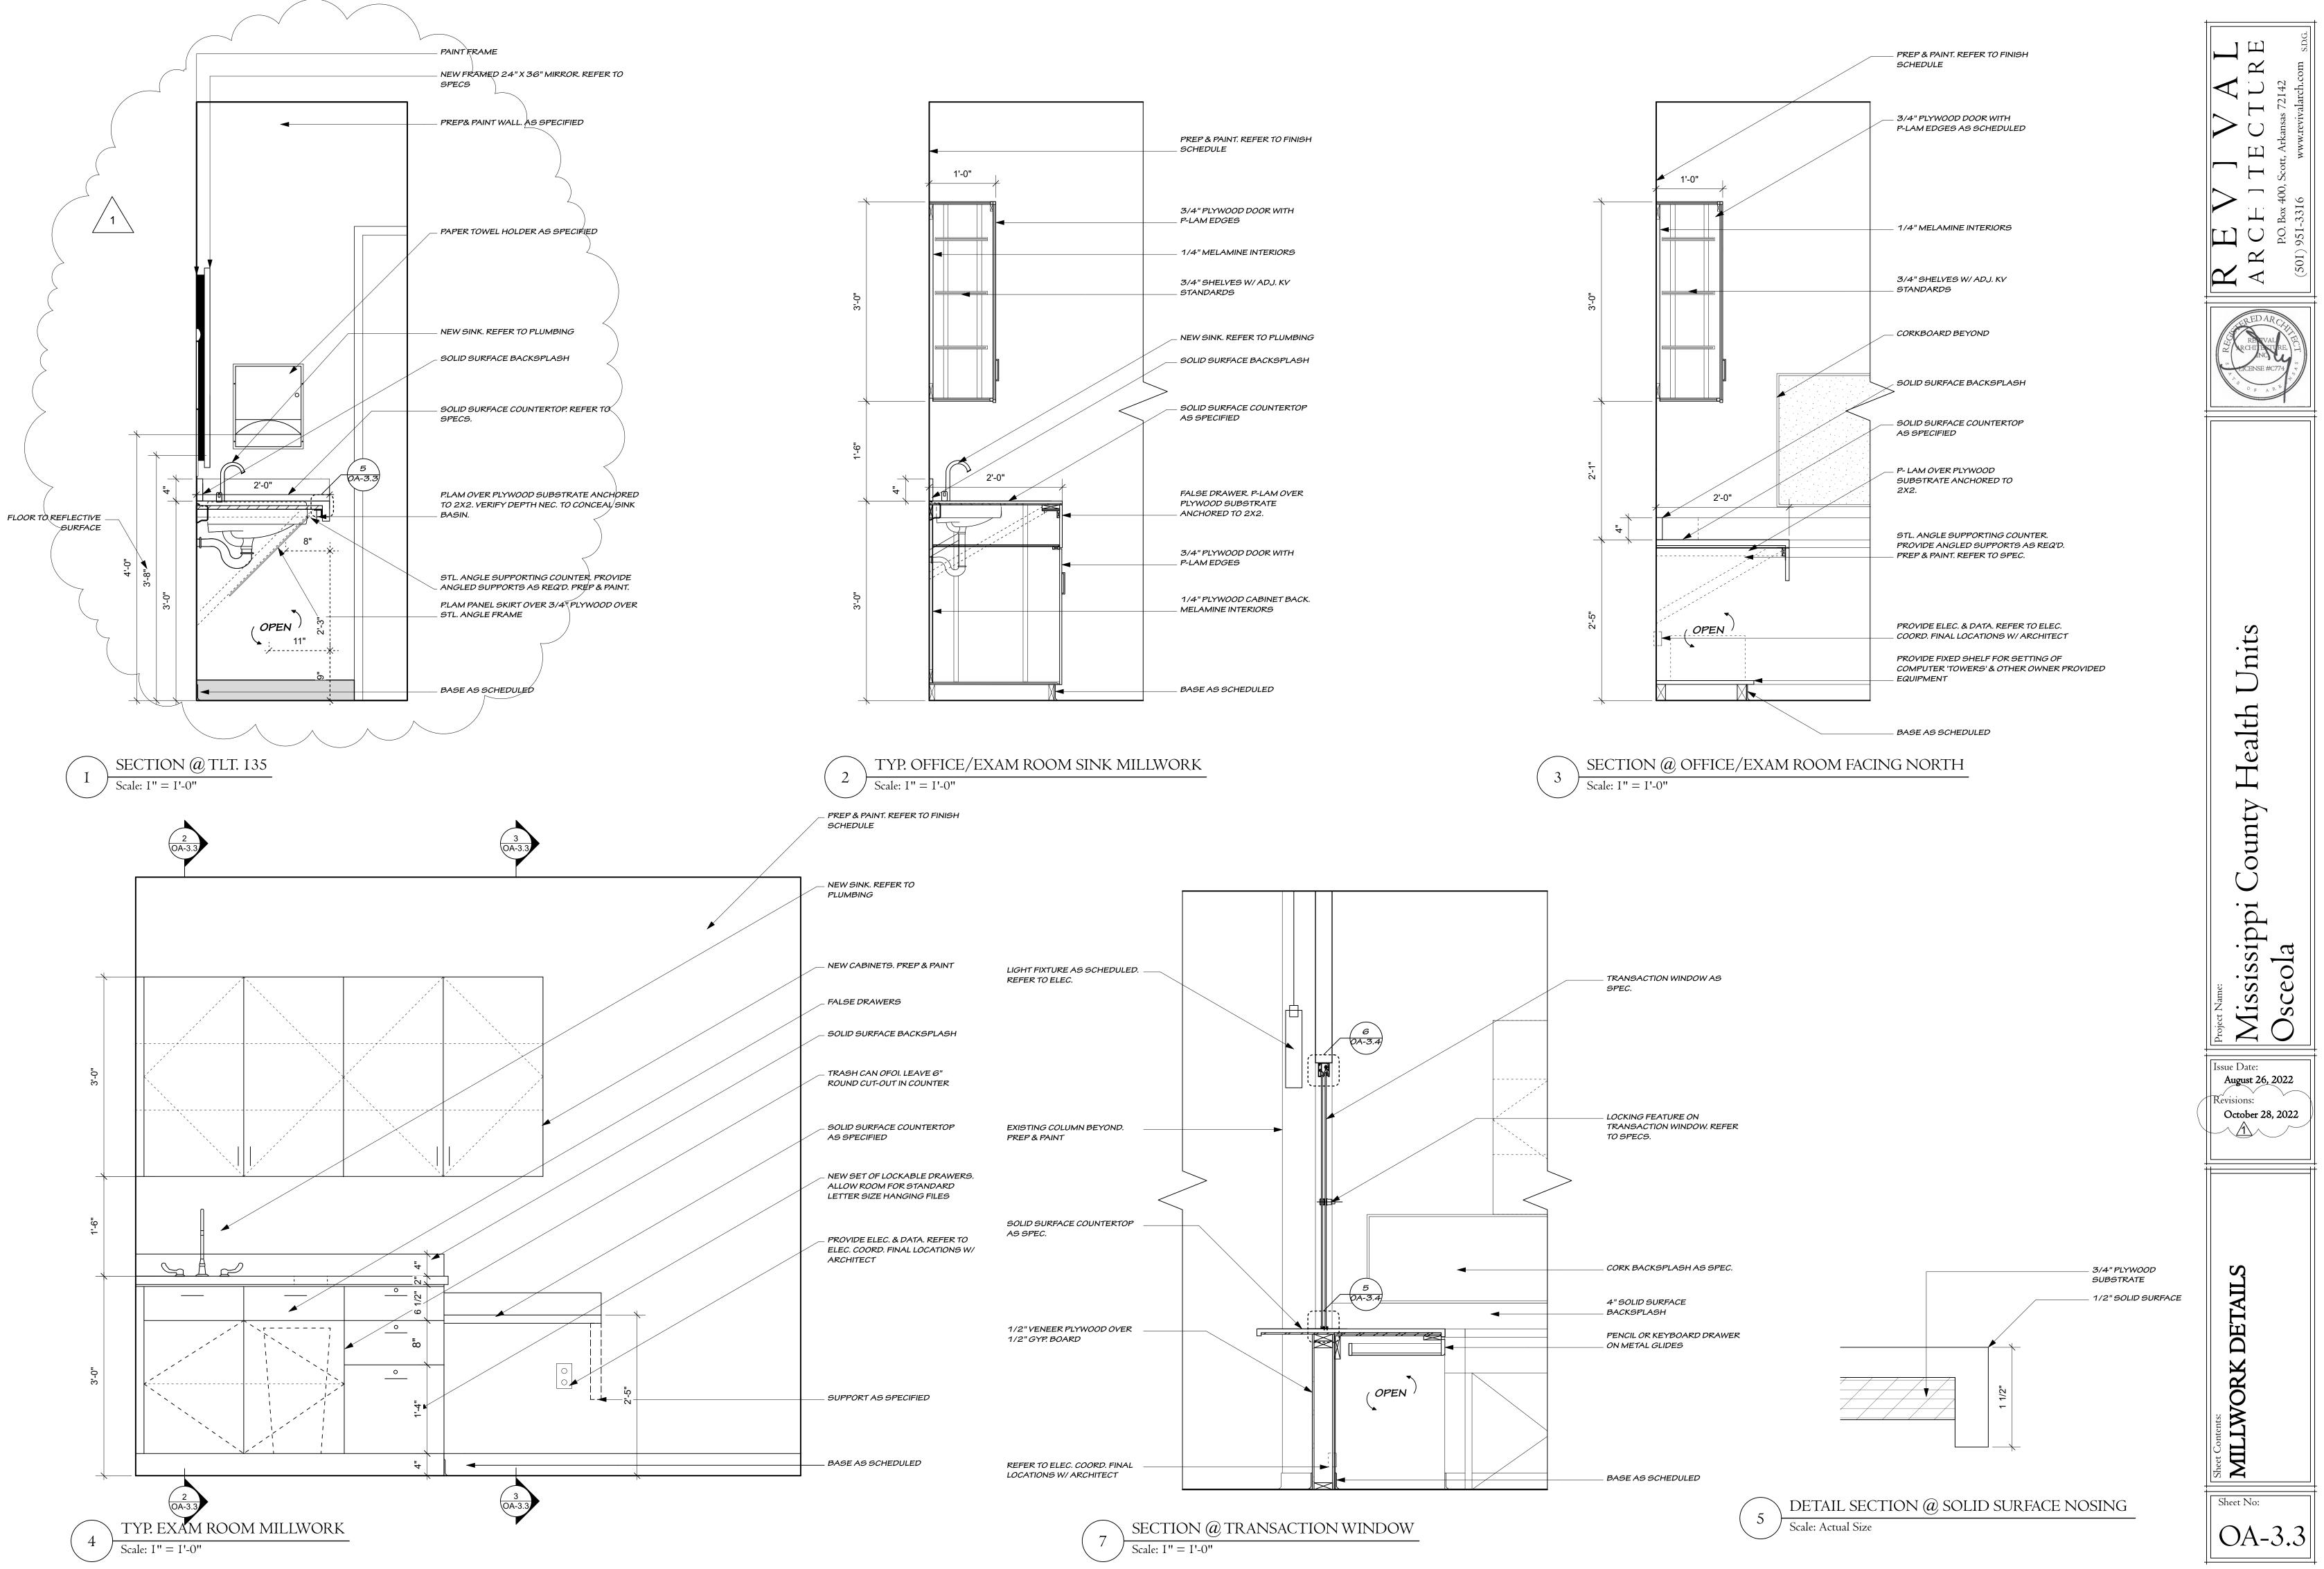


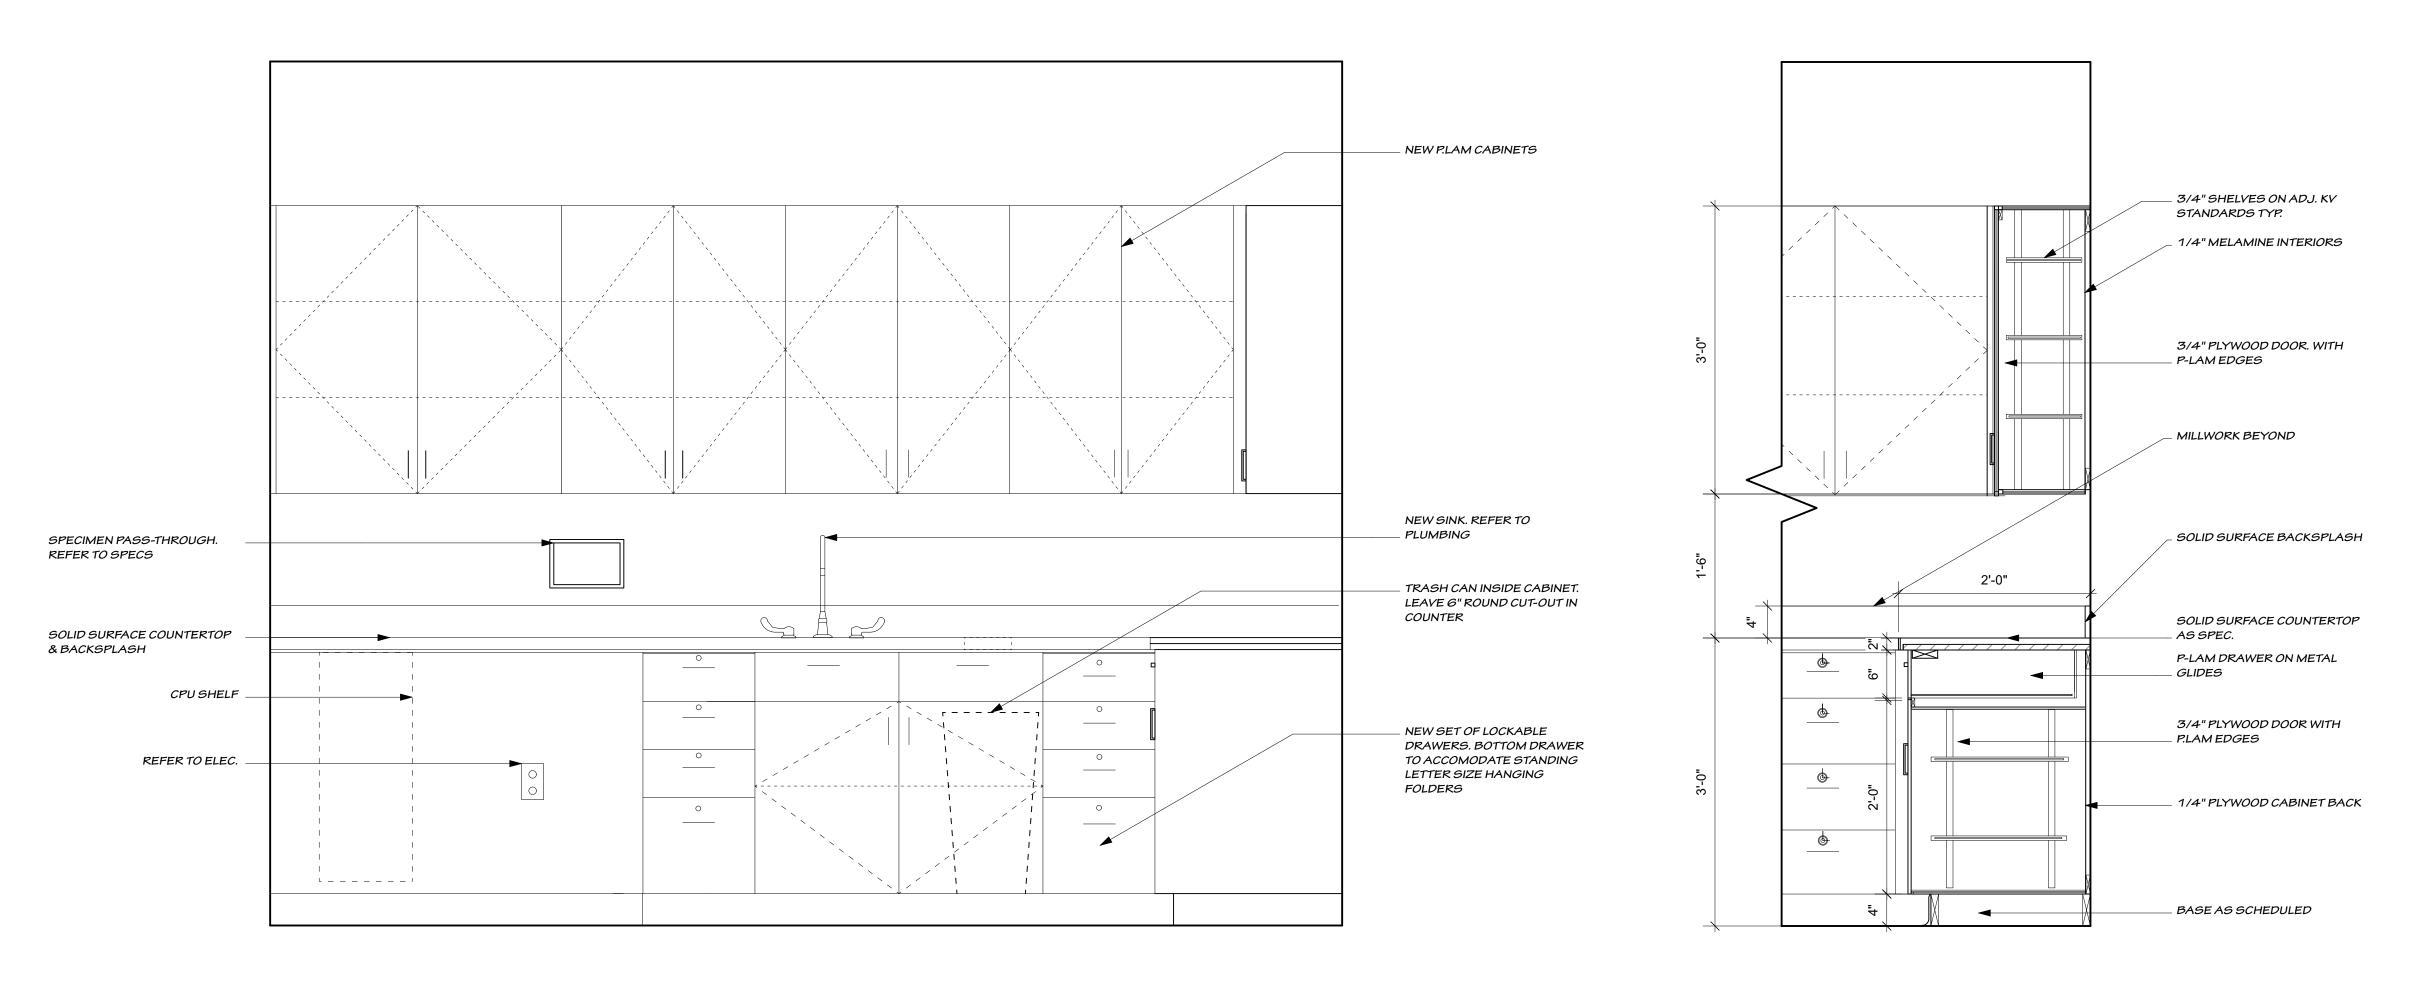



MILLWORK @ LAB FACING EAST Scale: I'' = I'-0''

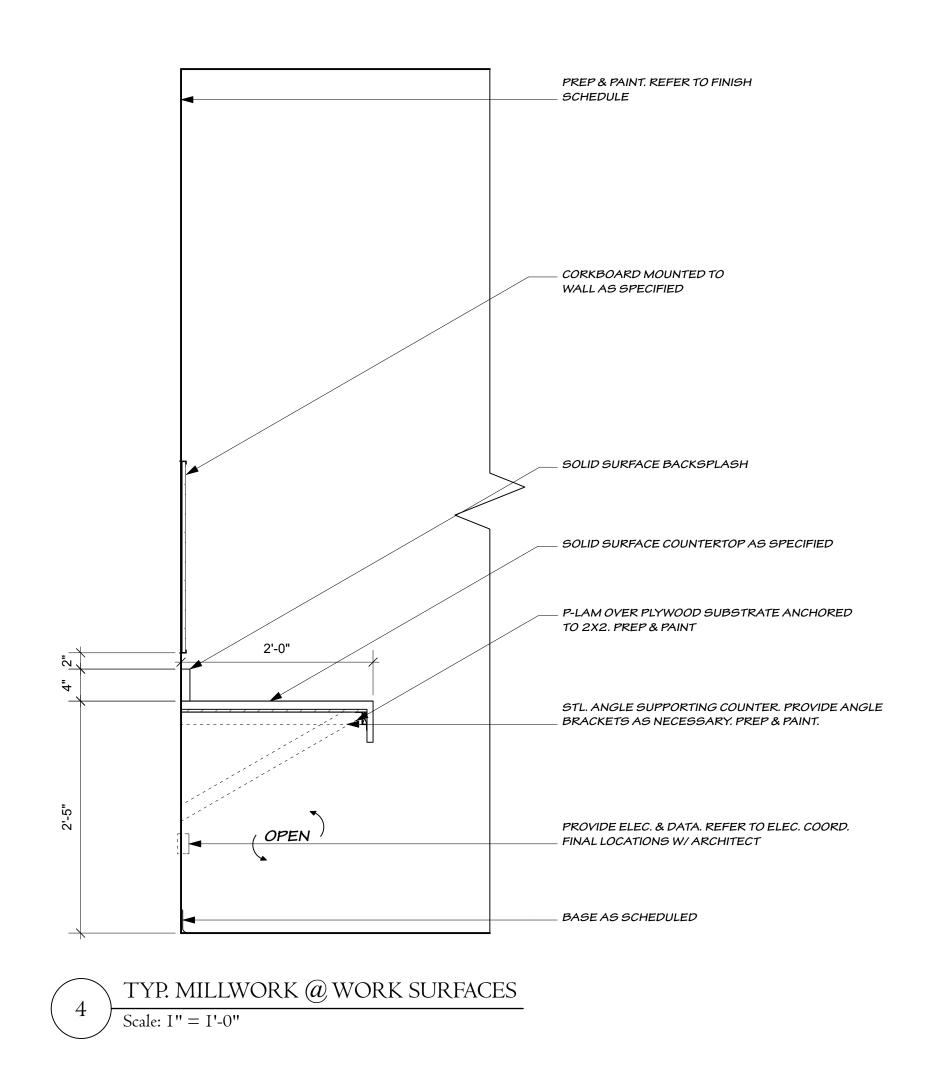

5

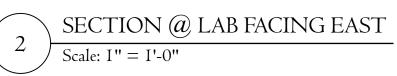

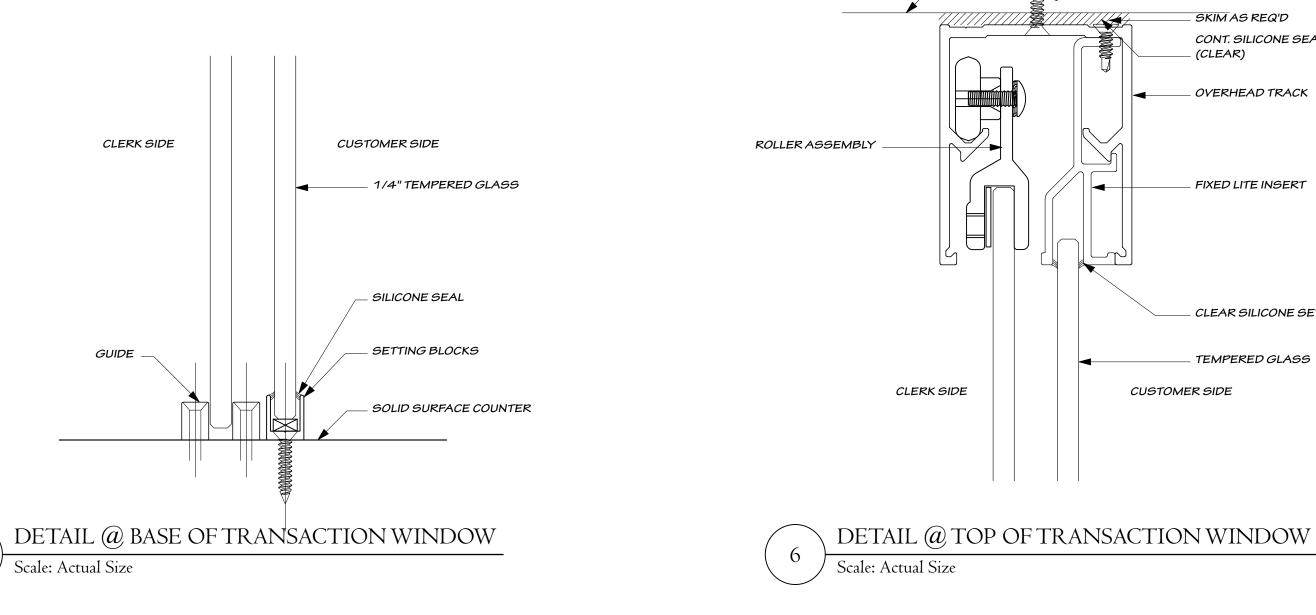

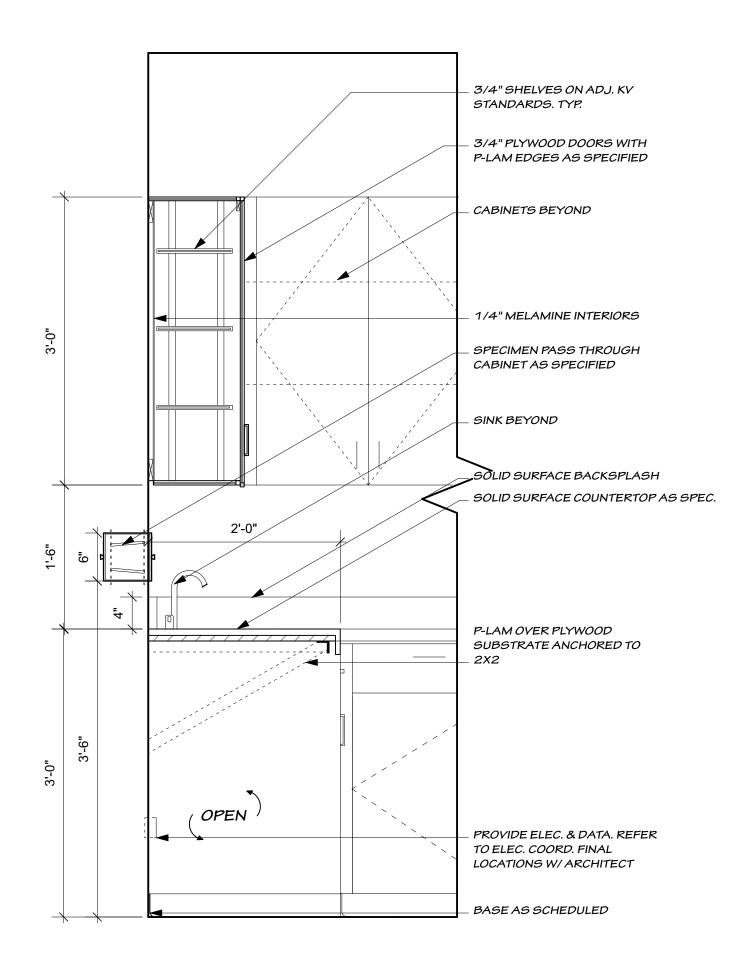

SECTION @ LAB WORK STATION FACING SOUTH Scale: I'' = I'-0''

FACE OF GYP. BD. PAINTED

FASTENER BY INSTALLER SKIM AS REQ'D


CONT. SILICONE SEALANT (CLEAR)

_ OVERHEAD TRACK

- FIXED LITE INSERT

_ CLEAR SILICONE SET

TEMPERED GLASS

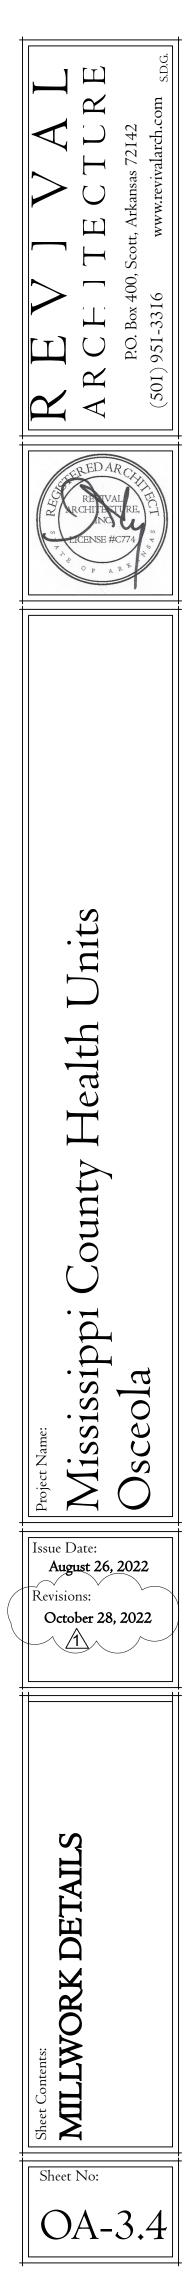


FINISH SCHEDULE

ROOM NUMBER	DESCRIPTION	CEILING	FLOOR	BASE	WALLS		NOTES
101	WAITING ROOM	REFER TO CEILING PLAN	LVT	4" RUBBER	PAINT		NEW ENTRY DOOR. CLEAN INSIDE & OUTSIDE OF STOREFRONTS. 6
102	CONFERENCE ROOM	REFER TO CEILING PLAN		4" RUBBER	PAINT		6. REFER TO FLOOR PLAN. CLEAN WINDOWS
103	BREAK ROOM	REFER TO CEILING PLAN	LVT	4" RUBBER	PAINT		6. NEW REFRIG.OFCI. REFER TO ALLOWANCES. CLEAN WINDOWS
104	CLOSET	REFER TO CEILING PLAN	LVT	4" RUBBER	FRP		
105	STAFF TOILET	REFER TO CEILING PLAN	LVT	4" RUBBER	PAINT		REFER TO INT. ELEVATION
106	CORRIDOR	REFER TO CEILING PLAN	LVT	4" RUBBER	PAINT		
107	STAFF OFFICE	REFER TO CEILING PLAN	LVT	4" RUBBER	PAINT		6. REFER TO FLOOR PLAN. CLEAN WINDOWS
108	OFFICE	REFER TO CEILING PLAN	LVT>	4" RUBBER	PAINT	$\langle $	6. REFER TO FLOOR PLAN. CLEAN WINDOWS
109	ADMIN.	REFER TO CEILING PLAN	LVT	4" RUBBER	PAINT		6. REFER TO FLOOR PLAN. CLEAN WINDOWS
110	OFFICE	REFER TO CEILING PLAN	LVT	4" RUBBER	PAINT		6. REFER TO FLOOR PLAN. CLEAN WINDOWS
111	OFFICE/EXAM	REFER TO CEILING PLAN	LVT	4" RUBBER	PAINT		REFER TO INT. ELEVATION
112	OFFICE/EXAM	REFER TO CEILING PLAN	LVT	4" RUBBER	PAINT		
113	OFFICE	REFER TO CEILING PLAN	LVT	4" RUBBER	PAINT		NEW SLIDING GLASS WINDOW. OFCI. REFER TO SPEC & DETAIL
114	CLERICAL	REFER TO CEILING PLAN	LVT	4" RUBBER	PAINT		
115	OFFICE/EXAM	REFER TO CEILING PLAN		4" RUBBER	PAINT		REFER TO INT. ELEVATION
116	CORRIDOR	REFER TO CEILING PLAN	LV∕T	4" RUBBER	PAINT		
117	OFFICE/EXAM	REFER TO CEILING PLAN	ЦVТ	4" RUBBER	PAINT	/	REFER TO INT. ELEVATION
121	PHARMACY	REFER TO CEILING PLAN	LVT	4" RUBBER	PAINT		REFER TO FLOOR PLAN. CLEAN WINDOWS
122	PHONE/DATA	REFER TO CEILING PLAN	LŴŢ	4" RUBBER	PAINT	$\langle $	
123	EXAM	REFER TO CEILING PLAN		4" RUBBER	PAINT		REFER TO INT. ELEVATION
124	EXAM	REFER TO CEILING PLAN	LVT	4" RUBBER	PAINT		REFER TO INT. ELEVATION
125	CLOSET	REFER TO CEILING PLAN	L∕VT	4" RUBBER	PAINT		
126	CORRIDOR	REFER TO CEILING PLAN	ЦVТ	4" RUBBER	PAINT		
127	MECHANICAL	REFER TO CEILING PLAN	LVT	4" RUBBER	PAINT		REPLACE CEILING W/ NEW GYP. B.D. CEILING. PREP & PAINT.
128	OFFICE	REFER TO CEILING PLAN	LŴŢ	4" RUBBER	PAINT		6. REFER TO FLOOR PLAN. CLEAN WINDOWS
129	CLOSET	REFER TO CEILING PLAN		4" RUBBER	PAINT		
130	CENTRAL SUPPLY	REFER TO CEILING PLAN	LVT	4" RUBBER	PAINT		REFER TO FLOOR PLAN
131	WAITING ROOM	REFER TO CEILING PLAN	LÝT	4" RUBBER	PAINT		REFER TO FLOOR PLAN
132	HC TLT.	REFER TO CEILING PLAN	LVT	4" RUBBER	PAINT		REFER TO INT. ELEVATION
133	LAB	REFER TO CEILING PLAN	LXT	4" RUBBER	PAINT		REFER TO INT. ELEVATION . NEW CASED OPENING.
134	TOILET	REFER TO CEILING PLAN	LVT	4" RUBBER	PAINT	_)	REFER TO INT. ELEVATION
135	OFFICE	REFER TO CEILING PLAN	LVT	4" RUBBER	PAINT	\langle	6. REFER TO INT. ELEVATION. CLEAN WINDOWS
136	WOMEN TOILET	REFER TO CEILING PLAN	LVT	4" RUBBER	PAINT		REFER TO INT. ELEVATION
137	MENS TOILET	REFER TO CEILING PLAN	LVT	4" RUBBER	PAINT		REFER TO INT. ELEVATION
138	RECEPTION	REFER TO CEILING PLAN	LVŤ	4" RUBBER	PAINT		REFER TO INT. ELEVATION

DOOR SCHEDULE

DOOR NUMBER	LOCATION	DOOR	DOOR ELEVATION	SIZE (WIDTH X HEIGHT)	CONSTRUCTION	FIRE RATING	FRAME	FRAME TYPE	HARDWARE	NOTES
101/1	WAITING 101	Ν	Α	3'-0" X 7'-0"	AL		Е	AL	1	1
101/2	WAITING 101	N	A	3'-0" X 7'-0"	AL		Е	AL	1	1
102/1	CONFERENCE 102	E					Е			2
102/2	CONFERENCE 102	E					E			2
103/1	BREAK 103	E					E			2
104/1	CLOSET 104	E					E			2
105/1	STAFF TOILET 105	E					E			2
106/1	CORRIDOR 106	Е					Е			2;4
106/2	CORRIDOR 106	E					E			2
107/1	STAFF OFFICE 107	E					E			2
108/1	OFFICE 108	E					Е			2
109/1	ADMINISTRATION 109	E					E			2
110/1	OFFICE 110	E					E			2
110A/1	STORAGE 110A	Ν	С	3'-0" X 7'-0"	SCW		Ν	HM	3	5
110B/1	CLOSET 110B	E					E			2
110C/1	CLOSET 110C	E					E			2
110D/1	CLOSET 110D	E					E			2
111/1	OFFICE/EXAM 111	E					Е			2
112/1	OFFICE/EXAM 112	E					E			2
113/1	OFFICE 113	E					Е			2
113A/1	CLOSET 113A	E					E			2
114/1	CLERICAL 114	E					Е			2
115/1	OFFICE/EXAM 115	E					Е			2
116/1	CORRIDOR 116	E					Е			2
117/1	OFFICE/EXAM 117	E					E			2
121/1	PHARMACY 121	E					Е		3	3
122/1	PHONE/DATA 122	E					E			2
123/1	EXAM 123	E					E			2
125/1	EXAM 125	E					E			2
126/1	CORRIDOR 126	E					E			2
126/2	CORRIDOR 126	E					E			2;4
126/3	CLOSET 126	E					E			2
127/1	MECHANICAL 127	E					Е			2
128/1	OFFICE 128	E					Е			2
129/1	CLOSET 129	E					Е			2
130/1	CENTRAL SUPPLY 130	E					Е			2
131/1	WAITING 131	E					Е			2
132/1	H.C. TOILET 132	E					Е			
134/1	LAB 134	NONE		4'-0" X 7'-0"			NONE		N/A	
135/1	TLT. 135	Е					Е			
136/1	OFFICE 136	E					Е			2
137/1	WOMENS TOILET 137	E					Е			2
138/1	MENS TOILET 138	E					Е			2
139/1	RECEPTION 139	E					E			2

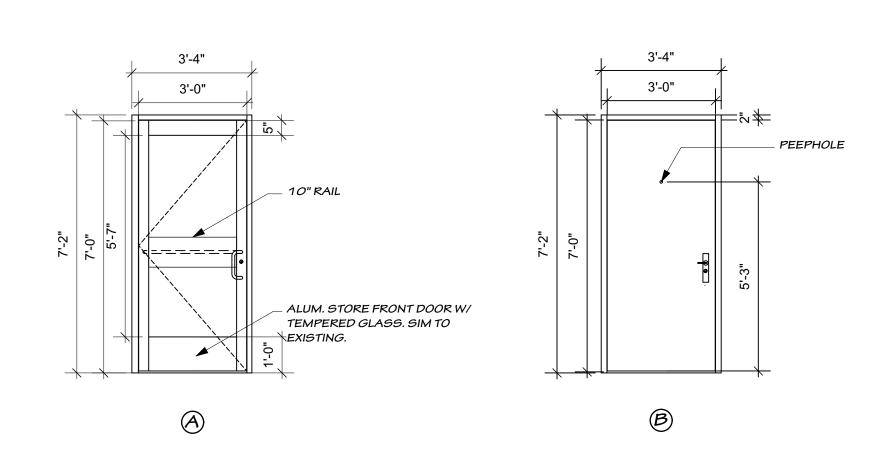

GENERAL NOTES


- COORDINATE DOOR & HARDWARE W/ EXISTING FRAME. MAKE NECESSARY REPAIRS OR ADJUSTMENTS TO FRAME AS MAY BE REQ'D TO ACCOM. NEW DOOR. PROVIDE NEW WEATHER STRIPPING.
- 2. EXISTING DOOR TO REMAIN. CLEAN THOROUGHLY. ADJUST OR TIGHTEN EXISTING HARDWARE FOR BEST FUNCTION.
- 3. PROVIDE NEW HARDWARE. DRILL/PATCH EXISTING DOOR AS REQ'D. 4. REPLACE HARDWARE W/ NEW SIM. TO EXISTING. PROVIDE NEW WEATHERSTRIPPING. ADD
- PEEPHOLE.
- ELSEWHERE.
- 6. APPLY ROLLER SHADES TO ALL WINDOWS. WITH THE EXCEPTION OF GLASS BLOCK WINDOWS.

HARDWARE NOTES

- 1. HARDWARE 1 ENTRY DOORS W/ HANDLE AND LOCK. PUSH BAR ON INTERIOR SIDE. SIM. TO EXISTING
- 2. HARDWARE 2 EXT. METAL HANDLE W/ LOCK
- 3. HARDWARE 3 PROVIDE NEW LOCKSET
- 4. HARDWARE 4 METAL HANDLE FOR INT. DOOR WITH BATHROOM PRIVACY LOCK
- 5. HARDWARE 5 STANDARD METAL HANDLE FOR INT. DOOR


ABBREVIATIONS


AL - ALUMINUM	
HM - HOLLOW METAL	
SCW - SOLID CORE WOOD	
E - EXISTING	
N - NEW	
T - TEMPERED	
EQ - EQUAL	
SIM - SIMILAR	

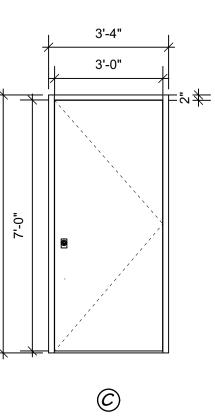

5. FOR NEW DOOR & FRAME; PROVIDE NEW LOCKSET & BUTT HINGES TO MATCH THOSE EXISTING

JШ \mathbf{X} Ш \dashv T \cup \mathbf{R} \triangleleft $\mathbf{\mathbf{\mathcal{A}}}$ nits \square Health lty Ino \bigcirc Mississippi Osceola Issue Date: August 26, 2022 **Revisions:** October 28, 2022 $\overline{}$ Sheet Contents: SCHEDULES Sheet No: OA-4.I

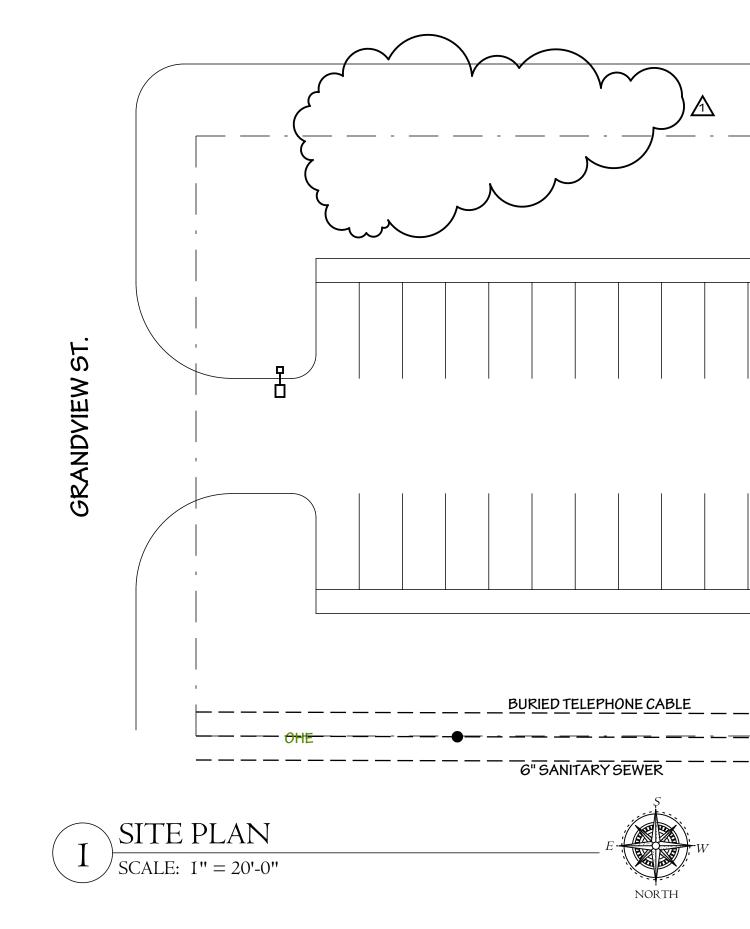

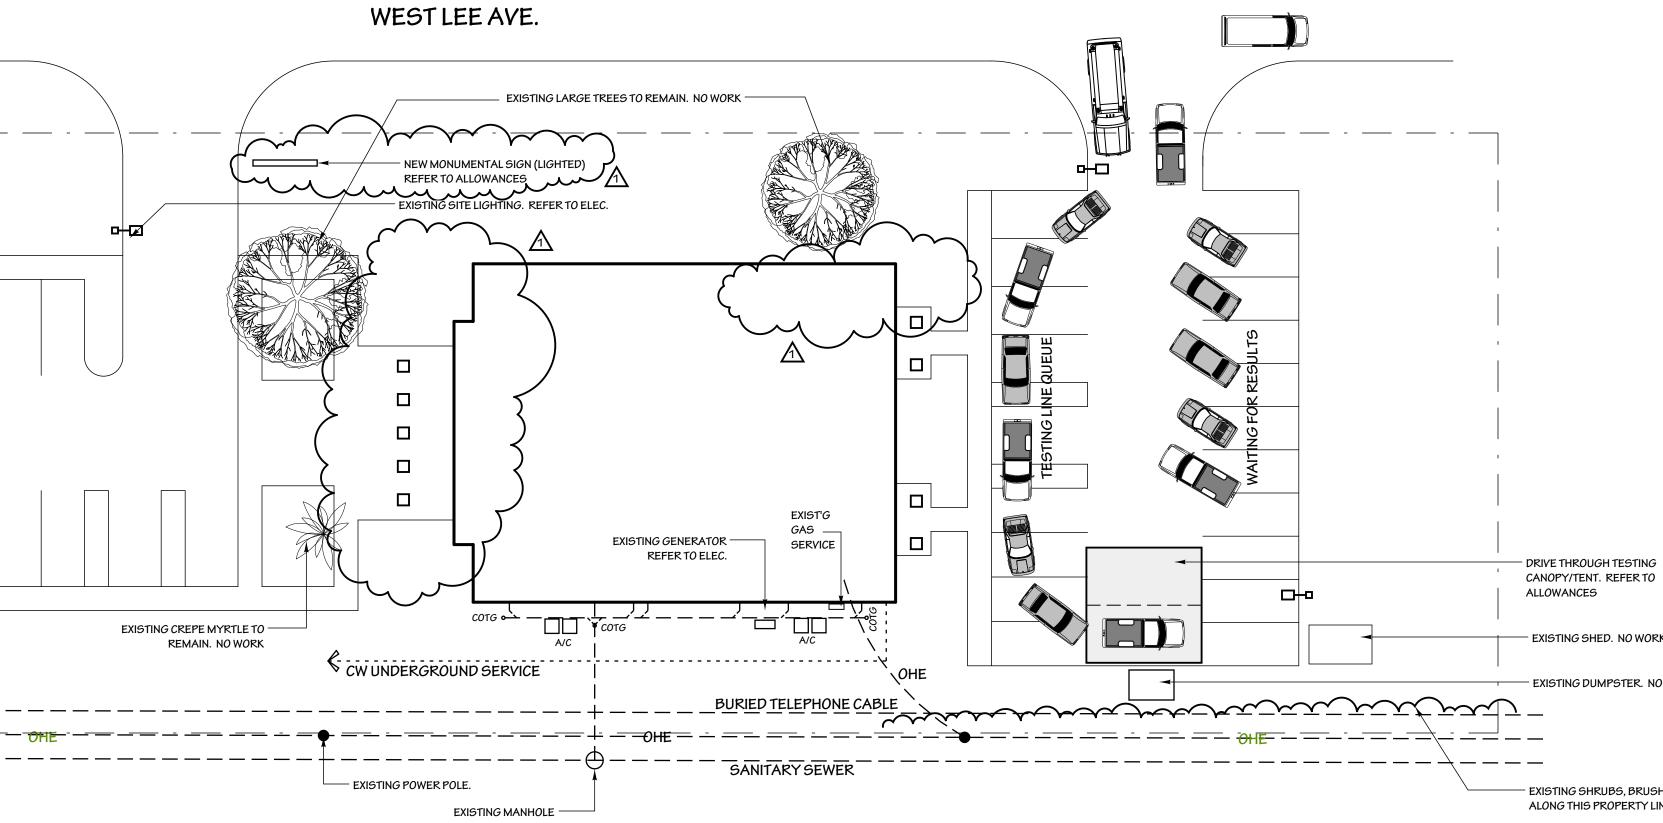

3.)

- EXISTING SHRUBS, BRUSH AGAINST FENCE ALONG THIS PROPERTY LINE. NO WORK.


- EXISTING SHED. NO WORK

- EXISTING DUMPSTER. NO WORK.

GENERAL NOTES:

1.) THIS SITE PLAN SHALL NOT BE CONSIDERED A LEGAL SURVEY. IT HAS BEEN DRAWN BASED ON PRE-EXISTING INFORMATION FROM THE ORIGINAL ARCHITECTURAL DRAWINGS & CONFIRMED, ROUGHLY, BY STUDY OF RECENT PHOTOGRAPHS. THE CONTRACTOR SHALL VERIFY ALL INFORMATION PERTITENT TO THE WORK, INCLUDING LOCATING PRESENCE OF UTILTIES AND THEIR ACTUAL LOCATION AND SIZE.

2.) CONTRACTOR IS RESPONSIBLE FOR CONTACTING UTILITIES SHOULD WORK REQUIRE NEW SERVICE LINES OR ALTERATIONS.

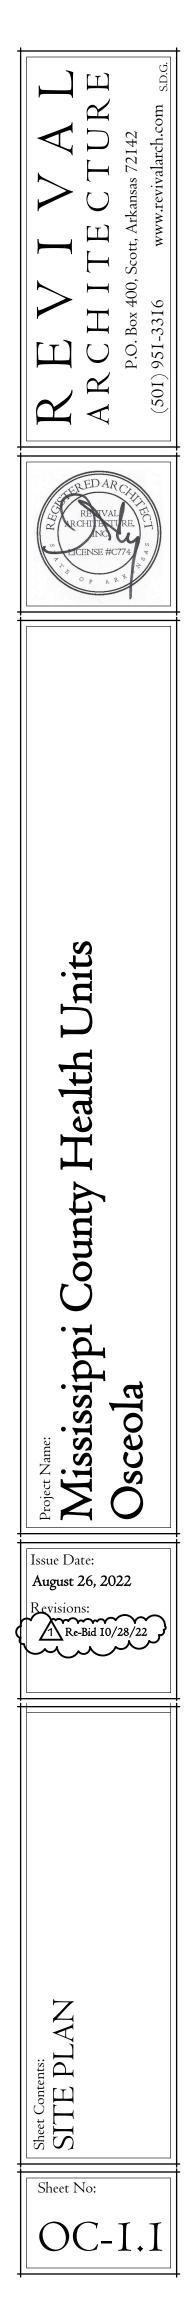

ALTERNATES

THE CONTRACTOR SHALL PRICE THE FOLLOWING ITEMS AS DEDUCTIVE ALTERNATE TO THE DRAWINGS.

- 1. EXISTING HVAC UNITS TO REMAIN.
- 2. AN ALTERNATE LIGHTING PACKAGE AS APPROVED BY THE ARCHITECT.
- 3. ALUMINUM WIRES FOR WIRE SIZE 1/0 AND LARGER. DRAWINGS ARE SIZED FOR COPPER, CONTRACTOR TO SIZE ALUMINUM PER NEC.
- 4. MC CABLE IN LIEU OF EMT THROUGHOUT THE INTERIOR OF THE BUILDING.

- 1. SHALL BE PROVIDED AT NO ADDITIONAL COST.
- WORK.

3.

- INFORMATION.
- SERVICE TO THE OWNER.
- BROUGHT TO THE ATTENTION OF THE ENGINEER.
- GOVERN.
- PROCEEDING.
- 8.
- INSTALLATION OF TEMPORARY OR NEW SERVICES.
- MANUALS AND RECORD DRAWINGS.
- ELECTRICAL WORK AND APPRENTICE ELECTRICIANS SHALL BE SUPERVISED BY A MASTER JOURNEYMAN ELECTRICIAN ON A ONE TO ONE RATIO.
- 14. PREPARE AND SUBMIT SUBMITTALS TO ARCHITECT.
- FUNCTIONING.
- ALL MOTORS PROVIDED UNDER THIS CONTRACT.

GENERAL NOTES

CONTRACTOR IS RESPONSIBLE FOR COORDINATING ALL INSTALLATION WITH THE WORK OF OTHER TRADES. FIELD MODIFICATIONS NEEDED DUE TO OBSTRUCTIONS OR INTERFERENCES

2. ALL WORK SHALL BE PERFORMED IN A NEAT AND WORKMANLIKE MANNER WITHIN STANDARD OF CARE FOR PROFESSION. ALL LABOR, MATERIAL, TOOLS, PERMITS, INSPECTIONS, TESTING, CERTIFICATION, ETC. REQUIRED FOR A COMPLETE AND SATISFACTORY INSTALLATION TO DESIGN INTENT SHALL BE FURNISHED BY CONTRACTOR. PROVIDE, AT NO ADDITIONAL COST, INCLUDING INCIDENTAL ITEMS NOT SHOWN WHEN REQUIRED FOR TYPICAL COMPLETION OF

DRAWINGS NOT BEARING THE STAMP OR SEAL AND SIGNATURE OF A REGISTERED PROFESSIONAL ENGINEER SHALL NOT BE USED FOR BIDDING OR CONSTRUCTION PURPOSES UNLESS EXPRESSLY APPROVED IN WRITING BY THE ARCHITECT. THE CONTRACTOR SHALL BE RESPONSIBLE FOR ENSURING THAT ALL DRAWINGS AND SPECIFICATIONS BEING USED FOR BIDDING AND CONSTRUCTION PURPOSES ARE OF THE LATEST REVISION AVAILABLE AND ALL ADDENDUM DOCUMENTS HAVE BEEN INCORPORATED EITHER BY REVISION RELEASE OF DRAWINGS/SPECIFICATIONS OR ATTACHMENT OF SKETCHES OR OTHER ADDENDUM

4. THE CONTRACTOR SHALL FURNISH AND INSTALL NEW PRODUCTS OF ESTABLISHED AND REPUTABLE MANUFACTURERS. NO EQUIPMENT SUBSTITUTIONS SHALL BE MADE THAT WOULD LEAVE INADEQUATE OPERATING OR SERVICE SPACE. EQUIPMENT SHALL BE INSTALLED IN ACCORDANCE WITH MANUFACTURER'S RECOMMENDED INSTALLATION PROCEDURES AND IN AN ARRANGEMENT THAT WILL GIVE THE GREATEST PRACTICAL EASE OF OPERATION AND

5. ALL EQUIPMENT WHICH IS INDICATED TO BE FURNISHED AND/OR INSTALLED BY OTHERS OR BY OWNER IS INCLUDED FOR REFERENCE ONLY UNLESS NOTED OTHERWISE. CONTRACTOR SHALL BE RESPONSIBLE FOR COORDINATING AND VERIFYING INSTALLATION REQUIREMENTS OF THIS EQUIPMENT WITH THE APPLICABLE SUPPLIER OR THE OWNER. ANY DISCREPANCIES SHALL BE

6. ALL WORK SHALL BE INSTALLED IN ACCORDANCE WITH THE REQUIREMENTS OF ALL APPLICABLE CODES AND REGULATIONS INCLUDING BUT NOT LIMITED TO NATIONAL, CITY, STATE, LOCAL ORDINANCES, AND UTILITY COMPANY REGULATIONS. ALL PLUMBING MATERIALS, INSTALLATION PROCEDURES, AND SYSTEM LAYOUTS SHALL BE APPROVED BY ALL APPLICABLE AUTHORITIES HAVING JURISDICTION. THE CONTRACTOR SHALL PROVIDE ALL MATERIALS AND LABOR NECESSARY TO COMPLY WITH THESE RULES, REGULATIONS, AND ORDINANCES. THESE CODES REPRESENT THE MINIMUM ACCEPTABLE REQUIREMENTS, THEREFORE, WHERE DRAWINGS AND/OR SPECIFICATIONS INDICATE MATERIALS OR CONSTRUCTION MORE STRINGENT THAT CODE REQUIREMENTS, THE DRAWINGS AND/OR SPECIFICATIONS SHALL

7. IF COMPLIANCE WITH STANDARDS, CODES, REGULATIONS AND CONTRACT DOCUMENTS ESTABLISH DIFFERENT OR CONFLICTING REQUIREMENTS FOR MINIMUM QUANTITIES OR QUALITY LEVELS, REFER CONFLICTING REQUIREMENTS TO ENGINEER FOR A DECISION BEFORE

WHERE CONTRACT DOCUMENTS NAME A SINGLE MANUFACTURER AND PRODUCT, PROVIDE THE NAMED PRODUCT THAT COMPLIES WITH REQUIREMENTS. COMPARABLE PRODUCTS OR SUBSTITUTIONS FOR CONTRACTOR'S CONVENIENCE WILL NOT BE CONSIDERED.

9. THE CONTRACTOR SHALL BE RESPONSIBLE FOR ALL COSTS INCURRED BY ANY SERVING UTILITY, MUNICIPAL AUTHORITY, AND/OR OWNER FOR THE RELOCATION, REMOVAL, AND

10. THE CONTRACTOR SHALL BE RESPONSIBLE FOR COORDINATING AND PROVIDING THE EXACT SERVICE EQUIPMENT AND INSTALLATION METHODS WITH THE SERVING UTILITY, MUNICIPAL AUTHORITY, AND/OR OWNER PRIOR TO BIDDING. FAILURE TO DO SO WILL NOT CONSTITUTE SUFFICIENT GROUNDS FOR AN AUTHORIZED CHANGE ORDER TO THE PROJECT.

11. CLOSEOUT SUBMITTALS SHALL INCLUDE, BUT NOT LIMITED TO, OPERATION AND MAINTENANCE

12. THE CONTRACTOR SHALL VISIT THE SITE OF THE BUILDING BEFORE SUBMITTING A PROPOSAL ON THIS WORK AND SHALL THOROUGHLY FAMILIARIZE HIMSELF WITH THE EXISTING CONDITIONS AND OPERATIONS. FAILURE ON HIS PART TO DO THIS WILL NOT BE CAUSE OF EXTRAS AFTER THE CONTRACT IS SIGNED, BY REASON OF UNFORESEEN CONDITIONS. 13. NO PERSON SHALL PERFORM ELECTRICAL WORK ON THE CONTRACT WITHOUT POSSESSING A MASTER'S OR JOURNEYMAN'S LICENSE FROM THE STATE ELECTRICAL EXAMINERS BOARD. ALL

15. ALL AREAS USED AS RETURN AIR PLENUMS SHALL BE CONSTRUCTED WITH FIRE RESISTANT MATERIALS AND SHALL ONLY CONTAIN MATERIALS WHICH HAVE SMOKE DEVELOPED RATINGS NOT GREATER THAN 50 AND FLAME SPREAD RATINGS NOT GREATER THAN 25.

16. ALL ELECTRICAL EQUIPMENT, SUCH AS SWITCHES, CIRCUIT BREAKERS, ETC. SHALL BE TESTED BY OPERATING THE DEVICE TO VERIFY THAT THE MECHANICAL PORTIONS OF THE DEVICE ARE

17. THE CONTRACTOR SHALL ASSIST ALL OTHER TRADES IN PERFORMING ROTATIONAL TESTS ON

	LEG	END	
ΞA	WALL MOUNT STRIP LIGHT.		
ЭН	WALL PACK LIGHT FIXTURE.		COMBINATION TELEPHONE/DATA: REQUIRES 4" SQUARE OUTLET BOX, APPROPRIATE PLASTER RING, AND 1" C. STUBBED TO AN ACCESSIBLE LOCATION ABOVE A
\mathbb{D}	RECESSED DOWN LIGHT.	\mathbf{V}	REMOVABLE CEILING TILE. NUMBER DENOTES THE NUMBER OF TELEPHONE PORTS/CABLES TO BE PROVIDED. MINIMUM OF TWO CABLES AT EACH LOCATION IS
\Box	2X4 LED TROFFER.		REQUIRED UNLESS OTHERWISE NOTED. MOUNT 18" AFF UNLESS OTHERWISE NOTED.
	2X4 LED TROFFER ON EMERGENCY POWER.	┏╹	FUSED/NON-FUSED DISCONNECT-FUSE ALL EQUIPMENT PER MANUFACTURER RECOMMENDATION FOR THE ACTUAL EQUIPMENT FURNISHED. MOUNT DISCONNECT FOR HVAC CONDENSER UNITS WITH TOP OF SWITCH AT 36" A.F.F.
]	2X2 LED TROFFER.		
EL	2X2 LED TROFFER ON EMERGENCY POWER.	J	JUNCTION BOX. VERIFY MOUNTING HEIGHT WITH MILLWORK DETAILS AND/OR THE OWNER'S REPRESENTATIVE. AT EQUIPMENT LOCATIONS VERIFY THE EXACT LOCATION
Н	4' LED STRIP	J	WITH THE EQUIPMENT INSTALLER PRIOR TO ROUGH-IN.
	WALL LIGHT	Œ	DUPLEX RECEPTACLE. MOUNT 18" AFF UNLESS OTHERWISE NOTED.
	RECESSING LIGHTING	(QUADRUPLEX RECEPTACLE. MOUNT 18" AFF UNLESS OTHERWISE NOTED.
	SINGLE POLE SWITCH. "D" DENOTES DIMMER, "3" 3-WAY, "4" - 4 WAY.		DUPLEX RECEPTACLE GROUND FAULT TYPE.
	COORDINATE WITH FIXTURE/LAMP TYPE AND CIRCUIT WATTAGE.	—	QUADRUPLEX RECEPTACLE GROUND FAULT TYPE.
5	WALL MOUNTED DUAL TECH. MOTION SENSOR SWITCH WIRE PER MANUFACTURERS RECOMMENDATION. PROVIDE CONTACTORS TO	e =	
	CONTROL EXHAUST FAN WITH LIGHTS WHERE REQUIRED.		QUADRUPLEX RECEPTACLE MOUNTED ABOVE COUNTER.
	MOTOR RATED SWITCH USED FOR EQUIPMENT DISCONNECTING MEANS. SINGLE PHASE: PROVIDE MANUAL MOTOR STARTER WITH THERMAL OVERLOAD RELAYS	⊖- ●-	DUPLEX RECEPTACLE MOUNTED ABOVE COUNTER. QUADRUPLEX RECEPTACLE MOUNTED ABOVE COUNTER.
	SIZED PER MOTOR LOAD.	<u> </u>	EMERGENCY RECEPTACLE.
لا	BRANCH CIRCUIT HOMERUN. PANEL AND CIRCUIT NUMBER INDICATED.	• •-	SPECIAL RECEPTACLE AS NOTED ON THE PLANS.
•	CEILING MOUNTED DUAL TECH. OCCUPANCY SENSOR EQUAL TO WATTSTOPPER 2000 SQ FT. PROVIDE AND INSTALL POWER PACKS AS REQUIRED. COORDINATE SWITCHING, LOCATION AND QUANTITY WITH ACTUAL OCCUPANCY SENSOR USED. WIRE PER MANUFACTURERS RECOMMENDATION.		ELECTRICAL PANEL.
)s)	WALL MOUNTED DUAL TECH. OCCUPANCY SENSOR. EQUAL TO WATTSTOPPER 2000 SQ FT. PROVIDE AND INSTALL POWER PACKS AS REQUIRED. COORDINATE SWITCHING, LOCATION AND QUANTITY WITH ACTUAL OCCUPANCY SENSOR USED. WIRE PER MANUFACTURERS RECOMMENDATION.	тв	TELEPHONE TERMINAL BOARD
A	EXIT SIGN/COMBINATION EXIT/EMERGENCY LIGHT		SUBSCRIPTS:
A	EXIT SIGN/COMBINATION EXIT/EMERGENCY LIGHT (WITH DIRECTIONAL ARROWS).		GFI = GROUND FAULT CIRCUIT INTERRUPTER.
A A	EXIT SIGN/COMBINATION EXIT/EMERGENCY LIGHT (WITH DIRECTIONAL ARROWS). EXIT SIGN/COMBINATION EXIT/EMERGENCY LIGHT (WITH STROBES).		GFI = GROUND FAULT CIRCUIT INTERRUPTER. WP = WEATHER RESISTANT RECEPTACLES ARE "GFI", WITH METAL WEATHER RESISTANT "WHILE-IN-USE" COVERS. EC = ELECTRICAL CONTRACTOR
A	WALL MOUNTED EXIT SIGN/COMBINATION EXIT/EMERGENCY LIGHT.		AFF = ABOVE FINISHED FLOOR AFG = ABOVE FINISHED GRADE NTS = NOT TO SCALE

 \mathbf{O}

ounty

. DI

Mississip

ISSUE DATE:

evisions:

ES

NOT

Sheet Contents: ELECTRICAL GENERAL AND LEGEND


Sheet No:


OE-1.0

August 26, 2022

sceola

 \bigcirc

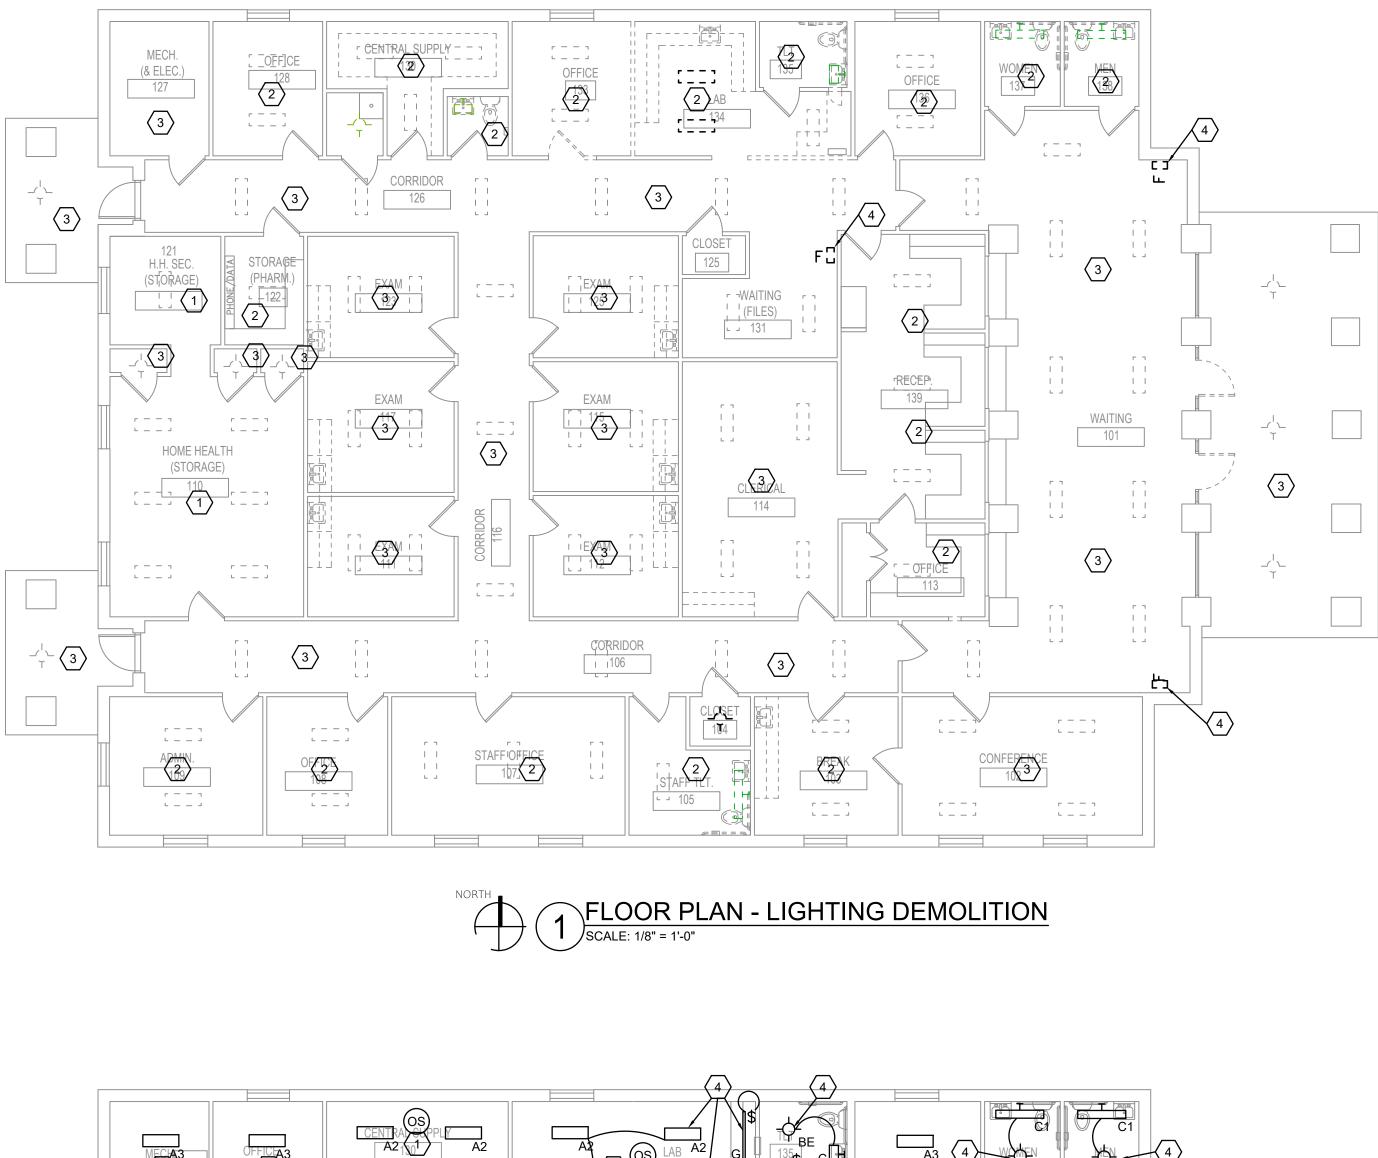

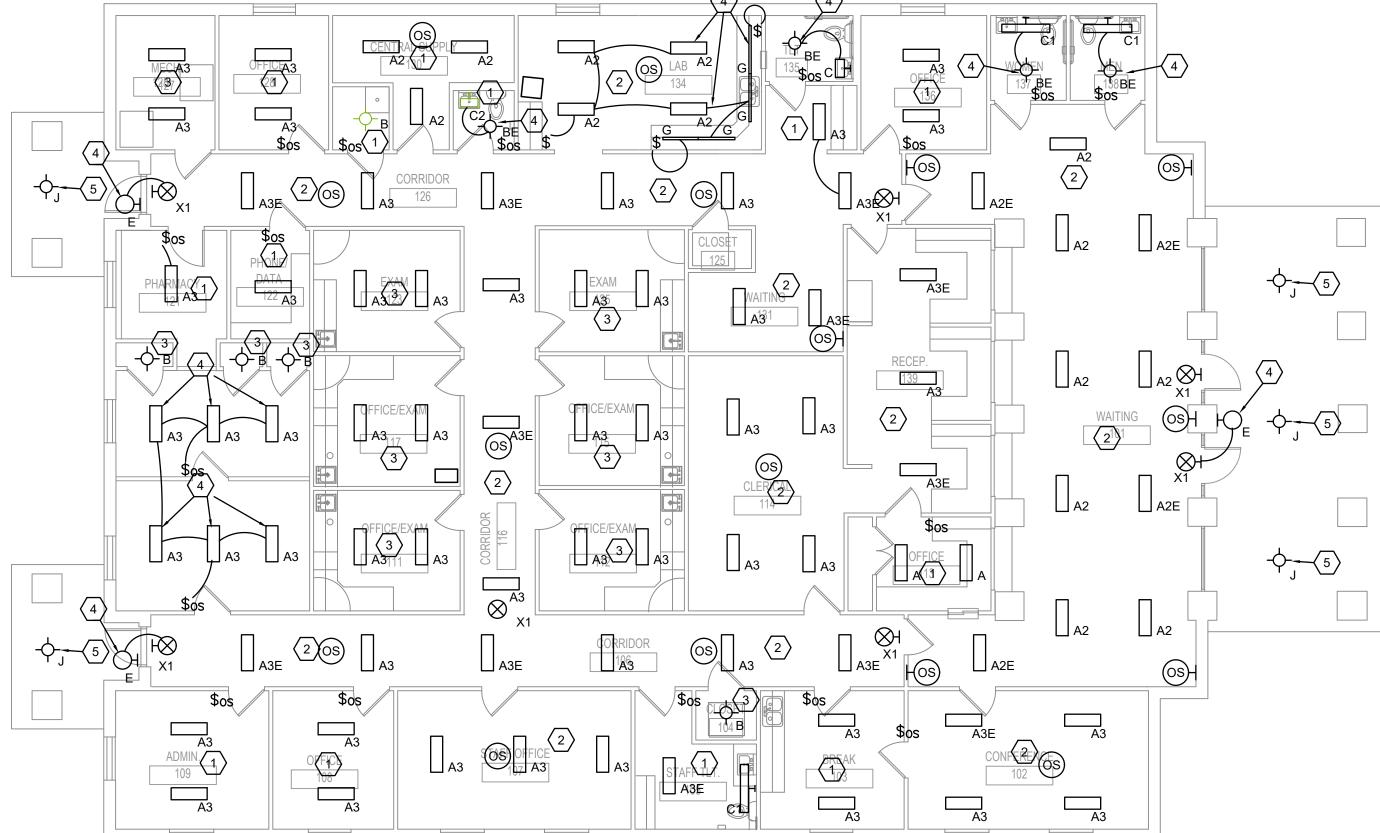

FLOOR PLAN - LIGHTING SCALE: 1/8" = 1'-0"

DEMOLITION KEYED NOTES:

1 REMOVE EXISTING LIGHT FIXTURE, BOX, WIRE, AND CONDUIT IN THIS ROOM BACK TO NEAREST J-BOX. REMOVE EXISTING SWITCH(ES) AND PROVIDE BLANK COVERPLATE AS REQUIRED.


2 REMOVE EXISTING LIGHT FIXTURE IN THIS ROOM. BOX, CONDUIT, AND WIRE TO REMAIN. REMOVE EXISTING SWITCH, SWITCH BOX AND CONDUIT TO REMAIN.

- 3 REMOVE EXISTING LIGHT FIXTURES IN THIS ROOM. BOX, CONDUIT, AND WIRE TO REMAIN. EXISTING SWITCH(ES) TO REMAIN.
- $\langle 4 \rangle$ REMOVE EXISTING UV LIGHT, WIRE, AND CONDUIT.

KEYED NOTES:

$\langle 1 \rangle$	INSTALL NEW LIGHT FIXTURE IN EXISTING JBOX. RECONNECT TO EXISTING CIRCUIT AND SWITCHING. EXTEND HOT TO NEW EMERGENCY FIXTURES AS REQUIRED. INSTALL NEW SWITCHED OCCUPANCY SENSOR IN EXISTING BOX.
2	INSTALL NEW LIGHT FIXTURE IN EXISTING JBOX. RECONNECT TO EXISTING CIRCUIT AND SWITCHING. EXTEND HOT TO NEW EMERGENCY FIXTURES AS REQUIRED. INSTALL NEW OCCUPANCY SENSOR(S) AND POWER PACK AS REQUIRED, CONNECT TO EXISTING CIRCUIT. WIRE EXISTING SWITCH TO OVERRIDE OCCUPANCY SENSOR(S).
$\langle 3 \rangle$	INSTALL NEW LIGHT FIXTURE IN EXISTING JBOX. RECONNECT TO EXISTING CIRCUIT AND SWITCHING. EXTEND HOT TO NEW EMERGENCY FIXTURES AS REQUIRED.
$\langle 4 \rangle$	INSTALL NEW LIGHT FIXTURE IN NEW JBOX. CONNECT TO CIRCUIT AS SHOWN. RECONNECT TO EXISTING CIRCUIT.
$\left< 5 \right>$	BLOCK AND PATCH EXISTING HOLE AS REQUIRED.

REVIVAL ARCHITECTURE P.O. Box 400, Scott, Arkansas 72142 (501) 951-3316 www.revivalarch.com S.D.
 ARKANSAS REGISTERED PROJESSIONAL ANG 5822 PRESTON PRESTON B/AG AA
ENGINEERING ENGINEERING INSIGHT ENGINEERING, PLLC No. 3523 ARXANSAS AR
PROJECT NAME: Mississippi County Health Units Osceola
 ISSUE DATE: August 26, 2022 Revisions:
 Sheet Contents: OSCEOLA PLAN - LIGHTING
Sheet No: OE-I.I

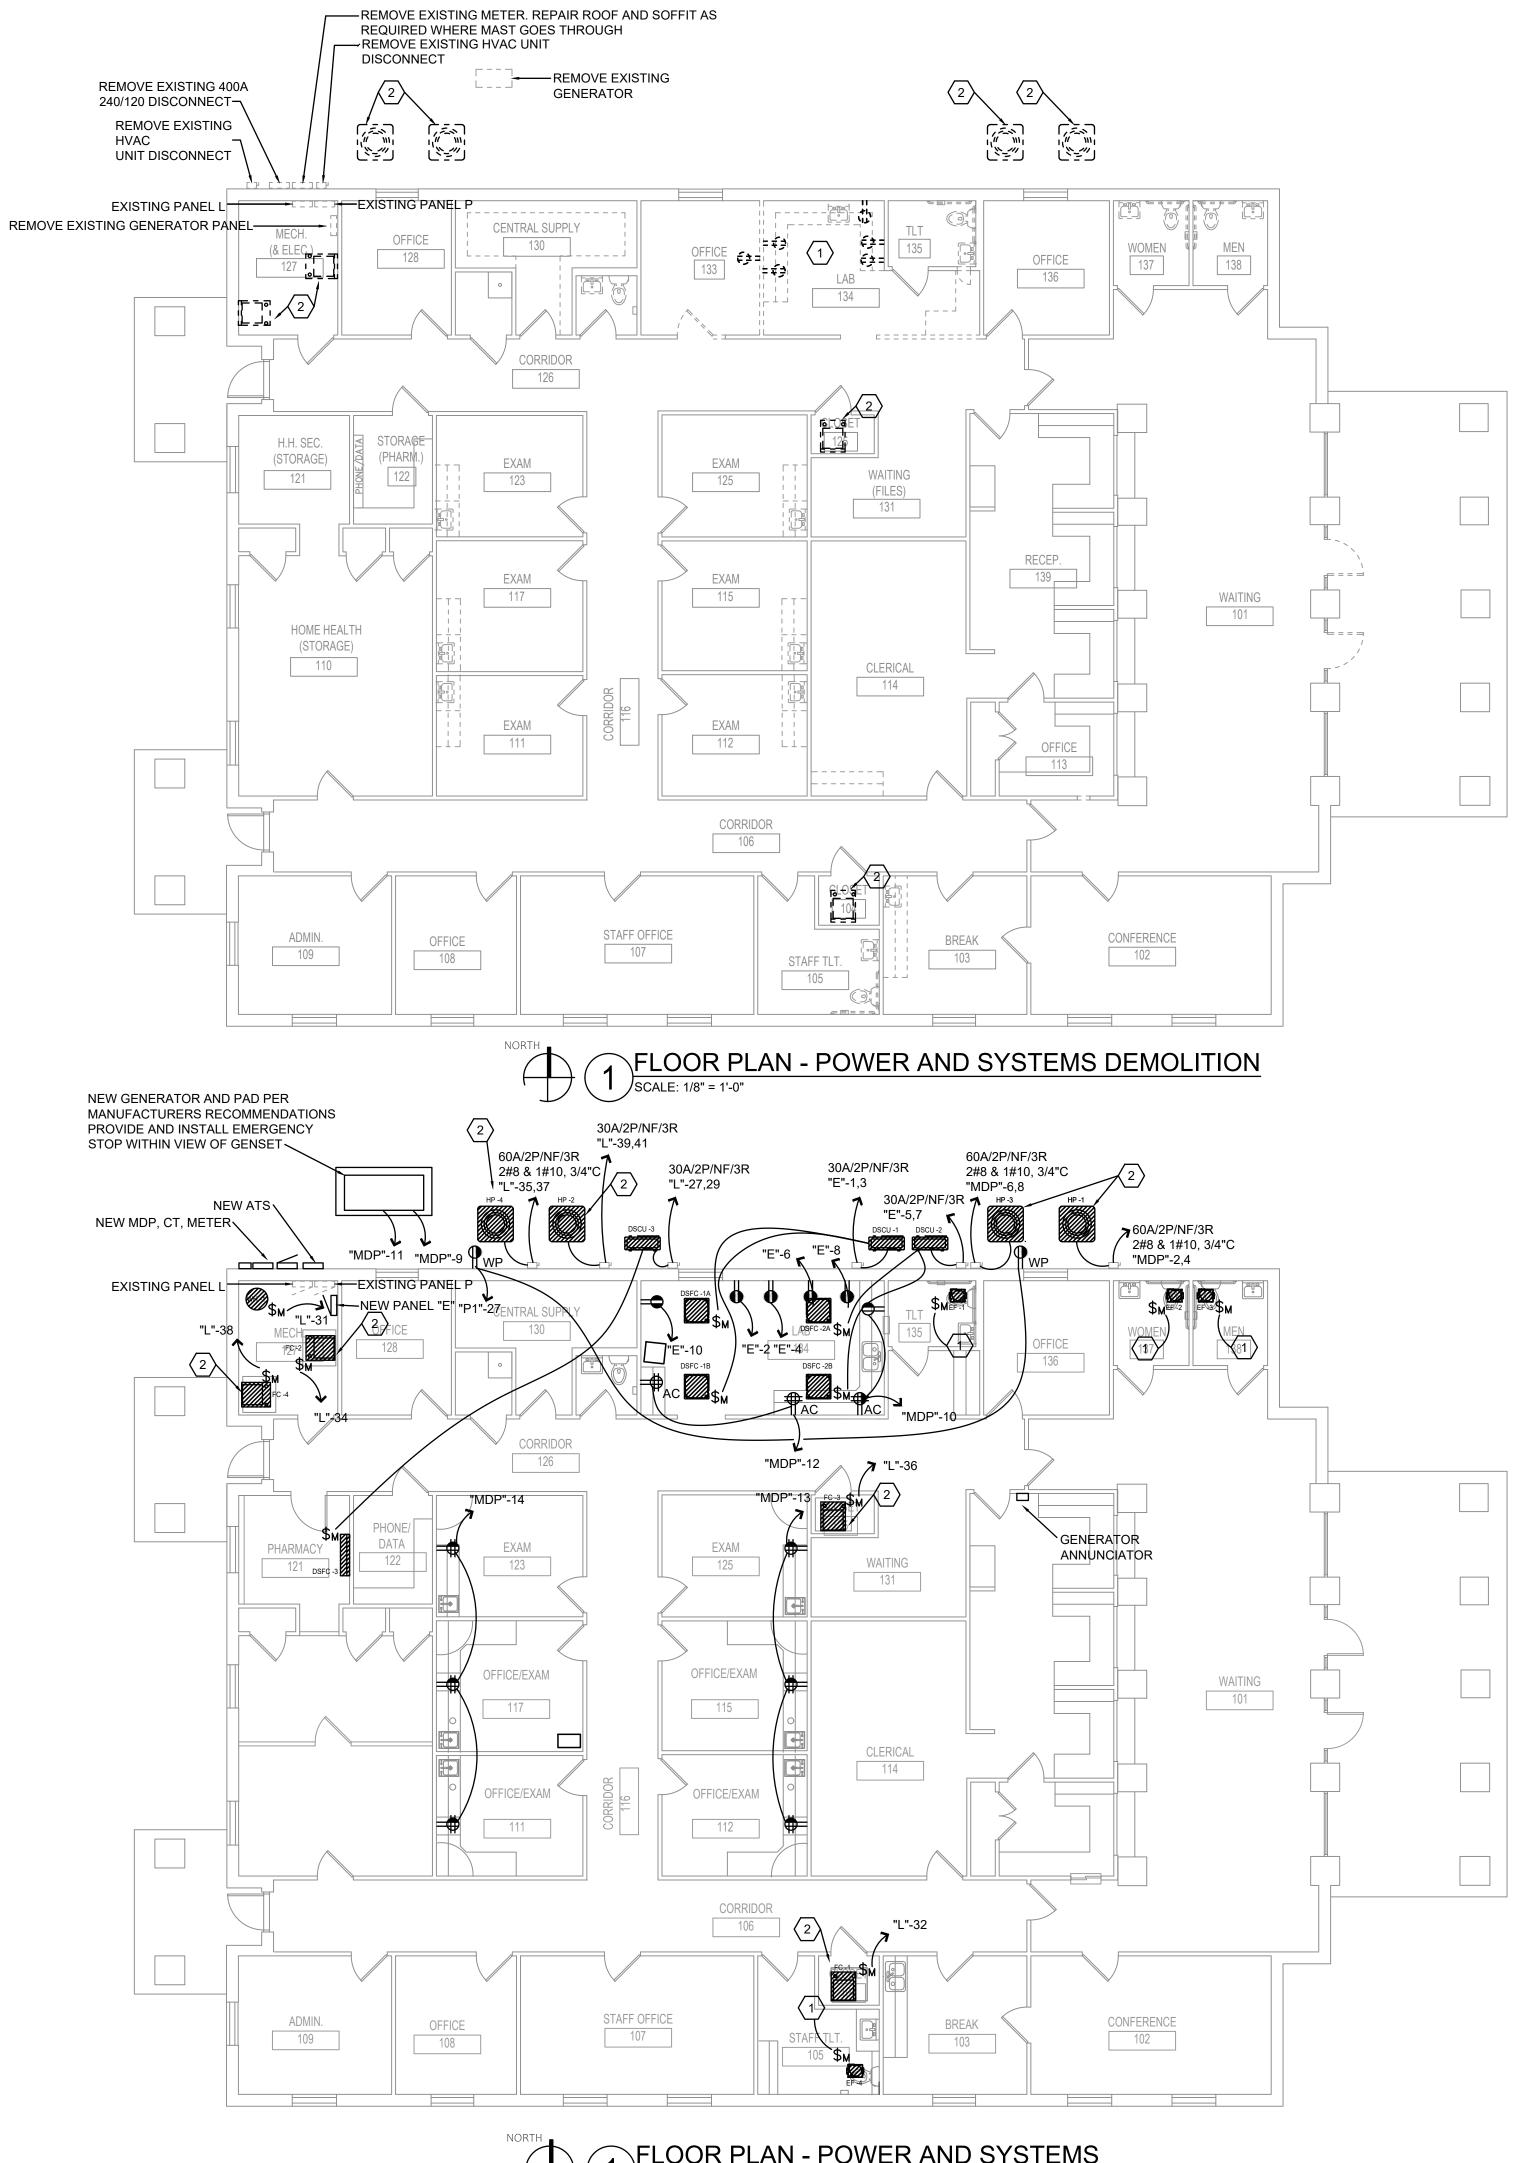

FLOOR PLAN - POWER AND SYSTEMS SCALE: 1/8" = 1'-0"



EXISTING RECEPTACLES IN WALLS TO BE DEMOLISHED TO BE REMOVED BACK TO NEAREST J-BOX. MAINTAIN CIRCUIT CONTINUITY.


2 REMOVE EXISTING HVAC DISCONNECT, CONDUIT, AND WIRE BACK TO PANEL.


KEYED NOTES:

 $\langle 1 \rangle$ TO ROOM LIGHTS AND SWITCH.

 $\left< \frac{2}{2} \right>$ REFER TO ALTERNATES SHEET OE-1.0.

-	REUNTECTURE ARCHITECTURE P.O. Box 400, Scott, Arkansas 72142 (501) 951-3316 www.revivalarch.com S.D.G.
1.1	ARKANSAS REGISTERED PROTOSSIONAL AGGALAN NO. 5822 PRESTON B/26 22
	ENGINEERING OOOC
	PROJECT NAME: Mississippi County Health Units Osceola
	ISSUE DATE: August 26, 2022 Revisions:
	Sheet Contents: SSCEOLA PLAN - POWER AND SYSTEMS No:
	OE-1.2

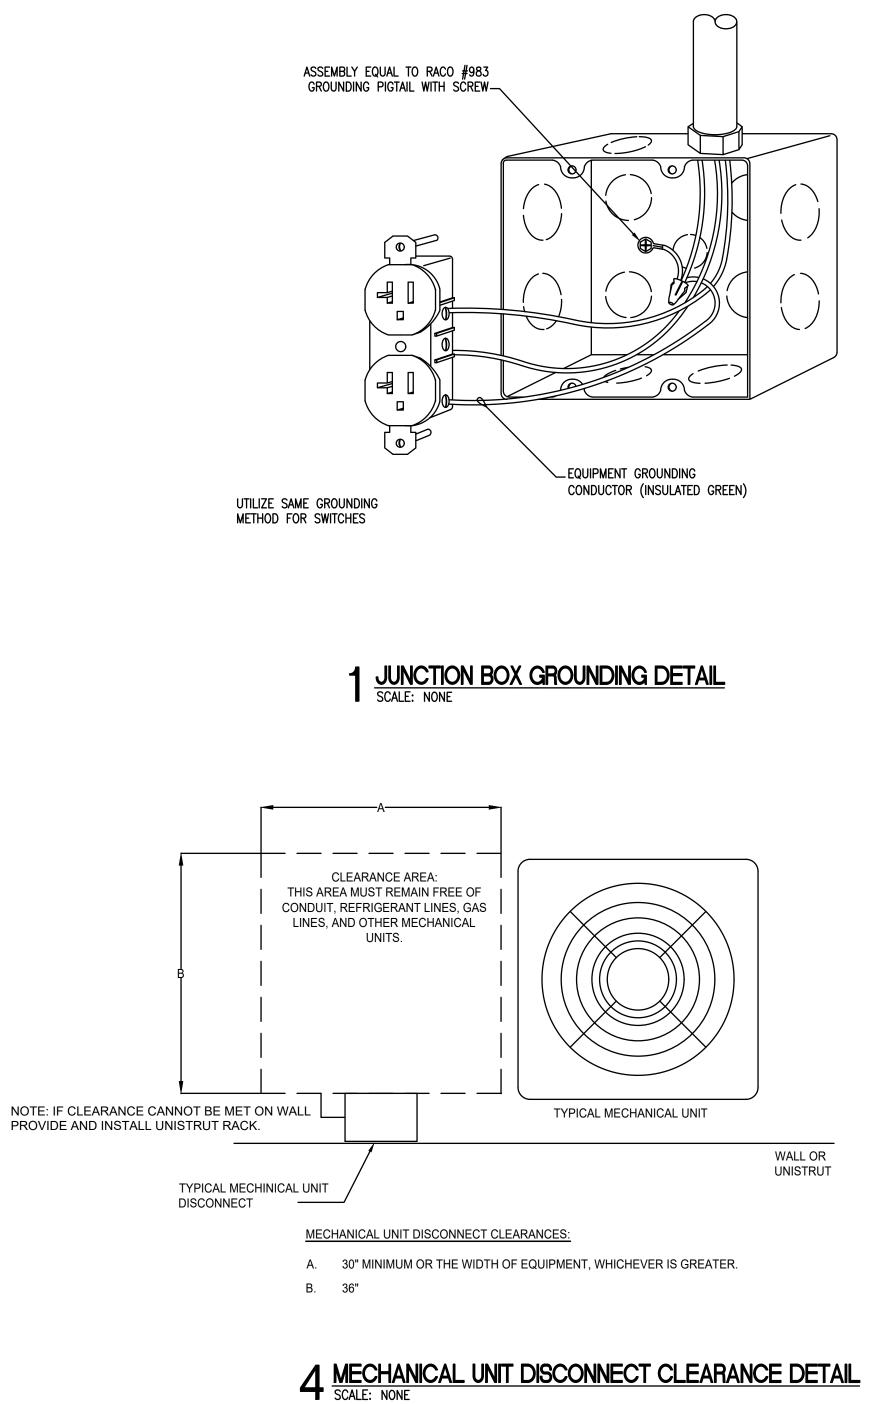

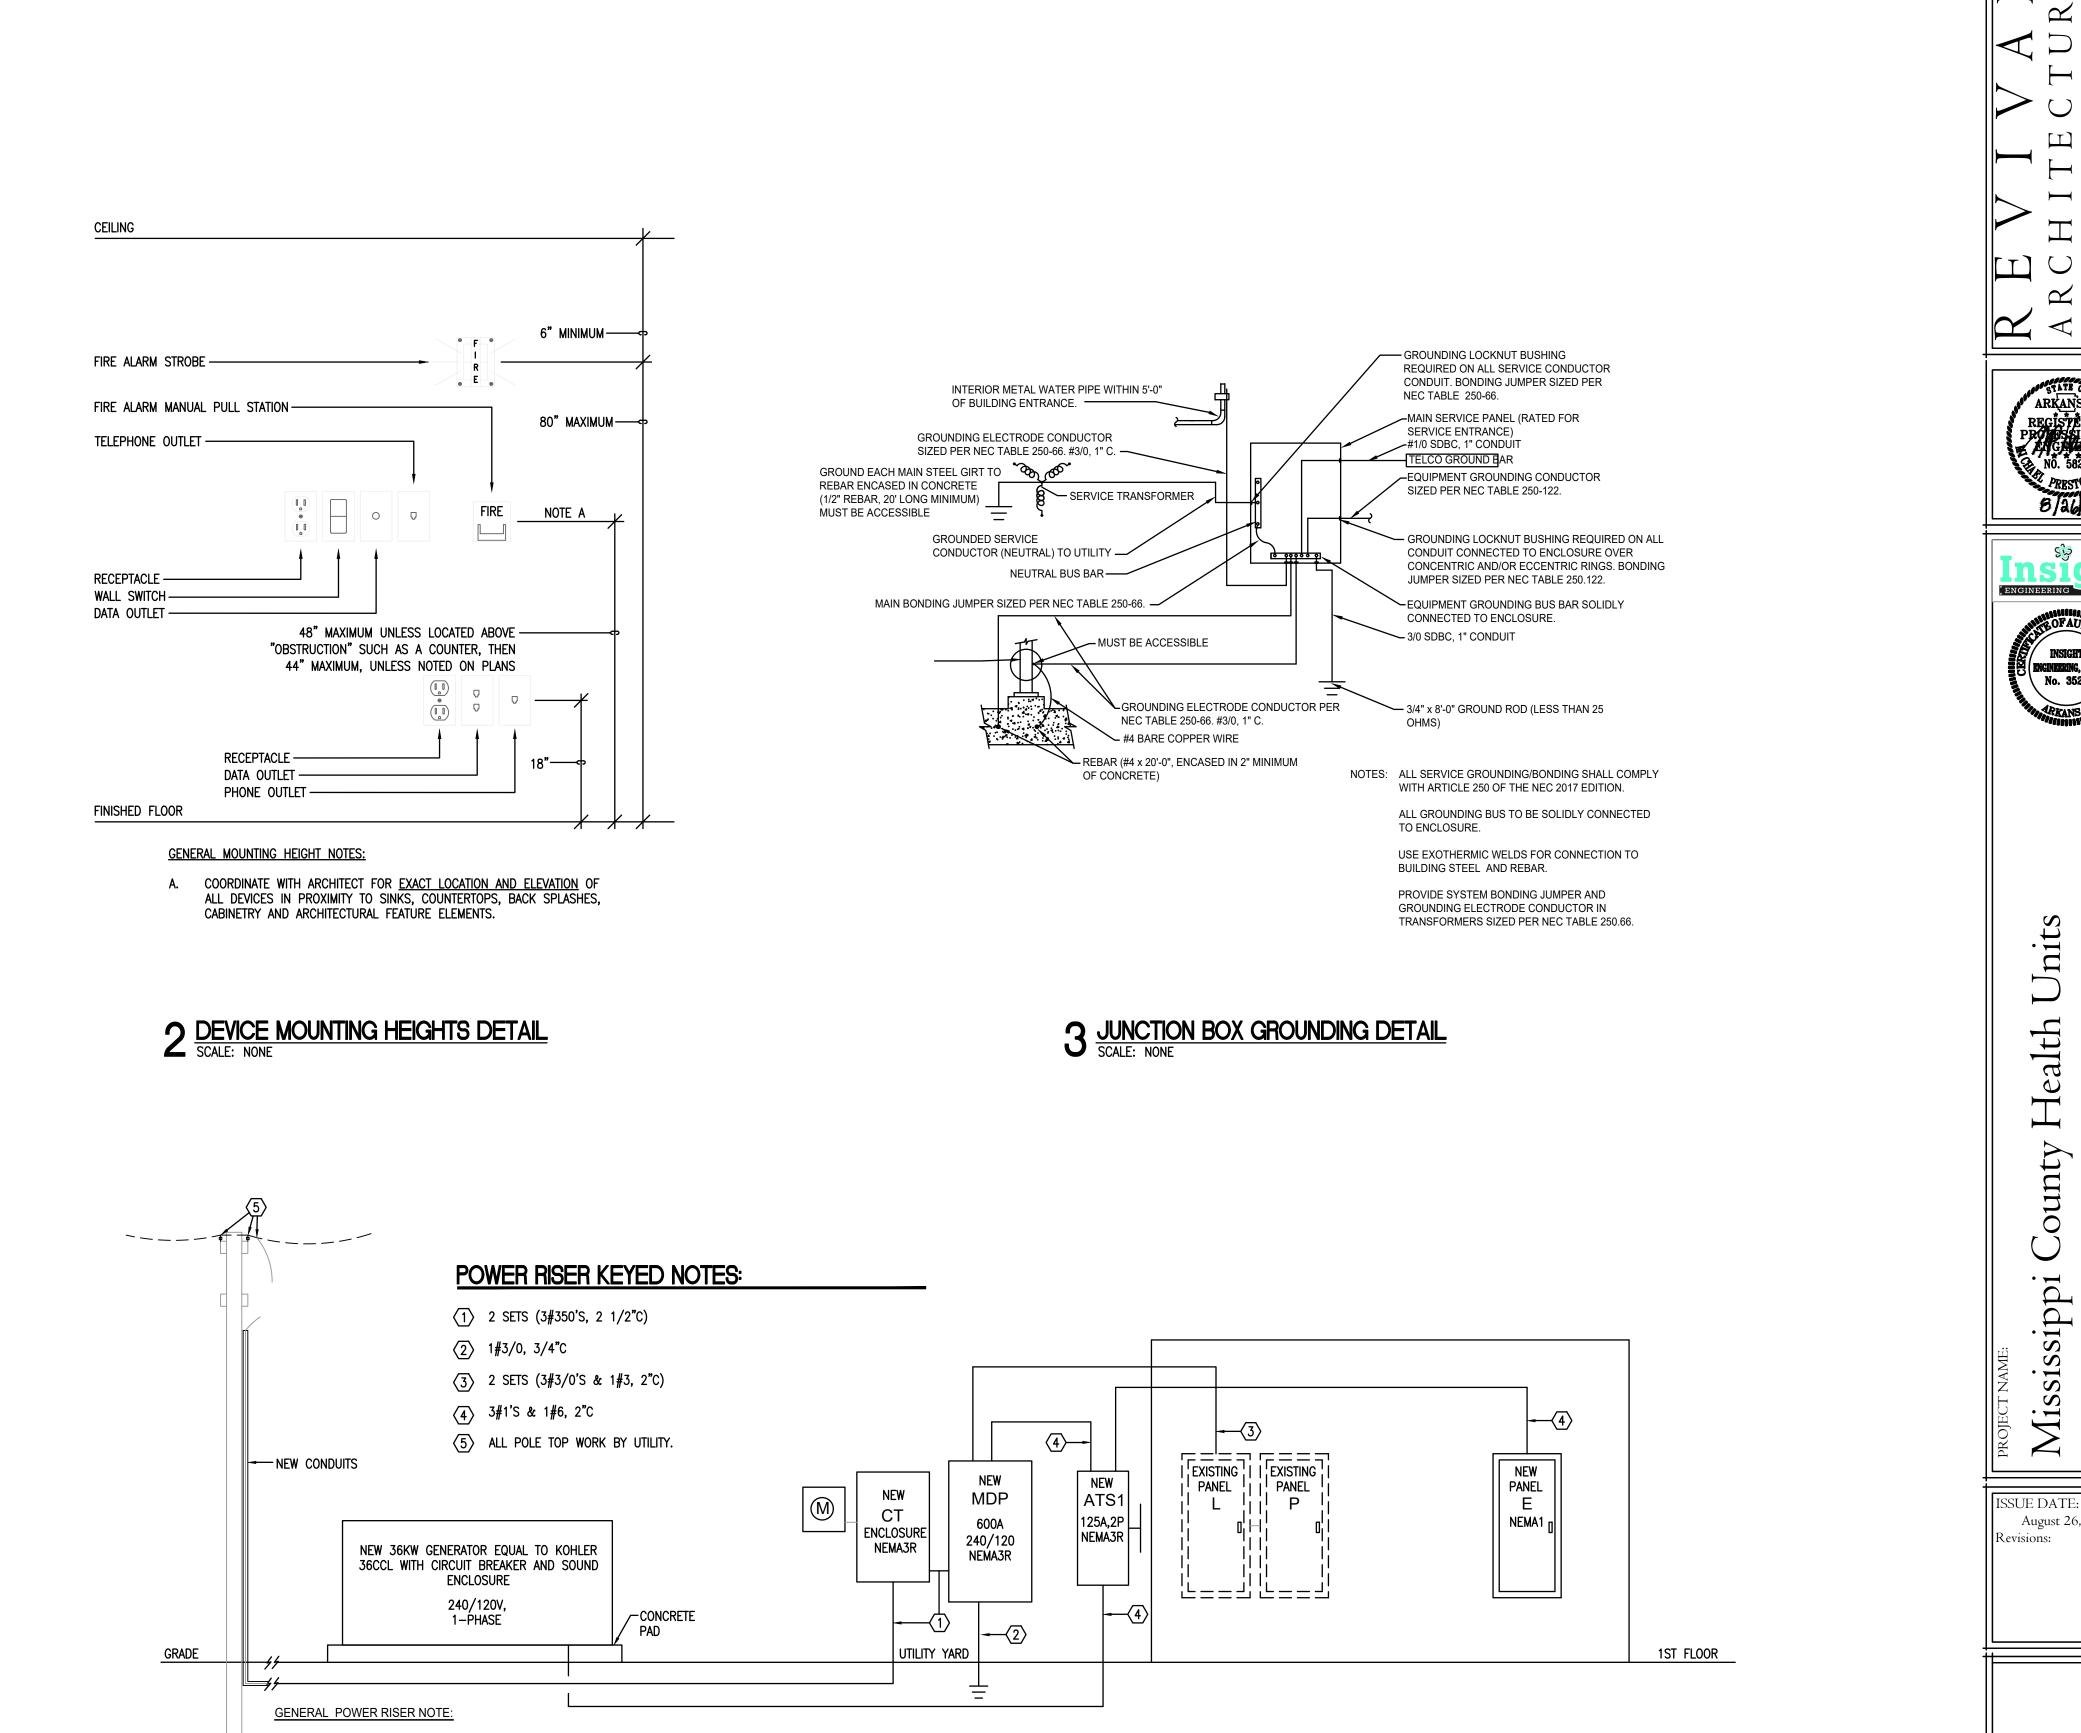

EC TO COORDINATE NEW SERVICE WITH LOCAL UTILITY. ALL COSTS AND FEES FOR TEMPORARY AND PERMANENT SERVICE TO THE BUILDING ARE TO BE PAID 1. BY CONTRACTOR.

4 POWER RISER DIAGRAM

-	A R C H I T E C T U P.O. Box 400, Scott, Arkansas 72142 (501) 951-3316 www.revivalarch.com
	ARKANSAS RECISTERED PROTOSSICILAL AAGAMANN NO. 5822 PRESTON B/26/22
	UNCOMPANY OF AUTOMATION OF AUT
	PROJECT NAME: Mississippi County Health Units Osceola
-	ISSUE DATE: August 26, 2022 Revisions:
+	Sheet Contents: ELECTRICAL DETAILS AND DIAGRAMS
	Sheet No: OE-2.I

ΙШ

Panel Name:MDPVoltage240/120		;									PANEL	. SCH	HEDUL	E						:						
Phase SINGLE Mounting: SURFACE		ICHES	SIZE AWG	SIZE AWG	P+N WIRES	P+N SETS	E AWG	RES			MBER		MBER			RES	E AWG	P+N SETS	P+N WIRES	SIZE AWG	E AWG	ICHES				
Rating NEMA 3R	LOAD	L L RACEWAY SIZE INCHES	PHASE SIZE	NEUTRAL SIZ	Ъ	NUMBER OF	GROUND SIZE	TOTAL WIRES	POLES	BREAKER TRIP	CIRCUIT NUMBER	I	CIRCUIT NUMBER	KER TRIP	POLES	TOTAL WIRES	GROUND SIZE AWG	NUMBER OF	NUMBER OF P	NEUTRAL SIZ	PHASE SIZE	WAY SIZE INCHES		LO	AD	
DESCRIPTION	A B	RACEV		Z	NUMBER	NUN	0			BREA			C	BREAKER			0	NUN	NUM	Z		RACEWAY	*			-
ATS	14140 14140	1 1/2	1/0	1/0	4	1	6	5	3	150	1 3		2 4	70	2	3	10	1	2		8	3/4		040	5040	_c
PANEL L	36240 36240	2 1/2	3/0	3/0	4	2	3	5	3	400	5 7		6 8	70	2	3	10	1	1		8	3/4	50	040	5040	_c
GENSET BATTERY CHARGER	500	3/4	12	12	2	1	12	3	1	20	9		10	20	1	3	12	1	2	12	12	3/4	6	600		L
GENSET BLOCK HEATER	1500	-	12	12	2	1	12	3	1	20	11		12	20	1	3	12	1	2	12	12	_	-		600	L
	1200	3/4	12	12	2	1	12	3	1	20	13	-	14	20	1	3	12	1	2	12	12	3/4	12	200		L
SPARE SPARE				+	<u> </u>		<u> </u>			20	15	╉	16	20							+		-			S
		-								20	17 19	╉	18 20	20	1						+					
											21		22					-			+		+			t
· · · · · · · · ·		-	<u> </u>				<u> </u>				23		24		+						-	-				T
											25		26								<u> </u>	<u> </u>		_		
					<u> </u>		 	<u> </u>			27 29	╉	28 30									+				T
TOTALS	52080 51880		I	1	1	1	1	1	1	I	L		1	1	, I	1	.1	.1	.,I		-	, _ I,	11	1880	10680	Т
WATTS PHASE A LOAD 63960 PHASE B LOAD 62560 TOTALS 126520			NECTE	D	527																					
	EXISTING L																	. <u></u>								
	Voltage 24	40/120														PA	NEL SC	HEDUL	.E		i.					
		INGLE URFACE									G								·					ω		Т
		• • • •						SI	ğ	AWG	P+N WIRES	SETS	NG				н.	н				NG	P+N SETS	P+N WIRES	S S	2
			_					SIZE INCHES	ZE AWG	SIZE A	A+N I	P+N P+N	ZE AV	/IRES	ES		CIRCUIT NUMBER	CIRCUIT NUMBER		ហ	TOTAL WIRES	IZE AV	P+N	P+N	L SIZE AWC	i
								SIZE	E SIZE	3AL		ΠOF	ND SI	OTAL WIRE	POLE	TRIP	UIT N	UIT N	TRIP	POLES	TAL W	ND SI	° OF	Ъ	S AL S	,
	Rating N	EMA 1				LOAD)		PHASE	NEUTRAL	NUMBER	NUMBER	GROUND SIZE AWG	0		BREAKER TRIP	CIRC	CIRC	BREAKER TRIP		0	GROUND SIZE AWG	NUMBER OF	NUMBER OF	NEUTRAL SIZE AWG	
	DES	CRIPTIO	N		A		В	RACEWAY		Z		N	0			BREA			BREA			0	NUI	NUN	2	
*	WAITING 101	·		· · ·	150	00									1	20	1	2	20	1						
*	LIGHTING - 102,103	3,105,107					1500								1	20	3	4	20	1						\Box
*	LIGHTING 107,108,				150	_										20	5	6	20	1						+
*	LIGHTING CORRID				150	_	1500					_				20 20	7 9	8 10	20 20	1			\rightarrow			+
*	LIGHTING 112, 113					_	1500										11	12	20	1						+
*	LIGHTING 129,132,	134			150	00									1	20	13	14	20	1						
*	LIGHTING ATTIC					_	1500									20	15	16	20	1						
*	RECEPTACLES 10 RECEPTACLES 10				150	_	1500					_				20 20	17 19	18 20	20 20	1						+
IF ALTERNATE IS TAKEN *	RECEPTACLES - R		6		150	_	1500						-				21	20	20	1						+
VAL CONDENSING UNIT *	RECEPTACLES - 1	02					1500								1	20	23	24	20	1						+
CIRCUIT AND CIRCUIT	RECEPTACLES - 1	18			150	00									1	20	25	26	20	1						
KERS TO "MDP" + +	DSCU-3				144	_	1440					_			2	15 -	27 29	28 30	20 20	1						_
· · · ·	WATER HEATER					_	1500								1	· · · ·	31	32	20	1						+
×+	SPARE														1	20	33	34	20	1						
+	CU4				504	_	5040					_			2	50 -	35 37	36 38	30 30	1						_
+ +	0.110				502	_	2760										39	40				\rightarrow	\rightarrow			+
+	CU2				276	_									2	35 —	41	42	100	2						
			TO	TALS	152	40 1	15240																			
	PHASE A LOAD	WATTS 362	3 240					CONNE	ECTED		302															
	PHASE & LOAD PHASE B LOAD	362	240																							
	TOTALS LEGEND:	724	480																							
		EXIST	ING	BREA	\KEF	2																				
	+ N	IEW E	3RE4	١KER	ł																					

I T⊢

			Amperage		600A							Panel Name:	E											<u> </u>		PANEL S	
		Main	A.I.C. Rat	ing: 100% RAT	65kAl							Voltage	240/120												F	ANEL S	CHE
		Iviairi		100 /8 ΠΑΤ								Phase	SINGLE	_			· · · · ·				<u> </u>		· · · ·				
				iii								Mounting:	SURFACE	_						ES	TS						
														-			ES	MG	AWG	WIF	P+N SETS	AWG	s s			ER	
				1	1									-			SIZE INCHES	SIZE AWG	SIZE AWG	P+N WIRES	Ч+	IZE /	TOTAL WIRES	្ល		CIRCUIT NUMBER	
												· · · · ·					IZE		AL S	OF	Ь	GROUND SIZE	AL W	POLES	RIP	N	
					s							Rating	NEMA 3R			1	۲۲ S	PHASE	NEUTRAL (ER C	NUMBER OF	NNO	101	"	BREAKER TRIP	RCU	
			DESCRI	PTION												.OAD	E M	H H	NEL	NUMBER	UMB	GR	'		AKE	CI	Ō
													DESCRIPTION		A	В	RACEWAY			NN	z				BRE		
	CU-1									E IS TAKEN					3120											1	
40	00-1							TO REMA	IN. RELOC	SING UNIT BF ATE CIRCUIT	S AND	DSCU-1				3120	- 3/4	10	10	2	1	10	3	2	30	3	
					ł		/ (CIRCUIT E	BREAKERS	SHOWN IN F			· · · ·		3120							-				5	
40	CU-3					Í			OCATION			DSCU-2			0120	3120	3/4	10	10	2	1	10	3	2	30	7	
	LAB REC	CEPTAC	LES											·	0700	3120											
		CEPTAC											L VACCINE RE	:F	2700	_								1	30	9	
		CEPTAC										EX GEN VACO				2700	_						ļ	1	30	11	
	SPARE											EX GEN CLEF	RICAL		1200								ļ	1	15	13	-
_												EX GEN CLEF	RICAL			1200								1	15	15	-
	SPARE																									17	-
			i.																							19	2
																										21	2
												· · ·														23	2
																										25	2
												·									-					27	2
																-										29	~
680	TOTALS	;										· · · · · ·		TOTALO		10140							I	I		23	Š
	·												· · · · · · · · · · · · · · · · · · ·	TOTALS	10140	10140											
													WATTS	_			CONN	IECTED)	118							
												PHASE A LO									-						
												TOTA	10 0000														
									-				LS 2828	30													
					Panel An Panel A.		a:	400A 22K	7				2820	30	: .												
					Panel An Panel A.I Main			400A 22K	-			EXISTING	P	30													
					Panel A.I	I.C. Ratin							P 240/120	30	· · · · ·									PAI	NEL SC	HEDULE	
Ð	SI SI				Panel A.I	I.C. Ratin						EXISTING Voltage Phase	P 240/120 SINGLE						· · · · · ·				·	PAI	NEL SC	HEDULE	
AWG	ICHES				Panel A.I	I.C. Ratin						EXISTING Voltage	P 240/120	30					JES	TS				PAI	NEL SC	HEDULE	
SIZE AWG	ZE INCHES				Panel A.I	I.C. Ratin						EXISTING Voltage Phase	P 240/120 SINGLE		· · · · · · · · · · · · · · · · · · ·		. MG	AWG	I WIRES	N SETS	AWG	S					
	SIZE				Panel A.I	I.C. Ratin						EXISTING Voltage Phase	P 240/120 SINGLE			INCHES	ZE AWG	size Awg	P+N WIRES	P+N SETS	IZE AWG	VIRES	ES			JUMBER	
PHASE SIZE AWG	SIZE	LO	DAD		Panel A.I Main	I.C. Rating 400A M						EXISTING Voltage Phase	P 240/120 SINGLE SURFACE		· · · · · · · · · · · · · · · · · · ·	SIZE INCHES	<u> </u> <u></u>	SIZE	Ъ	OF P+N	SIZE	ral wires	POLES			JUMBER	TRIP
	SIZE	LO	DAD B		Panel A.I Main	I.C. Ratin						EXISTING Voltage Phase	P 240/120 SINGLE			SIZE	SE SI	SIZE	Ъ	OF P+N	SIZE	TOTAL WIRES	POL	TRIP		JUMBER	(ER TRIP
	RACEWAY SIZE INCHES	-	T		Panel A.I Main	I.C. Ratiny 400A M						EXISTING Voltage Phase Mounting: Rating	P 240/120 SINGLE SURFACE			SIZE	SE SI	L SIZE	Ъ	P+N	GROUND SIZE AWG	TOTAL WIRES	POL	TRIP	CIRCUIT NUMBER	JUMBER	REAKER TRIP
	SIZE	A	T	-	Panel A.I Main	I.C. Rating 400A M					*	EXISTING Voltage Phase Mounting: Rating	P 240/120 SINGLE SURFACE		A	AV SIZF	SE SI	SIZE		OF P+N	SIZE	TOTAL WIRES	IOA	BREAKER TRIP	CIRCUIT NUMBER	CIRCUIT NUMBER	BREAKER TRIP
	SIZE	A	В	LIGHTING	Panel A.I Main	I.C. Ratiny 400A M	TION				*	EXISTING Voltage Phase Mounting: Rating	P 240/120 SINGLE SURFACE			B BADERWA	SE SI	SIZE	Ъ	OF P+N	SIZE	TOTAL WIRES	IOA 1	0 BREAKER TRIP	1 CIRCUIT NUMBER	CIRCUIT NUMBER	20
	SIZE	A 1500	B 1500	LIGHTING	Panel A.I Main	I.C. Ratiny 400A M 400A M DESCRIP G G	TION		* * *			EXISTING Voltage Phase Mounting: Rating OFFICE 136 LAB 134	P 240/120 SINGLE SURFACE		A 1500	SIZE	SE SI	SIZE	Ъ	OF P+N	SIZE	TOTAL WIRES	10 1	02 BREAKER TRIP	CIRCUIT NUMBER	CIRCUIT NUMBER	20 20
	SIZE	A 1500	B 1500	LIGHTING LIGHTING LIGHTING	Panel A.I Main E PARKINC PARKINC 136, 137, EXAM,11	I.C. Rating 400A M 400A M DESCRIP G G G (, 138, CA 11,117,12	TION				*	EXISTING Voltage Phase Mounting: Rating OFFICE 136 LAB 134 OFFICE 136	P 240/120 SINGLE SURFACE		A	B 2000 1500	SE SI	SIZE	Ъ	OF P+N	SIZE	TOTAL WIRES	1 1 1	BREAKER TRIP	2 CIRCUIT NUMBER	9 b CIRCUIT NUMBER	20 20 20
	SIZE	A 1500 1500	B 1500	LIGHTING LIGHTING LIGHTING LIGHTING	Panel A.I Main PARKING PARKING 136, 137, EXAM,11 110,120,	I.C. Rating 400A M 400A M DESCRIP G G G (, 138, CA 11,117,12 121	TION NOPY		- * - * - * - *		*	EXISTING Voltage Phase Mounting: Rating OFFICE 136 LAB 134 OFFICE 136 LAB 134 135	P 240/120 SINGLE SURFACE		A 1500 1500	B BADERWA	SE SI	SIZE	Ъ	OF P+N	SIZE	TOTAL WIRES	1 1 1 1	200 202 202 203 203 204 203 204 204 204 204 204 204 204 204 204 204	CIRCUIT NUMBER	8 CIRCUIT NUMBER	20 20 20 20
	SIZE	A 1500 1500	B 1500 1500	LIGHTING LIGHTING LIGHTING LIGHTING LIGHTING	Panel A.I Main E PARKINC PARKINC 136, 137, EXAM,11 110,120, CORRID	I.C. Ratiny 400A M 400A M DESCRIP G G G (, 138, CA 11,117,12 121 100R, 126,	TION NOPY 3 127				* * *	EXISTING Voltage Phase Mounting: Rating OFFICE 136 LAB 134 OFFICE 136 LAB 134 135 EXAM 112 CLI	P 240/120 SINGLE SURFACE NEMA 1 DESCRIPTION		A 1500	B 2000 B 2000 1500 1500	SE SI	SIZE	Ъ	OF P+N	SIZE	TOTAL WIRES	1 1 1 1 1	BREAKER TRIP 02 02 02 02 02 02 02 02 02 02 02 02 02	CIRCUIT NUMBER	CIRCUIT NUMBER	20 20 20 20 20
	SIZE	A 1500 1500 1500	B 1500 1500	LIGHTING LIGHTING LIGHTING LIGHTING LIGHTING	Panel A.I Main PARKING PARKING 136, 137, EXAM,11 110,120, CORRID CLES TE	I.C. Rating 400A M 400A M DESCRIP G G G (, 138, CA 11,117,12 121 00R, 126, ELEPHON	TION NOPY 3 127 NE BD				* * *	EXISTING Voltage Phase Mounting: Rating OFFICE 136 LAB 134 OFFICE 136 LAB 134 135 EXAM 112 CLI EXAM 112 CLI	P 240/120 SINGLE SURFACE NEMA 1 DESCRIPTION ERICAL 114 ERICAL 114		A 1500 1500 1500 1500	B 2000 1500	SE SI	SIZE	Ъ	OF P+N	SIZE	TOTAL WIRES	1 1 1 1 1 1 1	BREAKER TRIP 002 002 002 002 002 002 002 002 002 00	CIRCUIT NUMBER 2 CIRCUIT NUMBER 2 CIRCUIT NUMBER 2 CIRCUIT NUMBER 2 CIRCUIT NUMBER	CIRCUIT NUMBER	20 20 20 20 20 20 20
	SIZE	A 1500 1500 1500	B 1500 1500 1500 1500	LIGHTING LIGHTING LIGHTING LIGHTING LIGHTING RECEPTA	Panel A.I Main E PARKING PARKING 136, 137, EXAM,11 110,120, CORRID CLES TE CLES 103	I.C. Rating 400A M 400A M DESCRIP G G G (1,138, CA 11,117,12 121 100R, 126, ELEPHON 3,106,114	TION NOPY 3 127 NE BD				* * * *	EXISTING Voltage Phase Mounting: Rating OFFICE 136 LAB 134 OFFICE 136 LAB 134 135 EXAM 112 CLI EXAM 112 CLI EXAM 123 ST	P 240/120 SINGLE SURFACE NEMA 1 DESCRIPTION ERICAL 114 ERICAL 114 ORAGE 122		A 1500 1500	B 2000 B 2000 1500 2000 1500 2000 1500 2000 1500 2000 1500 2000	SE SI	SIZE	Ъ	OF P+N	SIZE	TOTAL WIRES	1 1 1 1 1 1 1 1 1	BREAKER TRIP 00 00 02 02 02 02 02 02 02 02 02 02 02	CIRCUIT NUMBER 2 CIRCUIT NUMBER 2 CIRCUIT NUMBER 2 CIRCUIT NUMBER	CIRCUIT NUMBER 5 6 7 7 7 7 7 7 7 7 7 7 7 7 7 7 7 7 7 7	20 20 20 20 20 20 20 20
	SIZE	A 1500 1500 1500 1500	B 1500 1500 1500 1500 1500	LIGHTING LIGHTING LIGHTING LIGHTING RECEPTA RECEPTA	Panel A.I Main PARKING PARKING PARKING 136, 137, EXAM,11 110,120, CORRID CLES TE CLES 100 CLES 100	I.C. Rating 400A M 400A M DESCRIP G G G G (11,117,12 121 DOR, 126, ELEPHON 3,106,114 2	TION NOPY 3 127 NE BD				* * * *	EXISTING Voltage Phase Mounting: Rating OFFICE 136 LAB 134 OFFICE 136 LAB 134 135 EXAM 112 CLI EXAM 112 CLI EXAM 123 STO	P 240/120 SINGLE SURFACE NEMA 1 DESCRIPTION ERICAL 114 ERICAL 114 ORAGE 122		A 1500 1500 1500 1500 1500	B 2000 B 2000 1500 1500	SE SI	SIZE	Ъ	OF P+N	SIZE	TOTAL WIRES	TOG 1 1 1 1 1 1 1 1 1 1 1 1 1	BREAKER TRIP 002 002 002 002 002 002 002 002 002 00	CIRCUIT NUMBER 2 CIRCUI	CIRCUIT NUMBER 2 4 6 8 10 12 14 16	20 20 20 20 20 20 20 20 20
	SIZE	A 1500 1500 1500 1500	B 1500 1500 1500 1500 1500	LIGHTING LIGHTING LIGHTING LIGHTING RECEPTA RECEPTA	Panel A.I Main DEPARKING PARKING 136, 137, EXAM,11 110,120, CORRID CLES TE CLES 100 CLES 100 CLES 100	I.C. Rating 400A M 400A M DESCRIP G G G G (11,117,12 121 DOR, 126, ELEPHON 3,106,114 2 1	TION NOPY 3 127 NE BD				* * * * * *	EXISTING Voltage Phase Mounting: Rating OFFICE 136 LAB 134 OFFICE 136 LAB 134 135 EXAM 112 CLI EXAM 112 CLI EXAM 123 ST EXAM 123 ST LAB 134	P 240/120 SINGLE SURFACE NEMA 1 DESCRIPTION ERICAL 114 ERICAL 114 ORAGE 122		A 1500 1500 1500 1500	B 2000 2000 2000 2000 2000 2000 2000 20	SE SI	SIZE	Ъ	OF P+N	SIZE	TOTAL WIRES	TOG 1 1 1 1 1 1 1 1 1 1 1 1 1	BREAKER TRIP 00 00 00 00 00 00 00 00 00 00 00 00 00	CIRCUIT NUMBER 2 CIRCUI	CIRCUIT NUMBER 2 3 4 6 6 7 7 7 7 7 7 7 7 7 7 7 7 7 7 7 7 7	20 20 20 20 20 20 20 20 20 20
	SIZE	A 1500 1500 1500 1500 1500	B 1500 1500 1500 1500 1500	LIGHTING LIGHTING LIGHTING LIGHTING RECEPTA RECEPTA RECEPTA	Panel A.I. Main DEPARKING PARKING PARKING 136, 137, EXAM,11 110,120, CORRID CLES 100 CLES 100 CLES 100 CLES 100 CLES 100	I.C. Rating 400A M 400A M 5000000000000000000000000000000000000	TION NOPY 3 127 NE BD				* * * * * *	EXISTING Voltage Phase Mounting: Rating OFFICE 136 LAB 134 OFFICE 136 LAB 134 135 EXAM 112 CLI EXAM 112 CLI EXAM 112 STO EXAM 123 STO EXAM 123 STO LAB 134	P 240/120 SINGLE SURFACE NEMA 1 DESCRIPTION ERICAL 114 ERICAL 114 ORAGE 122		A 1500 1500 1500 1500 1500 1500 1500 150	B 2000 B 2000 1500 2000 1500 2000 1500 2000 1500 2000 1500 2000	SE SI	SIZE	Ъ	OF P+N	SIZE	TOTAL WIRES	TOG 1 1 1 1 1 1 1 1 1 1 1 1 1	200 200 200 200 200 200 200 200 200 200	CIRCUIT NUMBER CIRCUIT NUMBER 11 13 15 17 19	LINOWBER CIRCUIT NUMBER 2 4 6 8 10 12 14 16 18 18 20	20 20 20 20 20 20 20 20 20 20 20
	SIZE	A 1500 1500 1500 1500 1500	B 1500 1500 1500 1500 1500 1500	LIGHTING LIGHTING LIGHTING LIGHTING LIGHTING RECEPTA RECEPTA RECEPTA	Panel A.I Main E PARKINC PARKINC 136, 137, EXAM,11 110,120, CORRID CLES 102 CLES 102 CLES 102 CLES 102 CLES 103 CLES 103	I.C. Rating 400A M 400A M DESCRIP G G G G (11,117,12 121 DOR, 126, ELEPHON 3,106,114 2 1 9, 113 9	ICB TION NOPY 3 127 NE BD 4	22K			* * * * * * *	EXISTING Voltage Phase Mounting: Rating OFFICE 136 LAB 134 OFFICE 136 LAB 134 135 EXAM 112 CLI EXAM 112 CLI EXAM 123 ST0 LAB 134 LAB 134 CIRC PUMP	P 240/120 SINGLE SURFACE NEMA 1 DESCRIPTION ERICAL 114 ERICAL 114 ORAGE 122		A 1500 1500 1500 1500 1500	B 2000 2000 2000 2000 2000 2000 2000 20	SE SI	SIZE	Ъ	OF P+N	SIZE	TOTAL WIRES	TOG 1 1 1 1 1 1 1 1 1 1 1 1 1	BREAKER TRIP 20 20 20 20 20 20 20 20 20 20 20 20 20	CIRCUIT NUMBER CIRCUIT NUMBER 2 1 1 2 1 2 1 2 1	UHCOLL NOWBER 2 CIRCULT NOWBER 4 6 6 8 10 12 14 16 18 18 20 22	20 20 20 20 20 20 20 20 20 20 20 20
	SIZE	A 1500 1500 1500 1500 1500 1500	B 1500 1500 1500 1500 1500 1500	LIGHTING LIGHTING LIGHTING LIGHTING RECEPTA RECEPTA RECEPTA RECEPTA	Panel A.I Main E PARKINC PARKINC 136, 137, EXAM,11 110,120, CORRID CLES 102 CLES 102 CLES 102 CLES 102 CLES 103 CLES 103	I.C. Rating 400A M 400A M DESCRIP G G G G (11,117,12 121 DOR, 126, ELEPHON 3,106,114 2 1 9, 113 9	ICB TION NOPY 3 127 NE BD 4	22K			* * * * * * * *	EXISTING Voltage Phase Mounting: Rating OFFICE 136 LAB 134 OFFICE 136 LAB 134 I35 EXAM 112 CLI EXAM 112 CLI EXAM 112 CLI EXAM 123 STO EXAM 123 STO LAB 134 LAB 134 LAB 134	P 240/120 SINGLE SURFACE NEMA 1 DESCRIPTION ERICAL 114 ERICAL 114 ORAGE 122		A 1500 1500 1500 1500 1500 1500 1500 150	B 2000 2000 2000 2000 2000 2000 2000 20	SE SI	SIZE	Ъ	OF P+N	SIZE	TOTAL WIRES	TOC 1 1 1 1 1 1 1 1 1 1 1 1 1	Image: state	CIRCUIT NUMBER CIRCUIT NUMBER 21 23	LINOWBER 2 4 6 8 10 12 14 16 18 20 22 24 24	20 20 20 20 20 20 20 20 20 20 20 20 20
	SIZE	A 1500 1500 1500 1500 1500 1500	B 1500 1500 1500 1500 1500 1500 1500	LIGHTING LIGHTING LIGHTING LIGHTING RECEPTA RECEPTA RECEPTA RECEPTA	Panel A.I Main E PARKINC PARKINC 136, 137, EXAM,11 110,120, CORRID CLES 102 CLES 102 CLES 102 CLES 102 CLES 103 CLES 103	I.C. Rating 400A M 400A M DESCRIP G G G G (11,117,12 121 DOR, 126, ELEPHON 3,106,114 2 1 9, 113 9	ICB TION NOPY 3 127 NE BD 4	22K			* * * * * * * * * *	EXISTING Voltage Phase Mounting: Rating OFFICE 136 LAB 134 OFFICE 136 LAB 134 OFFICE 136 LAB 134 I23 STO EXAM 123 STO EXAM 123 STO LAB 134 LAB 134 CIRC PUMP HEAT TAPE WAITING 131	P 240/120 SINGLE SURFACE NEMA 1 DESCRIPTION ERICAL 114 ERICAL 114 ORAGE 122 ORAGE 122		A 1500 1500 1500 1500 1500 1500 1500 150	B 44700000000000000000000000000000000000	DHASE SI	NEUTRAL SIZE		NUMBER OF P+N	GROUND SIZE	TOTAL	TOG 1 1 1 1 1 1 1 1 1 1 1 1 1	BHEAKER TRIP 20 20 20 20 20 20 20 20 20 20	CIRCUIT NUMBER CIRCUIT NUMBER 2 1 2 3 5 7 9 11 13 15 17 19 21 23 25	LINOWBER CIRCUIT NUMBER 2 4 6 7 4 6 8 10 12 14 16 18 16 18 10 12 14 16 18 20 22 24 24 26	20 20 20 20 20 20 20 20 20 20 20 20
	SIZE	A 1500 1500 1500 1500 1500 1500 1500	B 1500 1500 1500 1500 1500 1500 1500	LIGHTING LIGHTING LIGHTING LIGHTING RECEPTA RECEPTA RECEPTA RECEPTA	Panel A.I Main E PARKINC PARKINC 136, 137, EXAM,11 110,120, CORRID CLES 102 CLES 102 CLES 102 CLES 102 CLES 103 CLES 103	I.C. Rating 400A M 400A M DESCRIP G G G G (11,117,12 121 DOR, 126, ELEPHON 3,106,114 2 1 9, 113 9	ICB TION NOPY 3 127 NE BD 4	22K			* * * * * * * * *	EXISTING Voltage Phase Mounting: Rating OFFICE 136 LAB 134 OFFICE 136 LAB 134 135 EXAM 112 CLI EXAM 112 CLI EXAM 123 ST EXAM 123 ST LAB 134 LAB 134 LAB 134 CIRC PUMP HEAT TAPE WAITING 131 EXTERIOR RE	P 240/120 SINGLE SURFACE NEMA 1 DESCRIPTION ERICAL 114 ERICAL 114 ORAGE 122 ORAGE 122		A 1500 1500 1500 1500 1500 1500 1500 150	B 2000 2000 2000 2000 2000 2000 2000 20	DHASE SI	NEUTRAL SIZE	Ъ	OF P+N	SIZE	ε τοται wires	I 1	20 20 20 20 20 20 20 20 20 20 20 20 20 2	CIRCUIT NUMBER 1 3 5 7 9 11 13 15 17 19 21 23 25 27	Handbook and the second	20 20 20 20 20 20 20 20 20 20 20 20 20
	SIZE	A 1500 1500 1500 1500 1500 1500 1500	B 1500 1500 1500 1500 1500 1500 1500 150	LIGHTING LIGHTING LIGHTING LIGHTING LIGHTING RECEPTA RECEPTA RECEPTA RECEPTA RECEPTA RECEPTA FU1 FU2	Panel A.I Main E PARKINC PARKINC 136, 137, EXAM,11 110,120, CORRID CLES 102 CLES 102 CLES 102 CLES 102 CLES 103 CLES 103	I.C. Rating 400A M 400A M DESCRIP G G G G (11,117,12 121 DOR, 126, ELEPHON 3,106,114 2 1 9, 113 9	ICB TION NOPY 3 127 NE BD 4	22K			* * * * * * * * * *	EXISTING Voltage Phase Mounting: Rating OFFICE 136 LAB 134 OFFICE 136 LAB 134 OFFICE 136 LAB 134 I23 STO EXAM 123 STO EXAM 123 STO LAB 134 LAB 134 CIRC PUMP HEAT TAPE WAITING 131	P 240/120 SINGLE SURFACE NEMA 1 DESCRIPTION ERICAL 114 ERICAL 114 ORAGE 122 ORAGE 122		A 1500 1500 1500 1500 1500 1500 1500 1500 1500 1500 1500 1500 1500 1500 1500 1500 1500	B 2000 CV2	DHASE SI	NEUTRAL SIZE		NUMBER OF P+N	GROUND SIZE	TOTAL	I 1	BHEAKER TRIP 20 20 20 20 20 20 20 20 20 20	CIRCUIT NUMBER 1 3 5 7 9 11 13 15 17 19 21 23 25 27	Hand Hand Hand Hand Hand Hand Hand Hand	20 20 20 20 20 20 20 20 20 20 20 20 20 2
	SIZE	A 1500 1500 1500 1500 1500 1500 1500	B 1500 1500 1500 1500 1500 1500 1500 150	LIGHTING LIGHTING LIGHTING LIGHTING LIGHTING RECEPTA RECEPTA RECEPTA RECEPTA RECEPTA RECEPTA FU1 FU2 FU3	Panel A.I Main E PARKINC PARKINC 136, 137, EXAM,11 110,120, CORRID CLES 102 CLES 102 CLES 102 CLES 102 CLES 103 CLES 103	I.C. Rating 400A M 400A M DESCRIP G G G G (11,117,12 121 DOR, 126, ELEPHON 3,106,114 2 1 9, 113 9	ICB TION NOPY 3 127 NE BD 4	22K			* * * * * * * * * *	EXISTING Voltage Phase Mounting: Rating OFFICE 136 LAB 134 OFFICE 136 LAB 134 135 EXAM 112 CLI EXAM 112 CLI EXAM 123 ST EXAM 123 ST LAB 134 LAB 134 LAB 134 CIRC PUMP HEAT TAPE WAITING 131 EXTERIOR RE	P 240/120 SINGLE SURFACE NEMA 1 DESCRIPTION ERICAL 114 ERICAL 114 ORAGE 122 ORAGE 122	TOTALS	A 1500 1500 1500 1500 1500 1500 1500 150	B 44700000000000000000000000000000000000	DHASE SI	NEUTRAL SIZE		NUMBER OF P+N	GROUND SIZE	TOTAL	I 1	20 20 20 20 20 20 20 20 20 20 20 20 20 2	CIRCUIT NUMBER 1 3 5 7 9 11 13 15 17 19 21 23 25 27	Handbook and the second	20 20 20 20 20 20 20 20 20 20 20 20 20 2
	SIZE	A 1500 1500 1500 1500 1500 1500 1500	B 1500 1500 1500 1500 1500 1500 1500 150	LIGHTING LIGHTING LIGHTING LIGHTING LIGHTING RECEPTA RECEPTA RECEPTA RECEPTA RECEPTA RECEPTA FU1 FU2	Panel A.I Main E PARKINC PARKINC 136, 137, EXAM,11 110,120, CORRID CLES 102 CLES 102 CLES 102 CLES 102 CLES 103 CLES 103	I.C. Rating 400A M 400A M DESCRIP G G G G (11,117,12 121 DOR, 126, ELEPHON 3,106,114 2 1 9, 113 9	ICB TION NOPY 3 127 NE BD 4	22K			* * * * * * * * * *	EXISTING Voltage Phase Mounting: Rating OFFICE 136 LAB 134 OFFICE 136 LAB 134 OFFICE 136 LAB 134 I23 STO EXAM 112 CLI EXAM 112 CLI EXAM 112 CLI EXAM 123 STO LAB 134 CIRC PUMP HEAT TAPE WAITING 131 EXTERIOR RE SPARE	P 240/120 SINGLE SURFACE NEMA 1 DESCRIPTION ERICAL 114 ERICAL 114 ERICAL 114 ORAGE 122 ORAGE 122 ORAGE 122 ECEPTS	TOTALS	A 1500 1500 1500 1500 1500 1500 1500 1500 1500 1500 1500 1500 1500 1500 1500 1500 1500	B 2000 CV2	DHASE SI	NEUTRAL SIZE			GROUND SIZE	TOTAL	I 1	20 20 20 20 20 20 20 20 20 20 20 20 20 2	CIRCUIT NUMBER 1 3 5 7 9 11 13 15 17 19 21 23 25 27	Handbook and the second	20 20 20 20 20 20 20 20 20 20 20 20 20 2
	SIZE	A 1500 1500 1500 1500 1500 1500 1500 150	B 1500 1500 1500 1500 1500 1500 1500 150	LIGHTING LIGHTING LIGHTING LIGHTING RECEPTA RECEPTA RECEPTA RECEPTA RECEPTA RECEPTA RECEPTA FU1 FU1 FU2 FU3 FU4	Panel A.I Main E PARKINC PARKINC 136, 137, EXAM,11 110,120, CORRID CLES 102 CLES 102 CLES 102 CLES 102 CLES 103 CLES 103	I.C. Rating 400A M 400A M DESCRIP G G G G (11,117,12 121 DOR, 126, ELEPHON 3,106,114 2 1 9, 113 9	ICB TION NOPY 3 127 NE BD 4	22K			* * * * * * * * * *	EXISTING Voltage Phase Mounting: Rating OFFICE 136 LAB 134 OFFICE 136 LAB 134 135 EXAM 112 CLI EXAM 112 CLI EXAM 123 ST EXAM 123 ST LAB 134 LAB 134 LAB 134 CIRC PUMP HEAT TAPE WAITING 131 EXTERIOR RE	P 240/120 SINGLE SURFACE SURFACE NEMA 1 DESCRIPTION ERICAL 114 ERICAL 114 ERICAL 114 ORAGE 122 ORAGE 122 ORAGE 122	TOTALS	A 1500 1500 1500 1500 1500 1500 1500 1500 1500 1500 1500 1500 1500 1500 1500 1500 1500	B 2000 CV2	A 12	NEUTRAL SIZE	NUMBER OF		GROUND SIZE	TOTAL	I 1	20 20 20 20 20 20 20 20 20 20 20 20 20 2	CIRCUIT NUMBER 1 3 5 7 9 11 13 15 17 19 21 23 25 27	Handbook and the second	20 20 20 20 20 20 20 20 20 20 20 20 20 2
	SIZE	A 1500 1500 1500 1500 1500 1500 1500 150	B 1500 1500 1500 1500 1500 1500 1500 150	LIGHTING LIGHTING LIGHTING LIGHTING LIGHTING RECEPTA RECEPTA RECEPTA RECEPTA RECEPTA RECEPTA FU1 FU2 FU3 FU4 PANEL P	Panel A.I Main E PARKINC PARKINC 136, 137, EXAM,11 110,120, CORRID CLES 102 CLES 102 CLES 102 CLES 102 CLES 103 CLES 103	I.C. Rating 400A M 400A M DESCRIP G G G G (11,117,12 121 DOR, 126, ELEPHON 3,106,114 2 1 9, 113 9	ICB TION NOPY 3 127 NE BD 4	22K			* * * * * * * * * *	EXISTING Voltage Phase Mounting: Rating OFFICE 136 LAB 134 OFFICE 136 LAB 134 135 EXAM 112 CLI EXAM 112 CLI EXAM 123 STI EXAM 123 STI EXAM 123 STI LAB 134 LAB 134 LAB 134 LAB 134 LAB 134 LAB 134 CIRC PUMP HEAT TAPE WAITING 131 EXTERIOR RE SPARE	P 240/120 SINGLE SURFACE SURFACE NEMA 1 DESCRIPTION ERICAL 114 ERICAL 114 ORAGE 122 ORAGE 122 ORAGE 122 ECEPTS ECEPTS	TOTALS	A 1500 1500 1500 1500 1500 1500 1500 1500 1500 1500 1500 1500 1500 1500 1500 1500 1500	B 2000 CV2	A 12	NEUTRAL SIZE	NUMBER OF		GROUND SIZE	TOTAL	I 1	20 20 20 20 20 20 20 20 20 20 20 20 20 2	CIRCUIT NUMBER 1 3 5 7 9 11 13 15 17 19 21 23 25 27	Handbook and the second	20 20 20 20 20 20 20 20 20 20 20 20 20 2
	LACEWAY SIZE	A 1500 1500 1500 1500 1500 1500 1500 150	B 1500 1500 1500 1500 1500 1500 1500 150	LIGHTING LIGHTING LIGHTING LIGHTING RECEPTA RECEPTA RECEPTA RECEPTA RECEPTA RECEPTA RECEPTA FU1 FU1 FU2 FU3 FU4	Panel A.I Main E PARKINC PARKINC 136, 137, EXAM,11 110,120, CORRID CLES 102 CLES 102 CLES 102 CLES 102 CLES 103 CLES 103	I.C. Rating 400A M 400A M DESCRIP G G G G (11,117,12 121 DOR, 126, ELEPHON 3,106,114 2 1 9, 113 9	ICB TION NOPY 3 127 NE BD 4	22K			* * * * * * * * * *	EXISTING Voltage Phase Mounting: Rating OFFICE 136 LAB 134 OFFICE 136 LAB 134 OFFICE 136 LAB 134 I23 ST EXAM 112 CL EXAM 112 CL EXAM 112 CL EXAM 123 ST LAB 134 LAB 134 CIRC PUMP HEAT TAPE WAITING 131 EXTERIOR RE SPARE	P 240/120 SINGLE SURFACE SURFACE NEMA 1 DESCRIPTION ERICAL 114 ERICAL 114 ERICAL 114 ORAGE 122 ORAGE 122 ORAGE 122 ECEPTS ECEPTS	TOTALS	A 1500 1500 1500 1500 1500 1500 1500 1500 1500 1500 1500 1500 1500 6000	B 2000 CV2	A 12	NEUTRAL SIZE	NUMBER OF		GROUND SIZE	TOTAL	I 1	20 20 20 20 20 20 20 20 20 20 20 20 20 2	CIRCUIT NUMBER 1 3 5 7 9 11 13 15 17 19 21 23 25 27	Handbox Constraints of the second sec	20 20 20 20 20 20 20 20 20 20 20 20 20 2
	LACEWAY SIZE	A 1500 1500 1500 1500 1500 1500 1500 150	B 1500 1500 1500 1500 1500 1500 1500 150	LIGHTING LIGHTING LIGHTING LIGHTING LIGHTING RECEPTA RECEPTA RECEPTA RECEPTA RECEPTA RECEPTA FU1 FU2 FU3 FU4 PANEL P	Panel A.I Main E PARKINC PARKINC 136, 137, EXAM,11 110,120, CORRID CLES 102 CLES 102 CLES 102 CLES 102 CLES 103 CLES 103	I.C. Rating 400A M 400A M DESCRIP G G G G (11,117,12 121 DOR, 126, ELEPHON 3,106,114 2 1 9, 113 9	ICB TION NOPY 3 127 NE BD 4	22K			* * * * * * * * * *	EXISTING Voltage Phase Mounting: Rating OFFICE 136 LAB 134 OFFICE 136 LAB 134 OFFICE 136 LAB 134 I23 STO EXAM 112 CLI EXAM 123 STO EXAM 123 STO EXAM 123 STO LAB 134 CIRC PUMP HEAT TAPE WAITING 131 EXTERIOR RE SPARE PHASE A LO. PHASE B LO. TOTA LEGEND:	P 240/120 SINGLE SURFACE SURFACE NEMA 1 DESCRIPTION ERICAL 114 ERICAL 114 ERICAL 114 ORAGE 122 ORAGE 122 ORAGE 122 CORAGE 122 ORAGE 12 ORAGE 12 ORAGE 12 ORAGE 12 ORAGE 12 ORAGE 12	TOTALS	A 1500 1500 1500 1500 1500 1500 1500 1500 1500 1500 1500 1500 1500 6000	B 2000 CV2	A 12	NEUTRAL SIZE	NUMBER OF		GROUND SIZE	TOTAL	I 1	20 20 20 20 20 20 20 20 20 20 20 20 20 2	CIRCUIT NUMBER 1 3 5 7 9 11 13 15 17 19 21 23 25 27	Handbox Constraints of the second sec	20 20 20 20 20 20 20 20 20 20 20 20 20 2
	LACEWAY SIZE	A 1500 1500 1500 1500 1500 1500 1500 150	B 1500 1500 1500 1500 1500 1500 1500 150	LIGHTING LIGHTING LIGHTING LIGHTING LIGHTING RECEPTA RECEPTA RECEPTA RECEPTA RECEPTA RECEPTA FU1 FU2 FU3 FU4 PANEL P	Panel A.I Main E PARKINC PARKINC 136, 137, EXAM,11 110,120, CORRID CLES 102 CLES 102 CLES 102 CLES 102 CLES 103 CLES 103	I.C. Rating 400A M 400A M DESCRIP G G G G (11,117,12 121 DOR, 126, ELEPHON 3,106,114 2 1 9, 113 9	ICB TION NOPY 3 127 NE BD 4	22K			* * * * * * * * * *	EXISTING Voltage Phase Mounting: Rating OFFICE 136 LAB 134 OFFICE 136 LAB 134 OFFICE 136 LAB 134 I23 ST EXAM 112 CL EXAM 112 CL EXAM 123 ST EXAM 123 S	P 240/120 SINGLE SURFACE SURFACE NEMA 1 DESCRIPTION ERICAL 114 ERICAL 114 ERICAL 114 ORAGE 122 ORAGE 122 ORAGE 122 ECEPTS ECEPTS	TOTALS	A 1500 1500 1500 1500 1500 1500 1500 1500 1500 1500 1500 1500 1500 6000	B 2000 CV2	A 12	NEUTRAL SIZE	NUMBER OF		GROUND SIZE	TOTAL	I 1	20 20 20 20 20 20 20 20 20 20 20 20 20 2	CIRCUIT NUMBER 1 3 5 7 9 11 13 15 17 19 21 23 25 27	Handbox Constraints of the second sec	20 20 20 20 20 20 20 20 20 20 20 20 20 2

		LIGHT FI	XTURE SCH	EDULE		
TYPE	MANUFACTURER	CATALOG NUMBER	VOLTAGE	LAMP	COLOR	MOUNTING NOTES
A1	COLUMBIA	RLW-4-35-XW-FA-W-EU	UNV	LED	35K	SURFACE LED LINEAR WRAP
A1E	COLUMBIA	RLW-4-35-XW-FA-W-EU-ELL14	UNV	LED	35K	SURFACE LED LINEAR WRAP
A2	COLUMBIA	RLW-4-35-MW-FA-W-EU	UNV	LED	35K	SURFACE LED LINEAR WRAP
A2E	COLUMBIA	RLW-4-35-MW-FA-W-EU-ELL14	UNV	LED	35K	SURFACE LED LINEAR WRAP
A3	COLUMBIA	RLW-4-35-LW-FA-W-EU	UNV	LED	35K	SURFACE LED LINEAR WRAP
A3E	COLUMBIA	RLW-4-35-LW-FA-W-EU-ELL14	UNV	LED	35K	SURFACE LED LINEAR WRAP
В	PRESCOLITE	LTR-4RD-H-SL15L-DM1 W/ LTR-4RD-T-SL-35K-WDS	UNV	LED	35K	RECESSED 4" ROUND LED DOWNLIGHT
BE	PRESCOLITE	LTR-4RD-H-SL15L-DM1-EM W/ LTR-4RD-T-SL-35K-WDS	UNV	LED	35K	RECESSED 4" ROUND LED DOWNLIGHT WITH EMERGENCY
C1	BROWNLEE	5160-48-XX-H32-35K	UNV	LED	35K	WALL 48" LED VANITY
C2	BROWNLEE	5160-13-XX-H10-35K	UNV	LED	35K	WALL 13" LED VANITY
D	BROWNLEE	2680-30-50L-XX-XX-XXX-35K	UNV	LED	35K	SURFACE LED DRUM PENDANT
E	CURRENT	RWL1-48L-10-4K7-4W-120-XX-EH-PC	UNV	LED	40K	WALL WALL MOUNT LED
F	BROWNLEE	2690-12-XX-H15-XXX-35K+DL6	UNV	LED	35K	PENDANT LED PENDANT
G	AFX	KNLU40XX-35K	UNV	LED	35K	SURFACE LED UNDERCABINET
Н	BROWNLEE	1260-XX-H10-EC1-35K	UNV	LED	35K	WALL LED SCONCE
J	AFX	EGRF2440LAJD2WH	UNV	LED	40K	SURFACE 24" ROUND SURFACE MOUNT
X1	COMPASS	CELS1RNE	UNV	LED	NA	WALL EXIT SIGN WITH BATTERY
NOTES:	ALL FIXTURE COLORS	TO BE SELECTED FROM MANUFACTURERS LIST OF STANDARD	COLORS BY ARCH	ITECT		

NOTES: ALL FIXTURE COLORS TO BE SELECTED FROM MANUFACTURERS LIST OF STANDARD COLORS BY ARCHITECT.


			_				:		÷			i	:	Panel Amperage: 150A
F	PANEL SO	CHEDUL	.E											Panel A.I.C. Rating: 22K
		_			- 									Main MLO
BREAKER TRIP	CIRCUIT NUMBER	CIRCUIT NUMBER	BREAKER TRIP	POLES	TOTAL WIRES	GROUND SIZE AWG	NUMBER OF P+N SETS	NUMBER OF P+N WIRES	NEUTRAL SIZE AWG	PHASE SIZE AWG	RACEWAY SIZE INCHES			
AKE	CIE	G	AKE			GR(NB	MBE	NEC	H	EWP	LC	AD	DECODIDITION
BRE			BRE				Ī	R			RAC	А	В	DESCRIPTION
30	1	2	20	1	3	12	1	2	12	12	3/4	1500		REFRIGERATOR
30	3	4	20	1	3	12	1	2	12	12	3/4		1500	REFRIGERATOR
30	5	6	20	1	3	12	1	2	12	12	3/4	1500		REFRIGERATOR
30	7	8	20	1	3	12	1	2	12	12	3/4		1500	REFRIGERATOR
30	9	10	20									1000		EX GEN PHONE SYSTEM
30	11	12	15										1000	EX GEN LORIE
15	13	14												
15	15	16												
	17	18												
	19	20												
	21	22												
	23	24												
	25	26												
	27	28												
	29	30												
												4000	4000	TOTALS

IEDUI	E							÷	1				mperage:	400A
			l									Panel A Main	I.C. Rating: 400A MCB	22K
		[- Indin		·
~				5	ETS	IRES	σ							,
IBEF			E S	AW	P+N SETS	P+N WIRES	AW	AWG	Ë					
NUN		POLES	WIR	SIZE		Å.	SIZE	SIZE AWG						
)UIT	TRII	POI	TOTAL WIRES	QN	3 OF	Ъ	RAL	Ц Ц Ц	SIZE					
CIRCUIT NUMBER	KER		1 2	GROUND SIZE AWG	NUMBER OF	NUMBER OF	NEUTRAL SIZE AWG	PHASE	WAY	LC	AD		, , ,	
	BREAKER TRIP				INN	NUN			RACEWAY SIZE INCHES	A	В	-	DESCRIPTION	
2	20	1								1500		EXAM 115 124	1	
4	20	1								1000	1500	EXAM 115 124		
6	20	1								1500		PROFESSIONAL S	TAFF OFFICE	i
8	20	1									1500	STAFF TLT		
10	20	1								1500		ADMIN 109 OFFICI	E 108	
12	20	1									1500	ADMIN 109 OFFICI	E 108	
14	20	1								1500		EXAM 111 EXAM 1	17	
16	20	1									1500	EXAM 111 EXAM 1	17	
18	20	1								1500		HOME HEALTH SE	EC 121	
20	20	1									1500	OFFICE 128		
22	20	1								1500		JAN 129 TLT 132 C	OFFICE 133	i
24	20	1									1500	RECEPTACLES 13	39	i
26	20	1								1500		REFRIGERATOR		
28														
30	60	2										1		
			•	•		•	•	•		6000	4500	TOTALS		

-			-		
Sheet No: OE-2.2	Sheet Contents: ELECTRICAL SCHEDULES	PROJECT NAME: Mississippi County Health Units Discola Discola	ENGINEERING 0000	ARKANSAS RECISTERED PROTESSIONAL AAGHANNA AAGHANNA PRESTON PRESTON B/26/22	REVIVAL ARCHITECTURE P.O. Box 400, Scott, Arkansas 72142 (501) 951-3316 www.revivalarch.com S.D.G.

			Η\	AC LEGE	END
ABBREVIATION	OR SYMBOL	DESCRIPTION	ABBREVIATION	OR SYMBOL	DESCRIPTION
AHU AFF AP BHP	AIR HANDLING UNIT ABOVE FINISHED FLO ACCESS PANEL BRAKE HORSEPOWER	OOR		CEILING SUPPLY	′ DIFFUSER
BTUH CFM CRAC	BRITISH THERMAL U CUBIC FEET PER MIN COMPUTER ROOM AI	NIT PER HOUR	, ø	CEILING RETUR	N/EXHAUST GRILLE
D DB DN EA	DRAIN DRY BULB TEMPERAT DOWN EXHAUST AIR			GRILLE OR REGI DUCTWORK	ISTER ON BOTTOM OF
EAT ESP EWT FCU FLR	EXTERNAL STATIC PE ENTERING WATER TE FAN COIL UNIT FLOOR		18/12 SA	SIDEWALL SUPP	'LY (RETURN SIMILAR)
FO FPM GPM	FLAT OVAL FEET PER MINUTE (V GALLONS PER MINUT		18/12	RECTANGULAR [DUCT WITH DUCT SIZE TAG
HP KW	HORSEPOWER	L	20ø	ROUND DUCT W	ITH DUCT SIZE TAG
LAT LWT MAU MAX	LEAVING WATER TEM MAKE-UP AIR UNIT MAXIMUM	RATURE OF THE COIL IPERATURE	20/14Φ	OVAL DUCT WIT	H DUCT SIZE TAG
MIN MHP NTS OSA	MINIMUM MOTOR HORSEPOWE NOT TO SCALE OUTSIDE AIR		24/24 SA	SUPPLY DUCT U	P
PSI RA RH	POUNDS PER SQUAR RETURN AIR RELATIVE HUMIDITY		24/24 SA	SUPPLY DUCT D	OWN
RPM RTU SA	REVOLUTION PER MI ROOF TOP (AIR CON SUPPLY AIR	NUTE	24/24 RA	RETURN DUCT L	JP
SP TYP	STATIC PRESSURE TYPICAL		24/24 RA	RETURN DUCT D	DOWN
VAV WB XFR '	VARIABLE AIR VOLUI WET BULB TEMPERAT TRANSFER AIR FEET		24/24 EA	EXHAUST DUCT	UP
" Ø Φ	INCHES ROUND DUCT OVAL DUCT		24/24 EA	EXHAUST DUCT	DOWN
			18/18Φ 24/12	RECTANGULAR/0	OVAL TRANSITION
			18ø 24/12	RECTANGULAR/	ROUND TRANSITION
- DETAIL/S	ECTION NUMBER			FLEXIBLE DUCT	CONNECTION
SHEET NU	DETAIL/SECTIO	N DESIGNATION		(1) FIRE DAMPE (2) SMOKE DAM (3) MOTORIZED (4) CONTROL D/	PER DAMPER
T _{VAV-2} S		R SENSOR. (SUBSCRIPT ONTROLLED EQUIPMENT)	(1) SD (2)	(1) BALANCING (2) SMOKE DETI	
<u>لا</u>	KEYED NOTE		250	BALANCING DAM	

* NOT ALL SYMBOLS MAY APPLY TO THIS PROJECT

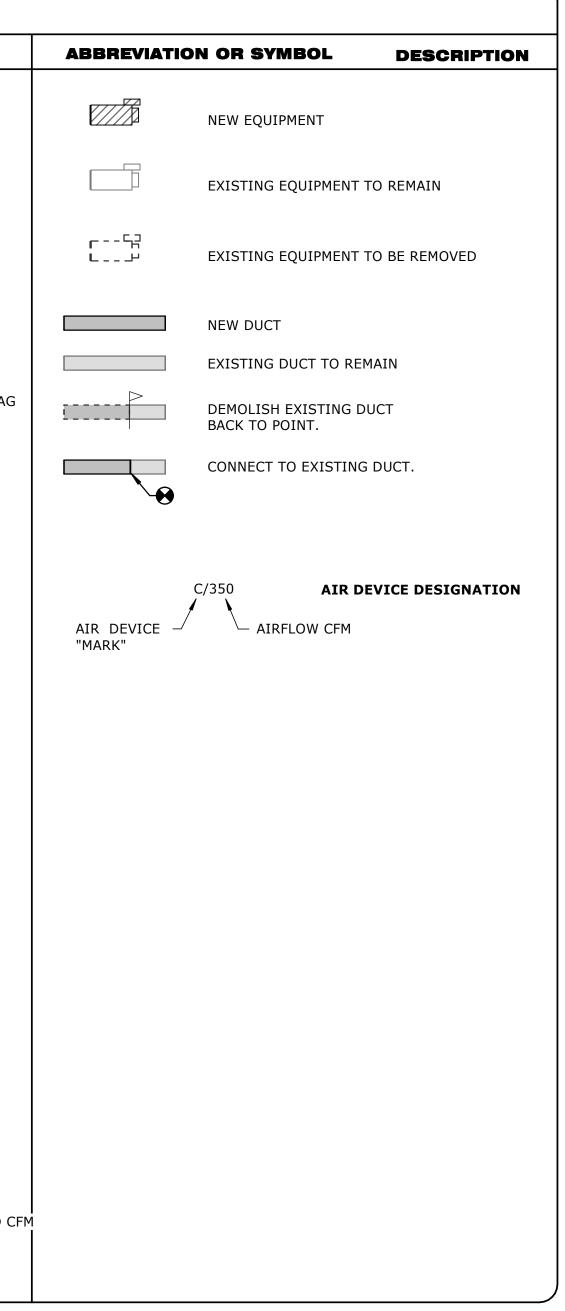

MECHANICAL GENERAL NOTES:

- TESTING ARE COMPLETE AND WORK IS ACCEPTED.
- REFER TO SPECIFICATION SHEETS FOR ADDITIONAL PROJECT INFORMATION.
- REFER TO ALL PROJECT DRAWINGS FOR DETAILS OF CONSTRUCTION AND INSTALLATION REQUIREMENTS. 4. 5. TRADES ASSOCIATED WITH THE SUBSTITUTION SHALL BE INCLUDED IN THE BID.
- 6. THE CONTRACTOR AND REPLACED WITH THE ORIGINAL DESIGN OR CORRECTED AS DIRECTED BY THE ENGINEER WITHOUT ADDITIONAL COST TO THE OWNER. 7.
- SHOW EVERY OFFSET, SEQUENCE, DEVICE, OPTION, FITTING, OR COMPONENT. 8. 9.
- 10. LAYOUT FOR COORDINATION OF FINAL DIFFUSER LOCATIONS. 11. SEE ARCHITECTURAL AND STRUCTURAL DRAWINGS FOR BUILDING DETAILS AND DIMENSIONS. COORDINATE PLACEMENT OF MECHANICAL SYSTEMS WITH ARCHITECTURAL AND STRUCTURAL TRADES.
- 12. PENETRATIONS THOROUGH UL RATED ASSEMBLIES, FIRE AND SMOKE WALLS. COORDINATE WITH GENERAL CONTRACTOR. 14.
- 15. CLOSELY COORDINATE FINAL LOCATIONS OF INSTALLED EQUIPMENT TO ACHIEVE THE GREATEST ACCESSIBILITY FOR MAINTENANCE PURPOSES. 16. CONTRACTOR SHALL VISIT THE SITE TO ESTABLISH THE EXISTING CONDITIONS PRIOR TO DUCT, PIPE OR EQUIPMENT FABRICATION. SYSTEMS SHALL BE ERECTED USING FIELD MEASUREMENTS FOR COORDINATION WITH THE EXISTING EQUIPMENT, STRUCTURE, FIRE PROTECTION AND ELECTRICAL IN THE SPACE. 17. CORE DRILL ALL PIPING PENETRATIONS OF CONCRETE WALLS AND FLOORS.
- 18. CONTRACTOR SHALL FIELD VERIFY ALL PIPE ROUTING AND ADJUST ELEVATIONS AS REQUIRED TO AVOID CONFLICTS. FINAL PLACEMENT OF PIPING SHALL BE DETERMINED BY FIELD MEASUREMENT AND VERIFICATION. ELEVATIONS ARE REFERENCED TO PIPE CENTERLINE UNLESS OTHERWISE NOTED. 19. ALL EQUIPMENT, DEVICES, AND FIXTURES SHALL BE INSTALLED AS PER MANUFACTURER'S RECOMMENDATION.
- CONTRACTOR SHALL VERIFY CLOSELY AT SITE TRANSPORTATION OF NEW HVAC EQUIPMENT INTO MECHANICAL AREAS BEFORE BIDDING. PROVIDE COMPLETE DISASSEMBLY AND RE-ASSEMBLY 20. OF NEW EQUIPMENT AS REQUIRED FOR A COMPLETE INSTALLATION. 21. PROVIDE FLEXIBLE CONNECTIONS AND TRANSITIONS ON DUCT INLET AND OUTLET CONNECTIONS TO ALL EQUIPMENT WITH MOVING PARTS.
- 22. NOT ALL REQUIRED PIPING, VALVES, OR FITTINGS ARE SHOWN ON DRAWINGS FOR CLARITY. COORDINATE PLAN DETAILS WITH SPECIFICATIONS, SCHEMATICS, FLOW DIAGRAMS, AND OTHER DETAILS TO PROVIDE COMPLETE PIPING SYSTEMS.
- PROVIDE SPARE PIPE WELL ADJACENT TO EACH TEMPERATURE SENSOR IN PIPING.
- DEVICES WITH MOUNTING SYSTEM DESIGNED FOR MOUNTING SURFACE TYPE. REQUIRED TO BE MOUNTED ON AN EXTERIOR WALL SHALL BE MOUNTED ON AN INSULATED PAD.
- 26. PROVIDE CONCRETE PADS FOR ALL GROUND MOUNTED EQUIPMENT.
- 27. REPLACE ALL ARCHITECTURAL FEATURES REMOVED OR DAMAGED DURING THE COURSE OF THE WORK. 28. CONTRACTOR SHALL PATCH ALL WALLS, FLOORS, AND CEILINGS TO MATCH NEW FOR ALL OPENINGS CREATED BY INSTALLATION OF EQUIPMENT AND HVAC SERVICE PENETRATIONS.
- 29. REFER TO SPECIFICATION SHEET FOR INSULATION AND R-VALUES FOR MECHANICAL PIPING AND DUCTWORK INSULATION.
- ALL CONTROL WIRING SHALL BE INSTALLED IN CONDUIT. 31. 32. PROVIDE ALL HVAC UNITS WITH AN EXTRA SET OF MANUFACTURER'S RECOMMENDED FILTERS AFTER PROJECT COMPLETION.

DEMOLITION/RENOVATION GENERAL NOTES

- 1. DEMOLITION DRAWINGS FOR ADDITIONAL INFORMATION AND DEMOLITION SCOPE OF WORK.
- ALL DEMOLITION WORK SHALL BE SCHEDULED WITH THE OWNER'S REPRESENTATIVE AT LEAST 48 HOURS PRIOR TO THE WORK.
- PATCH ALL OPENINGS IN WALLS, FLOORS, AND CEILINGS WHERE DUCT, PIPING, AND CONTROLS HAVE BEEN REMOVED TO MATCH EXISTING CONTRACTOR TO THE SATISFACTION OF THE OWNER AND ENGINEER WITHOUT ADDITIONAL COST TO THE OWNER. MAINTAIN THE SECURITY OF THE BUILDING AT ALL TIMES.
- REMOVE ALL EXISTING SUPPORTS ASSOCIATED WITH EQUIPMENT, DUCTWORK, AND PIPE BEING REMOVED UNLESS NOTED OTHERWISE. 7.
- 8. DISPOSE OF ALL REMOVED EQUIPMENT AS DIRECTED BY THE OWNER. CONTRACTOR SHALL COORDINATE REMOVAL OF UTILITY SERVICES WITH UTILITY COMPANIES AND LOCAL AUTHORITIES AND PAY ALL FEES. 9.
- SCHEDULE UTILITY WORK WITH OWNER TO KEEP TO A MINIMUM ACCEPTABLE DOWNTIME AND TO NOT INTERFERE WITH THE BUILDING OPERATIONAL SCHEDULE, IF POSSIBLE. 10.
- 11. MAINTAIN THE FIRE AND SMOKE CONSTRUCTION INTEGRITY OF THE EXISTING BUILDINGS. 12. DO NOT VENT REFRIGERANT TO ATMOSPHERE. RECOVER REFRIGERANT FOR REUSE USING ASHRAE RECOMMENDED PROCEDURES.
- THE ARCHITECT. DEMOLITION AND SHUTDOWN OF EXISTING HVAC SYSTEMS THAT WILL AFFECT PORTIONS OF THE BUILDING OUTSIDE OF PROJECT AREA SHALL BE COORDINATED WITH OWNER'S 14.
- WORK REQUIRED IN OCCUPIED AREAS OUTSIDE OF THE FLOOR AREA SHALL BE SCHEDULED WITH THE OWNER 48 HOURS IN ADVANCE.
- WITH STRUCTURAL DRAWINGS.
- REPRESENTATIVE IMMEDIATELY.
- 17. PHASE DEMOLITION AND RENOVATION WORK TO MAINTAIN EXISTING BUILDING AS REQUIRED BY BUILDING OWNER/OCCUPANTS, PROVIDE TEMPORARY SERVICES AS REQUIRED.
- ALL CONNECTIONS TO EXISTING SYSTEMS AND SYSTEM SHUT-DOWNS WITH OWNER'S REPRESENTATIVE.
- SATISFACTION OF THE OWNER WITHOUT ADDITIONAL COST TO THE OWNER.

ALL MECHANICAL WORK SHALL COMPLY WITH ALL LOCAL CODES, DRAWINGS, SPECIFICATIONS, AND AUTHORITIES HAVING JURISDICTION. IF DISCREPANCIES ARE FOUND, THE MOST STRINGENT REQUIREMENT SHALL GOVERN WORK. WHERE INSPECTIONS ARE REQUIRED BY AUTHORITIES HAVING JURISDICTION, WORK MUST NOT BE CONCEALED UNTIL INSPECTIONS AND

PRIOR TO BID, CONTRACTOR SHALL BECOME THOROUGHLY FAMILIAR WITH THE REQUIREMENTS OF THESE NOTES AS WELL AS OTHER NOTES SHOWN ON THE CONTRACT DOCUMENTS. THESE DRAWINGS REFLECT A SYSTEM DESIGNED AROUND SPECIFIED REFERENCE PRODUCTS, THE SELECTION OF WHICH HAS INFLUENCED THE DESIGNS OF OTHER TRADES. IF SUBSTITUTE MANUFACTURERS, SIZES, OR MODEL NUMBERS ARE BID OR SUBMITTED, IT IS THE RESPONSIBILITY OF THE CONTRACTOR TO COORDINATE ALL DIFFERENCES PRIOR TO BID. ALL COSTS OF ALL

COORDINATION OF ALL MODIFICATIONS TO EACH DISCIPLINE WHICH RESULT FROM SUBSTITUTION OF EQUIPMENT OR MATERIALS SHALL BE THE RESPONSIBILITY OF THE CONTRACTOR. SUBSTITUTIONS WHICH ARE INSTALLED AND SUBSEQUENTLY ARE PROVEN UNSATISFACTORY BY OWNER AND/OR ENGINEER WITHIN THE WARRANTY PERIOD, SHALL BE REMOVED COMPLETELY BY ALL DRAWINGS ARE DIAGRAMMATIC AND INDICATE THE GENERAL ARRANGEMENTS OR GEOMETRICAL RELATIONSHIPS OF EQUIPMENT AND SERVICES. THEY ARE NOT INTENDED TO SPECIFY OR

INFORMATION AND COMPONENTS ON DETAILS OR IN SPECIFICATIONS, BUT NOT SHOWN ON PLANS, AND VICE VERSA, SHALL BE PROVIDED AS IF EXPRESSLY REQUIRED BY BOTH. CONTRACTOR SHALL NOT SCALE DRAWINGS. DRAWINGS SPECIFIC TO THIS DISCIPLINE DO NOT LIMIT THE RESPONSIBILITY OF WORK REQUIRED BY THE CONTRACT DOCUMENTS. EXACT LOCATIONS OF ALL EQUIPMENT, ROOF CURBS, DUCTS, DIFFUSERS, AND PIPING SHALL BE COORDINATED WITH OTHER TRADES. CEILING MOUNTED SPRINKLER, LIGHTING, AND ELECTRICAL REQUIREMENTS TAKE PRECEDENCE OVER CEILING MOUNTED MECHANICAL REQUIREMENTS. SEE ARCHITECTURAL REFLECTED CEILING PLANS FOR CEILING GRID AND LIGHTING

CONTRACTOR SHALL BE RESPONSIBLE FOR COORDINATING ALL WORK WITH THAT OF OTHER TRADES. REFER TO ALL CONSTRUCTION DOCUMENTS FOR COMPLETE INFORMATION PRIOR TO BID. 13. ALL MECHANICAL CONSTRUCTION DETAILS SHALL BE AS SHOWN AND AS REQUIRED TO MAINTAIN "UL" ASSEMBLY RATINGS AS SHOWN ON ARCHITECTURAL SHEETS. SEAL AROUND ALL NO OTHER TRADES, I.E., ELECTRICAL, CEILING, PLUMBING, OR OTHER SYSTEMS SHALL BE SUSPENDED, HUNG, OR SUPPORTED FROM DUCTWORK OR PIPING.

23. COORDINATE WORK CLOSELY WITH CONTROL REQUIREMENTS. PROVIDE ALL NECESSARY DUCT TAPS, PIPE TAPS, WELLS, AND OTHER APPURTENANCES REQUIRED BY CONTROL SYSTEM.

24. REFER TO ARCHITECTURAL PLANS FOR CEILING GRILLE AND DIFFUSER LOCATIONS, FOR CEILING TYPE, AND FOR MOUNTING REQUIREMENTS. CONTRACTOR SHALL PROVIDE AND INSTALL ALL AIR

25. COORDINATE FINAL PLACEMENT OF ALL THERMOSTATS WITH WALL-MOUNTED DEVICES AND OWNER'S REPRESENTATIVE. MOUNT PER A.D.A. REQUIREMENTS. ANY THERMOSTAT THAT IS

30. ALL HVAC COMPONENTS WITH ELECTRICAL REQUIREMENTS SHALL BE INSTALLED WITH ELECTRICAL INFRASTRUCTURE NECESSARY TO PROVIDE A FULLY FUNCTIONING SYSTEM. IF NOT SPECIFICALLY SHOWN ON ELECTRICAL SCHEDULE, HVAC FIXTURES REQUIRING ELECTRICAL SERVICE SHALL BE FED FROM BREAKER OF ADEQUATE CAPACITY.

THE MECHANICAL RELATED DEMOLITION WORK INDICATED ON THE PLANS, SPECIFICATIONS, AND NOTES IS TO BE CLOSELY COORDINATED WITH THE OWNER'S REPRESENTATIVE. NO DEMOLITION SHALL TAKE PLACE IN ANY AREA OR BUILDING UNTIL THE CONTRACTOR HAS BEEN GIVEN APPROVAL TO PROCEED IN THAT SPECIFIC LOCATION. REFER TO ARCHITECTURAL IF, DURING DEMOLITION, IT BECOMES NECESSARY TO TEMPORARILY REMOVE ANY EQUIPMENT, PIPING, OR OTHER SYSTEM WHICH IS NOT SPECIFICALLY NOTED TO BE REMOVED (THEREBY

IMPLYING THAT THEY ARE TO BE LEFT FOR FUTURE USE), THE CONTRACTOR SHALL REINSTALL SAID SYSTEMS TO FULLY OPERABLE CONDITION IN THEIR ORIGINAL LOCATIONS.

ANY DAMAGE TO THE OWNER'S PROPERTY, BUILDING, EXISTING SYSTEMS, OR EQUIPMENT RESULTING FROM THE CONTRACTOR'S OPERATIONS SHALL BE REPAIRED OR REPLACED BY THE


13. EXISTING EQUIPMENT SHALL BE RELOCATED AS NECESSARY FOR THE INSTALLATION OF THE NEW SYSTEMS. METHODS AND POSITIONS OF THE RELOCATIONS SHALL HAVE PRIOR APPROVAL OF

REPRESENTATIVE AND PLANNED TO LIMIT INCONVENIENCE AND DISRUPTION OF BUILDING OPERATIONS AS MUCH AS POSSIBLE. WORK SHALL BE PHASED ACCORDINGLY. PLUMBING OR HVAC 15. THE EQUIPMENT LOCATIONS SHOWN ON THE DRAWINGS ARE APPROXIMATE. THE FINAL LOCATIONS SHALL BE ESTABLISHED IN THE FIELD TO BEST FIT THE AVAILABLE SPACE. COORDINATE

16. INSPECT THE EXISTING SYSTEM; ANY EXISTING EQUIPMENT, DUCTS, OR PIPING FOUND TO BE DAMAGED OR NON-OPERABLE SHALL BE BROUGHT TO THE ATTENTION OF THE OWNER'S

18. WORK REQUIRED IN THE AREAS OUTSIDE OF THE FLOOR AREA FOR PLUMBING OR HVAC WORK SHALL BE SCHEDULED WITH THE OWNER 48 HOURS IN ADVANCE. COORDINATE AND SCHEDULE 19. ANY DAMAGE TO THE EXISTING BUILDING, STRUCTURE, FINISHES, OR ARCHITECTURAL FEATURES CAUSED BY THE CONTRACTOR'S OPERATIONS SHALL BE REPAIRED OR REPLACED TO THE

REVICES AND CONTRACT OF CONT C
Project Name Property State Property State
ISSUE DATE August 26, 2022 REVISIONS 1 10/28/22 REBID
SHEET CONTENTS: MECHANICAL NOTES AND LEGEND

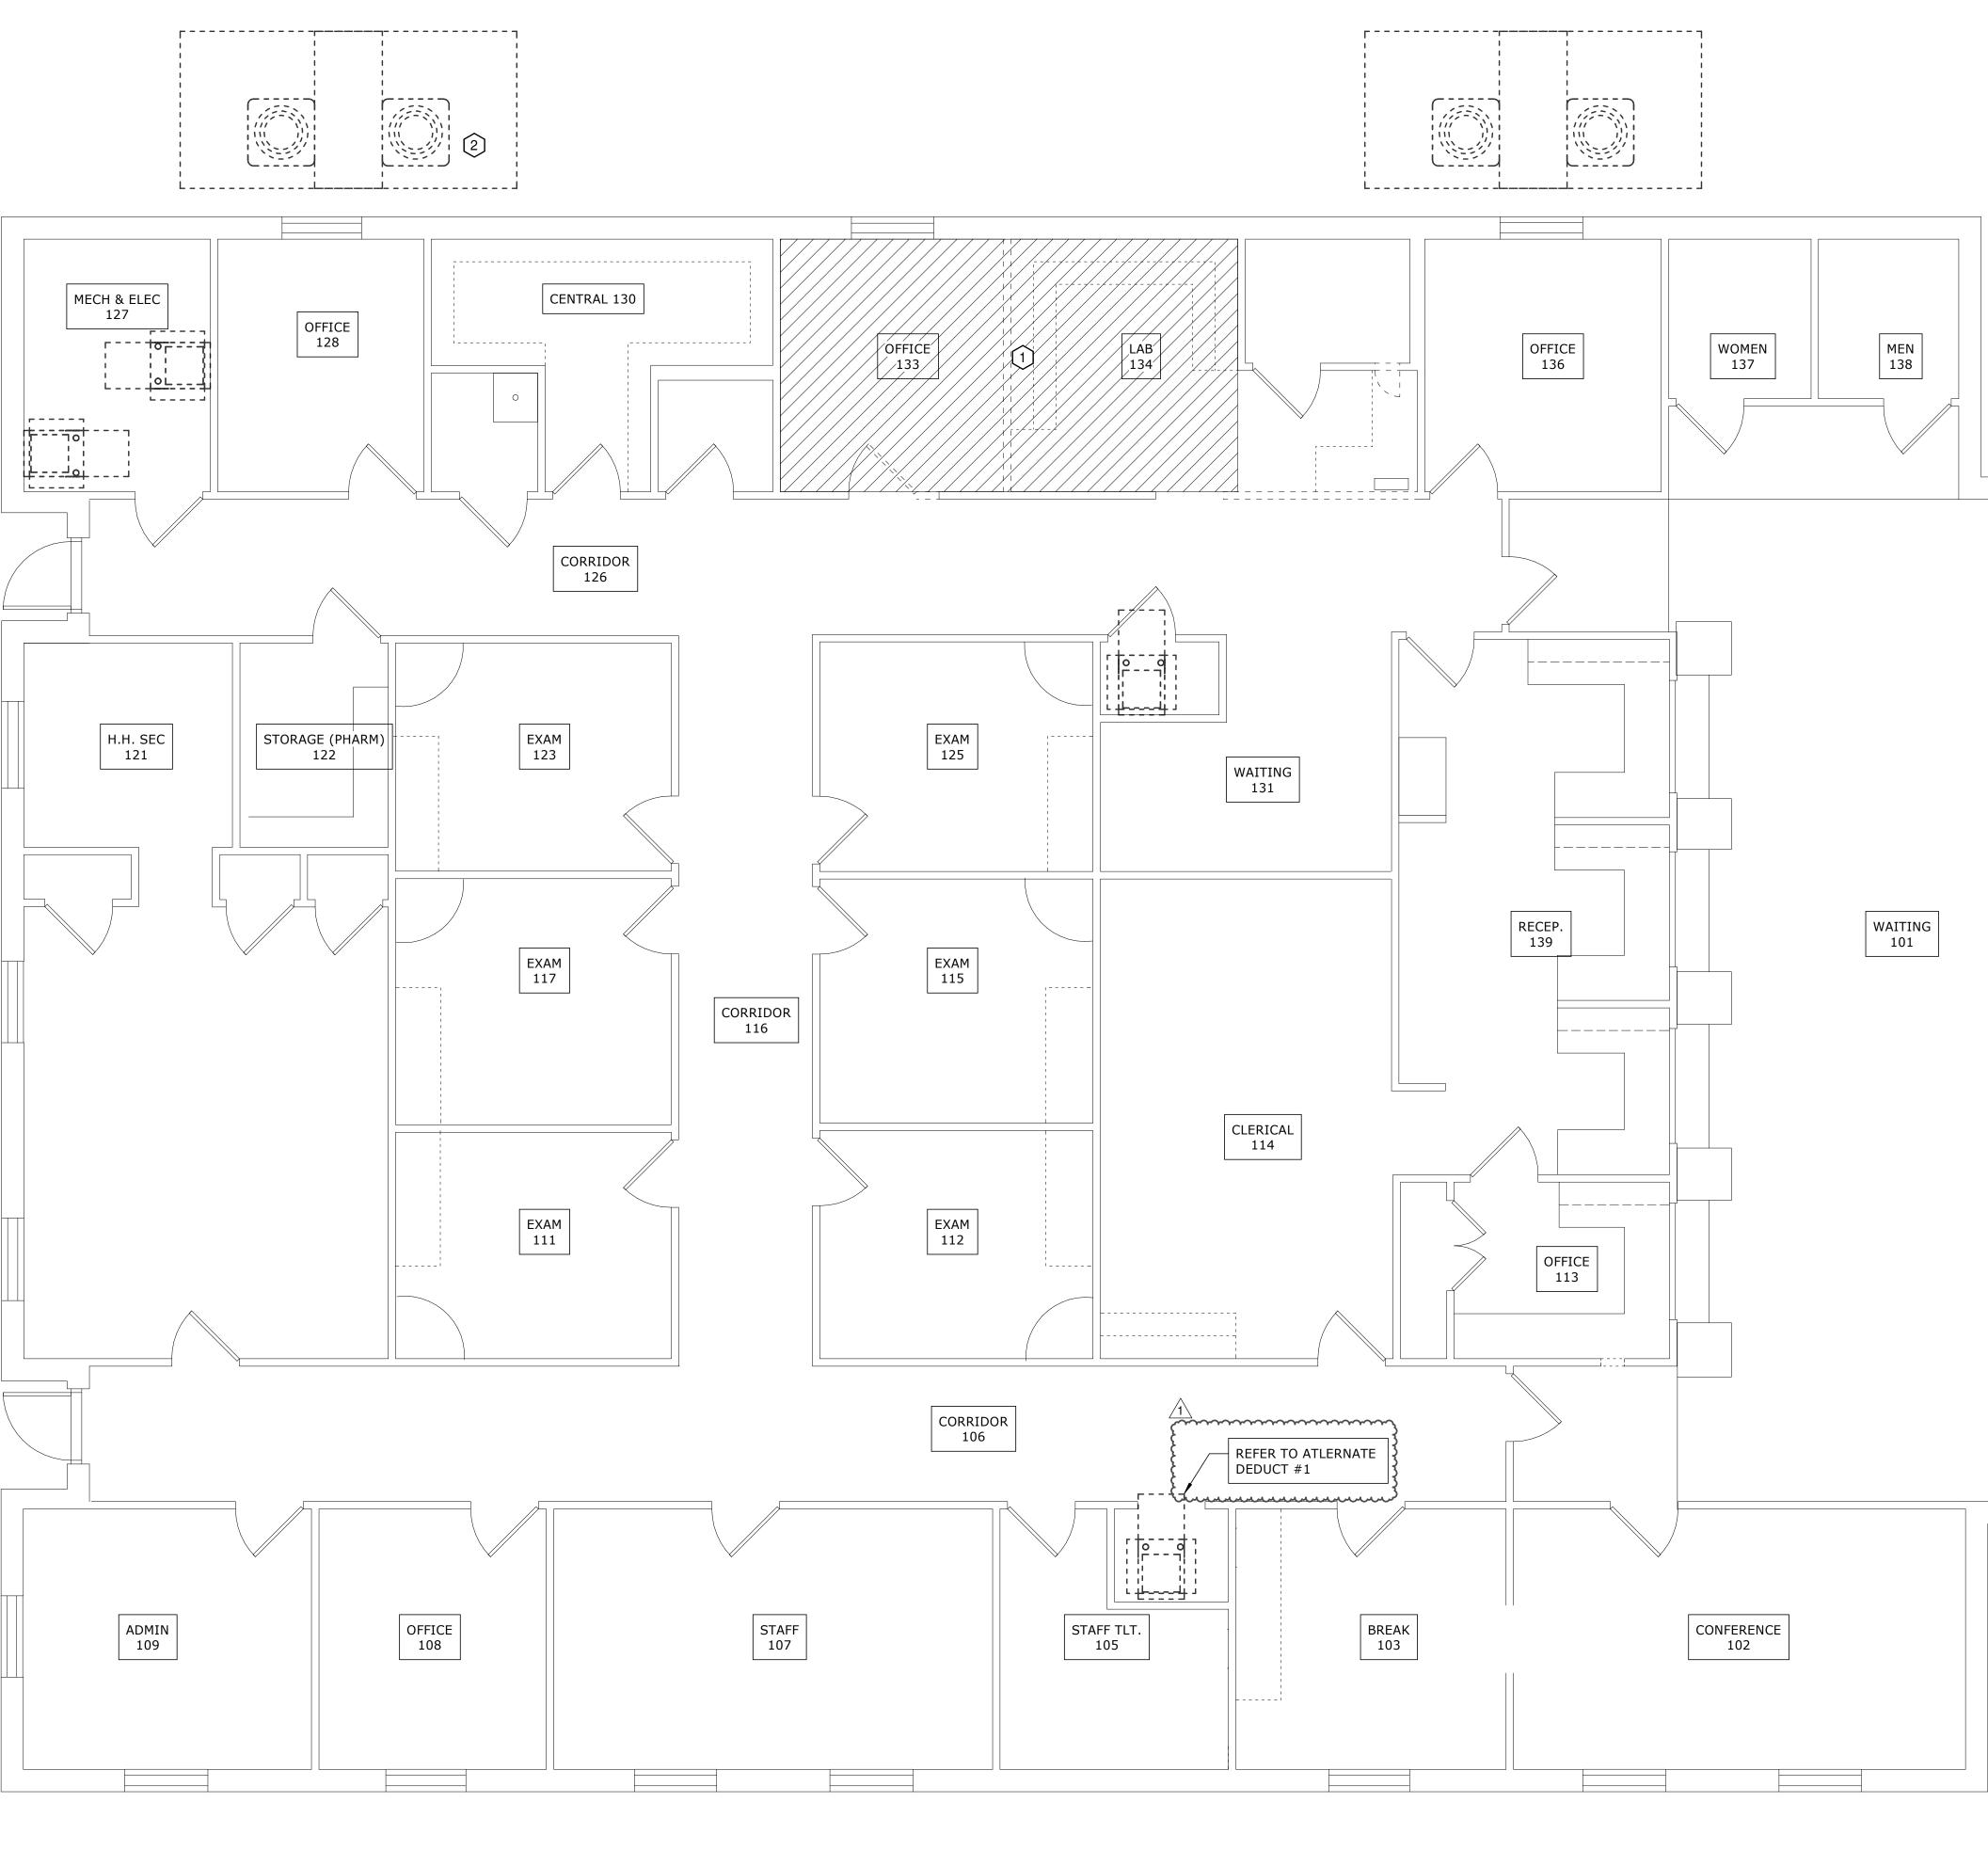



GENERAL NOTES


1. REMOVE COMPLETE EXISTING CONDENSING UNITS AND FURNACES. REMOVE ALL ASSOCIATE CONTROL WIRING, THERMOSTATS, REFRIGERANT PIPING. ALL DUCTWORK AND PLENUMS SHALL REMAIN. CAP EXISTING NATURAL GAS LINES FEEDING FURNACE UNIT.

KEYED NOTES

1.

AREA TO BE SERVED BY NEW EQUIPMENT. REMOVE AIR TERMINALS AND ASSOCIATED BRANCH DUCTWORK BACK TO MAIN. CAP EXISTING DUCTWORK AT DUCT MAIN. 2. EXISTING EQUIPMENT TO BE DEMOLISHED, TYPICAL ALL.

 \square \rightarrow Ш Ţ ΓΤΊ \cup \mathbf{X} \triangleleft K ARKANSA PROFESSIONAL ENGINEER 8-26-25-25-14 No. 20514 TR Alex Trulove, PE MEP Consulting alex@truengineering.net 501-993-7149 708 N Charles St Searcy, AR 72143 II OF AUT TRU ENGINEERING, LLC No. 6608 RKANSA Units Health \sum ount \bigcirc Mississippi Osceola ISSUE DATE August 26, 2022 REVISIONS 10/28/22 REBID Ζ \triangleleft Ы \bigcirc A DEMO HVA OSCEOLA SHEET NO. OM-I.I

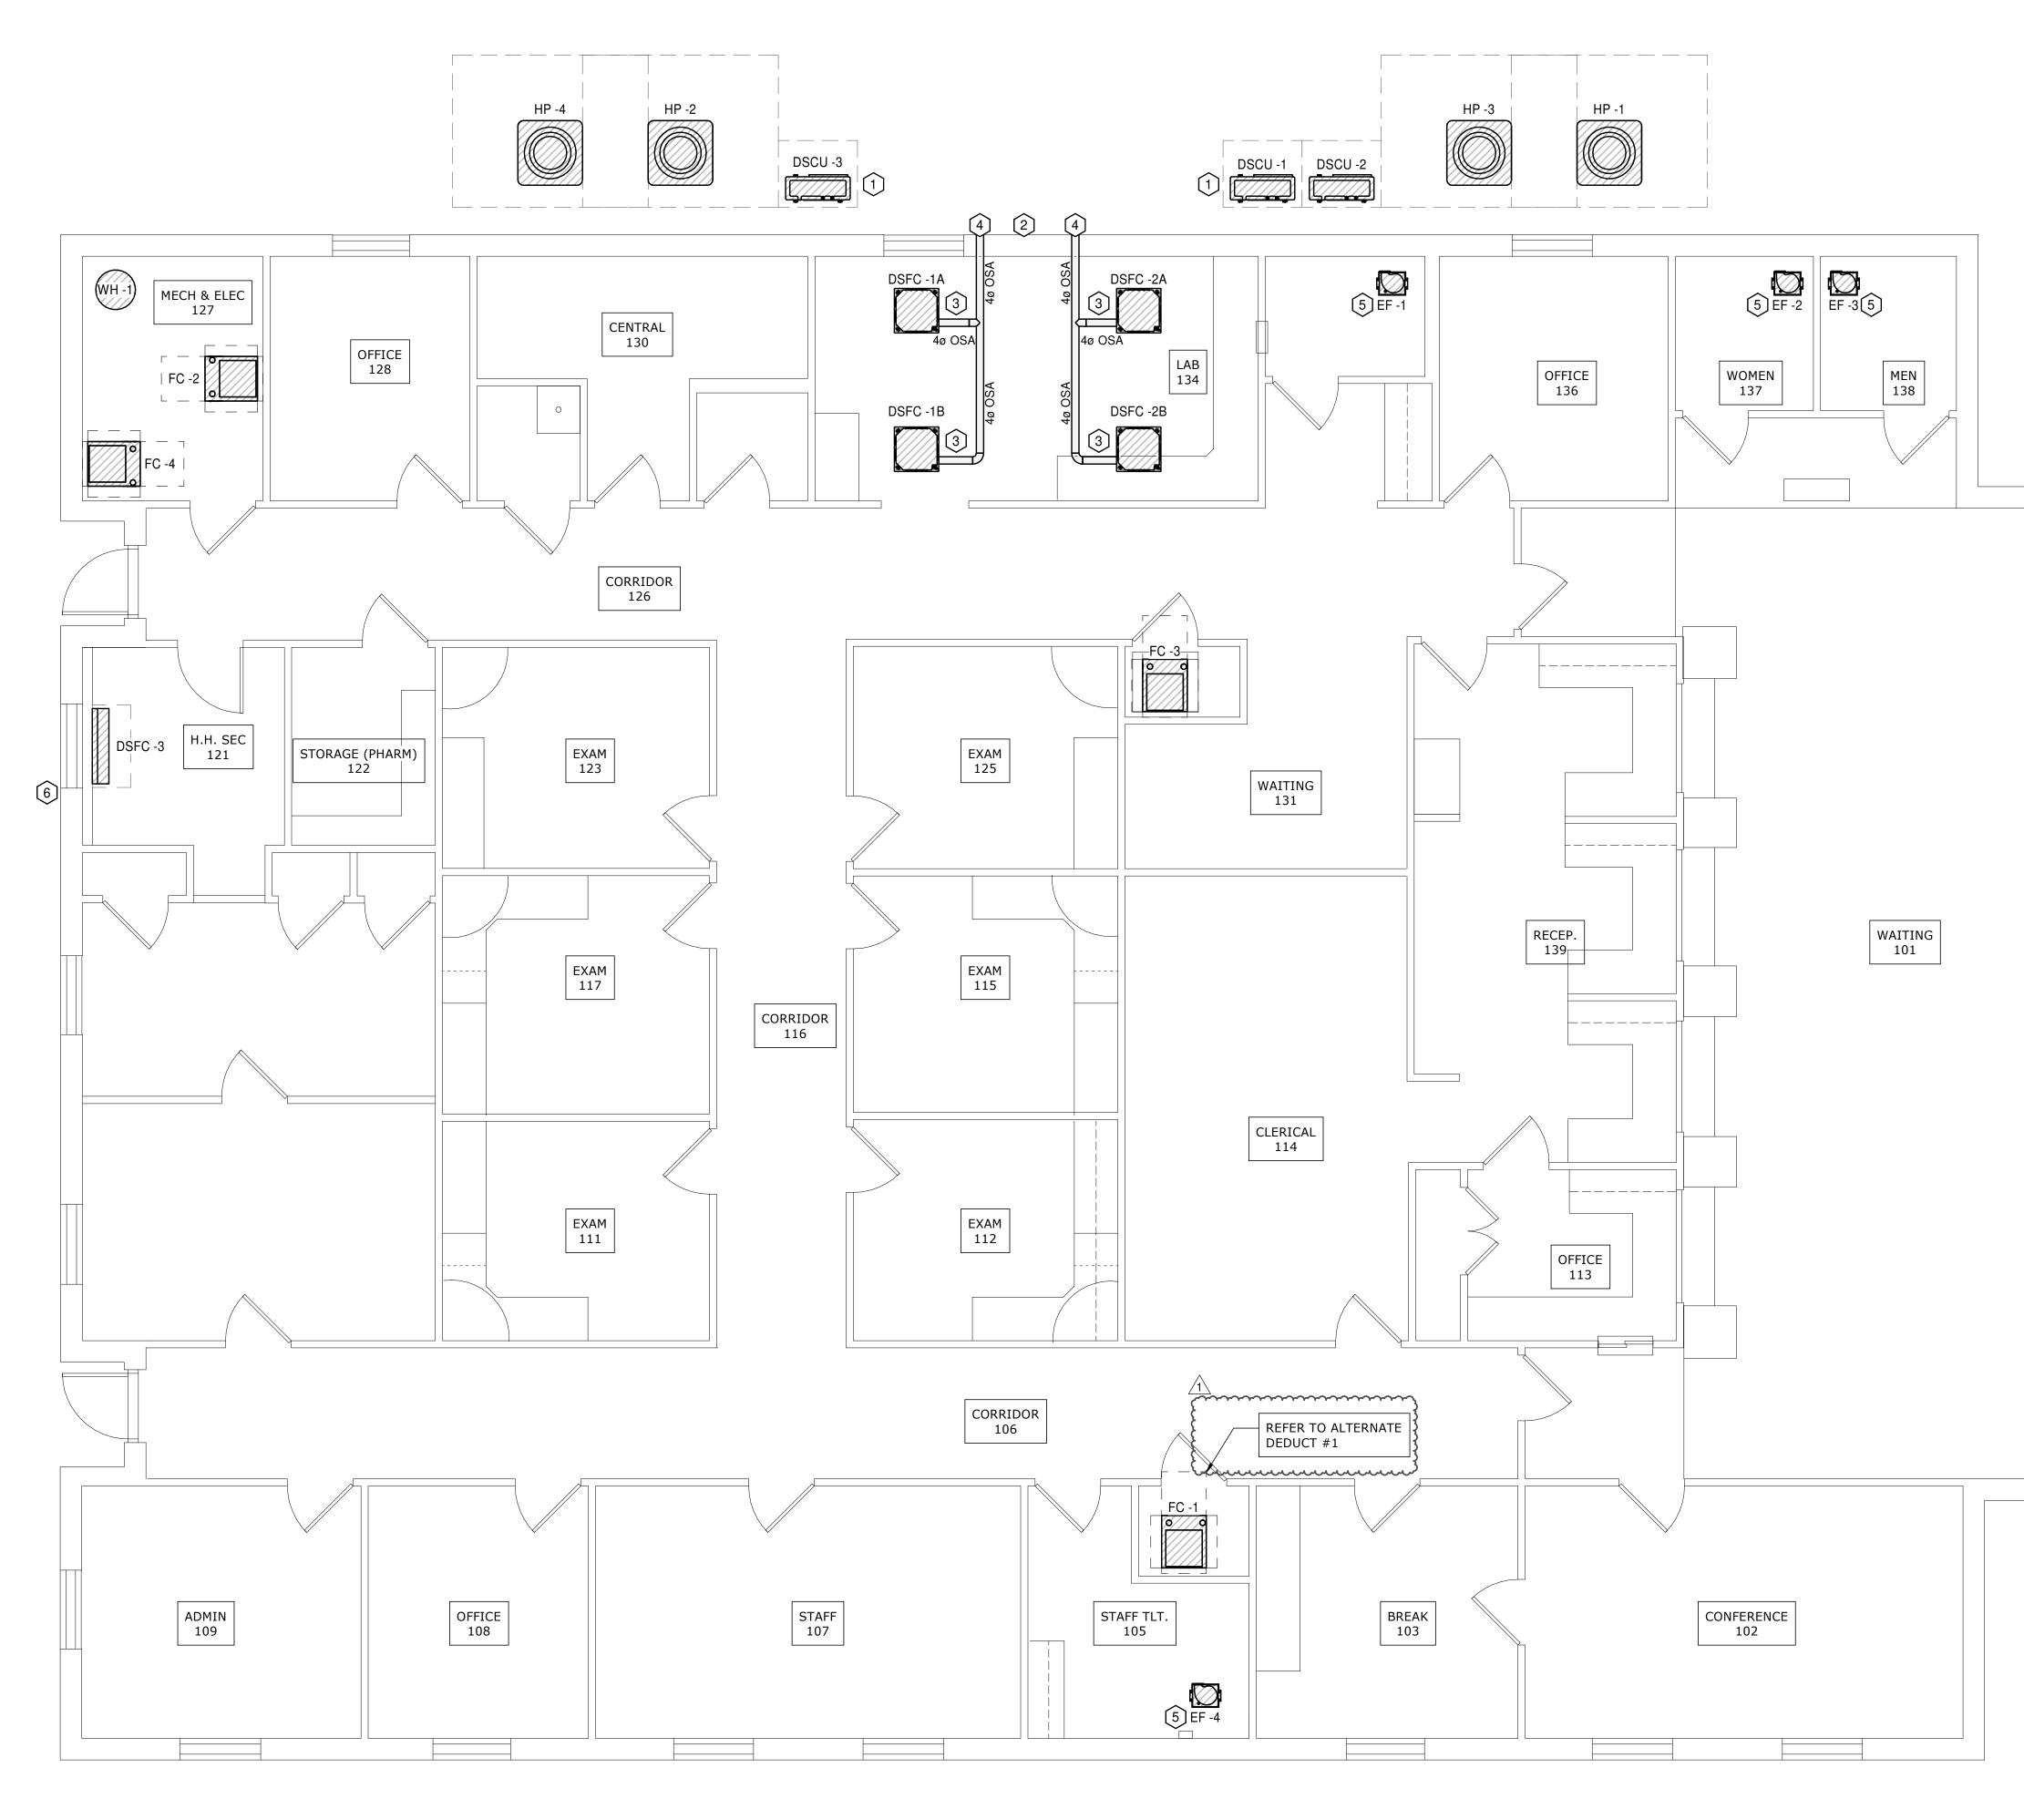



CONTROL NOTES


ALL CONTROLS SHALL BE STAND-ALONE. THERMOSTATS SHALL BE PER EQUIPMENT MANUFACTURER'S RECOMMENDATION, 7-DAY PROGRAMMABLE, WALL-MOUNTED (NON-REMOTE), AND WI-FI ACCESSIBLE. THERMOSTAT SHALL BE INITIALLY SET TO READ OFF OF RETURN DUCT TEMPERATURE SENSOR.


<u>GENERAL NOTES</u>

- . NEW UNIT CONDENSATE SHALL DISCHARGE TO EXISTING
- DRAIN LOCATIONS.
 2. NEW THERMOSTATS SHALL BE MOUNTED NEXT TO LIGHT SWITCH OF ASSOCIATED ROOM. TOP OF THERMOSTAT SHALL BE ALIGNED WITH TOP OF LIGHT SWITCH FACE PLATE.

KEYED NOTES

- 1. PROVIDE NEW 4" CONCRETE SERVICE PAD FOR MINI-
- SPLIT CONDENSERS.
 2. ROUTE DSFC CONDENSATE TO 1" GRAVITY MAIN IN ATTIC SPACE. GRAVITY MAIN SHALL BE ROUTED TO EXTERIOR WALL, ROUTED DOWN INSULATED SIDE OF WALL, AND DISCHARGE TO LANDSCAPED AREA 18" ABOVE GRADE.
- 3. ROUTE NEW OSA DUCTWORK IN ATTIC TO SOFFIT AND TERMINATE WITH SOFFIT VENT WITH INSECT SCREEN EQUAL TO COOK. PAINT PER ARCHITECT.
- BALANCE TO 15 CFM.
 REPLACE EXISTING EXHAUST FAN WITH NEW. NEW EXHAUST FAN TO CONNECT TO EXISTING EXHAUST DUCTWORK.
- 6. ROUTE DSFC CONDENSATE THROUGH WALL DOWN INSULATED SIDE OF EXTERIOR WALL AND DISCHARGE 18" ABOVE GRADE TO LANDSCAPED AREA.

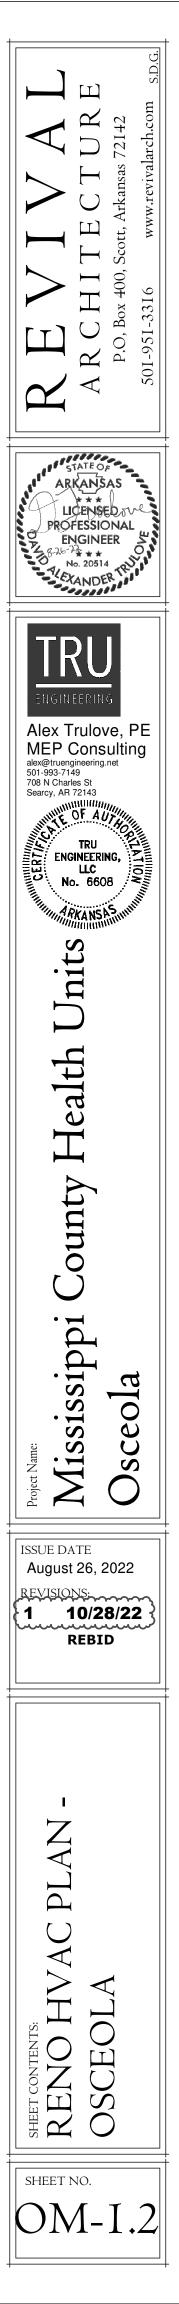

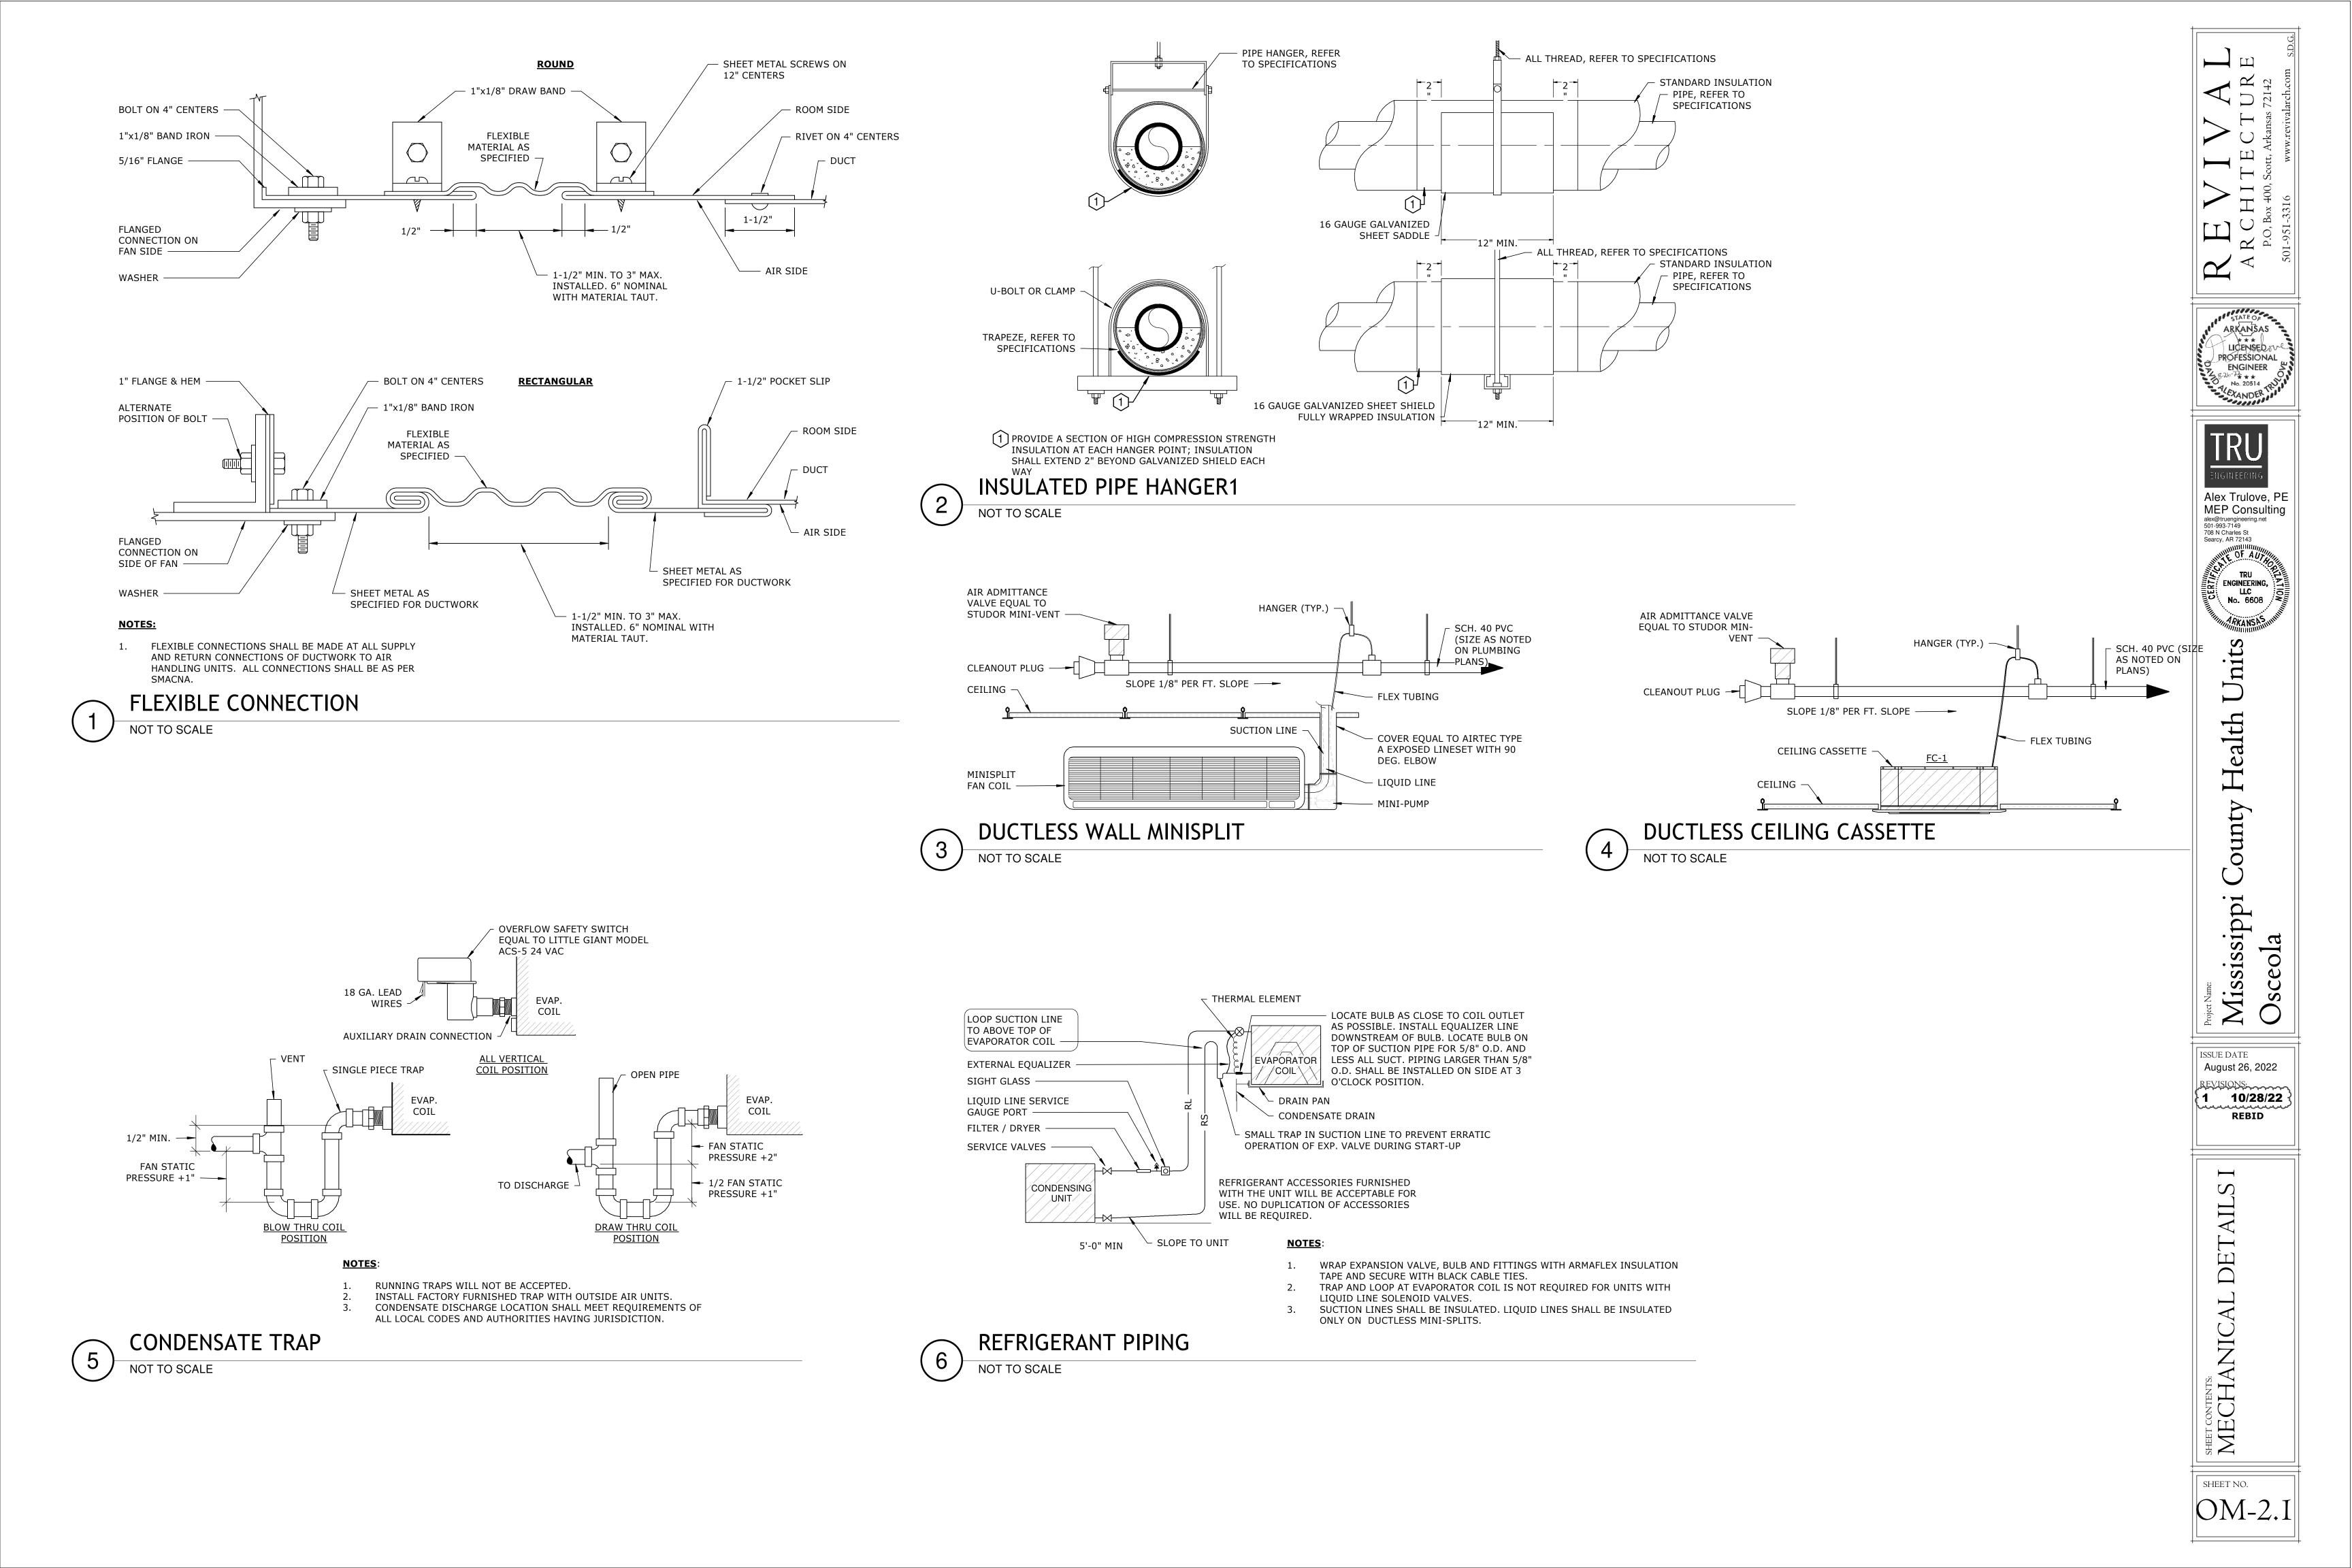

DESIG	NATION					HEATING	ELECTRIC
TYPE	MARK	DESCRIPTION	MANUFACTURER	MODEL	NOMINAL	TYPE	VOLTAGE
FC	1	MULTIPOSITION FAN COIL	SAMSUNG	AC054KNZDCH	4.5 ton	HEAT PUMP	240 V
FC	2	MULTIPOSITION FAN COIL	SAMSUNG	AC036KNZDCH	3.0 ton	HEAT PUMP	240 V
FC	3	MULTIPOSITION FAN COIL	SAMSUNG	AC054KNZDCH	4.5 ton	HEAT PUMP	240 V
FC	4	MULTIPOSITION FAN COIL	SAMSUNG	AC054KNZDCH	4.5 ton	HEAT PUMP	240 V
	NATION				NOMINAL		ELECTR
TYPE	MARK	DESCRIPTION	MANUFACTURER	MODEL	CAPACITY	VOLTAGE	PHASE
	1	VARIABLE SPEED HEAT PUMP		AC054KXADCH	4.5 ton	240 V	1
HP		VARIABLE SPEED HEAT PUMP	SAMSUNG	AC036BXADCH	3.0 ton	240 V	1
HP	2						
	2 3	VARIABLE SPEED HEAT PUMP	SAMSUNG	AC054KXADCH	4.5 ton	240 V	1

			HVAC D	DUCTLESS S	PLIT FAN CO		ULE - OS	CEOLA	
DESIG	NATION				COOLIN	G DATA	ELECTRIC	AL DATA	
TYPE	MARK	DESCRIPTION	MANUFACTURER	MODEL	MAX SUPPLY AIR	TOTAL COOLING	VOLTAGE	PHASE	REMARKS
DSFC	1A	1.5 TON CEILING CASSETTE	SAMSUNG	AC018BNNDCH	400 CFM	18,000 Btu/h	240 V	1	INDOOR UNIT SHALL BE POWERED THROUGH OUTDOOR UNIT
DSFC	1B	1.5 TON CEILING CASSETTE	SAMSUNG	AC018BNNDCH	400 CFM	18,000 Btu/h	240 V	1	INDOOR UNIT SHALL BE POWERED THROUGH OUTDOOR UNIT
DSFC	2A	1.5 TON CEILING CASSETTE	SAMSUNG	AC018BNNDCH	400 CFM	18,000 Btu/h	240 V	1	INDOOR UNIT SHALL BE POWERED THROUGH OUTDOOR UNIT
DSFC	2B	1.5 TON CEILING CASSETTE	SAMSUNG	AC018BNNDCH	400 CFM	18,000 Btu/h	240 V	1	INDOOR UNIT SHALL BE POWERED THROUGH OUTDOOR UNIT
DSFC	3	12 MBH WALL COIL UNIT	SAMSUNG	AR12TSFABWKNCV	600 CFM	12,000 Btu/h	240 V	1	INDOOR UNIT SHALL BE POWERED THROUGH OUTDOOR UNIT
	Н	VAC DUCTLESS S	1. P	ROVIDE WITH INTEGRAL CONDENSATE PUMP.					
DESIG	NATION				ELECTRICAL DATA				
TYPE	MARK	DESCRIPTION	MANUFACTURE	R MODEL	VOLTAGE PH	ASE MCA	MOCP		
DSCU	1	3 TON MULTI-SPLIT HEAT PUM	P SAMSUNG	AJ036BXJ4CH	240 V	1 26.0 A	30.0 A		
DSCU	2	3 TON MULTI-SPLIT HEAT PUM	P SAMSUNG	AJ036BXJ4CH	240 V	1 26.0 A	30.0 A		
DSCU	3	1.5 TON HEAT PUMP	SAMSUNG	AC018BXSCCC	240 V	1 12.0 A	15.0 A		

PROVIDE WITH LOW AMBIENT COOLING, HARD-START KIT, HAIL GUARDS, AND LOCAL DISCONNECT.

INDOOR AND OUTDOOR UNITS SHALL BE PROVIDED FROM SAME MANUFACTURER. 2. UNITS SHALL BE SELECTED AT AMBIENT CONDITIONS OF: 100 F DB AND 77 F WB. 3.

4. UNITS SHALL MEET CURRENT ENERGY CODE MINIMUM EFFICIENCY REQUIREMENTS.

	HVAC EXHAUST FAN SCHEDULE - OSCEOLA									
DESIG	NATION				EXTERNAL	ELECTRIC MOTOR DATA				
TYPE	MARK	MANUFACTUR ER	MODEL	EXHAUST AIR CFM	STATIC PRESSURE	MOTOR WATTS	VOLTAGE	PHASE	DRIVE	REMARKS
EF	1	СООК	GCVF	75 CFM	0.25 in-wg	150 W	120 V	1	DIRECT	INTERLOCK WITH LIGHTS IN ASSOCIATED ROOM
EF	2	СООК	GCVF	75 CFM	0.25 in-wg	150 W	120 V	1	DIRECT	INTERLOCK WITH LIGHTS IN ASSOCIATED ROOM
EF	3	СООК	GCVF	75 CFM	0.25 in-wg	150 W	120 V	1	DIRECT	INTERLOCK WITH LIGHTS IN ASSOCIATED ROOM
EF	4	СООК	GCVF	75 CFM	0.25 in-wg	150 W	120 V	1	DIRECT	INTERLOCK WITH LIGHTS IN ASSOCIATED ROOM

PROVIDE WITH SOLID STATE SPEED CONTROLLER, DISCHARGE BACKDRAFT DAMPER, ISOLATOR KIT, DISCONNECT SWITCH.
 PROVIDE WITH MANUFACTURER'S METAL GRILLE OPTION.
 EXHAUST FAN SHALL BE SUPPORTED BY STRUCTURE BY MEANS OF ALL THREAD RODS AND MANUFACTURER'S MOUNTING BRACKETS.
 EXHAUST FAN SHALL BE INTERLOCKED WITH LIGHTS IN ASSOCIATED ROOM.


~~~~~	~~~	~~~~~~	~~~~	~~~~~~~~~~~~~~~~~~~~~~~~~~~~~~~~~~~~~~~
OLA				
AL DATA				}
PHASE				REMARKS
1	IND	OOR UNIT SH	ALL BE	POWERED THROUGH OUTDOOR UNIT
1	IND	POWERED THROUGH OUTDOOR UNIT		
1	IND	OOR UNIT SH	ALL BE	POWERED THROUGH OUTDOOR UNIT
1	IND	OOR UNIT SH	ALL BE	POWERED THROUGH OUTDOOR UNIT
CAL DATA MCA 42.0 A 23.0 A 42.0 A 42.0 A		MOCP 70.0 A 35.0 A 70.0 A 70.0 A	1. 2. 3.	PROVIDE WITH 2" PLEATED FILTER BASE EQUAL TO EZ FILTER. PROVIDE WITH MINIMUM MERV 8 FILTERS. PROVIDE WITH EXTRA SET OF FILTERS AT TEST AND BALANCE AND AT PROJECT COMPLETION. PROVIDE WITH AUXILIARY DRAIN PAN WITH WET SWITCH TO DEENERGIZE UNIT UPON DETECTION OF WATER. PROVIDE WITH ELOSTOMERIC VIBRATION ISOLATION PADS EQUAL TO AMBER BOOTH. PADS SHALL BE INSTALLED PER MANUFACTURER'S RECOMMENDATIONS. UNIT SHALL BE SUPPORTED FROM ALL FOUR CORNERS.
			4.	PROVIDE WITH DISCONNECT SWITCH, REFER TO ELECTRICAL FOR COORDINATION.



		PLUMBING	LEGEND
BBREVIATION OR SYMBOL	DESCRIPTION	ABBREVIATION OR SYMBOL	DESCRIPTION
81 DCW 13	DOMESTIC COLD WATER	HHHHHHHH	FLEXIBLE PIPING
81 DHW 18	DOMESTIC HOT WATER	HHT	
81 DHMC 13	DOMESTIC HOT WATER RETURN	8	EXISTING PIPING TO REMAIN ( refer to line designation )
6 I ZZ I 3	SANITARY SEWER	<b>8</b>	EXISTING TO BE REMOVED
EI GW IB	SANITARY - GREASE WASTE	$\mathbf{e}$	( back to point indicated )
6 WA 13	SANITARY - ACID WASTE	8	CONNECT TO EXISTING
E SD 3	STORM DRAIN	<u>817 7 7 7 7 7 8 8 8 8 8 8 8 8 8 8 8 8 8 </u>	BELOW GRADE PIPING ( fine dash )
	VENT		· · · ·
<u>E G S</u>	NATURAL GAS	THREADED WATER	& GAS PIPING
8 i D i 3	CONDENSATE DRAIN		PIPE DOWN
VALVING		2	PIPE UP
			THREADED TEE DOWN
BFV BFV	BUTTERFLY VALVE (lever operator)		THREADED TEE UP
<b>•</b>	BUTTERFLY VALVE		BRANCH - BOTTOM OF PIPE
EFV BFV	(wheel operator)		BRANCH - TOP OF PIPE
GV GV	GATE VALVE	-	
	CHECK VALVE		90 DEGREE ELBOW
СНК СНК			45 DEGREE ELBOW
GB GB	GLOBE VALVE		
ST ST	STRAINER (Y-TYPE)		TEE
		ស	UNION

					PLUMBING	FIXTURE SCHEDU	LE - OSCEOLA					
									BRA	NCH CONNECT	ONS	
TAG	DESCRIPTION	MANUFACTURER	MODEL	ACCESSORIES	FAUCETS & FITTINGS	STOPS	TRAPS	MOUNTING	DCW	DHW	SS	REMARKS
P1	WATER CLOSET - FLUSH TANK - ADA	ZURN	Z5551-K	ADA ELONGATED SEAT	-	MCGUIRE COMMERCIAL	INTEGRAL	FLOOR	1/2"		4"	
P2A	WALL HUNG LAVATORY	ZURN	Z5310	GRID DRAIN	ZURN 831B4-XL	MCGUIRE COMMERCIAL	MCGUIRE COMMERCIAL	WALL	1/2"	1/2"	2"	MOUNT AT ADA HEIGHT
P2B	WALL HUNG LAVATORY	ZURN	Z5310	GRID DRAIN	KOHLER K-97031	MCGUIRE COMMERCIAL	MCGUIRE COMMERCIAL	WALL	1/2"	1/2"	2"	
Р3	SINK - ADA - SINGLE COMPARTMENT	ELKAY	LR2022	-	ZURN 831B4-XL	MCGUIRE COMMERCIAL	MCGUIRE COMMERCIAL	COUNTER	1/2"	1/2"	2"	
P4	KITCHEN SINK - SINGLE COMPARTMENT	ELKAY	DLRS332210	BADGER 5XP GARBAGE DISPOSAL	ZURN 831B4-XL	MCGUIRE COMMERCIAL	MCGUIRE COMMERCIAL	COUNTER	1/2"	1/2"	2"	
Р5	SINK - DOUBLE COMPARTMENT	ELKAY	3321	-	ZURN 831B4-XL	MCGUIRE COMMERCIAL	MCGUIRE COMMERCIAL	COUNTER	1/2"	1/2"	2"	
P6	DROP IN LAVATORY - OVAL	ZURN	Z5810	GRID DRAIN	KOHLER K-97031	MCGUIRE COMMERCIAL	MCGUIRE COMMERCIAL	COUNTER	1/2"	1/2"	2"	

			PLUMB	ING EQUIP	۳N
TAG	MARK	DESCRIPTION	MANUFACTURER	MODEL	Ν
WH	1	LIGHT COMMERCIAL TANK ELECTRIC WATER HEATER	AO SMITH	G12-FDT5040NVR	

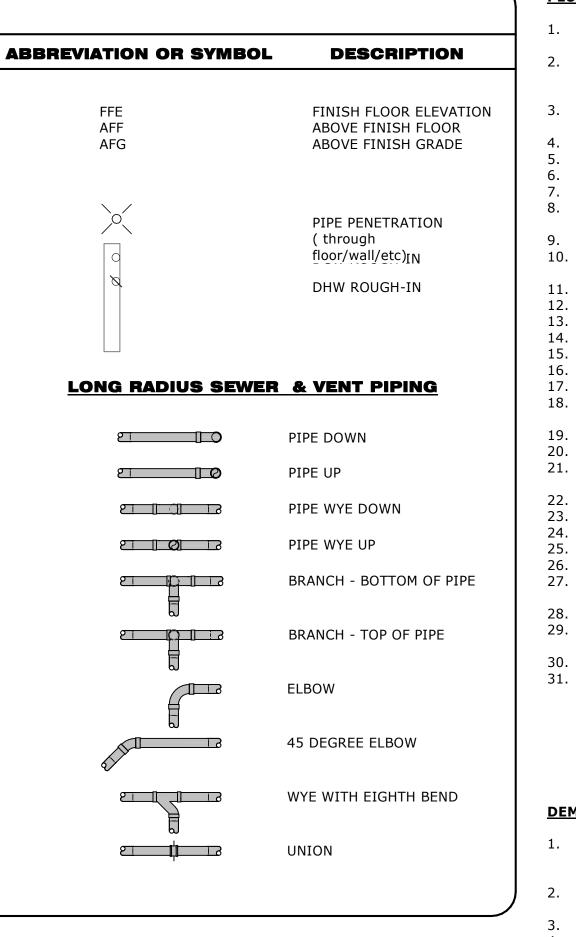


### **PLUMBING GENERAL NOTES:**


- REQUIREMENT SHALL GOVERN WORK.
- REFER TO PLUMBING SCHEDULES AND SPECIFICATIONS FOR BASIS OF DESIGN, ACCEPTABLE MANUFACTURERS, AND MODELS OF PLUMBING FIXTURES AND EQUIPMENT PROVIDE A TWO-WAY CLEANOUT AT THE JUNCTION OF ALL BUILDING DRAINS AND BUILDING SEWERS. REFER TO SPECIFICATIONS FOR INSULATION REQUIREMENTS.
- SANITARY LINE ELEVATIONS AND COORDINATE INSTALLATION TO ASSURE PROPER FLOW. SEAL ALL PIPE PENETRATIONS THROUGH WALLS, ROOF, AND FLOOR AIR AND WATER TIGHT. RECOMMENDATIONS FOR ALL FLOOR DRAINS.
- 15. MAINTAIN A MINIMUM OF 10' BETWEEN ALL HVAC FRESH AIR INTAKES AND PLUMBING VENTS. COORDINATE WITH MECHANICAL BEFORE INSTALLATION OF VTRs. 16. CONTRACTOR SHALL VISIT SITE AND VERIFY CONDITIONS PRIOR TO BIDDING.
- CONTRACTOR SHALL PAY ALL UTILITY FEES AND CHARGES IN THE CONTRACT.
- AND PLUMBING EQUIPMENT. 19. FIRE STOP ALL PIPE PENETRATIONS THROUGH RATED WALLS. REFER TO SPECIFICATIONS. PIPING SHALL NOT BE ROUTED OVER ELECTRICAL ROOMS, COMPUTER ROOMS, ELECTRICAL PANELS, OR ELECTRICAL EQUIPMENT UNLESS OTHERWISE NOTED.
- ROOM BELOW. 22. PAINT EXPOSED PIPING AND PIPE INSULATION. COORDINATE WITH OWNER FOR FINAL COLOR.
- 23. ALL UNDER FLOOR WATER PIPING SHALL BE PROVIDED WITH A POLYETHYLENE SLEEVE. EXTEND SLEEVE UP THROUGH FLOOR SLAB AND SEAL AIR AND WATER TIGHT. 24. PLASTIC PIPE IS PROHIBITED IN RETURN AIR PLENUMS. ALL PIPING AND PIPE CONNECTIONS IN RETURN AIR PLENUMS SHALL BE PLENUM RATED. 25. PIPING THROUGH FOUNDATION WALLS AND FOOTINGS SHALL BE SLEEVED AS PER STRUCTURAL DETAILS.
- 26. ALL PIPE CONNECTIONS BETWEEN DISSIMILAR METALS SHALL BE MADE THROUGH DIELECTRIC UNIONS. SPECIFICALLY SHOWN ON ELECTRICAL SCHEDULE, PLUMBING FIXTURES REQUIRING ELECTRICAL SERVICE SHALL BE FED FROM BREAKER OF ADEQUATE CAPACITY. 28. REFER TO PLUMBING SPECIFICATIONS FOR PIPE MATERIAL AND INSULATION REQUIREMENTS.
- MECHANICAL REQUIREMENTS. 30. PROVIDE FABRICATED EXPANSION LOOP OR MANUFACTURED EXPANSION DEVICE ON ALL PIPING SYSTEMS CROSSING BUILDING EXPANSION JOINTS.
- 31. WATER SUPPLY CONNECTIONS TO COFFEE MACHINES AND NONCARBONATED BEVERAGE DISPENSERS SHALL BE PROVIDED WITH A BACKFLOW PREVENTER OR AN AIR GAP.


## **DEMOLITION/RENOVATION GENERAL NOTES**

- 1. ADDITIONAL INFORMATION AND DEMOLITION SCOPE OF WORK.
- THEY ARE TO BE LEFT FOR FUTURE USE), THE CONTRACTOR SHALL REINSTALL SAID SYSTEMS TO FULLY OPERABLE CONDITION IN THEIR ORIGINAL LOCATIONS. ALL DEMOLITION WORK SHALL BE SCHEDULED WITH THE OWNER'S REPRESENTATIVE AT LEAST 48 HOURS PRIOR TO THE WORK. PATCH ALL OPENINGS IN WALLS, FLOORS, AND CEILINGS WHERE DUCT, PIPING, AND CONTROLS HAVE BEEN REMOVED TO MATCH EXISTING. THE SATISFACTION OF THE OWNER AND ENGINEER WITHOUT ADDITIONAL COST TO THE OWNER.
- MAINTAIN THE SECURITY OF THE BUILDING AT ALL TIMES. REMOVE ALL EXISTING SUPPORTS ASSOCIATED WITH EQUIPMENT, DUCTWORK, AND PIPE BEING REMOVED UNLESS NOTED OTHERWISE. DISPOSE OF ALL REMOVED EQUIPMENT AS DIRECTED BY THE OWNER.
- CONTRACTOR SHALL COORDINATE REMOVAL OF UTILITY SERVICES WITH UTILITY COMPANIES AND LOCAL AUTHORITIES AND PAY ALL FEES. 11. MAINTAIN THE FIRE AND SMOKE CONSTRUCTION INTEGRITY OF THE EXISTING BUILDINGS.
- DO NOT VENT REFRIGERANT TO ATMOSPHERE. RECOVER REFRIGERANT FOR REUSE USING ASHRAE RECOMMENDED PROCEDURES. ARCHITECT.
- AREAS OUTSIDE OF THE FLOOR AREA SHALL BE SCHEDULED WITH THE OWNER 48 HOURS IN ADVANCE.
- STRUCTURAL DRAWINGS.
- IMMEDIATELY. CONNECTIONS TO EXISTING SYSTEMS AND SYSTEM SHUT-DOWNS WITH OWNER'S REPRESENTATIVE.
- OF THE OWNER WITHOUT ADDITIONAL COST TO THE OWNER.

#### MENT SCHEDULE - OSCEOLA BRANCH CONNECTIONS WН MOUNTING WATTAGE | DESIGN EWT | SETPOINT | VOLTAGE (V) PHASE REMARKS DCW DHW FLOOR 3/4" 40,000 Btu/h 55.0 °F 120.0 °F REFER TO WATER HEATER DETAIL 3/4" 208 V 1

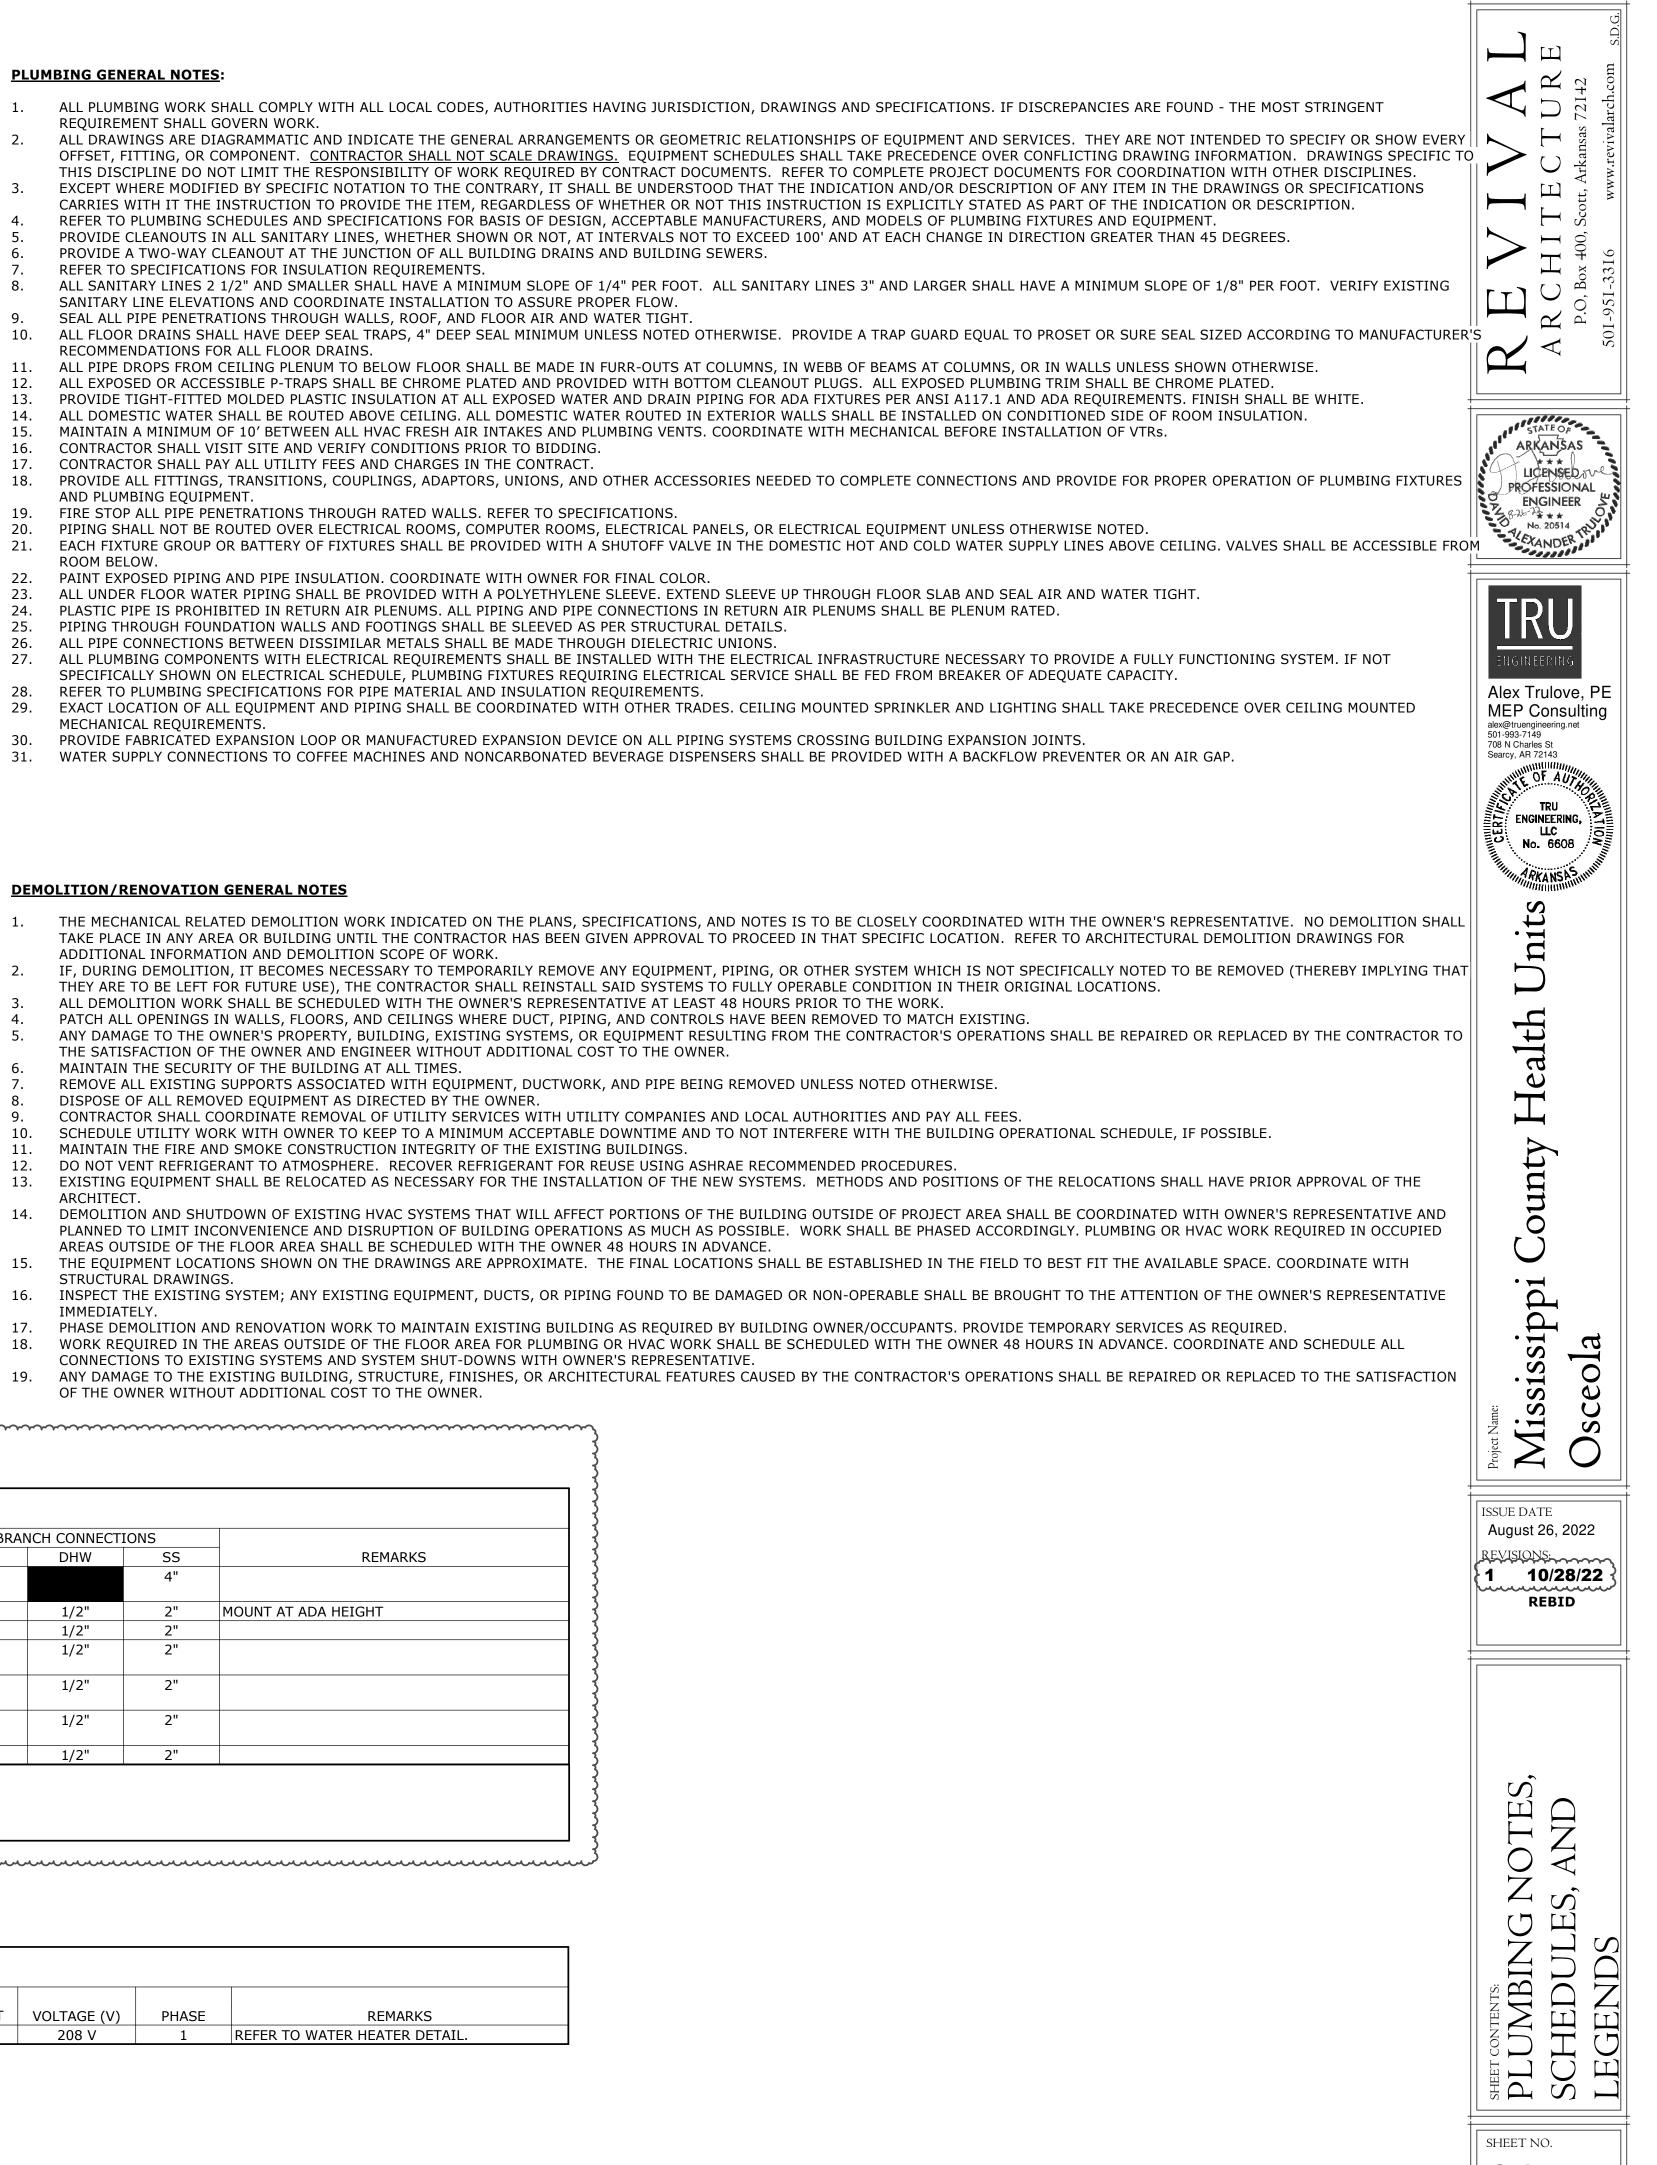


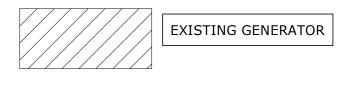

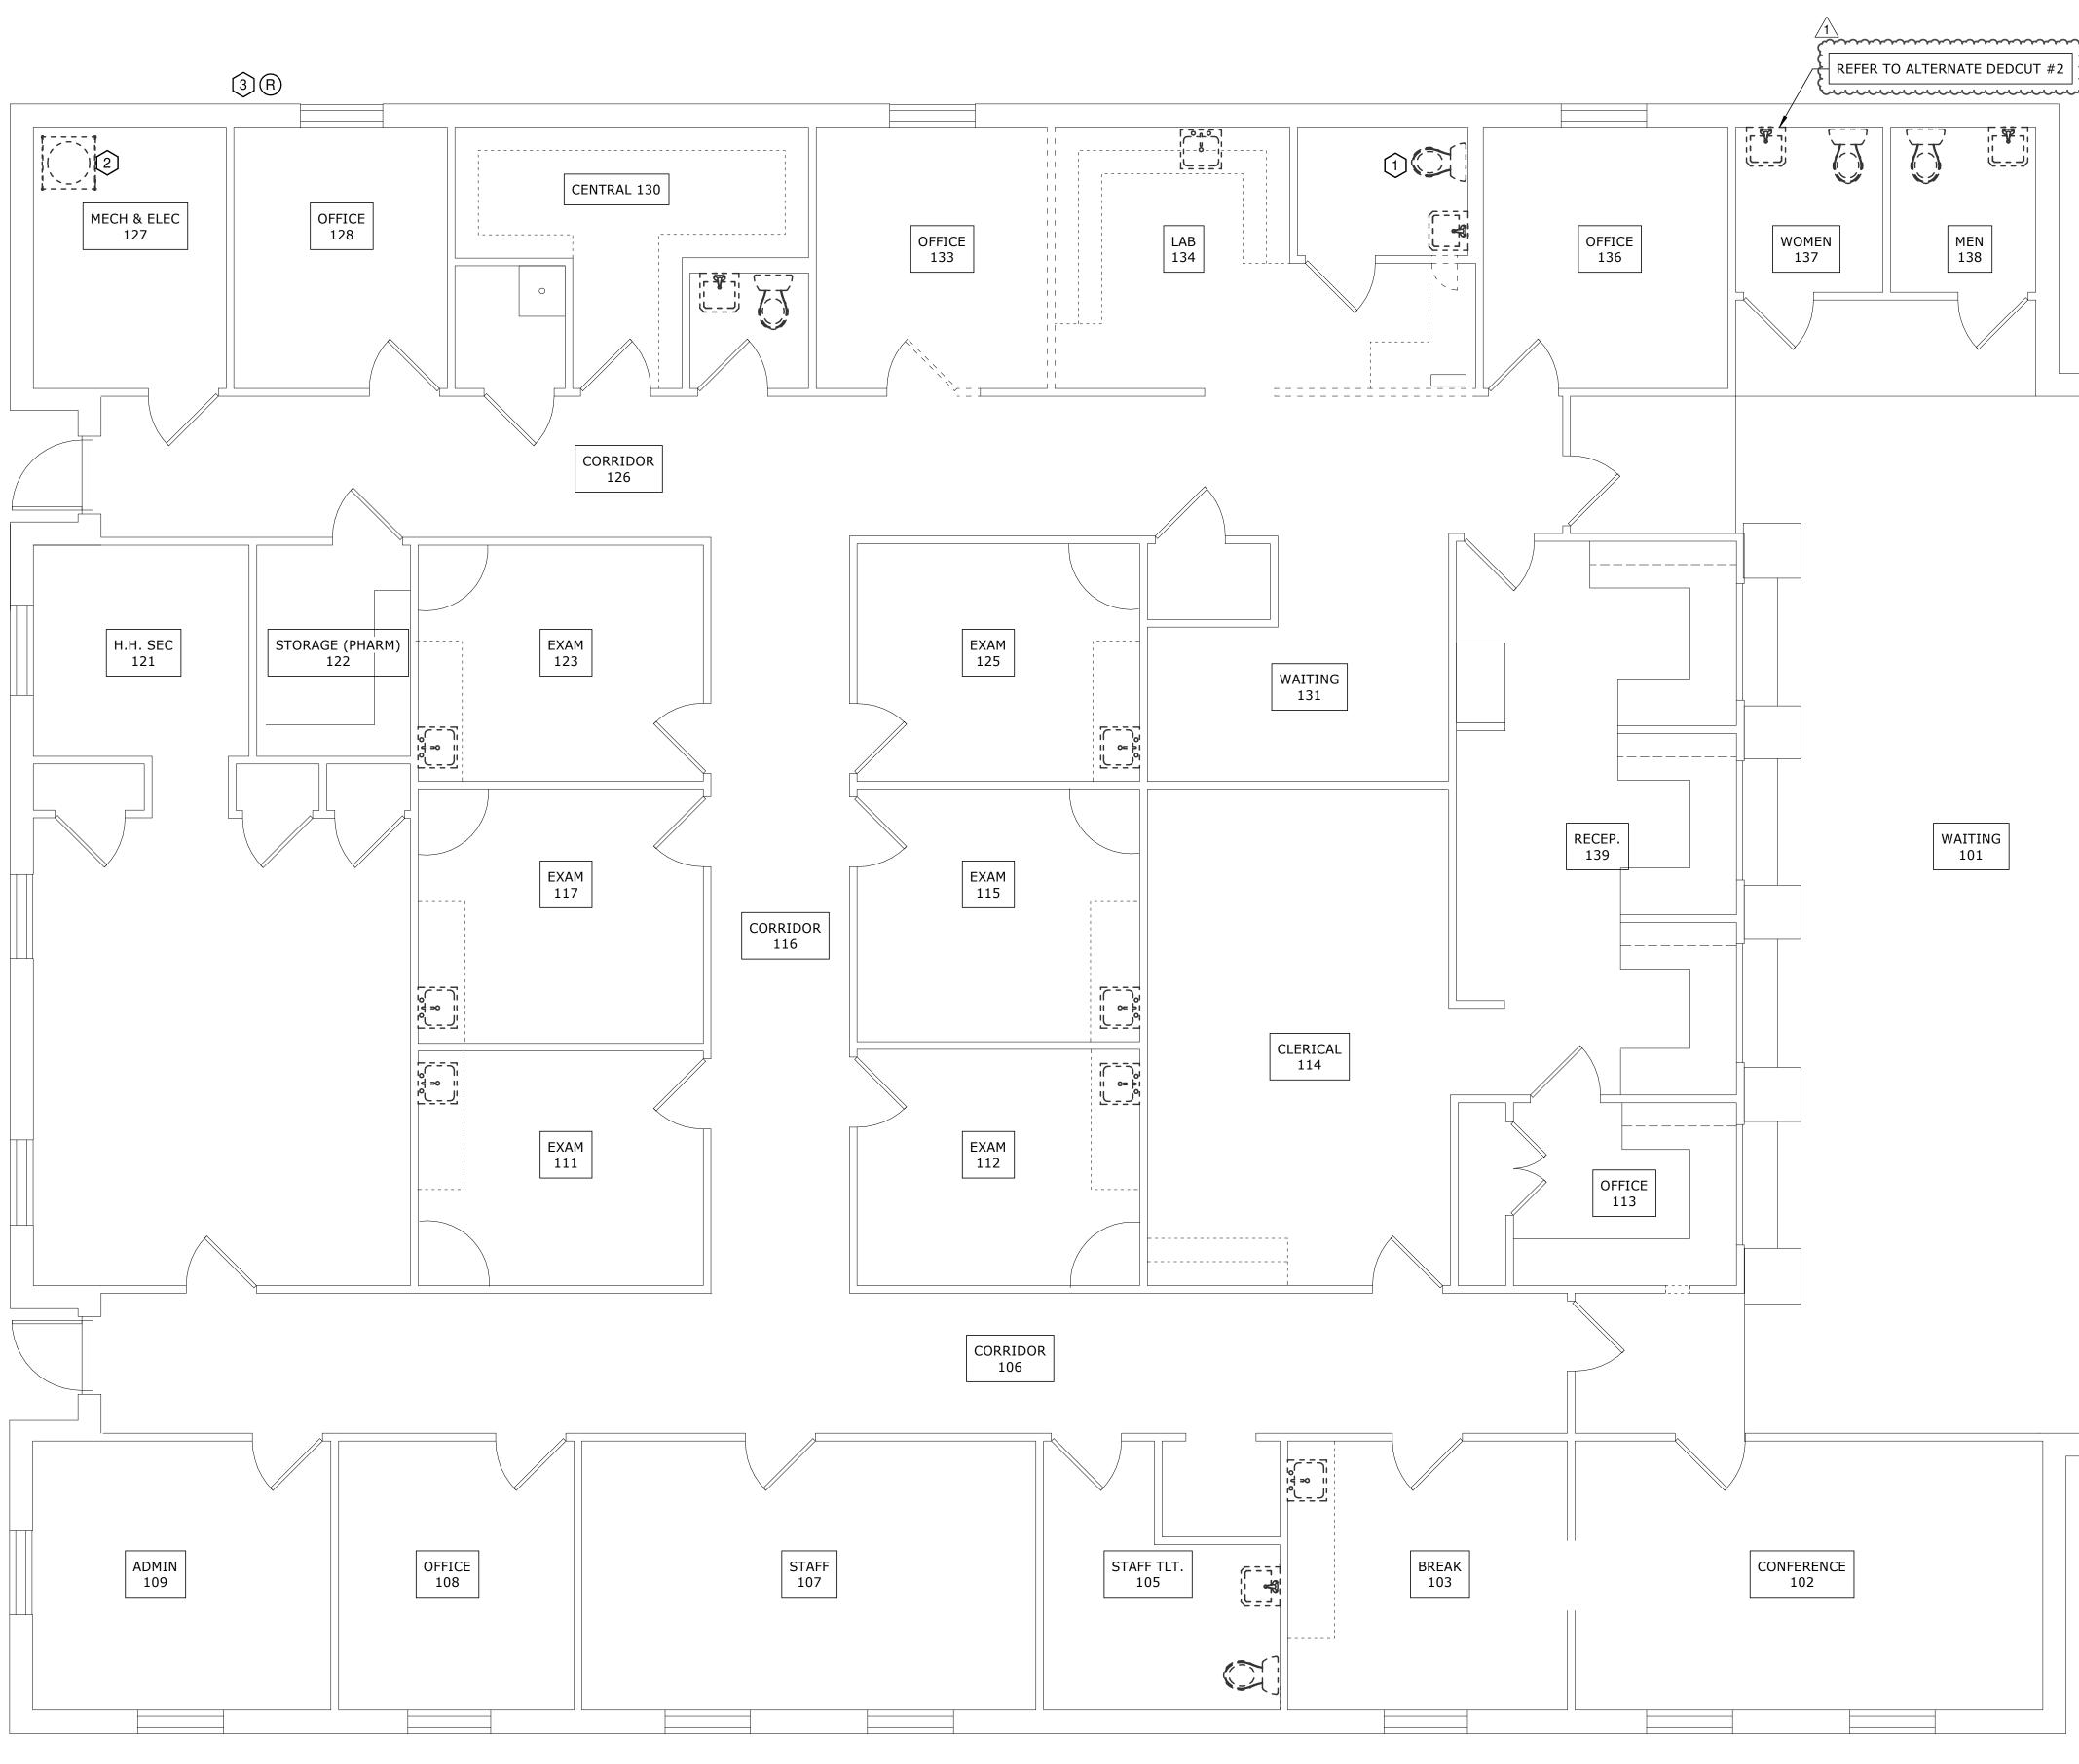


DEMO PLUMBING PLAN - OSCEOLA (1)1/4" = 1'-0"




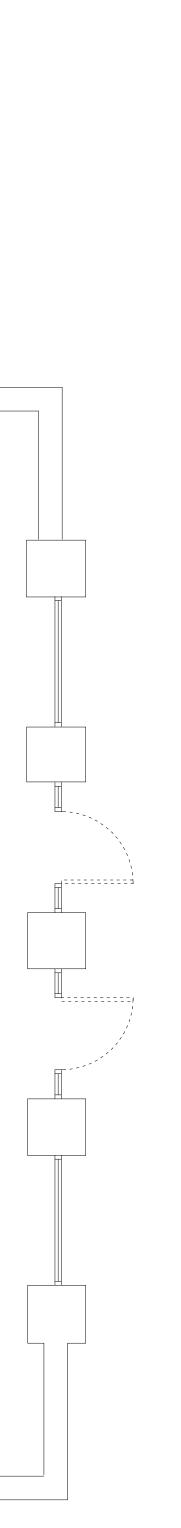

### KEYED NOTES

- REMOVE EXISTING PLUMBING FIXTURES COMPLETE BACK TO STOP, TYPICAL ALL. REMOVE EXISTING WATER HEATER AND ASSOCIATE 1.
- 2.
- 3.
- RECIRC PUMP COMPLETE. EXISTING NATURAL GAS REGULATOR. REMOVE ALL EXISTING PIPING WITH EXISTING GERNATOR TO BE DEMOLISHED.

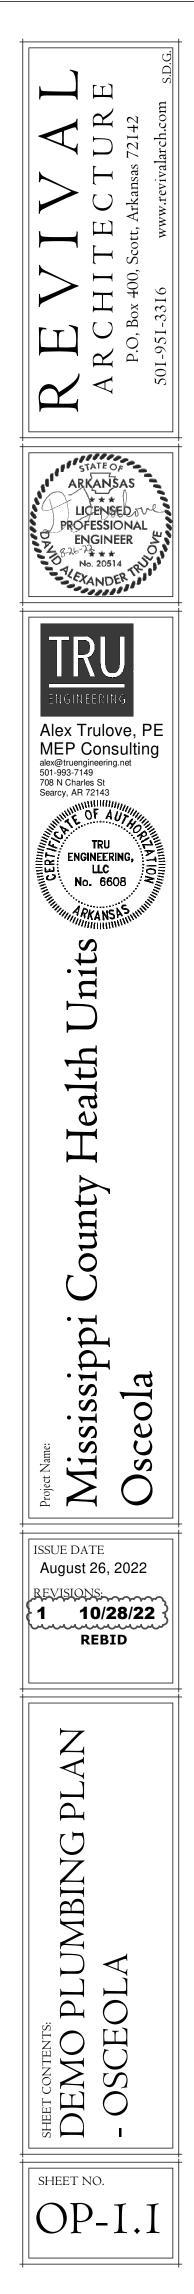

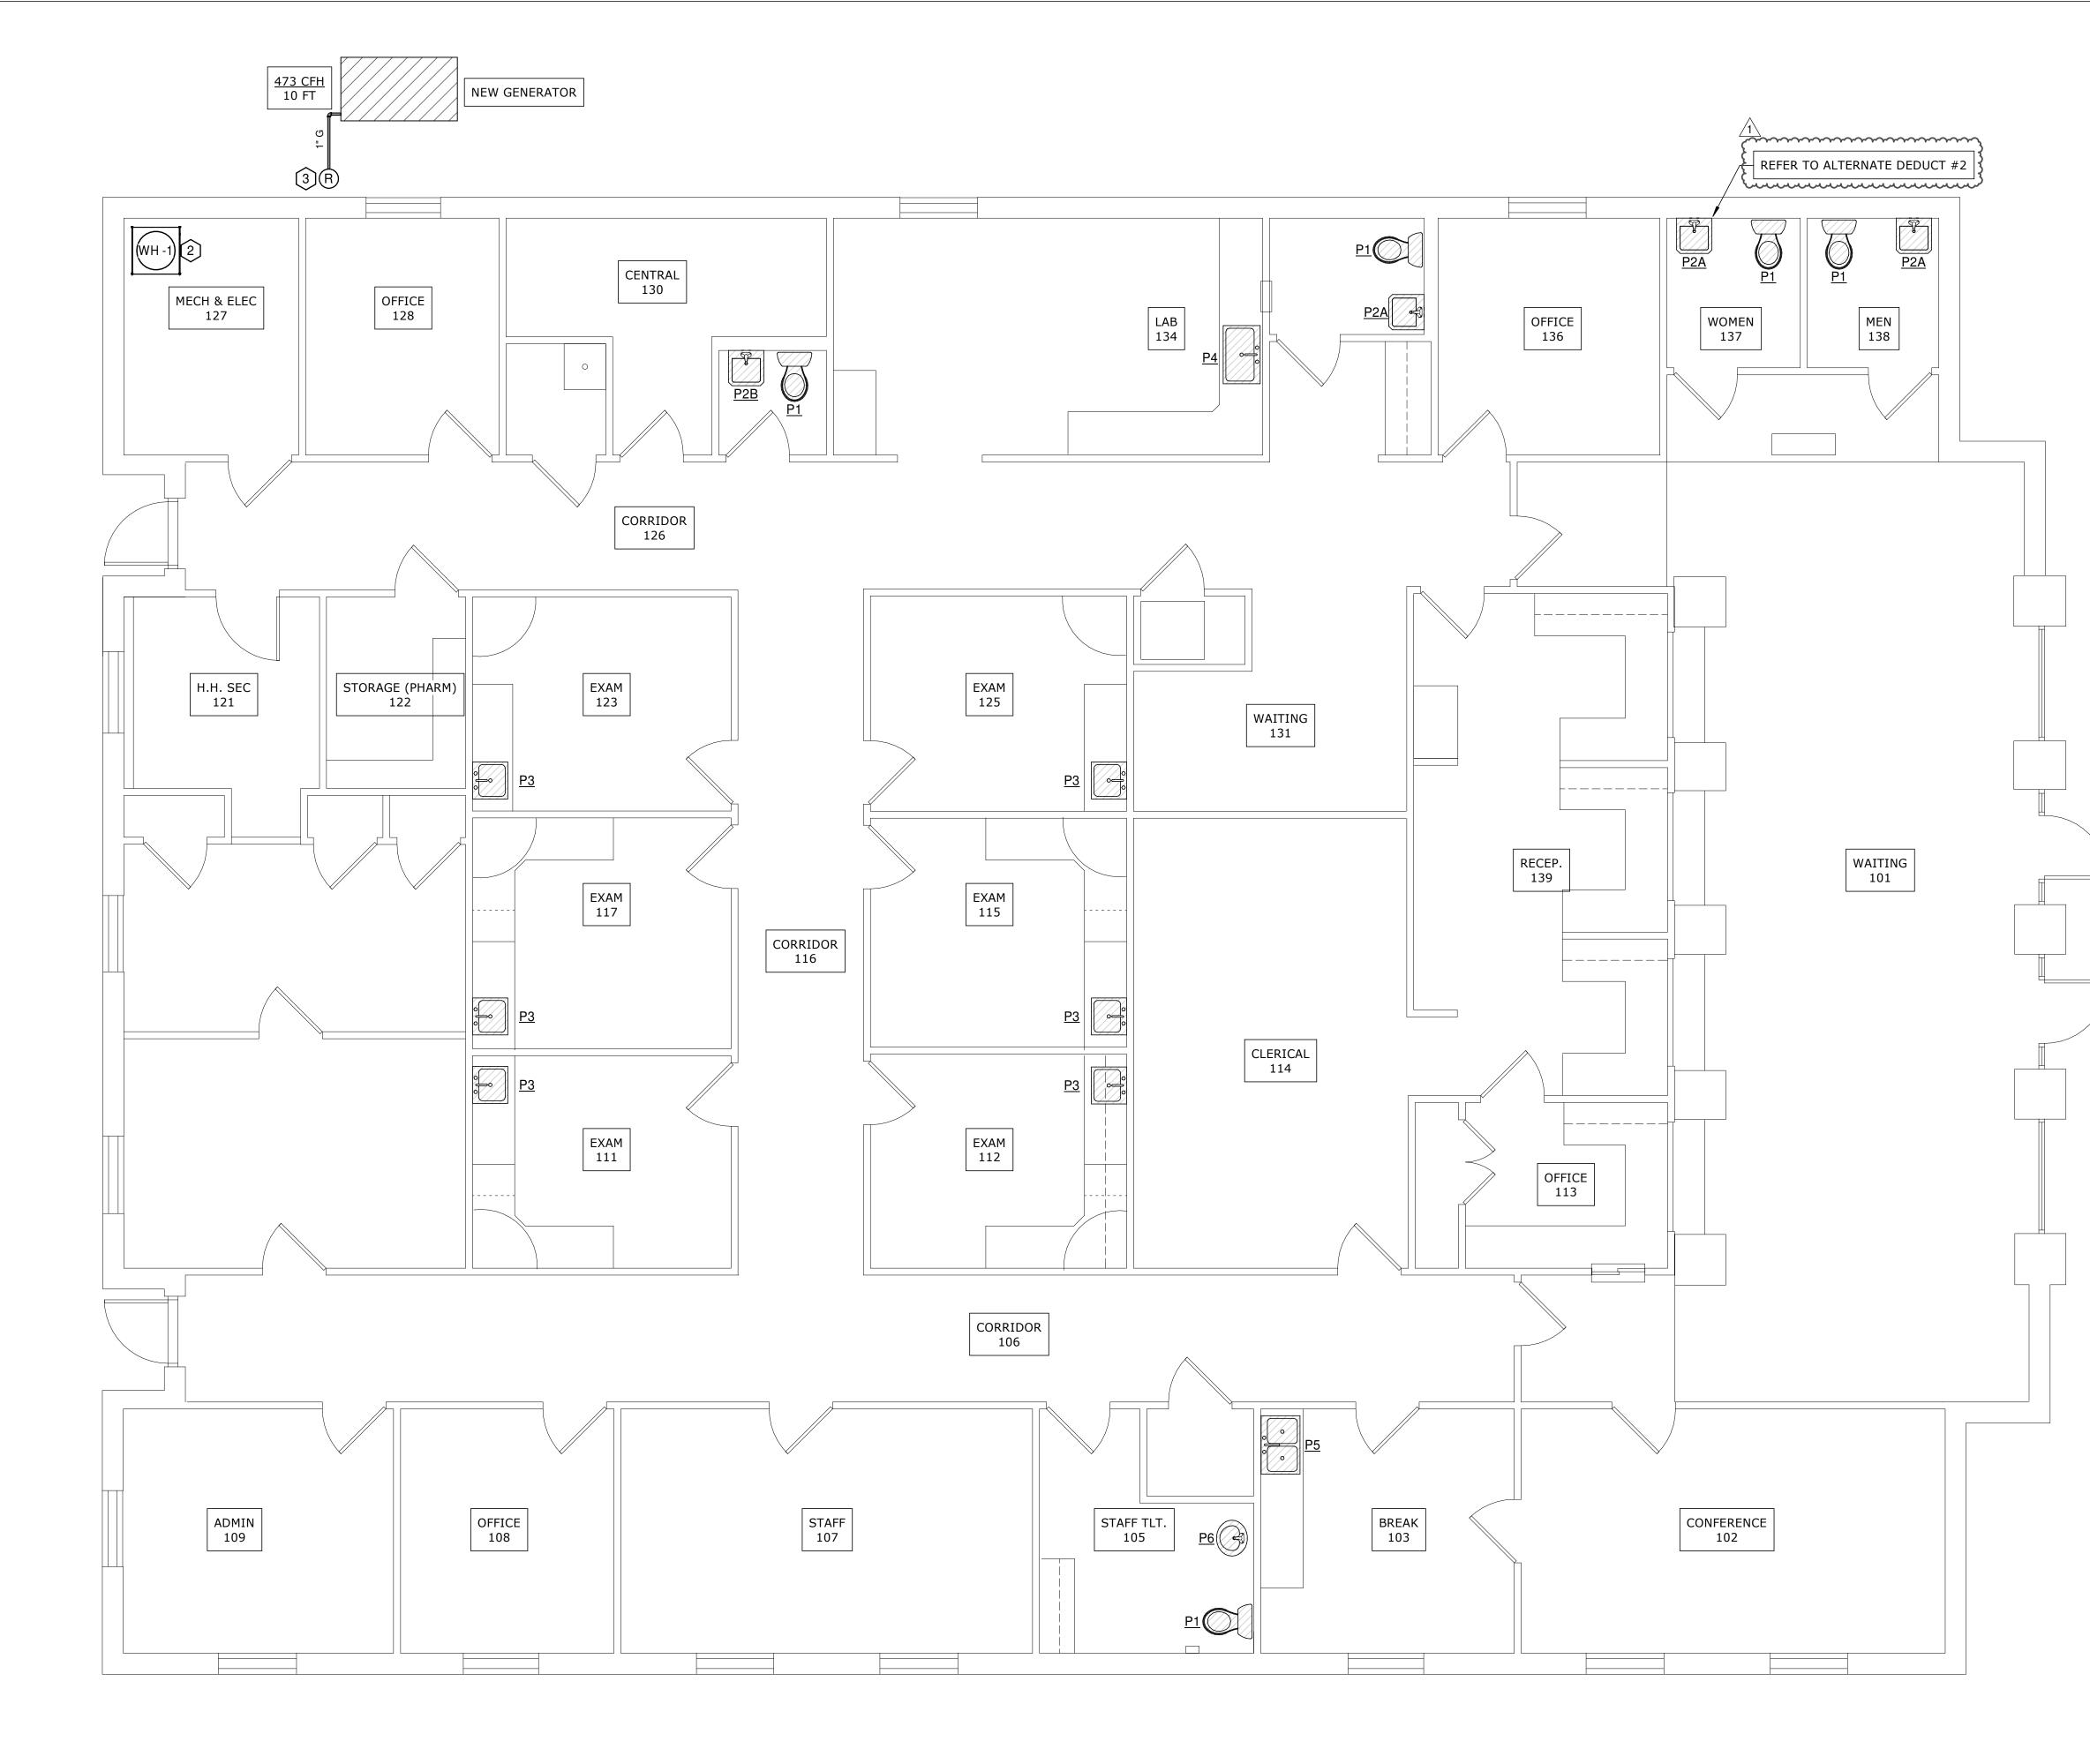






KEYED NOTES

- NEW PLUMBING FIXTURE TO CONNECT TO EXISTING SANITARY/DCW/DHW SUPPLIES. TYPICAL ALL.
   NEW WATER HEATER AND RECIRC PUMP. SEE WATER HEATER DETAIL FOR FULL REQUIREMENTS.
   PROVIDE 1" GAS LINE BELOW GRADE TO NEW GENERATOR. BALANCE REGULATOR AS REQUIRED FOR INCREASED CAPACITY.

	FIXTURE CONNECTION Ø	- OSCE	EOLA	
		BRANCH	I CONNECT	IONS
TAG	DESCRIPTION	DCW	DHW	SS
P1	WATER CLOSET - FLUSH TANK - ADA	1/2"		4"
P2A	WALL HUNG LAVATORY	1/2"	1/2"	2"
P2B	WALL HUNG LAVATORY	1/2"	1/2"	2"
P3	SINK - ADA - SINGLE COMPARTMENT	1/2"	1/2"	2"
P4	KITCHEN SINK - SINGLE COMPARTMENT	1/2"	1/2"	2"
P5	SINK - DOUBLE COMPARTMENT	1/2"	1/2"	2"
P6	DROP IN LAVATORY - OVAL	1/2"	1/2"	2"



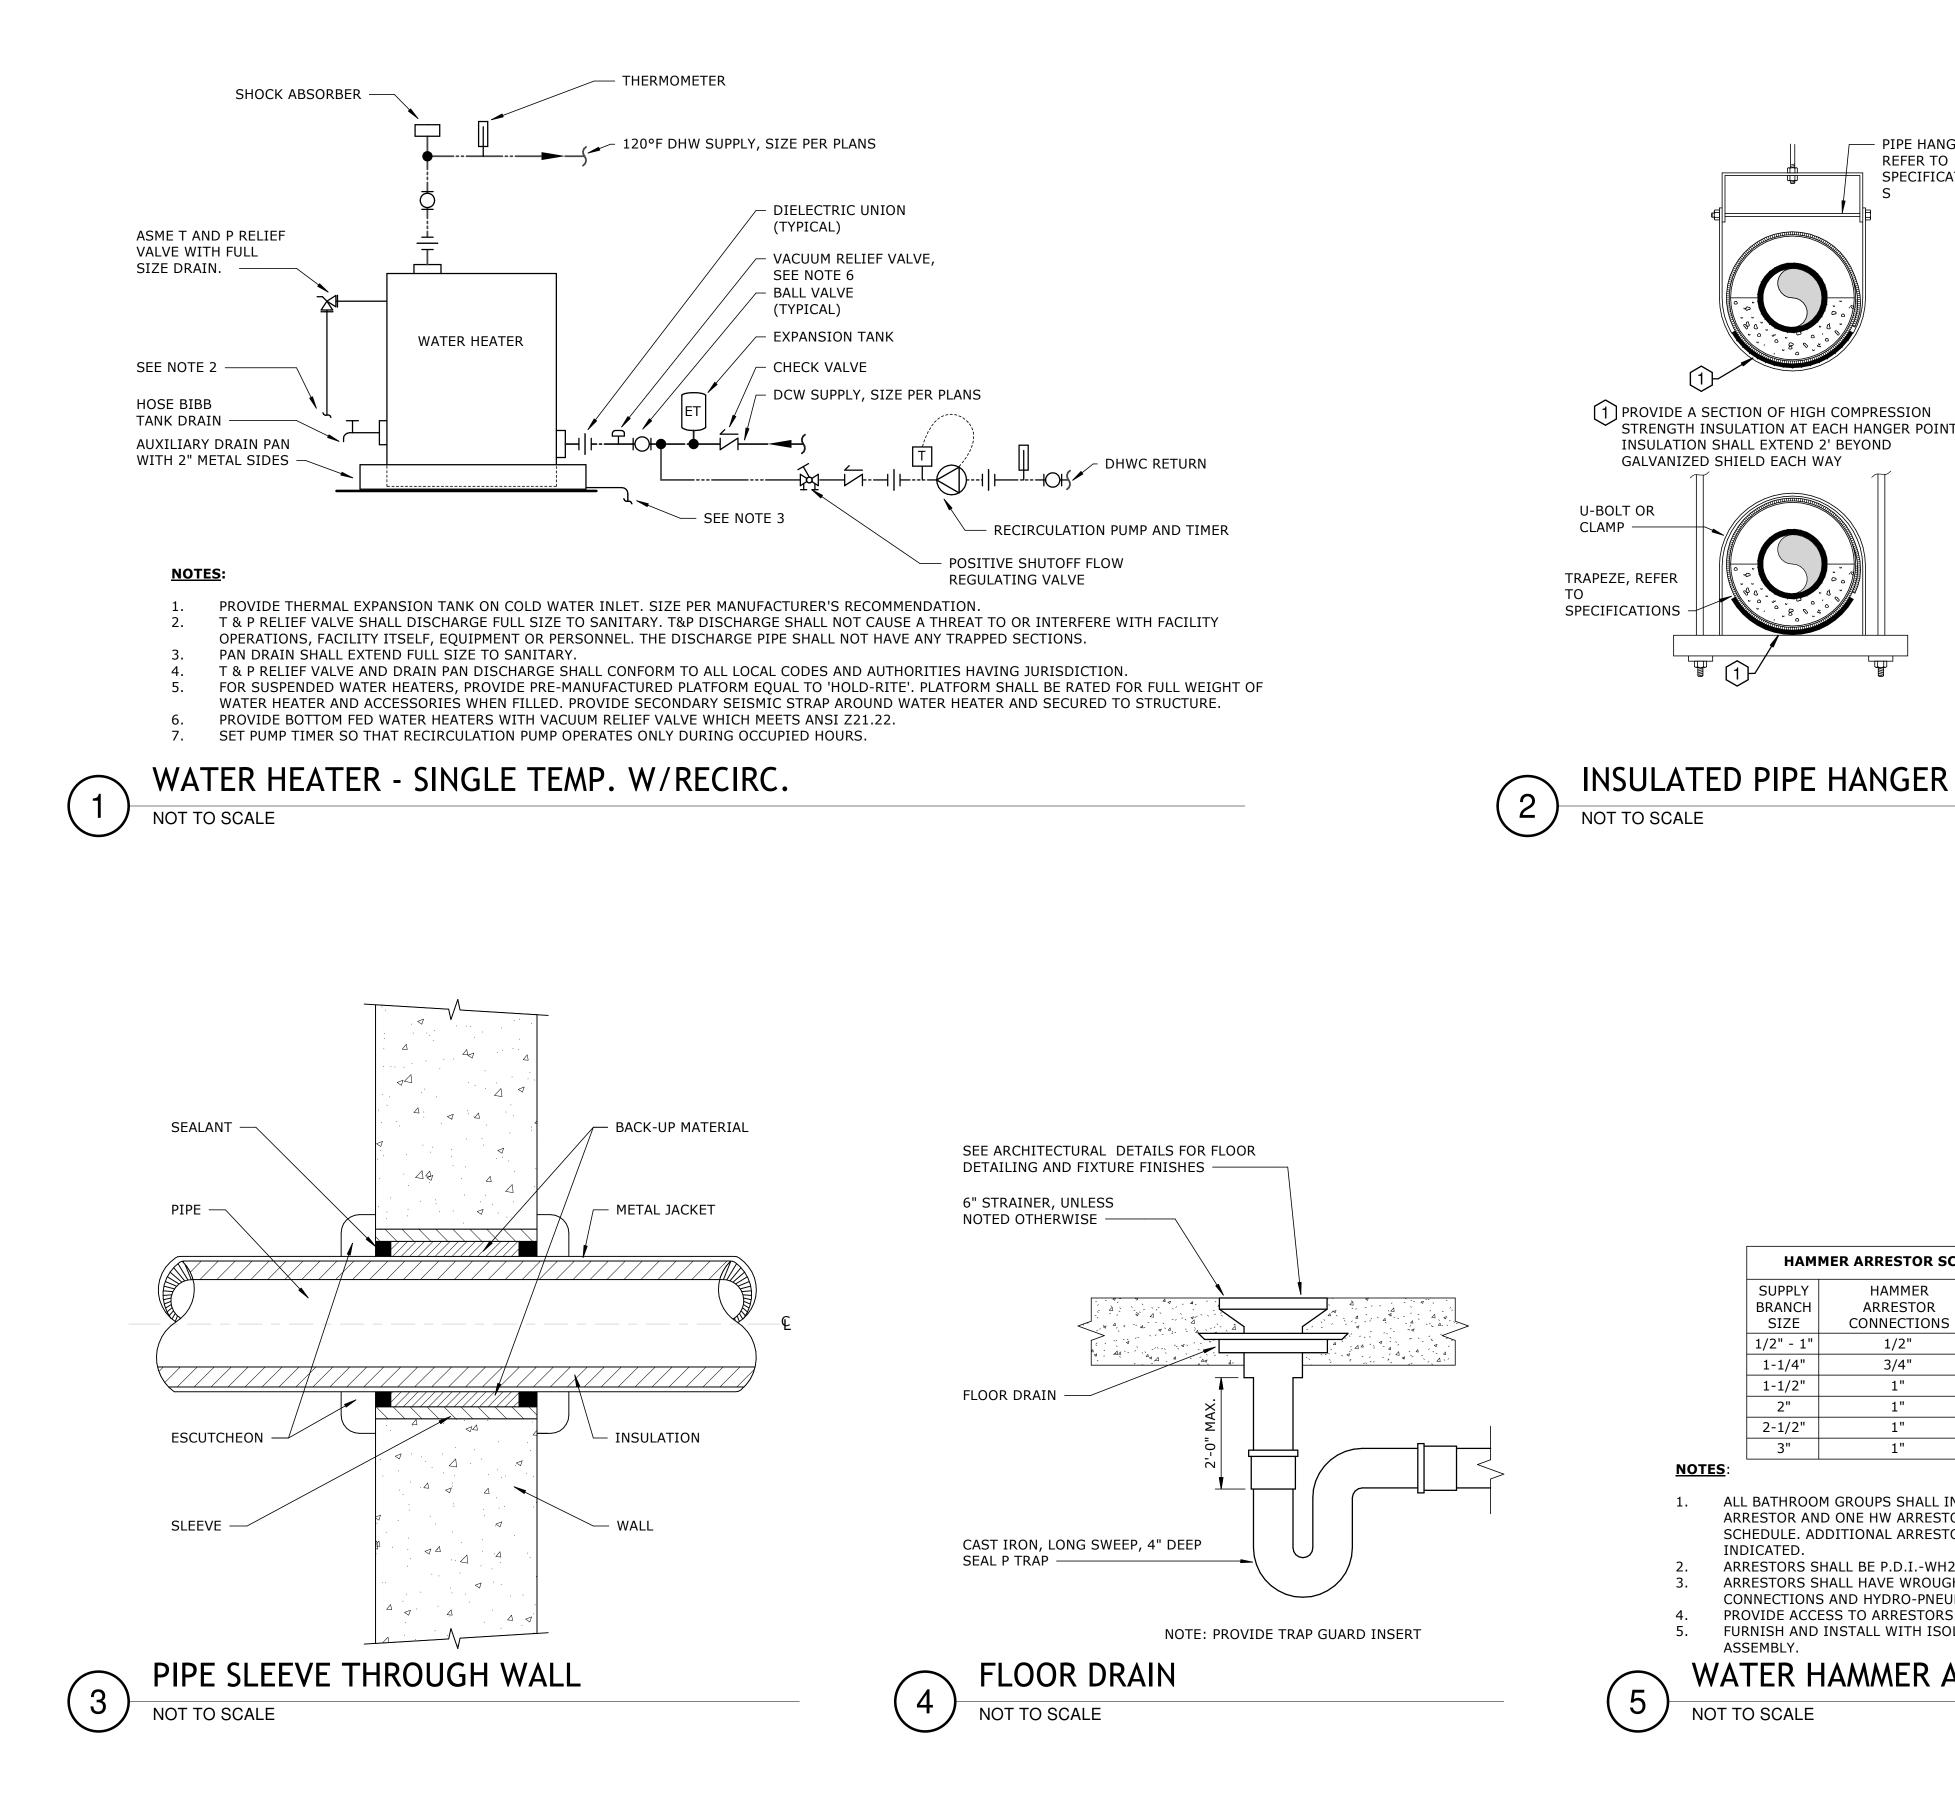

	EDULE
HAMMER ARRESTOR CONNECTIONS	FIXTURE UNITS
1/2"	1-11
3/4"	12-32
1"	33-60
1"	61-113
1"	114-154
1"	155-330
	ARRESTOR CONNECTIONS 1/2" 3/4" 1" 1" 1"

— PIPE HANGER, REFER TO

STRENGTH INSULATION AT EACH HANGER POINT;

INSULATION SHALL EXTEND 2' BEYOND

GALVANIZED SHIELD EACH WAY

SPECIFICATION

**-**2**-**►

(ĵ)^j

Û

16 GAUGE

GALVANIZED

SHEET SHIELD

INSULATION

FULLY WRAPPED

**-**2-**-**

_12" MIN.

-12" MIN.-

16 GAUGE GALVANIZED

SHEET SADDLE

NOTE

ALL BATHROOM GROUPS SHALL INCLUDE A MINIMUM OF ONE DCW ARRESTOR AND ONE HW ARRESTOR SIZED PER HAMMER ARRESTOR SCHEDULE. ADDITIONAL ARRESTORS SHALL BE INSTALLED WHERE INDICATED.

- ARRESTORS SHALL BE P.D.I.-WH201 APPROVED AND CERTIFIED.
- ARRESTORS SHALL HAVE WROUGHT COPPER SHELL WITH THREADED
- CONNECTIONS AND HYDRO-PNEUMATIC AIR CUSHION.
- PROVIDE ACCESS TO ARRESTORS. 5.


FURNISH AND INSTALL WITH ISOLATION VALVES INDEPENDENT OF


ASSEMBLY.


WATER HAMMER ARRESTOR SCHEDULE

5 NOT TO SCALE



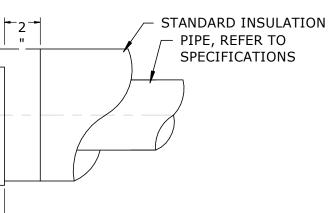

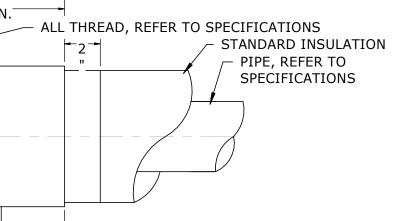

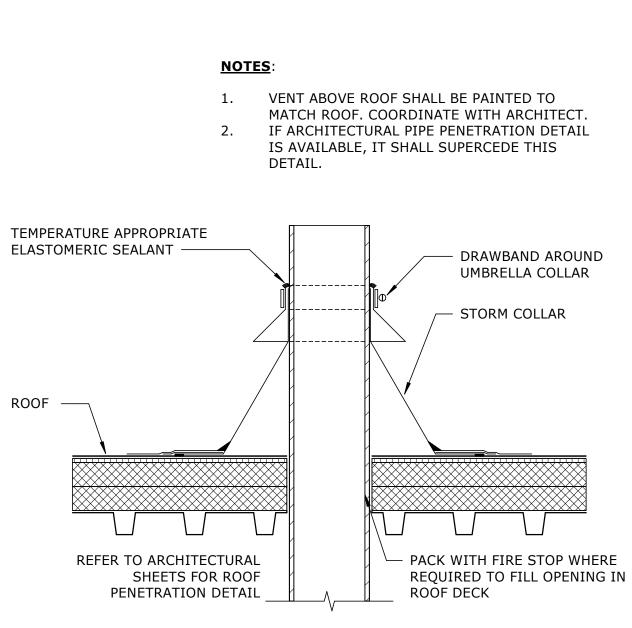





SHEET NO. OP-2.1