ELECTRICAL DETAILS

FIRE PROTECTION FIRE PROTECTION NOTES, LEGEND, INDEX, & MEZZANINE PLAN FIRE PROTECTION FLOOR PLAN

ELECTRICAL LIGHTING PLAN

HVAC EQUIPMENT POWER PLAN


ELECTRICAL PANEL SCHEDULES

ELECTRICAL POWER & SYSTEMS PLAN

ELECTRICAL MEZZANINE AND ENLARGED PLANS

ELECTRICAL ONE-LINE DIAGRAM AND PANEL

PROJECT LOCATION

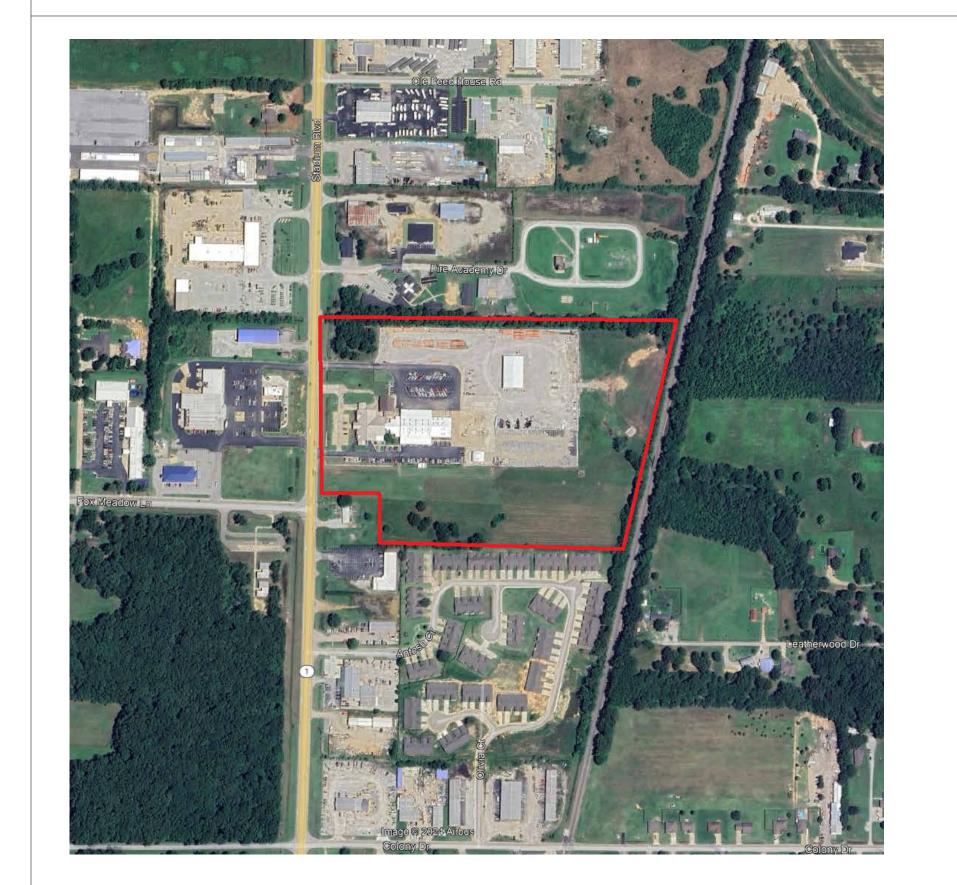




WDD ARCHITECTS

SCHEDULES

ARCHITECTS-INTERIOR DESIGN-PLANNERS **5050 NORTHSHORE LANE** NORTH LITTLE ROCK, ARKANSAS 72118 PH. # (501)376-6681 EMAIL: wdd@wddarchitects.com

I HEREBY CERTIFY THAT THESE PLANS AND SPECIFICATIONS HAVE BEEN PREPARED BY ME, OR UNDER MY SUPERVISION. I FURTHER CERTIFY THAT TO THE BEST OF MY KNOWLEDGE THESE PLANS AND SPECIFICATIONS ARE AS REQUIRED BY LAW AND IN COMPLIANCE WITH THE ARKANSAS FIRE PREVENTION CODE FOR THE STATE OF ARKANSAS.


SIGNATURE

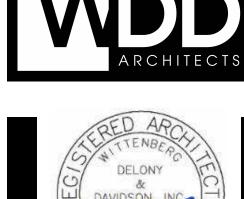



TRIC

GENERAI

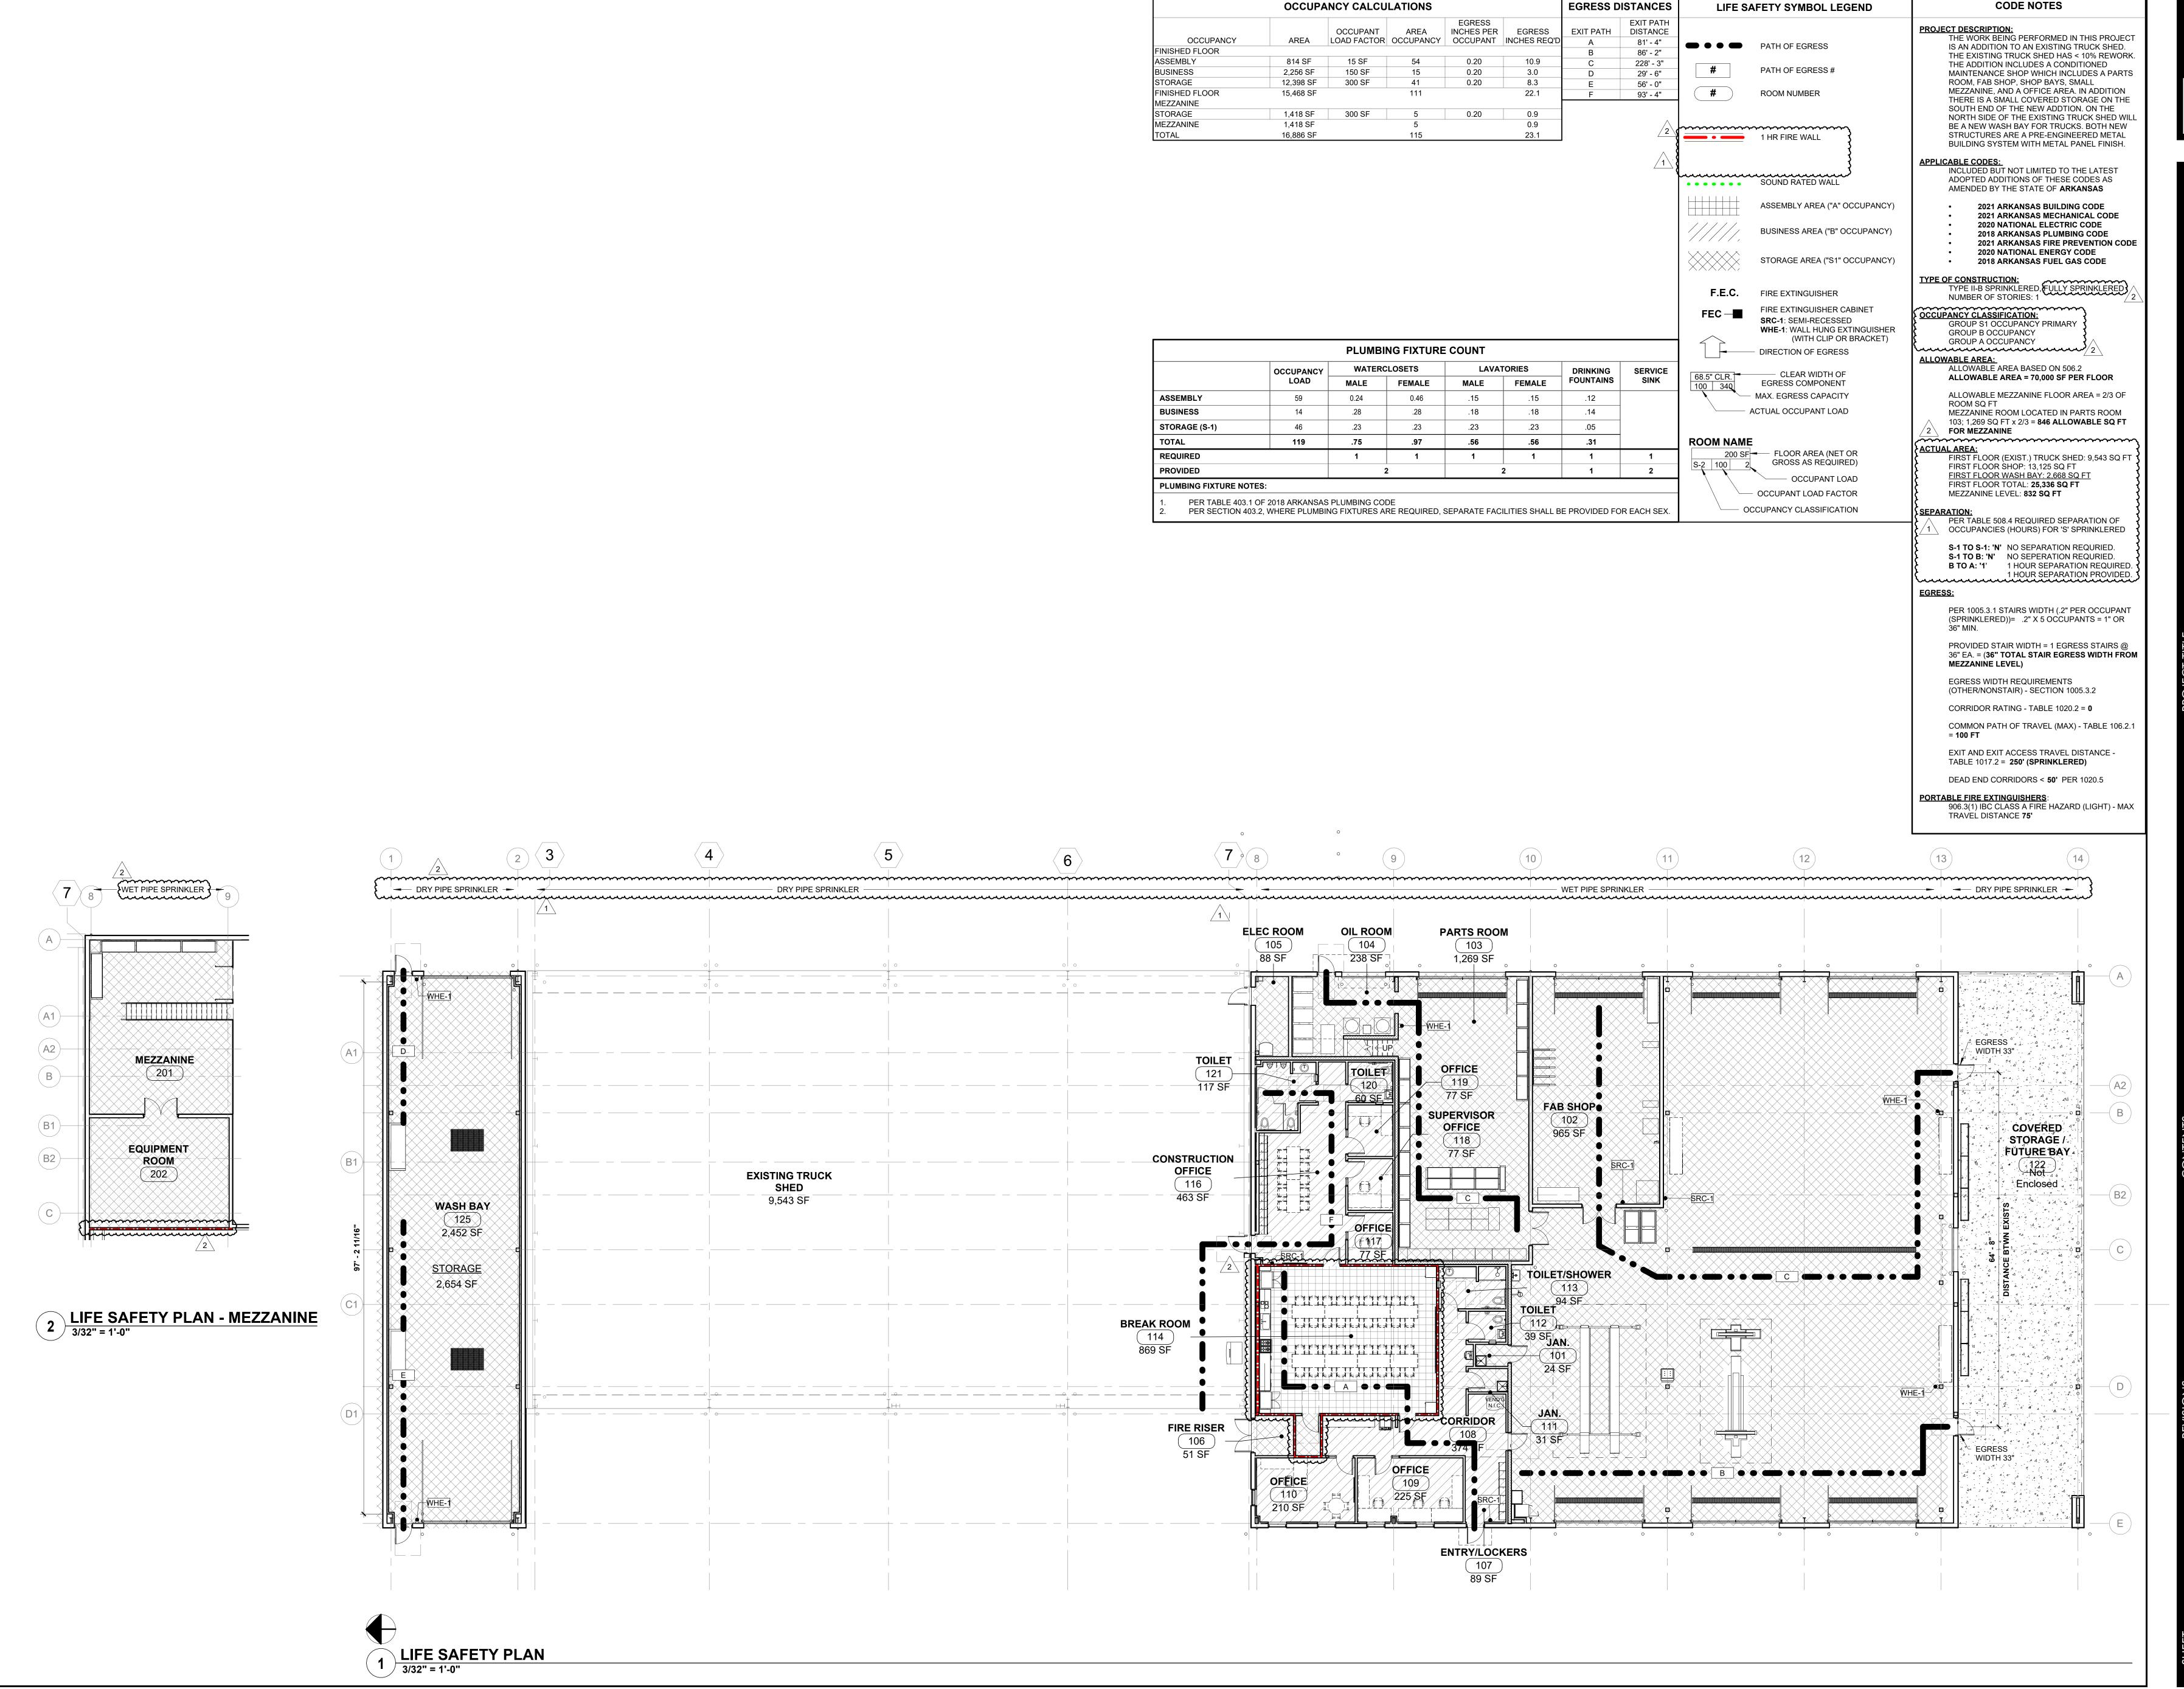





N N

RAIG

ADDITION

수

MAINTENANCE (4314 STAD)

24-096 JOB. NO. 02.14.2025

T120






ELECTRIC ADDITION CRAIGHEAL
MAINTENANCE

24-096 JOB. NO.

02.14.2025

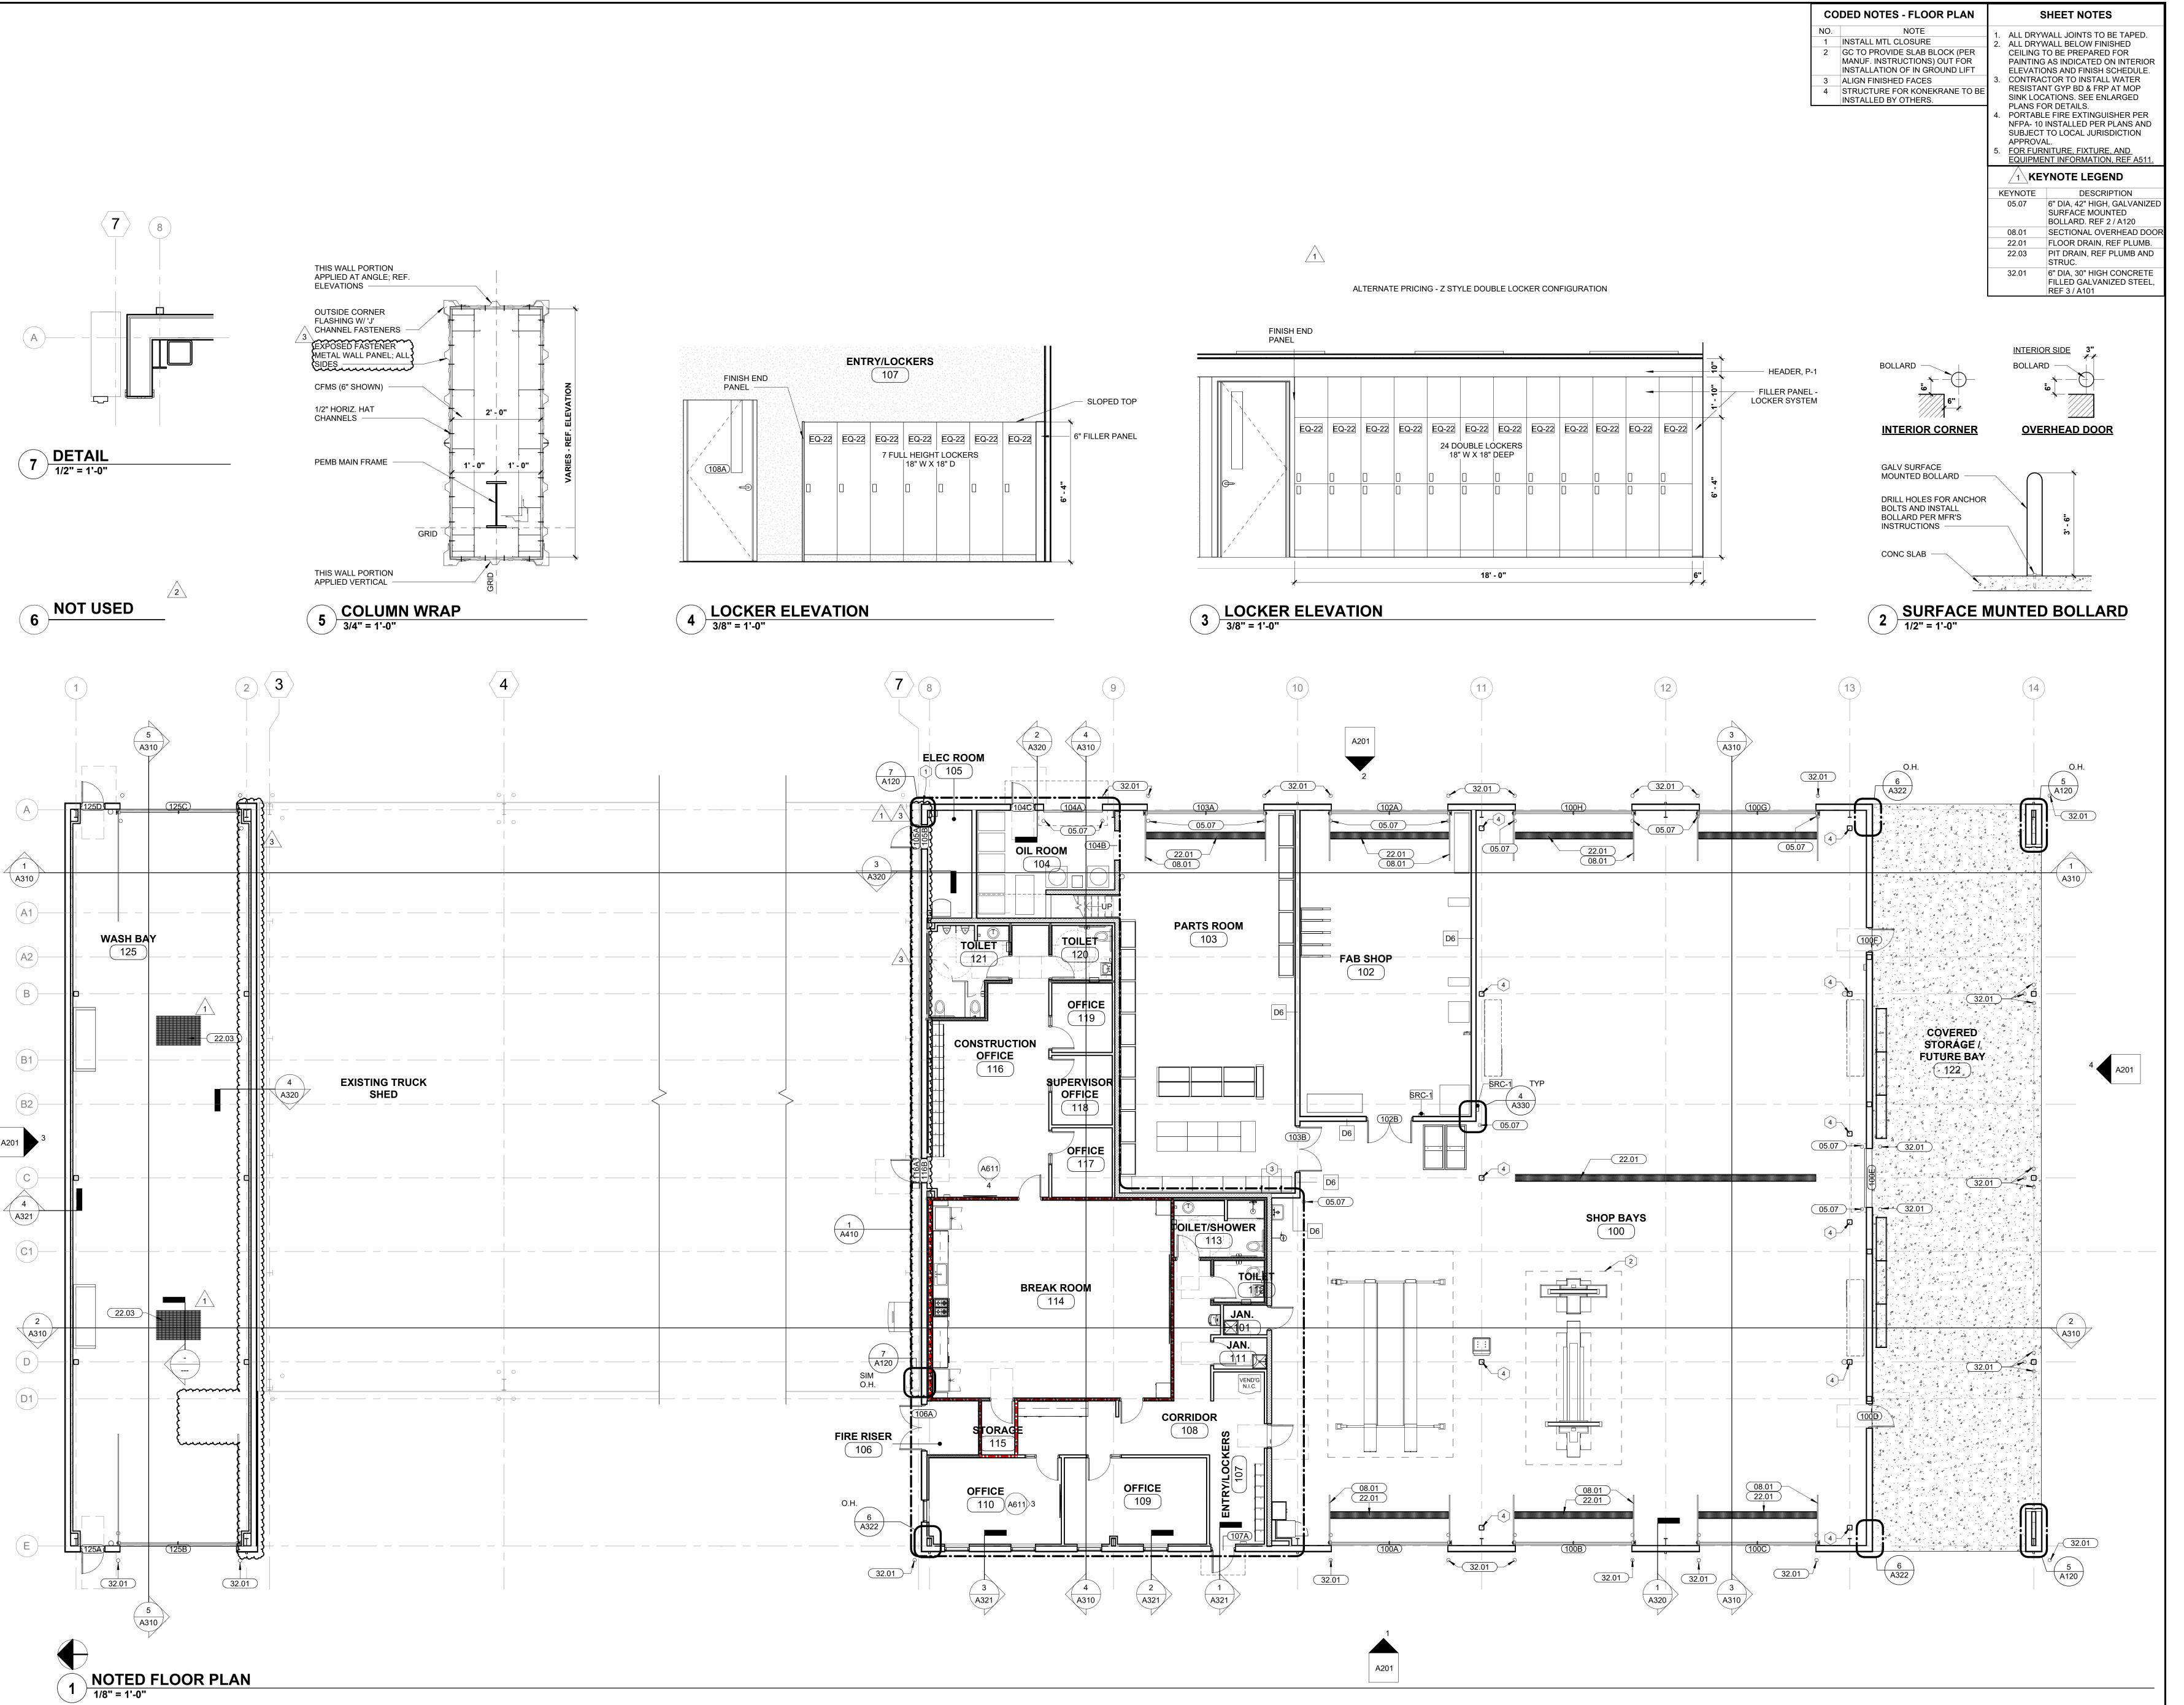






TRIC **ADDITION** CRAIGHEAL
MAINTENANCE

24-096 JOB. NO. 02.14.2025

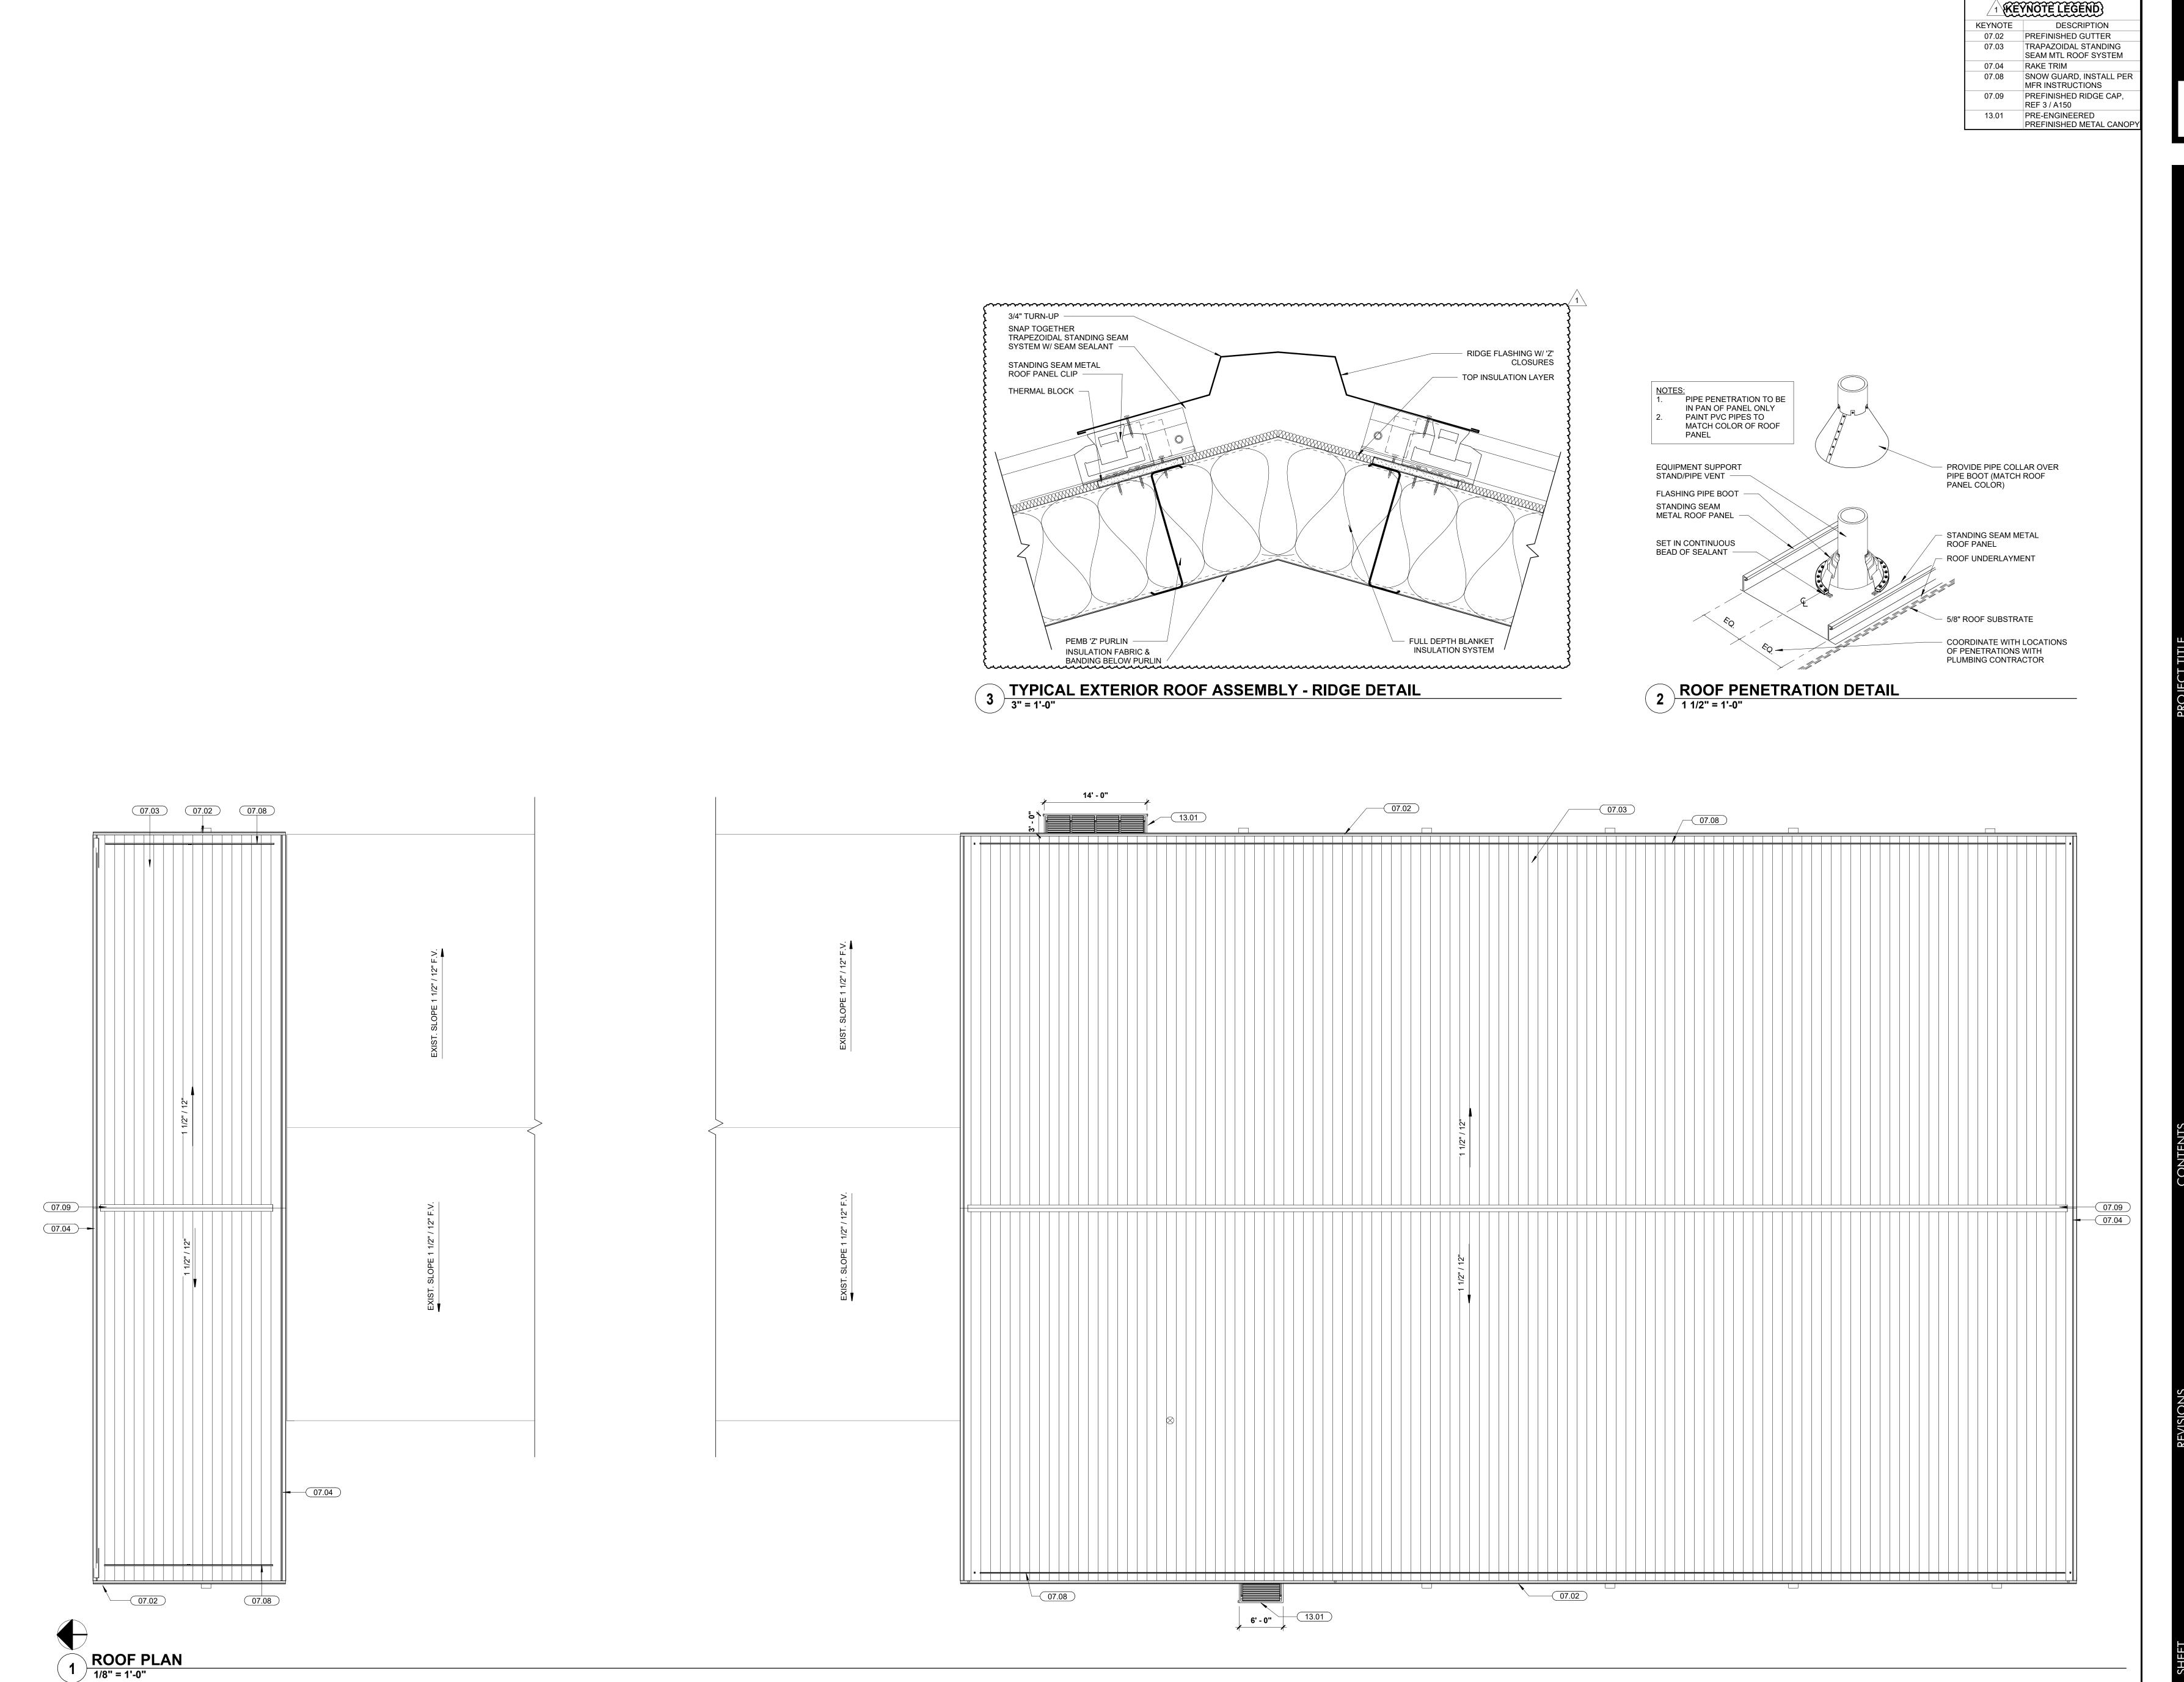






TRIC

24-096 Job. no. 02.14.2025

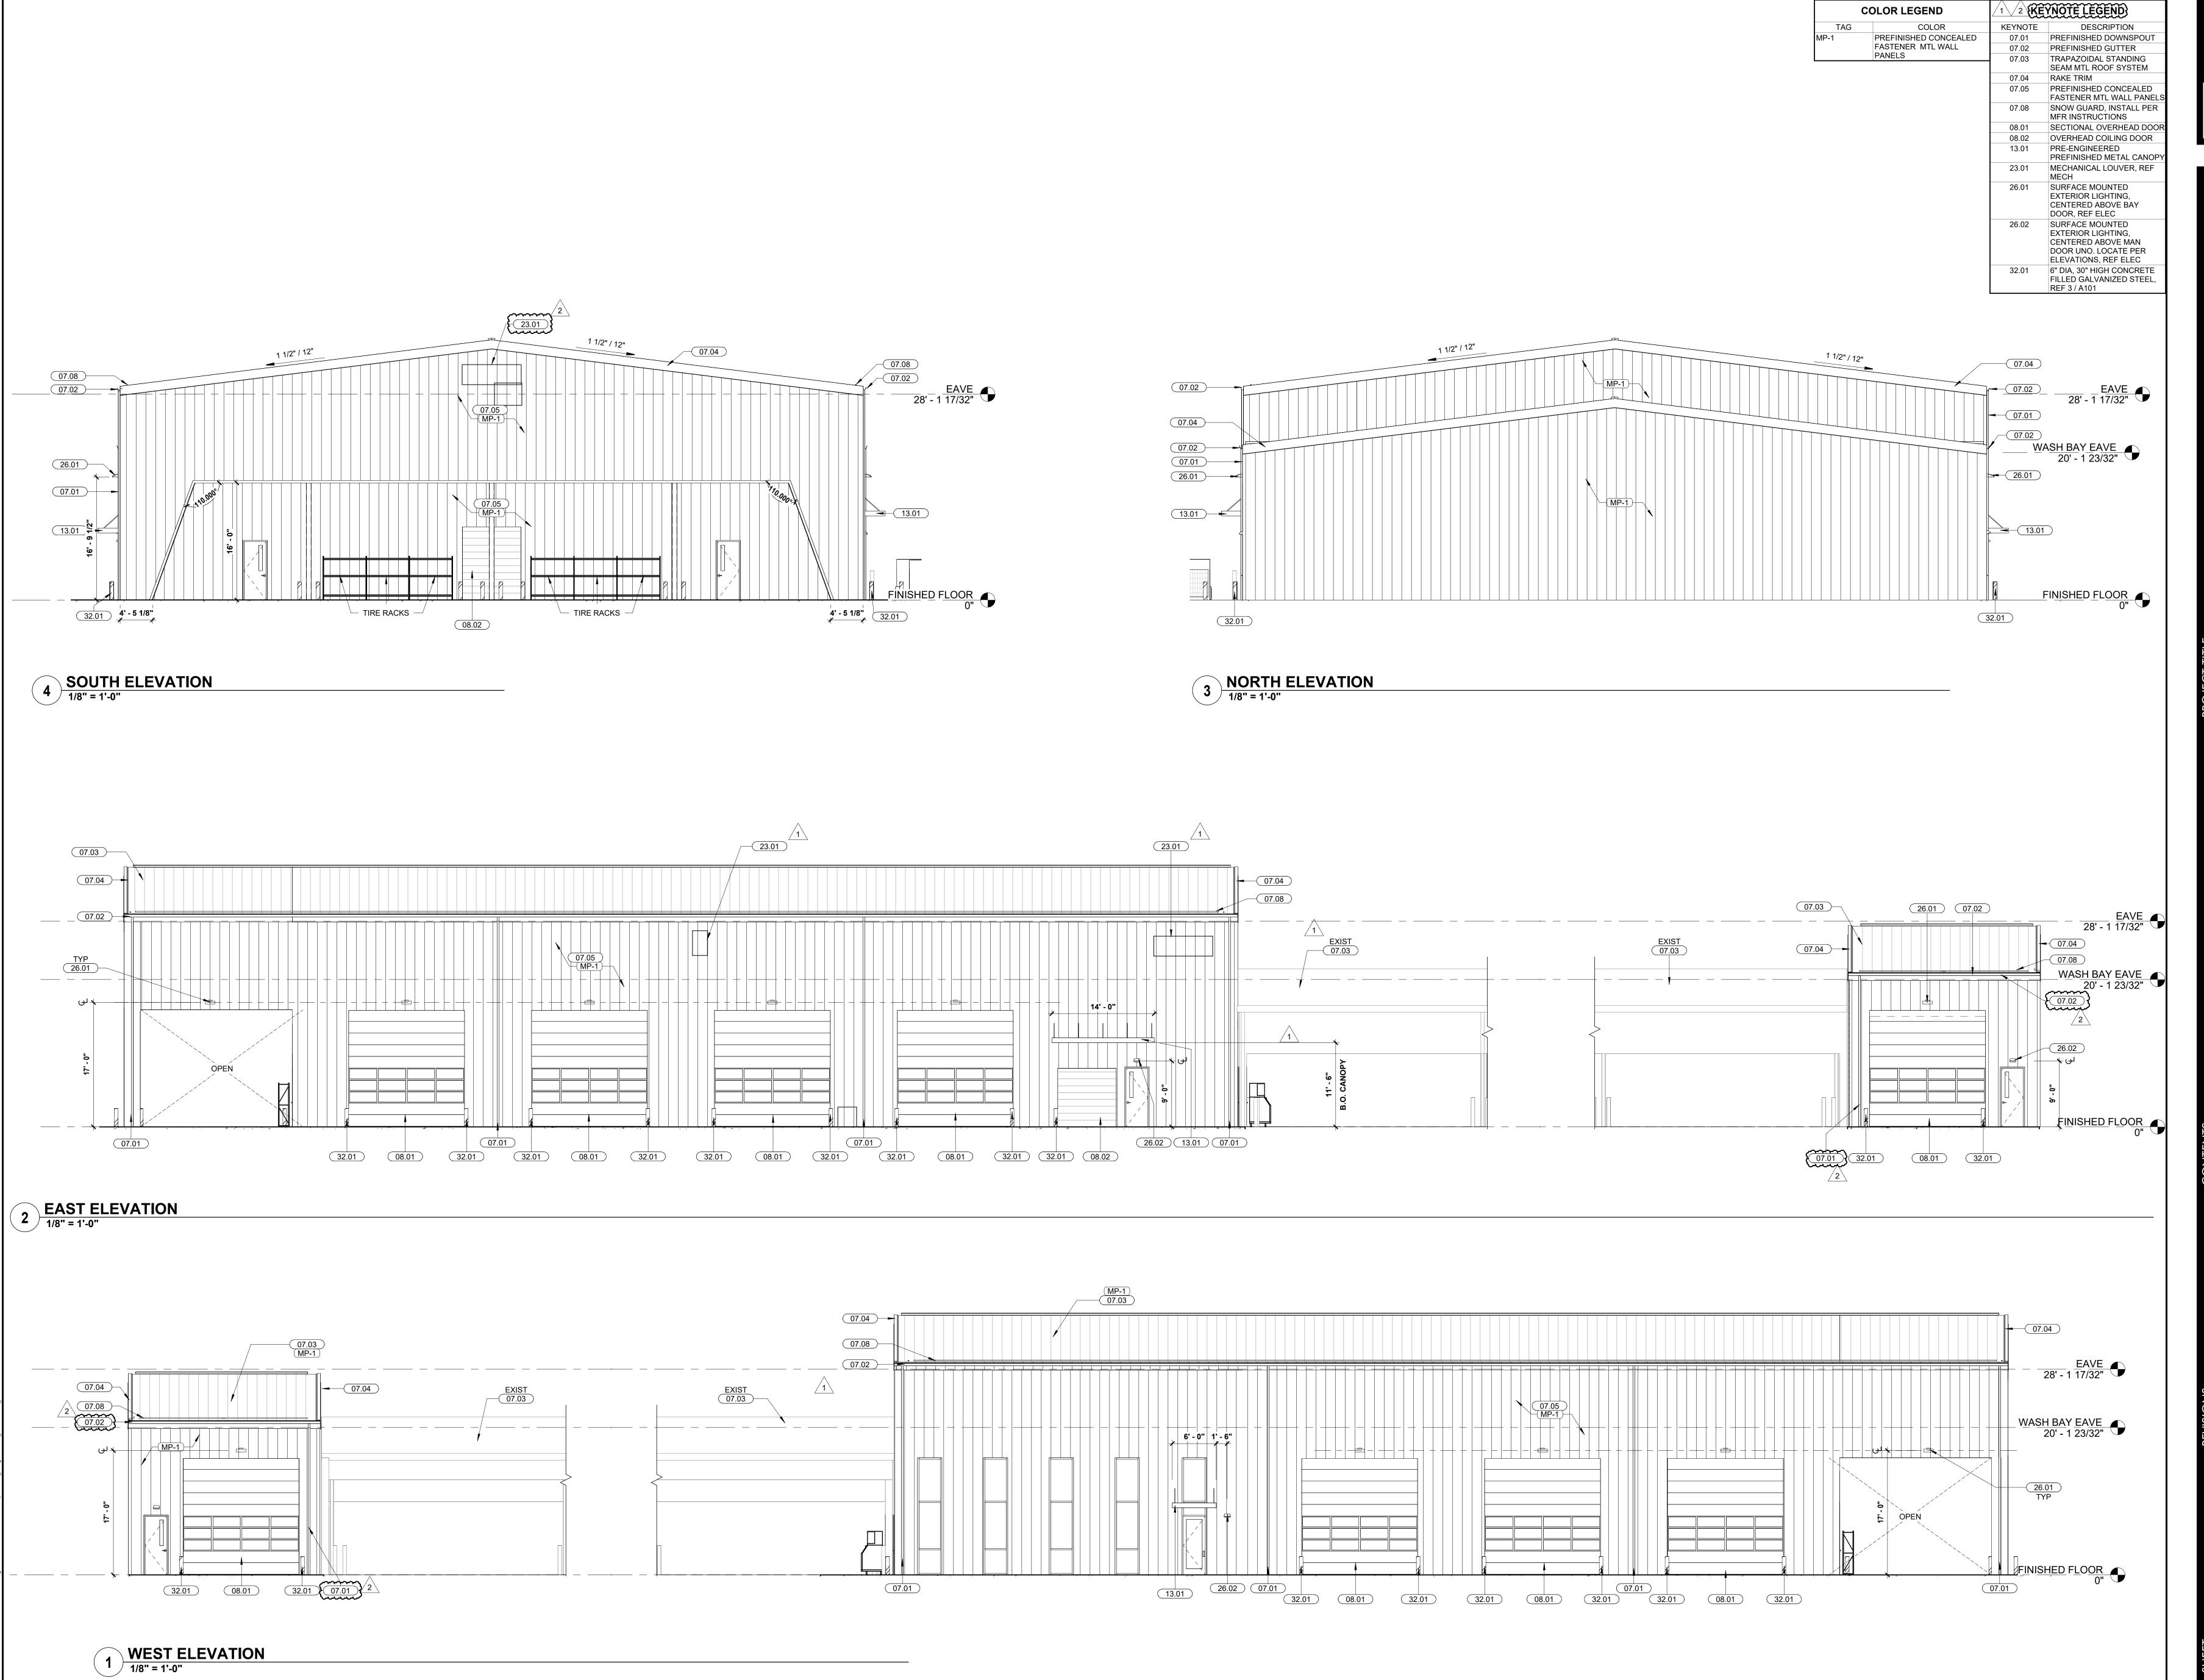







ELECTRIC

ADDITION

SHOP

CRAIGHEAD

MAINTENANCE SH

24-096 JOB. NO. 02.14.2025 DATE

EXTERIOR

ISSUE





CRAIGHEAD ELECTRIC
MAINTENANCE SHOP ADDITION
4314 STADIUM BLVD.

BUILDING SECTIONS


 NO.
 DATE
 DESCRIPTION

 1
 03/06/25
 ADD #1

 2
 04/03/25
 POST BID ADD #1

24-096 JOB. NO. 02.14.2025 DATE

ISSUE

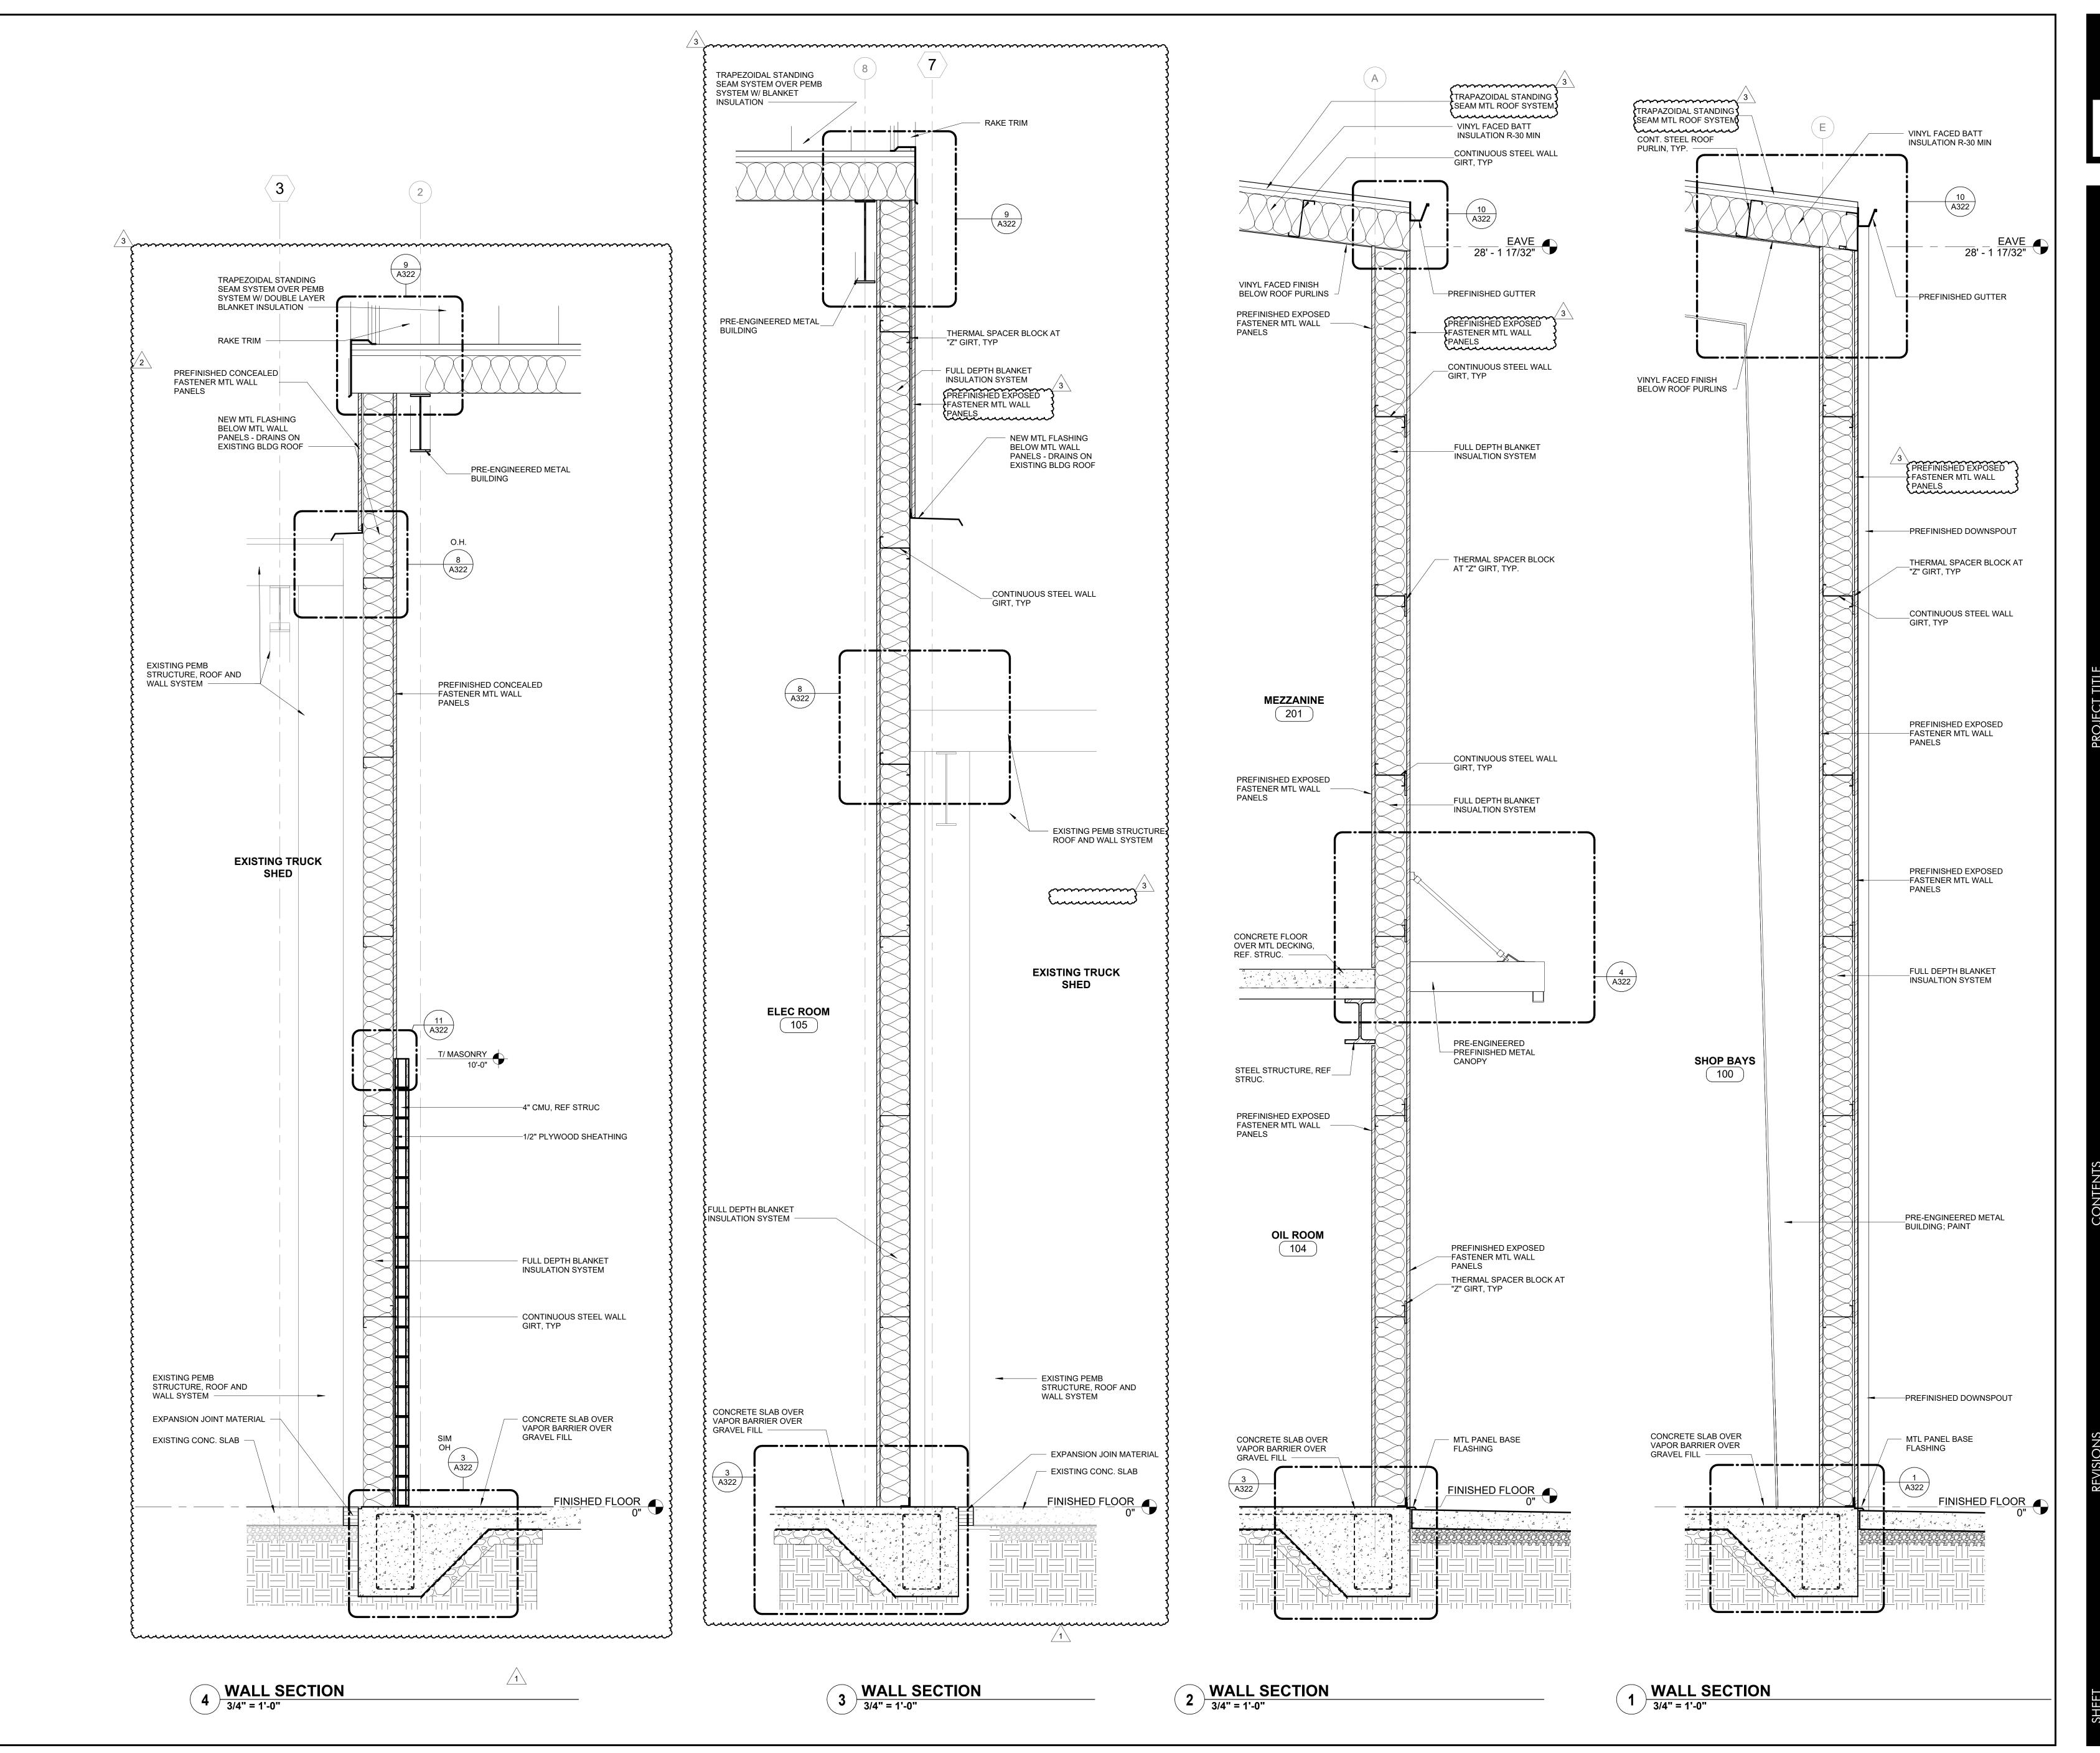

V D D ARCHITECTS

ARCHITECTS

ARCHITECTS

ARCHITECTS

DELONY

DAVIDSON, INC. 13

DAVIDSO

TRIC

ADDITION

24-096 JOB. NO.

02.14.2025

ISSUE





CRAIGHEAD ELECTRIC
MAINTENANCE SHOP ADDITION
4314 STADIUM BLVD.
JONESBORO, ARKANSAS

WALL SECTIONS

24-096
JOB. NO.
02.14.2025
DATE

ISSUE

NOT USED

1 FOUNDATION DETAIL
1 1/2" = 1'-0"

____REF ELEV.

FOUNDATION DETAIL1 1/2" = 1'-0"

3' - 0"

4 METAL CANOPY CONNECTION
1 1/2" = 1'-0"

V D D

ARCHITECTS



TRICON ITION

CRAIGHEAD ELECT
MAINTENANCE SHOP ADDI
4314 STADIUM BLVD.
JONESBORD ARKANSAS

KTERIOR DETAILS


NO. DATE DESCRIPTION
O4/03/25 POST BID ADD #1

24-096 B. NO.

OB. NO.
02.14.2025
DATE

ISSUE




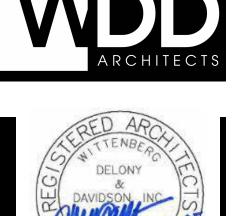



24-096 JOB. NO. 02.14.2025

ISSUE

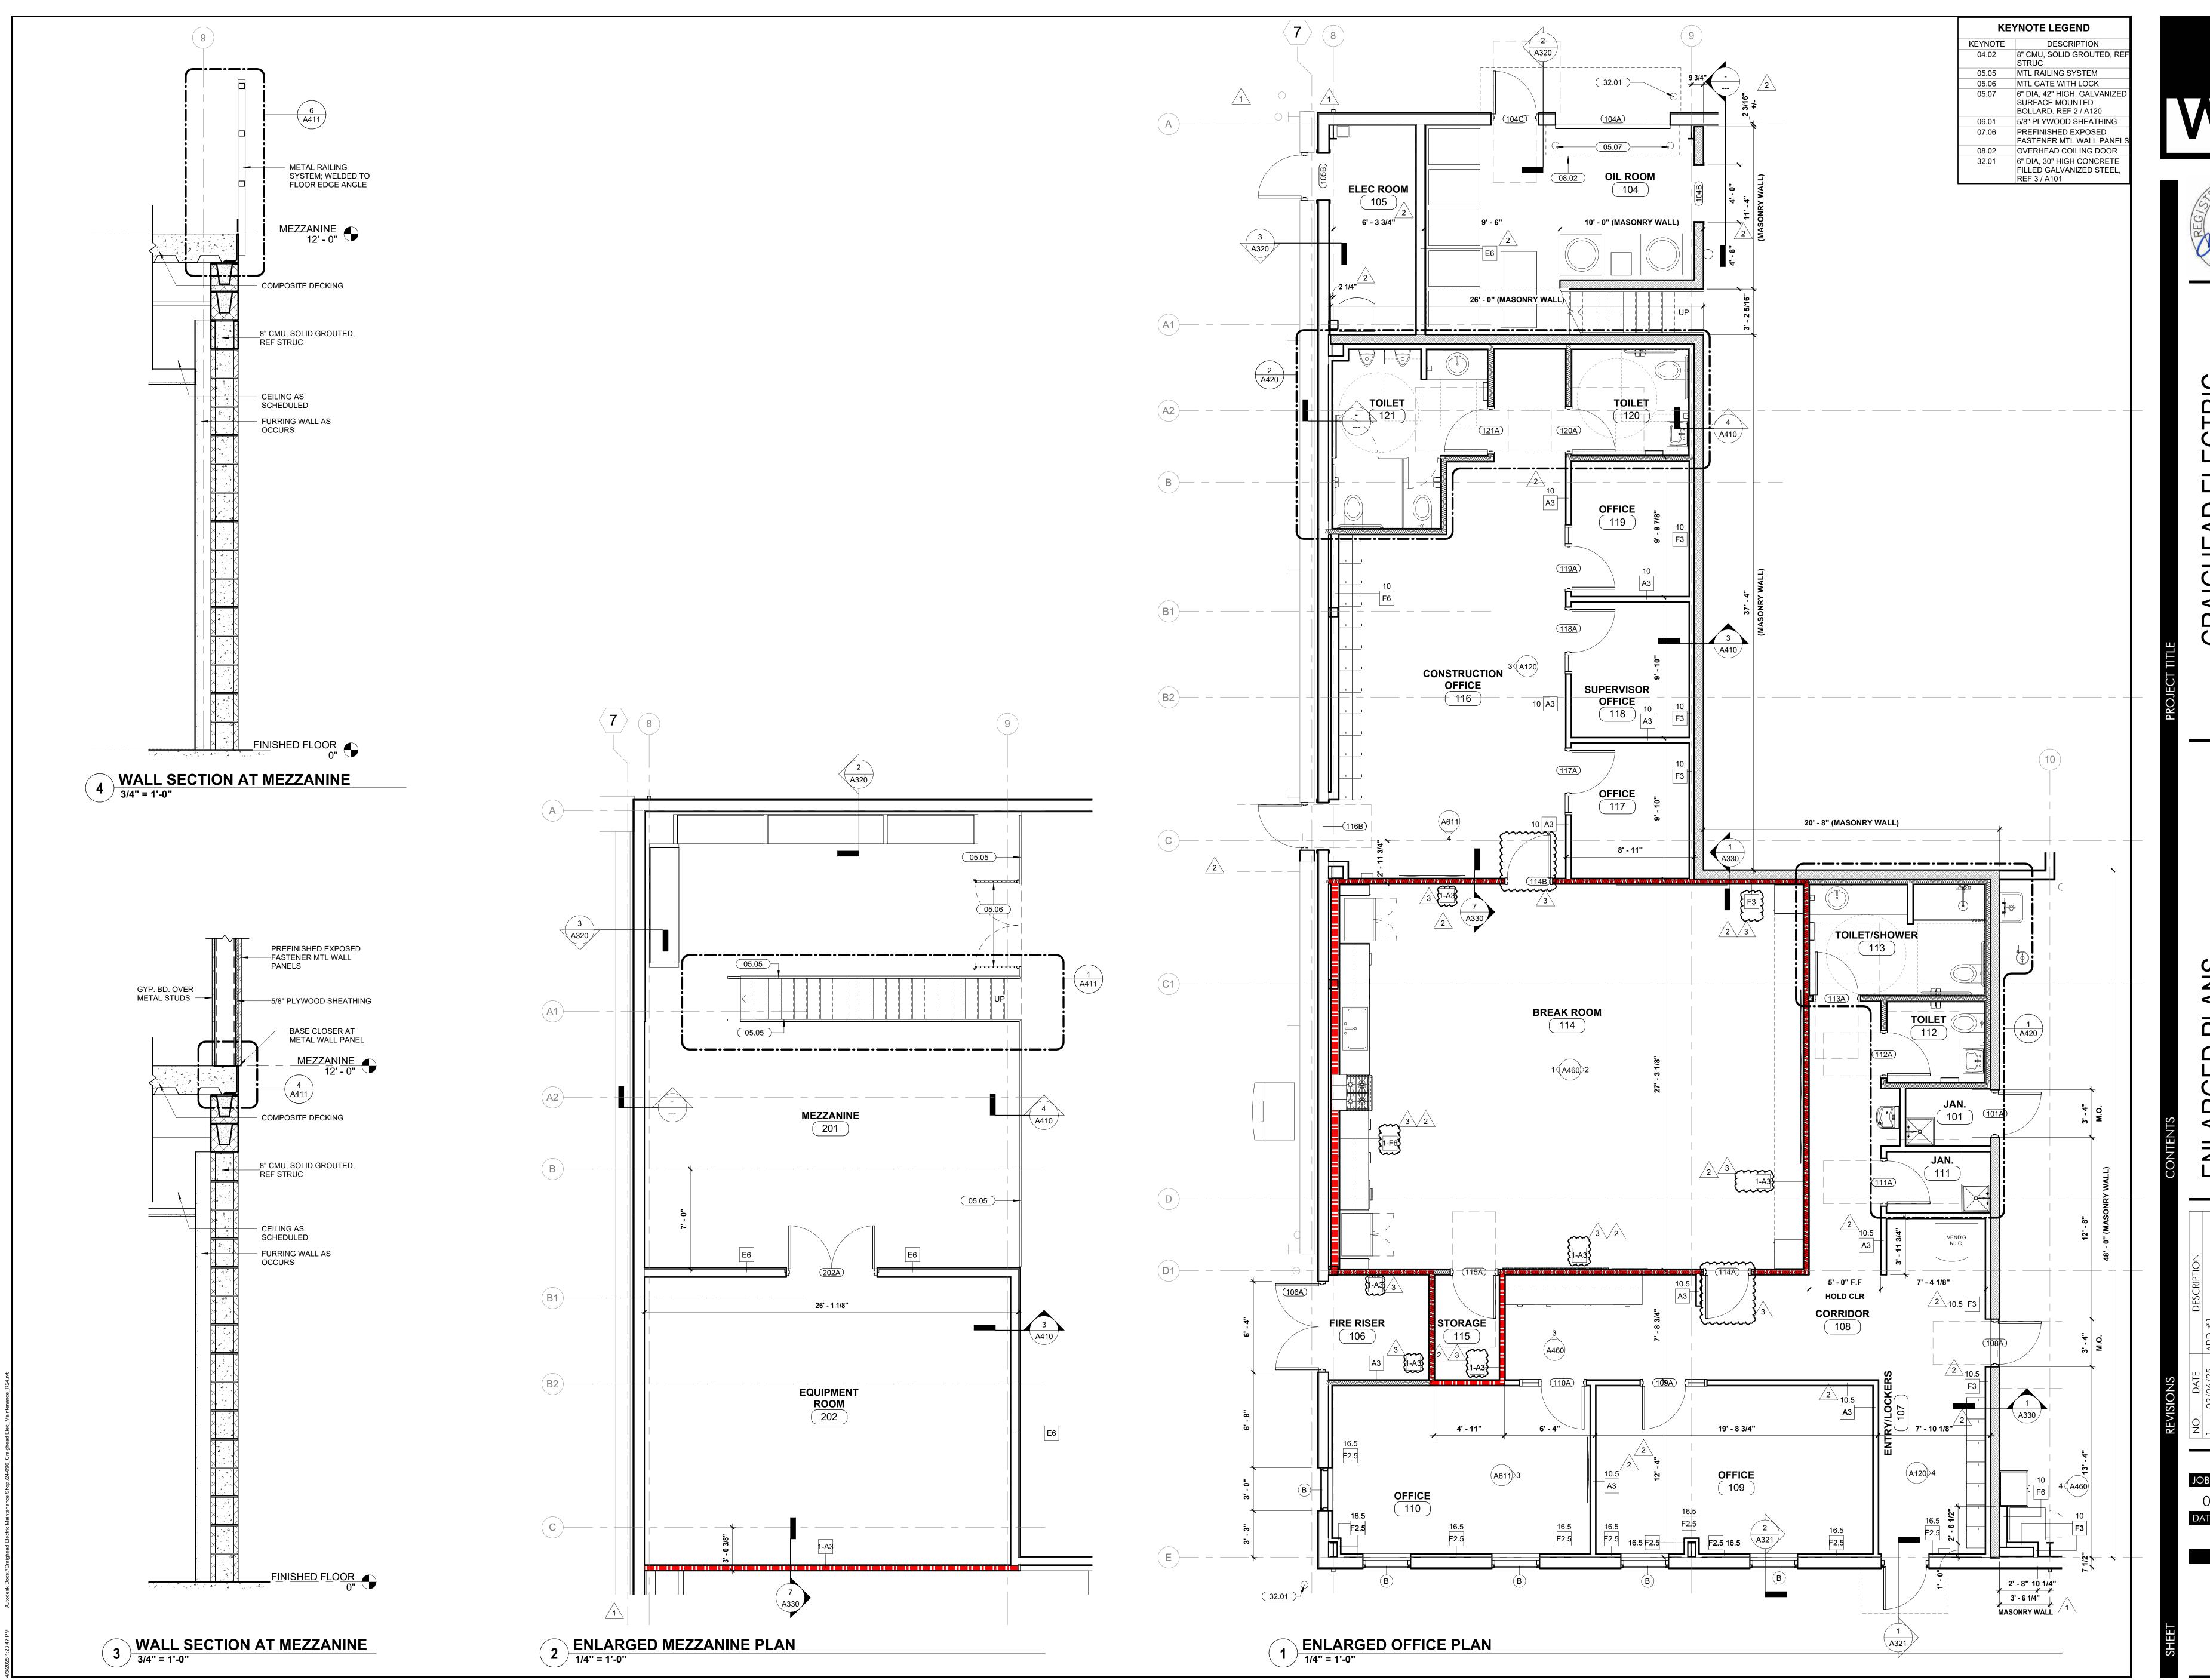

V D D


ARCHITECTS



2 03/10/25 ADD #2 3 04/03/25 POST BII

24-096 JOB. NO. 02.14.2025 DATE

ISSUE

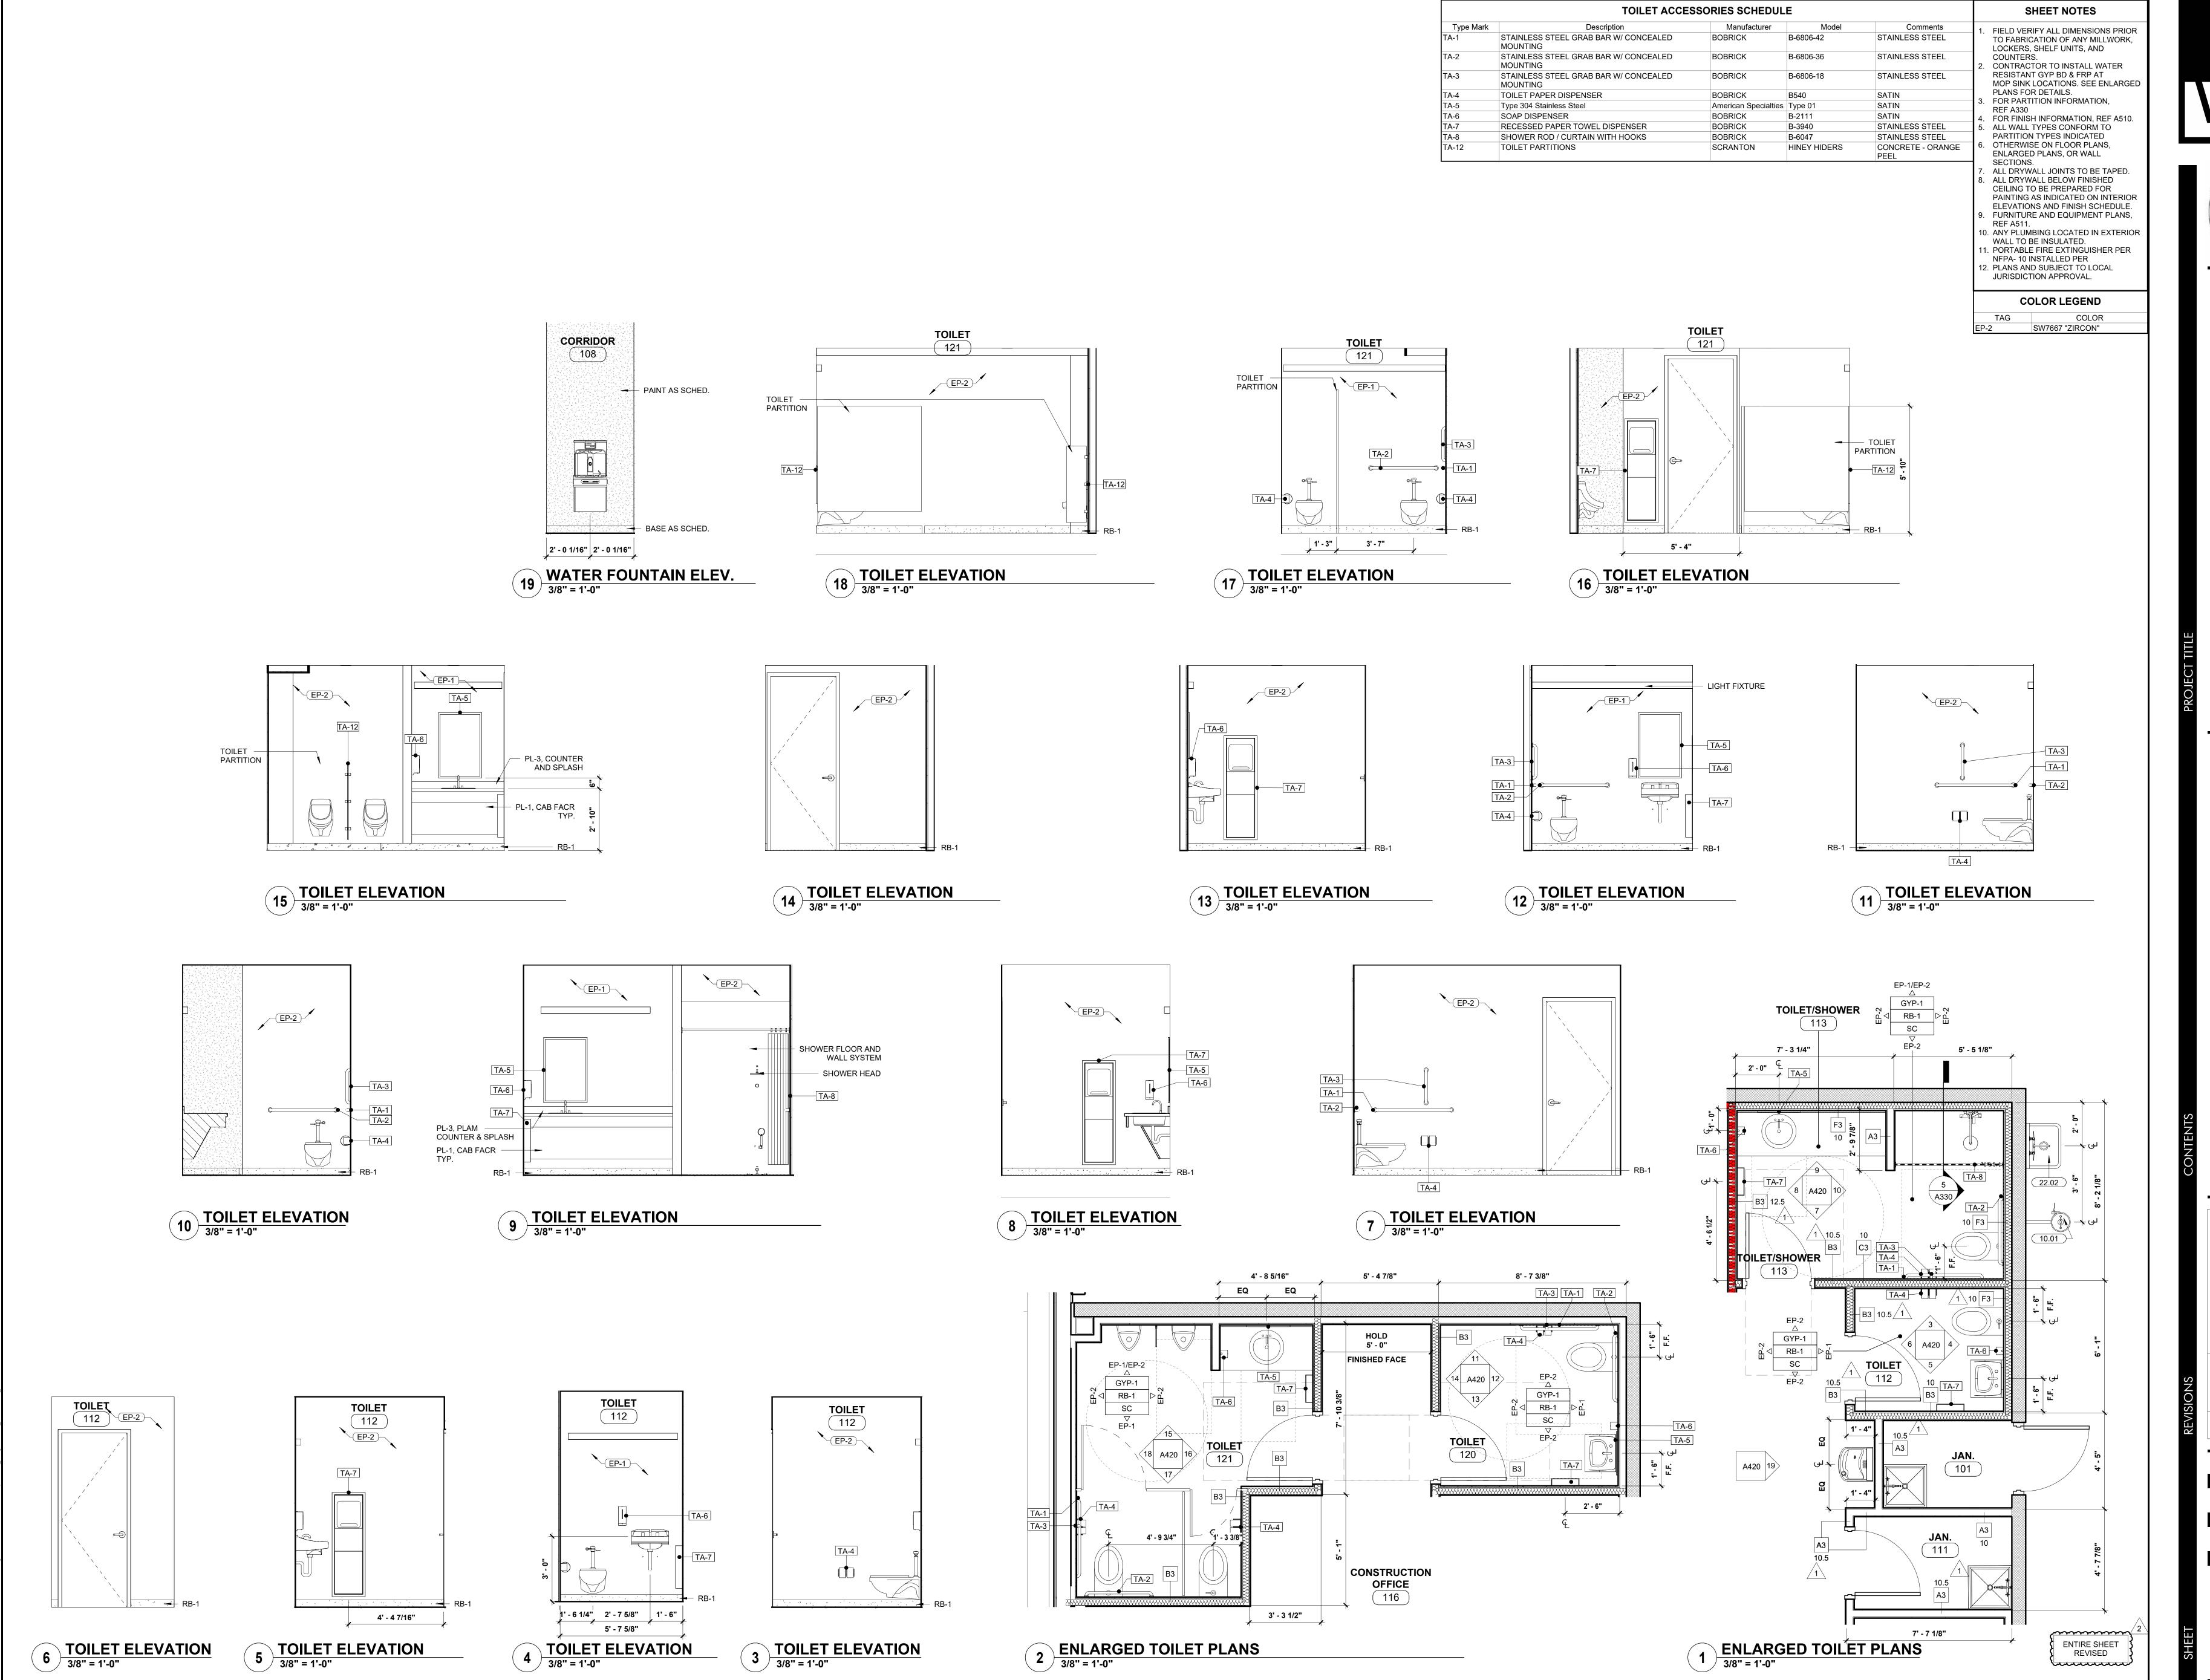



TRIC

ADDITION

CRAIGHEAL
MAINTENANCE

AND

ANS


ENLARGED TOILE ELEVATIONS



-096

24-096 JOB. NO. 02.14.2025 DATE

ISSUE

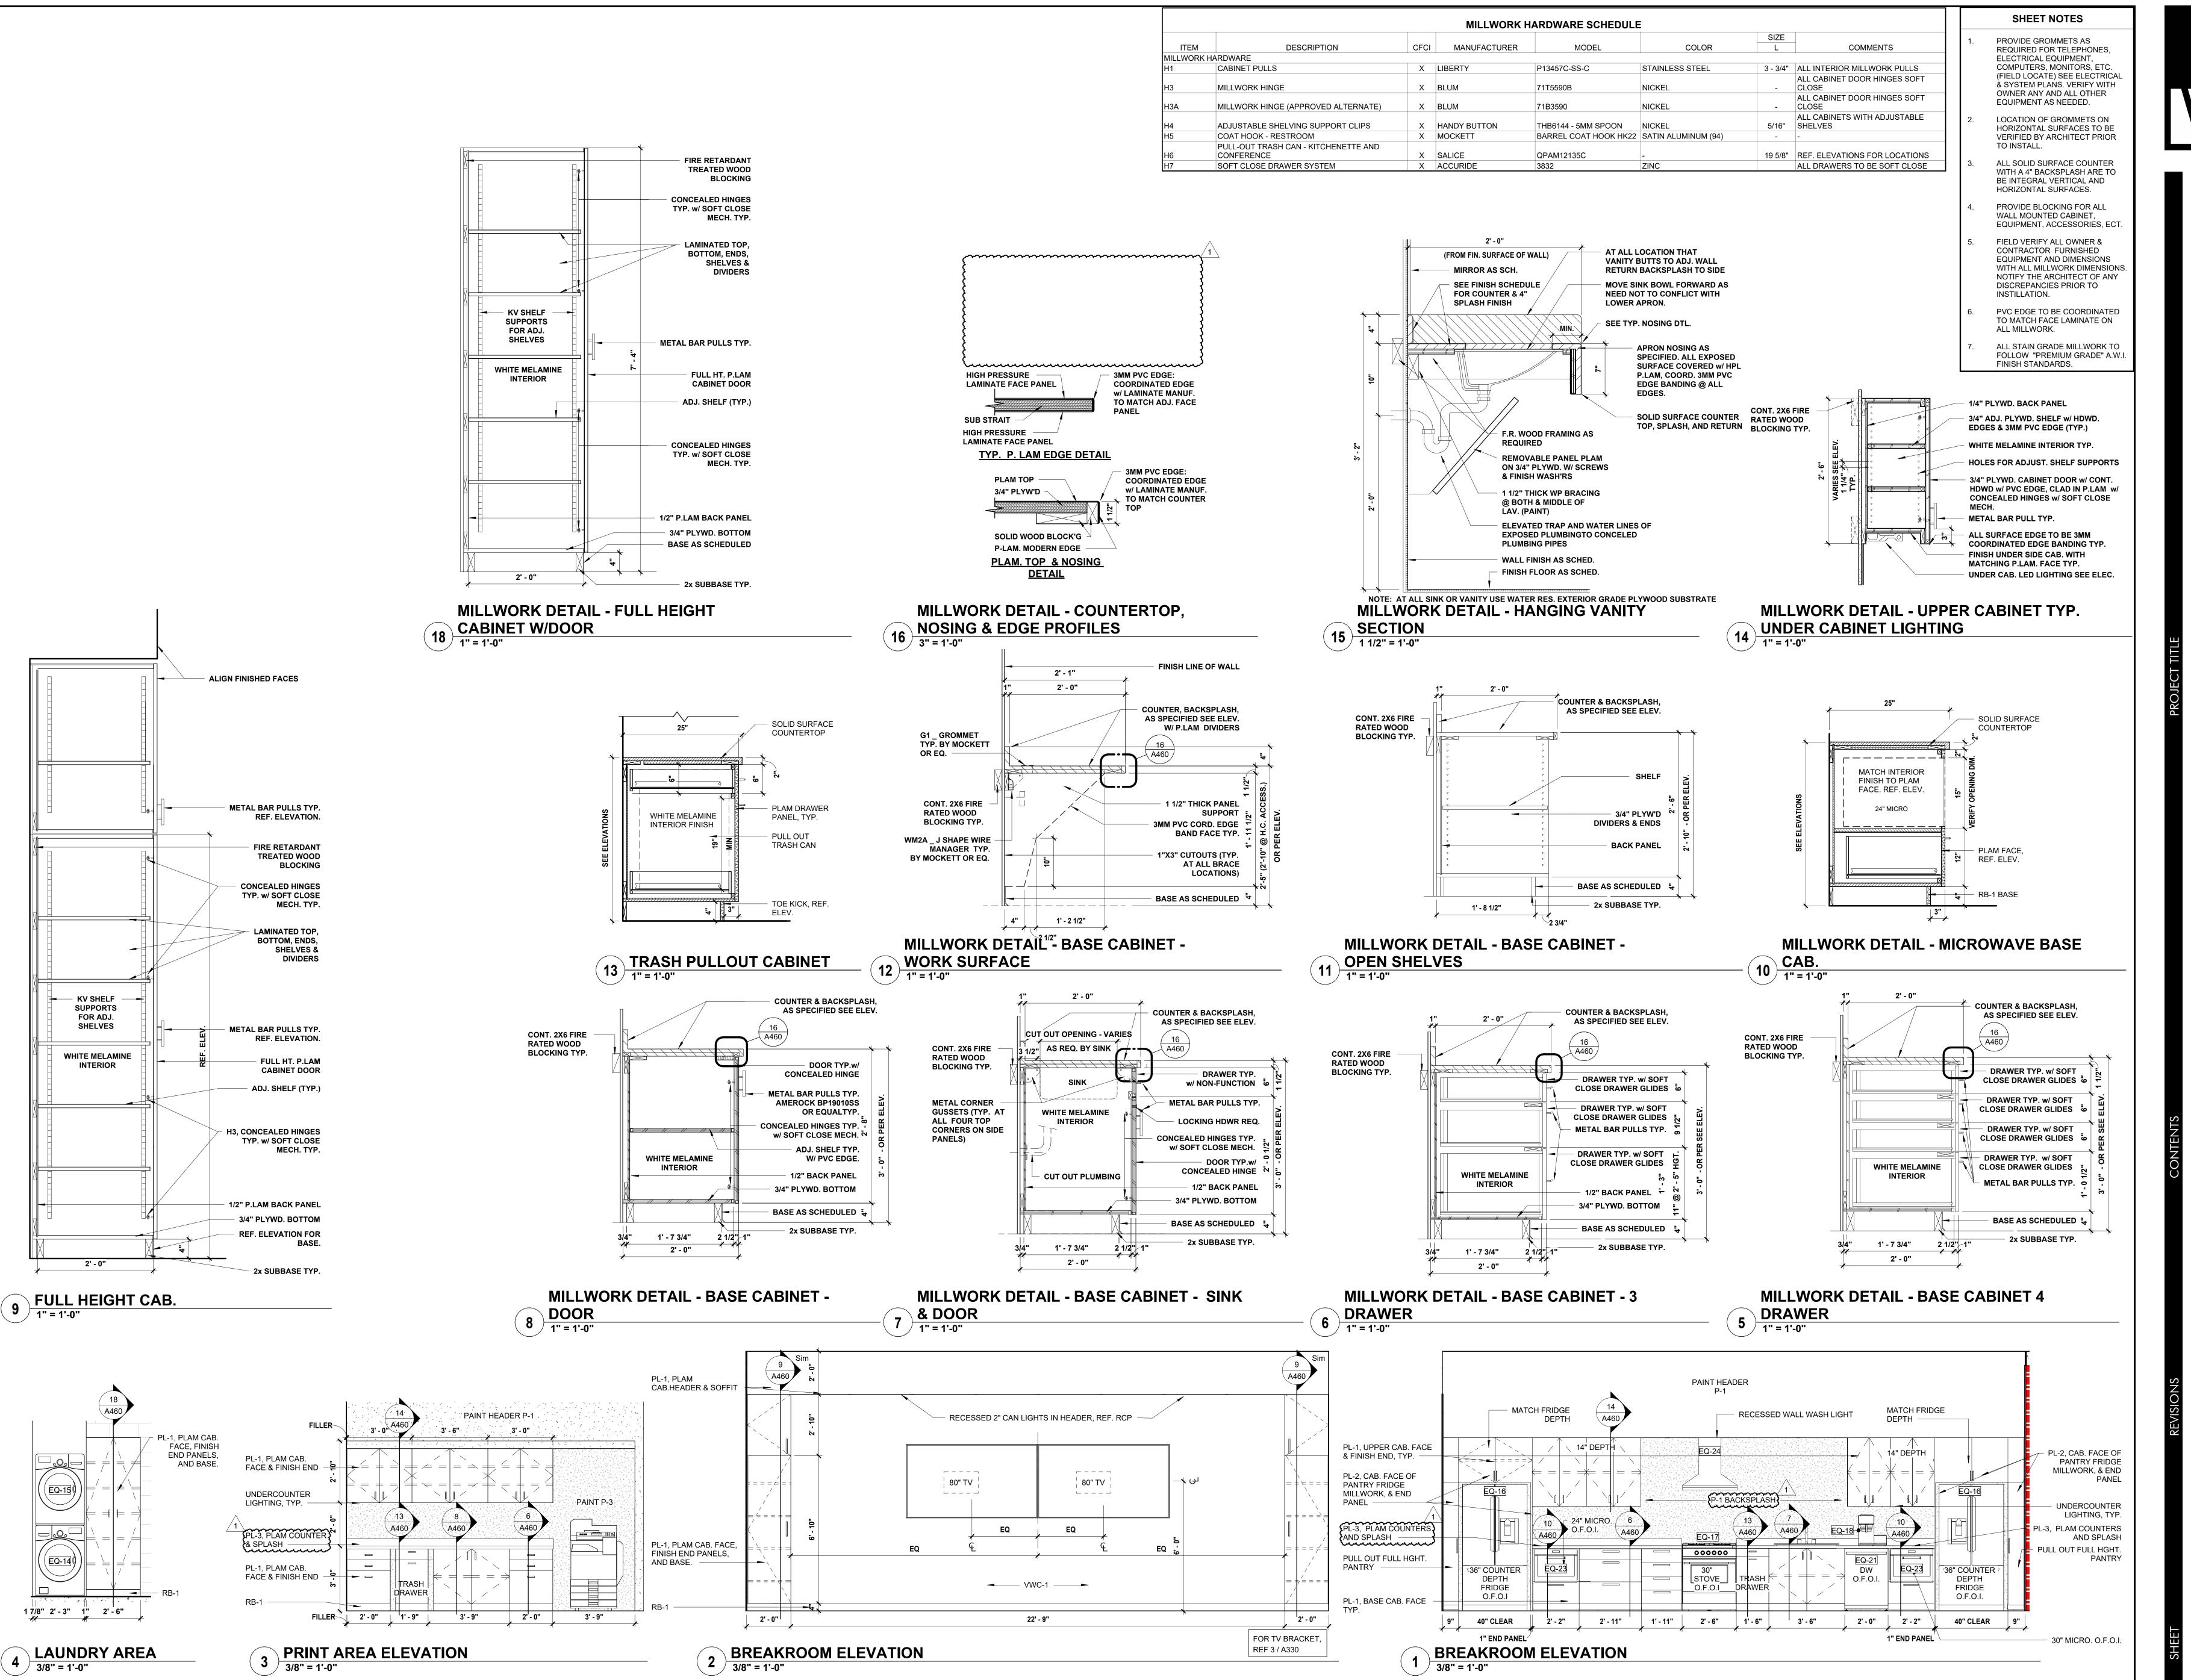





TRIC

ADDITION

24-096 JOB. NO. 02.14.2025

ERIOR E

INTE

ISSUE







AANSAS

CRAIGHEAD ELECTRIC
MAINTENANCE SHOP ADDITION
4314 STADIUM BLVD.
AND ARKANSAS

IISH SCHEDULE, PLAN TAILS


 NO.
 DATE
 DESCRIPTION

 03/10/25
 ADD #2

 04/03/25
 POST BID ADD #1

24-096 JOB. NO. 02.14.2025 DATE

ISSUE

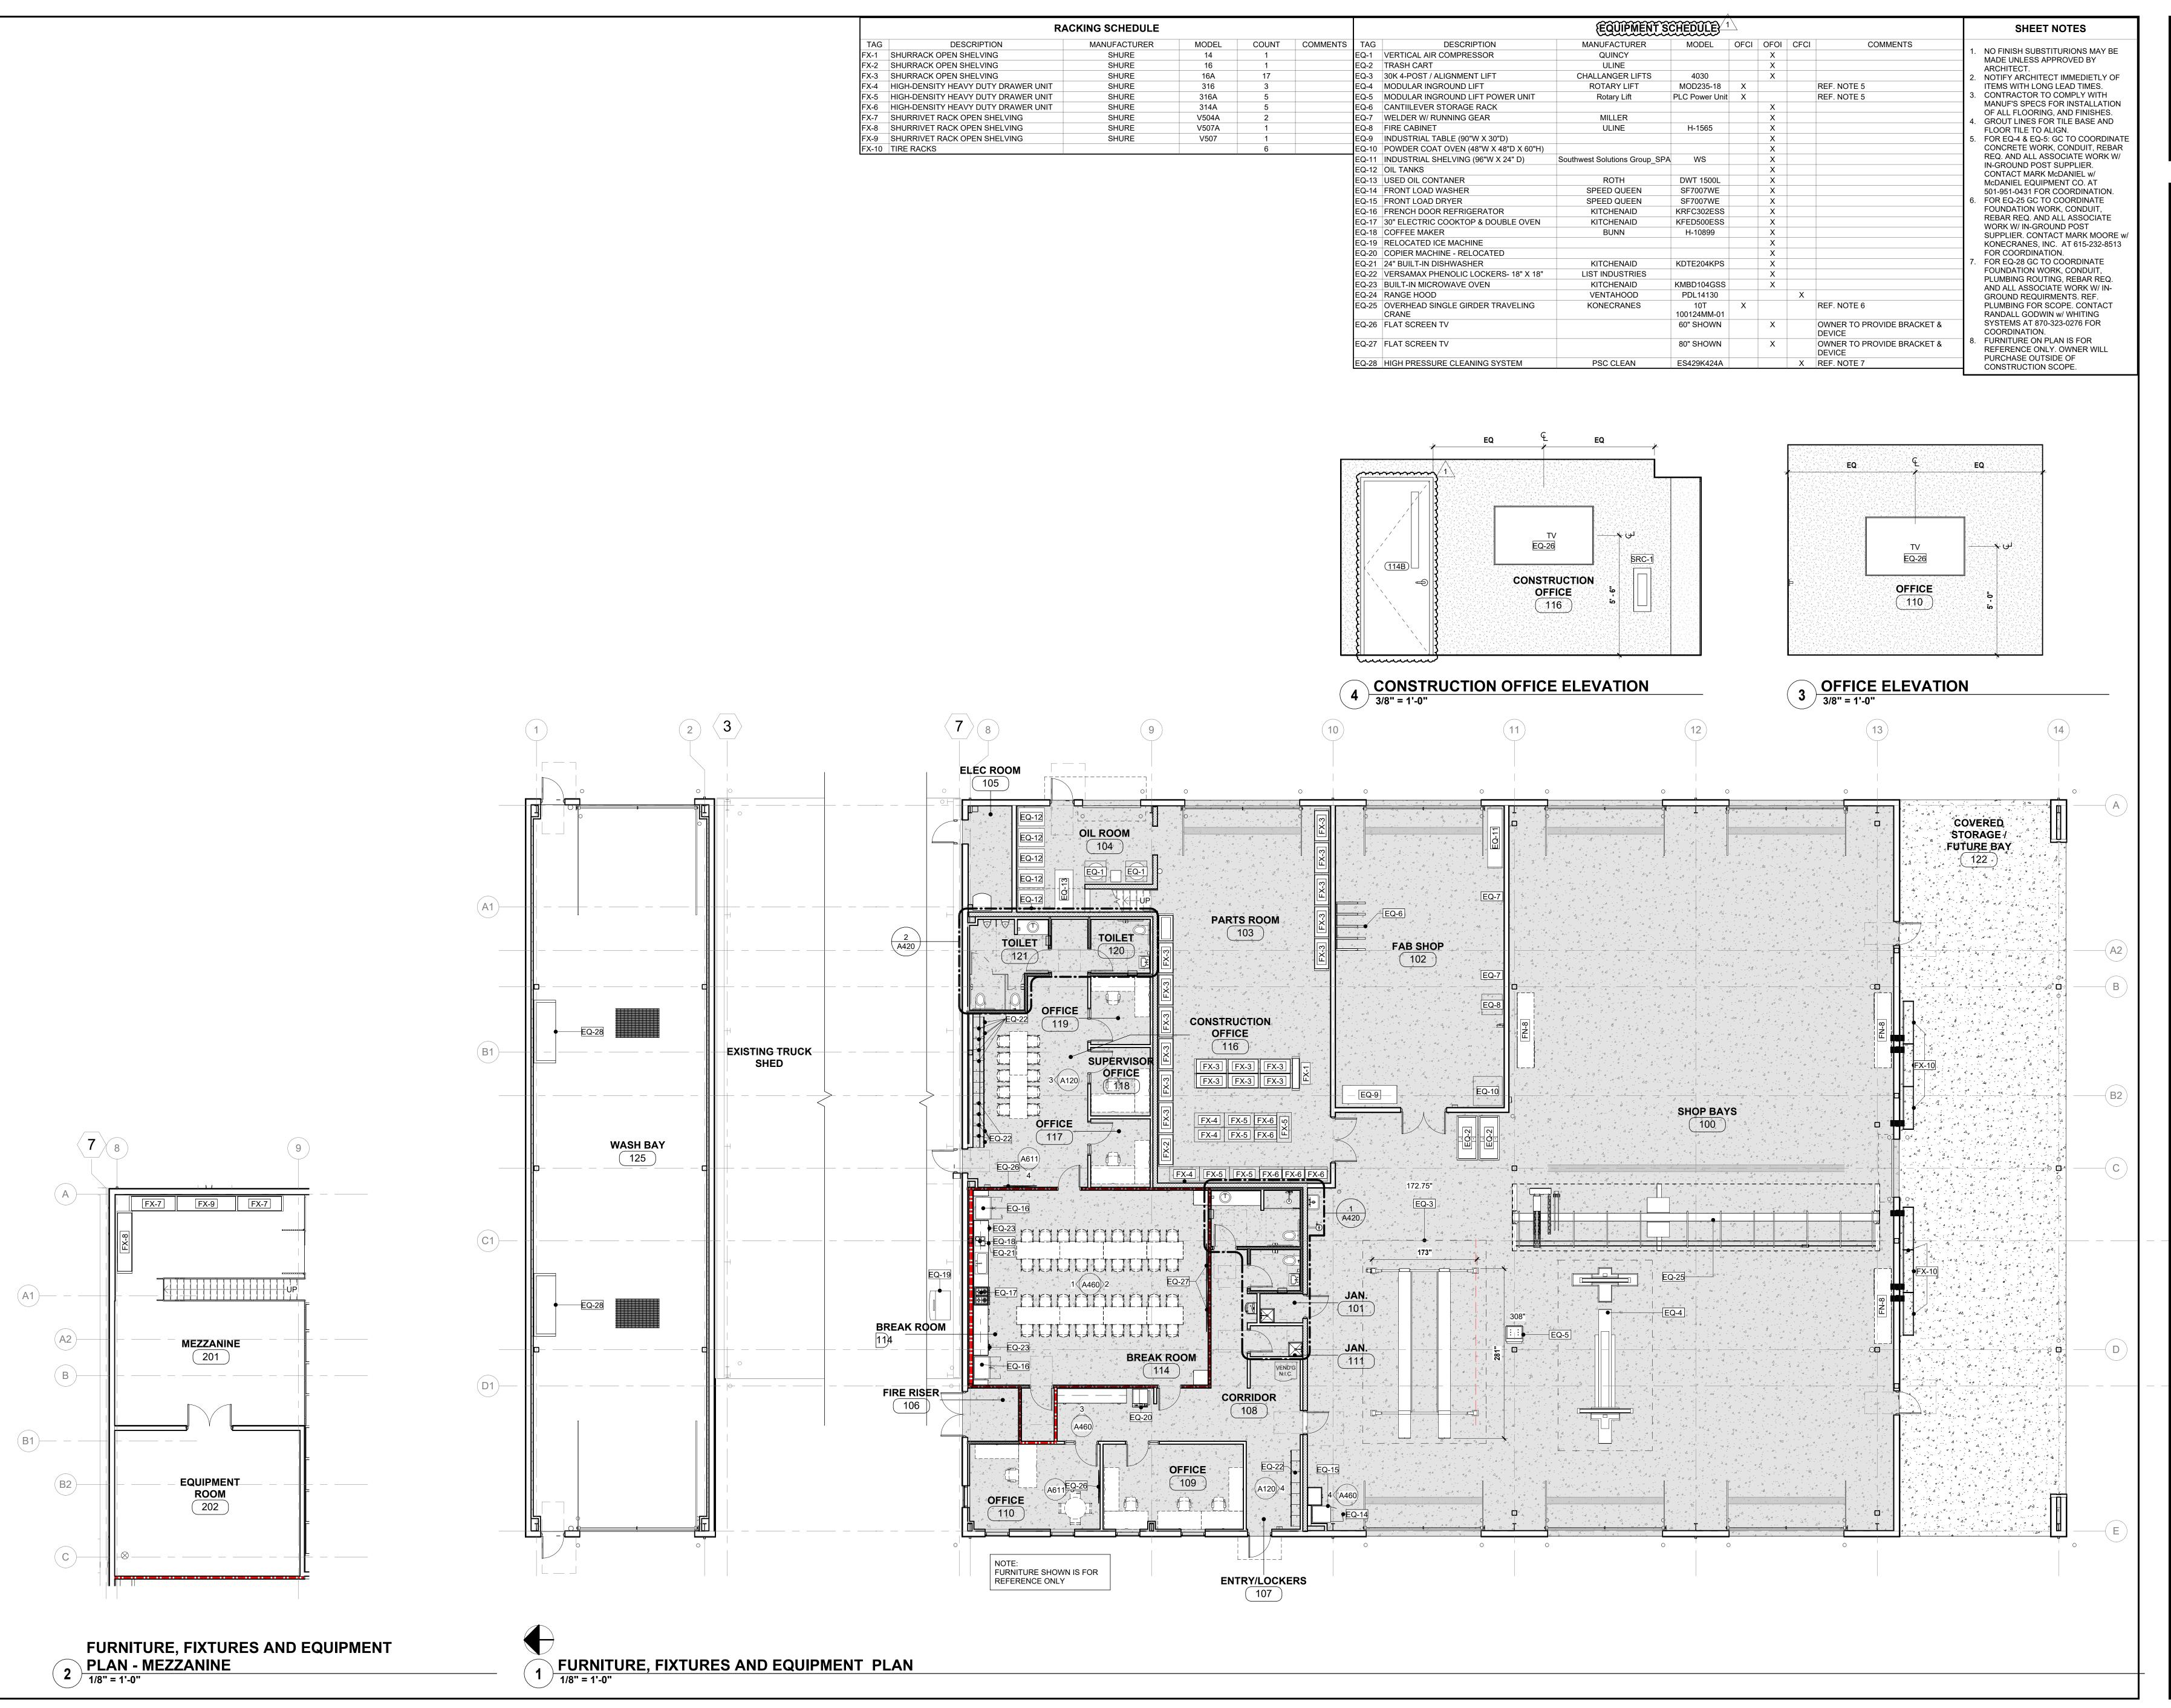








TRIC **ADDITION** CRAIGHEA MAINTENANCE

24-096 JOB. NO. 02.14.2025

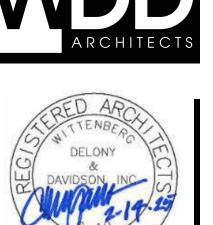



TRIC ADDITION

MAINTENANC :RAIGHE

OR OR EGEND, DOC & DETAILS WINDOW | SCHEDUL

24-096 JOB. NO. 02.14.2025

ISSUE

STRUCT	TURAL R	ISK CATEGORY:	II
GRAVITY LOA			
LIVE LO			
		OFFICE AREAS MECHANICAL ROOMS	50 psf 125 psf
R	OOF:	MINIMUM (NON-REDUCIBLE) MECHANICAL ROOF GROUND SNOW LOAD FLAT ROOF SNOW LOAD SNOW DRIFT LOAD (MAX) - SNOW LOAD IMPORTANCE FACTOR - SNOW EXPOSURE FACTOR - THERMAL FACTOR	20 psf N/A 21 psf 13 psf 50 psf Is = 1.0 Ce = 1.0 Ct = 1.0
DEAD LO		STRUCTURAL SLAB	70 psf
R	OOF:	DEAD & COLLATERAL PEMB ROOF SYSTEM	12 psf
LATERAL LOA	NDS:		
WIND			
E) W	XPOSUR (IND IMP	ID SPEED E DRTANCE FACTOR PRESSURE COEFFICIENT	115 mph B 1.00 +/- 0.18
SEISMIC			
SI	EISMIC IN	OCCUPANCY CATEGORY MPORTANCE FACTOR L RESPONSE COEFFICIENT	II le = 1.00 Ss = 1.56 S1 = 0.42
	ITE CLAS DJUSTED	SS O MC SPECTRAL RESPONSE	D (STIFF SOIL) Sms = 1.22 Sm1 = 0.41
DI	ESIGN SI	PECTRAL RESPONSE ACCELERATION	Sds = 0.81 Sd1 = 0.28
BA	ASIC SEI ESIGN BA SEISMI	ESIGN CATEGORY SMIC RESISTING SYSTEM ASE SHEAR C RESPONSE COEFFICIENT NSE MODIFICATION FACTOR	D MOMENT FRAME(S) (R=3.25) V = 0.024W Cs = 0.249 R = 3.25
1A	NALYSIS	PROCEDURE	EQUIVALENT LATERAL FORCE PROCEDURE

GENERAL STRUCTURAL NOTES

12. UNLESS SHOWN OR OTHERWISE NOTED, PROVIDE STANDARD HOOKS ON END OF ALL BARS EXCEPT THOSE LAPPED OR SPLICED TO A CONTINUING BAR. 13. AS PART OF CONCRETE WORK PROVIDE CONCRETE EQUIPMENT PADS, HOUSE KEEPING PADS, INERTIA BASES AND CURBS AS INDICATED ON ANY OF THE CONTRACT DRAWINGS UNLESS SPECIFIED TO BE PROVIDED UNDER OTHER DIVISIONS OF THE SPECIFICATION. UNLESS NOTED, DOWEL TO STRUCTURE BELOW WITH #4 x 0'-6" PROJECTING 3" FROM CONCRETE BELOW AT 12" O.C. EACH WAY AND REINFORCE W/ #4 @ 12" EACH WAY, TOP AND BOTTOM

14. CONCRETE EQUIPMENT PADS, INERTIA BASES AND CURBS NOT SHOWN ON THE CONTRACT DOCUMENTS FOR THIS BID PACKAGE ARE THE RESPONSIBILITY OF THE TRADE WHO'S EQUIPMENT BEARS ON THEM OR ATTACHES TO THEM.

15. SEE ARCHITECTURAL DRAWINGS FOR DOOR AND WINDOW OPENINGS, DRIP SLOWS, REGLETS, MASONRY ANCHORS, PRECAST BEARING LEDGES, AND FOR MISCELLANEOUS EMBEDDED PLATS, BOLTS, ANCHORS, ETC. 16. SELECT FORMWORK TO PRODUCE THE FINISH REQUIRED. WHERE FINISH IS NOT SPECIFIED, FORMWORK FOR EXPOSED SURFACES SHALL E ACI347R, CLASS A , AND FORMWORK FOR OTHER SURFACES SHALL BE ACI 347R, CLASS C. A SURFACE IS CONSIDERED EXPOSED IF THE CONCRETE TEXTURE CAN BE SEEN BY ANYONE IN THE COMPLETED STRUCTURE.

F. STRUCTURAL STEEL

4. CONNECTION DESIGN FORCES

1. ROLLED AND BUILT UP SECTIONS - W8'S THRU W36'S - A572 GRADE 50 - PIPES - A53 - 30 ksi - TUBES - A500 GRADE B - 46 ksi - BUILT-UP SHAPES - AS INDICATED - ALL ELSE - A36 - 36 ksi OR A572 GRADE 50

2. SPACE MEMBERS UNIFORMLY BETWEEN DIMENSIONED LOCATIONS

- WELD OR BOLT, UNLESS NOTED OTHERWISE - DESIGN CONNECTIONS NOT ENTIRELY DETAILED ON DRAWINGS - DETAILS SHOW THE RELATIONSHIP BETWEEN MEMBERS AND MAY GIVE LIMITATIONS OR CRITERIA TO BE USED IN DEVELOPING COMPLETE CONNECTION DESIGN AND DETAILS. USE CONNECTIONS FROM PART 4. AISC MANUAL, 9TH EDITION. FOR TS AND PIPE CONNECTIONS USE CONNECTIONS FROM AISC HOLLOW STRUCTURAL SECTIONS CONNECTIONS MANUAL. - MINIMUM THICKNESS: ANGLES 5/16" PLATES 3/8"

- BEAM CONNECTIONS 1) IF SHOWN, USE 110% OF THE REACTION OF THE DRAWINGS BUT NOT LESS THAN 10 kips. 2) IF NO REACTION IS SHOWN, USE 55% OF TOTAL ALLOWABLE UNIFORM LOAD CAPACITY FROM THE AISC TABLES FOR ALLOWABLE LOADS ON BEAMS BUT NOT LESS THAN 10 kips.

5. BOLTED CONNECTIONS - MINIMUM BOLT DIAMETER, 3/4" UNLESS NOTED. - TWO BOLTS MINIMUM PER CONNECTED MEMBER. - USE A325SC OR A490SC BOLTS FOR BRACING, MOMENT CONNECTIONS, CANTILEVERS, TENSIONS MEMBERS AND AT OVERSIZED OR SLOTTED HOLES WHERE THE FORCE ON THE JOINT IS PARALLEL TO THE LONG AXIS OF THE SLOT, USE A25N OR A490N ELSEWHERE. - FOR BEAM TO COLUMN CONNECTION, USE SHORT OR LONG SLOTTED HOLES AND FULLY TENSIONED BOLTS, EXCEPT USE SC BOLTS AT MOMENT CONNECTIONS. - OVERSIZED AND LONG SLOTTED HOLES PERMITTED ONLY WHERE SHOWN OR NOTED.

WELDED CONNECTIONS: AISC MINIMUM, BUT NOT LESS THAN 3/16", UNLESS NOTED - GROOVE WELDS: FULL PENETRATION, UNLESS NOTED OTHERWISE

- WELDS ARE CONTINUOUS UNLESS NOTED OTHERWISE

G. EMBEDDED ITEMS:

1. DO NOT EMBED PIPES, TUBES, WIRES, CONDUIT, DUCTS, OR CAVITY CREATING NON-STRUCTURAL ITEMS IN CONCRETE.

1. ANCHORS NOT SHOWN ON THE STRUCTURAL DRAWINGS SHALL BE PROVIDED BY THE TRADE CONTRACTOR ATTACHING TO THE ANCHOR.

2. DETERMINING THE INSTALLED CAPACITY OF ANCHORS WHICH ARE NOT SHOWN ON THE STRUCTURAL DRAWINGS IS THE RESPONSIBILITY OF THE TRADE CONTRACTOR ATTACHING TO THE ANCHOR. 3. LOCATING AND MISSING EMBED ITEMS IN CONCRETE IS THE RESPONSIBILITY OF THE TRADE CONTRACTOR ATTACHING TO THE ANCHOR.

I. SUPPORT AND BRACING OF WORK NOT SHOWN ON STRUCTURAL DRAWINGS:

1. SUPPORTS, BRACING, SUB-FRAMING, LIGHT GAGE FRAMING, MISCELLANEOUS STEEL, BRACKETS. CONNECTORS, AND ATTACHMENTS NOT SHOWN ON THE STRUCTURAL DRAWINGS ARE THE CONTRACTOR'S RESPONSIBILITY AND SHALL BE ENGINEERED AND PROVIDED BY THE TRADE CONTRACTOR WITH ITEMS BEING SUPPORTED OR BRACED AT THE TRADE CONTRACTOR'S EXPENSE

2. IF STRUCTURAL DRAWINGS REFERENCED BY OTHER DRAWINGS FOR ITEMS NOT FULLY DEFINED ON STRUCTURAL DRAWINGS (AND ASSOCIATED SPECIFICATIONS) THEN ENGINEER AND PROVIDE SUCH ITEMS ON A PERFORMANCE BASIS IN COMPLIANCE WITH THE GOVERNING BUILDING CODE. ALL COSTS SHALL BE BORN BY THE TRADE CONTRACTOR ATTACHING TO OR BEARING UPON SUCH ITEMS.

3. SUPPORT AND BRACING SYSTEMS SHALL NOT TRANSMIT LATERAL LOADS TO COLUMNS BETWEEN FLOORS OR TO THE BOTTOMS OR SIDES OF STEEL BEAMS OR JOISTS. IF OTHER CONTRACT DRAWINGS INDICATE BRACING OR ATTACHMENT DETAILS WHICH WOULD RESULT IN LATERAL LOADS BEING TRANSMITTED TO THE SIDE OF COLUMNS BETWEEN FLOORS OR TO THE BOTTOMS OR SIDES OF BEAMS OR JOISTS THEN THE TRADE CONTRACTOR RESPONSIBLE FOR THE ITEMS TRANSMITTING SUCH LATERAL LOADS INCLUDE THE COST IN HIS BID FOR ENGINEERING AND PROVIDING BRACING TO THE TOP OF FLANGE OF THE NEXT ADJACENT BEAM OR JOIST.

FACADE AND WALL SYSTEMS ATTACHMENTS TO THE STRUCTURE:

- SHALL NOT ASSUME THE STRUCTURE PROVIDES MOMENT RESISTANCE AT THE POINT OF ATTACHMENT. - SHALL BE TO THE EDGE OF THE FLOOR SLAB OR ROOF DECK ONLY UNLESS NOTED ONT THE STRUCTURAL - SHALL NOT RESTRICT INDEPENDENT VERTICAL OR LATERAL MOVEMENT OF THE BUILDING LEVELS.

fc - 3	3,000 psi		SPLICE L	ENGTH (ir	1)
10 – 0	,000 psi	TOP I	BARS	OTHER	RBARS
BAR	LAP	(alpha	= 1.3)	(alpha	= 1.0)
SIZE	CLASS	CASE 1	CASE 2	CASE 1	CASE 2
#3	Α	22	33	17	25
	В	28	42	22	33
#4	Α	29	43	22	33
	В	38	56	29	43
#5	Α	36	54	28	42
	В	47	70	36	54
#6	Α	43	65	33	50
	В	56	84	43	65
#7	Α	63	94	48	72
	В	81	122	63	94
#8	Α	72	107	55	83
	В	93	139	72	107
#9	Α	81	121	62	93
	В	105	157	81	121
#10	Α	91	136	70	105
	В	118	177	91	136
#11	Α	101	151	78	116
	В	131	196	101	151

fc = /	1,000 psi		SPLICE L	ENGTH (ir	1)
10	+,000 psi	TOP	BARS	OTHER	RBARS
BAR	LAP	(alpha	ı = 1.3)	(alpha	= 1.0)
SÍŽÈ	CLASS	CASE 1	CASE 2	CASE 1	CASE 2
#3	А	19	28	15	22
	В	25	37	19	28
#4	Α	25	37	19	29
	В	33	49	25	37
#5	Α	31	47	24	36
	В	41	61	31	47
#6	Α	37	56	29	43
	В	49	73	37	56
#7	Α	54	81	42	63
	В	71	106	54	81
#8	Α	62	93	48	72
	В	81	121	62	93
#9	Α	70	105	54	81
	В	91	136	70	105
#10	Α	7 9	118	61	91
	В	102	153	79	118
#11	Α	87	131	67	101
	В	114	170	87	131

GENERAL SIGN REQUIREMENTS. 10. IF A DIFFERENT ELEVATOR IS SELECTED SUCH THAT FRAMING AND/OR FOUNDATION CHANGES ARE REQUIRED, INCLUDE AN ALLOWANCE FOR THE ENGINEER TO REDESIGN TO ACCOMMODATE THE ELEVATOR 11. PRIOR TO STARTING SHOP DRAWINGS, ORDERING MATERIAL, AND PRIOR TO FABRICATION: a. CHECK ALL DIMENSIONS AGAINST REQUIREMENTS OF OTHER CONTRACT DOCUMENTS b. ARCHITECTURAL DIMENSIONS GOVERN

> 12. RESOLVE APPARENT DEFICIENCIES, OMISSIONS, CONTRADICTION, AND AMBIGUITIES IN CONTRACT DOCUMENTS WITH ARCHITECT/ENGINEER BEFORE AFFECTED WORK PROCEEDS. FOR BID PURPOSES USE THE INTERPRETATIONS RESULTING IN THE GREATEST COST.

13. NO MODIFICATION, ALTERATION, CORRECTION, OR REPAIR SHALL BE MADE WITHOUT PRIOR REVIEW AND ACCEPTANCE OF STRUCTURAL ENGINEER. SUBMIT DETAILS AND CALCULATIONS PREPARED BY A PROFESSIONAL ENGINEER REGISTERED IN THE STATE WHERE THE PROJECT IS LOCATED AND EMPLOYED BY THE CONTRACT. ARCHITECTURAL/ENGINEER REVIEW IS CONTRACTOR' EXPENSE.

D. FOUNDATION & EARTHWORK:

A. SPECIAL INSPECTIONS:

AND BRACES.

C MISCELLANEOUS:

CONNECTIONS ARE IN PLACE.

SPECIFIED IN SECTION 014533 (IBC).

THAT DO NOT PASS THE INSPECTIONS OR TESTS.

UNTIL ALL PERMANENT BRACING ELEMENTS ARE INSTALLED.

AND WELDING AND/OR BOLTING INSPECTION IS COMPLETE.

SHOWN AT CORRESPONDING PLACES SHALL BE REPEATED.

1. QUALIFIED INSPECTORS SHALL CONDUCT SPECIAL INSPECTIONS AND TEST AND FURNISH REPORTS AS

2. THE CONTRACTOR SHALL COORDINATE THE SPECIAL INSPECTIONS AND TESTING SERVICES WITH THE

USED IN THE SCHEDULE OF SPECIAL INSPECTION SERVICES IN SECTION 014533 (IBC).

B. STABILITY DURING CONSTRUCTION, SHORING, AND TEMPORARY STRUCTURES:

CONTRACT. THE DESIGN SHALL BE DONE BY A REGISTERED PROFESSIONAL ENGINEER.

6. COMPLY WITH OSHA SAFETY STANDARDS FOR ERECTION OF THE BUILDING FRAME.

THE DECK WILL NOT REQUIRE FRAMING UNLESS THE OPENING EXCEEDS 10 IN DIAMETER.

WITH OTHER CONSTRUCTION DOCUMENT REQUIREMENTS OR REGULATORY REQUIREMENTS.

PROGRESS OF THE WORK, PROVIDE THE APPROPRIATE DOCUMENTATION AND PERFORM OTHER TASKS AS

3. THE CONTRACTOR IS RESPONSIBLE FOR ALL OTHER INSPECTIONS OR TESTS IN THE SPECIFICATIONS, NOT

4. THE CONTRACTOR IS RESPONSIBLE FOR THE COST OF REPAIR, REINSPECTION AND RETESTING FOR ITEMS

5. SPECIAL INSPECTION SERVICES DO NOT RELIEVE THE CONTRACTOR OR RESPONSIBILITY FOR COMPLIANCE

. PERMANENT STABILITY OF THE BUILDING AND COMPONENTS IS NOT PROVIDED UNTIL ALL THE STRUCTURAL ELEMENTS ARE INSTALLED AS SHOWN ON THE CONTRACT DRAWINGS; PROVIDE STABILITY TO ALL NON-SELF

SUPPORTING ELEMENTS AND SAFETY TO ALL WORKERS, ANIMALS AND PROPERTY DURING CONSTRUCTION AND

2. WHERE SHORING AND/OR TEMPORARY STRUCTURES ARE REQUIRED IN ORDER TO SATISFY THE CONTRACT

REQUIREMENTS; TEMPORARY STRUCTURES SHALL BE DESIGNED AND BUILT WITHOUT EXTRA COST TO THE

3. BRACING USED TO STABILIZE THE BUILDING DURING THE ERECTION PROCESS SHALL BE DESIGNED TO NOT

4. THE TEMPORARY BRACING USED TO STABILIZE THE BUILDING DURING THE ERECTION PHASE SHALL BE

DESIGNED FOR LOADS AS REQUIRED BY THE APPLICABLE CODES. THE DESIGN OF THE BRACING SHALL TAKE

5. THE ANCHOR RODS FOR STEEL COLUMNS ARE NOT DESIGNED TO STABILIZE STRUCTURE BY PROVIDING

INTO ACCOUNT ADDITIONAL FORCES DUE TO THERMAL CONTRACTION AND EXPANSION OF THE BUILDING FRAME

FIXITY OF THE COLUMN BASE DURING ERECTION OF THE STEEL. PROVIDE TEMPORARY BRACING FOR STABILITY DURING THE ERECTION PHASE AND UNTIL ALL GRAVITY AND LATERAL LOAD RESISTING ELEMENTS ARE IN PLACE

STRUCTURAL DRAWINGS SHALL BE USED IN CONJUNCTION WITH DRAWINGS RELATING TO OTHER TRADES.

2. PRINCIPAL OPENINGS THROUGH THE FRAMING ARE SHOWN ON THESE DRAWINGS. EXAMINE THE DRAWINGS FOR REQUIRED OPENING AND PROVIDE FOR ALL OPENINGS WHETHER SHOWN ON THESE DRAWINGS ARE NOT,

3. WORK NOT INDICATED ON PART OF THE DRAWING BUT REASONABLY IMPLIED TO BE SIMILAR TO THAT

5. ALL DIMENSIONS SHALL TAKE PRECEDENCE OVER SCALE SHOWN ON PLANS, SECTIONS AND DETAILS.

6. INSURE THAT ALL CONSTRUCTION LOADS DO NOT EXCEED THE DESIGN LIVE LOADS INDICATED ON THE

4. LOADING FOR MECHANIC ROOMS ARE BASED ON THE WEIGHTS OF ASSUMED EQUIPMENT AS INDICATED

IN TYPE. SIZE OR NUMBER OF PIECES OF EQUIPMENT SHALL BE REPORTED TO THE ARCHITECT/ENGINEER FOR

VERIFICATION OF THE ADEQUACY OF SUPPORTING MEMBERS PRIOR TO THE PLACEMENT OF SUCH EQUIPMENT.

STRUCTURAL DRAWINGS AND THAT THESE LOADS ARE NOT PUT ON THE STRUCTURAL MEMBERS PRIOR TO THE

TIME THAT THE CONCRETE REACHES THE FULL DESIGN STRENGTH AND ALL FRAMING MEMBERS AND THEIR

7. THE DETAILS SHOWN AND DESIGNATED AS "TYPICAL DETAILS" APPLY GENERALLY TO THE DRAWINGS IN ALL

AREAS WHERE CONDITIONS ARE SIMILAR TO THOSE DESCRIBED IN THE DETAILS UNLESS NOTED OTHERWISE.

8. THE DETAILS ON THE CONTRACT DRAWINGS SHALL NOT BE REVISED WITHOUT PRIOR APPROVAL BY THE ARCHITECT/ENGINEER. IF PERMITTED, THE REVISED DETAILS AND CALCULATIONS SHALL BE DONE ONLY BY A

9. PROVIDE SIGNS AT ROOMS/FLOORS POSTED IN A CONSPICUOUS LOCATION INDICATING THE FLOOR LIVE

TO THE REQUIREMENTS OF THE BUILDING CODE AND THE BUILDING INSPECTOR. SEE SPECIFICATION FOR

LOAD CAPACITY AS STATED IN THE DESIGN CRITERIA SECTION OF THIS DRAWING. THE SIGNS SHALL CONFORM

LICENSED PROFESSIONAL ENGINEER AND SUBMITTED TO THE ARCHITECT/ENGINEER FOR APPROVAL.

CHECK AND COORDINATE DIMENSIONS, CLEARANCES, OPENINGS, PIPE SLEEVES, CURBS, ETC. WITH THE WORK OF

AND VERIFY SIZE AND LOCATION OF AL OPENINGS WITH ALL SUB-CONTRACTORS. NOMINAL PIPE SLEEVES THROUGH

ON THE MECHANICAL DRAWINGS (INCLUDING THE WEIGHT OF CONCRETE PADS, WHERE INDICATED). ANY CHANGES

TWIST OR DISTORT MEMBERS. SPECIFICALLY, IF CABLES ARE USED THEY SHALL BE ATTACHED TO THE CENTER OF THE COLUMN AND NOT WRAPPED AROUND THE COLUMN IN A MANNER THAT WILL TWIST THE COLUMN.

SPECIFIED IN SECTION 014533 AND IN ACCORDANCE WITH CHAPTER 17, INTERNATIONAL BUILDING CODE.

1. FOUNDATION DESIGN IS BASED UPON A PRESUMED BEARING VALUE OF 2000 PSF AND NO EXPANSIVE SOILS PRESENT AT THE SITE. 2. BEARING MATERIAL AND BEARING VALUE OF THE FOUNDATION SOILS SHALL BE FIELD VERIFIED AFTER EXCAVATION AND PRIOR TO PLACEMENT OF CONCRETE. TESTING SHOULD BE PERFORMED BY A CERTIFIED MATERIALS TESTING LABORATORY.

3. TAKE ADEQUATE MEASURES TO ALLOW FOR WORKING SURFACE DURING CONSTRUCTION OF FOUNDATIONS AND SLAB-ON-GRADE, SUCH AS GRAVEL BED OF ADEQUATE DEPTH, ETC. 4. SOME UNDERCUTTING MAY BE REQUIRED DEPENDING ON TIME OF YEAR (GROUND MEASURE). COORDINATE CLEARING AND DIRT WORK WITH GEOTECHNICAL ENGINEER.

- DO NOT PLACE BACKFILL AGAINST CONCRETE WALLS AND GRADE BEAMS UNTIL BRACING FLOORS ARE ARE IN PLACE OR ADEQUATE TEMPORARY BRACING HAS BEEN INSTALLED. BACKFILL IN EVEN LIFTS ALTERNATING FROM SIDE TO SIDE (8" MAX LOOSE LIFTS) - ALL FILL MATERIAL SHALL BE NONEXPANSIVE AND MINIMUM PLASTICITY - FILL SHALL BE COMPACTED TO 95% OF MODIFIED PROCTOR DENSITY PER ASTM 1557 - COMPACTION SHALL BE ACHIEVED WITHIN -3% TO +5% OF THE OPTIMUM WATER CONTENT

E. CONCRETE AND REINFORCING

1. MINIMUM CONCRETE COMPRESSIVE STRENGTH OF ALL CONCRETE AT 28 DAYS SHALL BE

4,000 PSI WITH A WEIGHT OF 145 PCF. 2. MAXIMUM ALLOWABLE w/c RATIO = 0.55

3. MAXIMUM ALLOWABLE SLUMP = 5" 4. NO CHLORIDE ADDITIVES ALLOWED. 5. REINFORCING:


> - BARS: ASTM A615 - GRADE 60, EXCEPT USE GRADE 40 FOR BARS NOTED (IF NOTED). AS FIELD BENT. - SHEET MESH: ASTM A185

6. CLEARANCE BETWEEN REINFORCING AND CONCRETE SURFACES WHICH ARE: CAST AGAINST EARTH OR ROCK..... FORMED AND EXPOSED TO WEATHER OR EARTH.... FORMED BUT NOT EXPOSED TO WEATHER OR EARTH:

- WALLS, SLABS...... 7. UNLESS OTHERWISE SHOWN IN THE ARCHITECTURAL DRAWINGS, PROVIDE 3/4" CHAMFERS AT ALL COLUMNS, BEAMS, WALLS, AND SLAB EDGES THAT ARE EXPOSED TO VIEW IN THE FINISHED

8. REFER TO ARCHITECTURAL DRAWINGS FOR CONCRETE FINISHES. WHERE FORM FINISH IS NOT SPECIFIED, CONFORM TO REQUIREMENTS OF ACI 301 AS MODIFIED BY THE SPECIFICATIONS. 9. MASONRY DOWELS: PROVIDE, PLACE, AND SPACE TO MATCH MASONRY VERTICAL REINFORCING. 10. "C.J." REPRESENTS CONTROL JOINT. SAWCUT ALL CONTROL JOINTS WITHIN 8 HOURS OF POUR. 11. PROVIDE PLAN (PER ACI RECOMMENDATIONS) FOR COLD (40°F & BELOW) OR HOT (90°F & ABOVE) WEATHER CONCRETE CURING. FOLLOW ACI RECOMMENDATIONS SPECIFIED IN ACI 306R-16 (COLD) & ACI 305R-20 (HOT WEATHER)

JOB. NO.

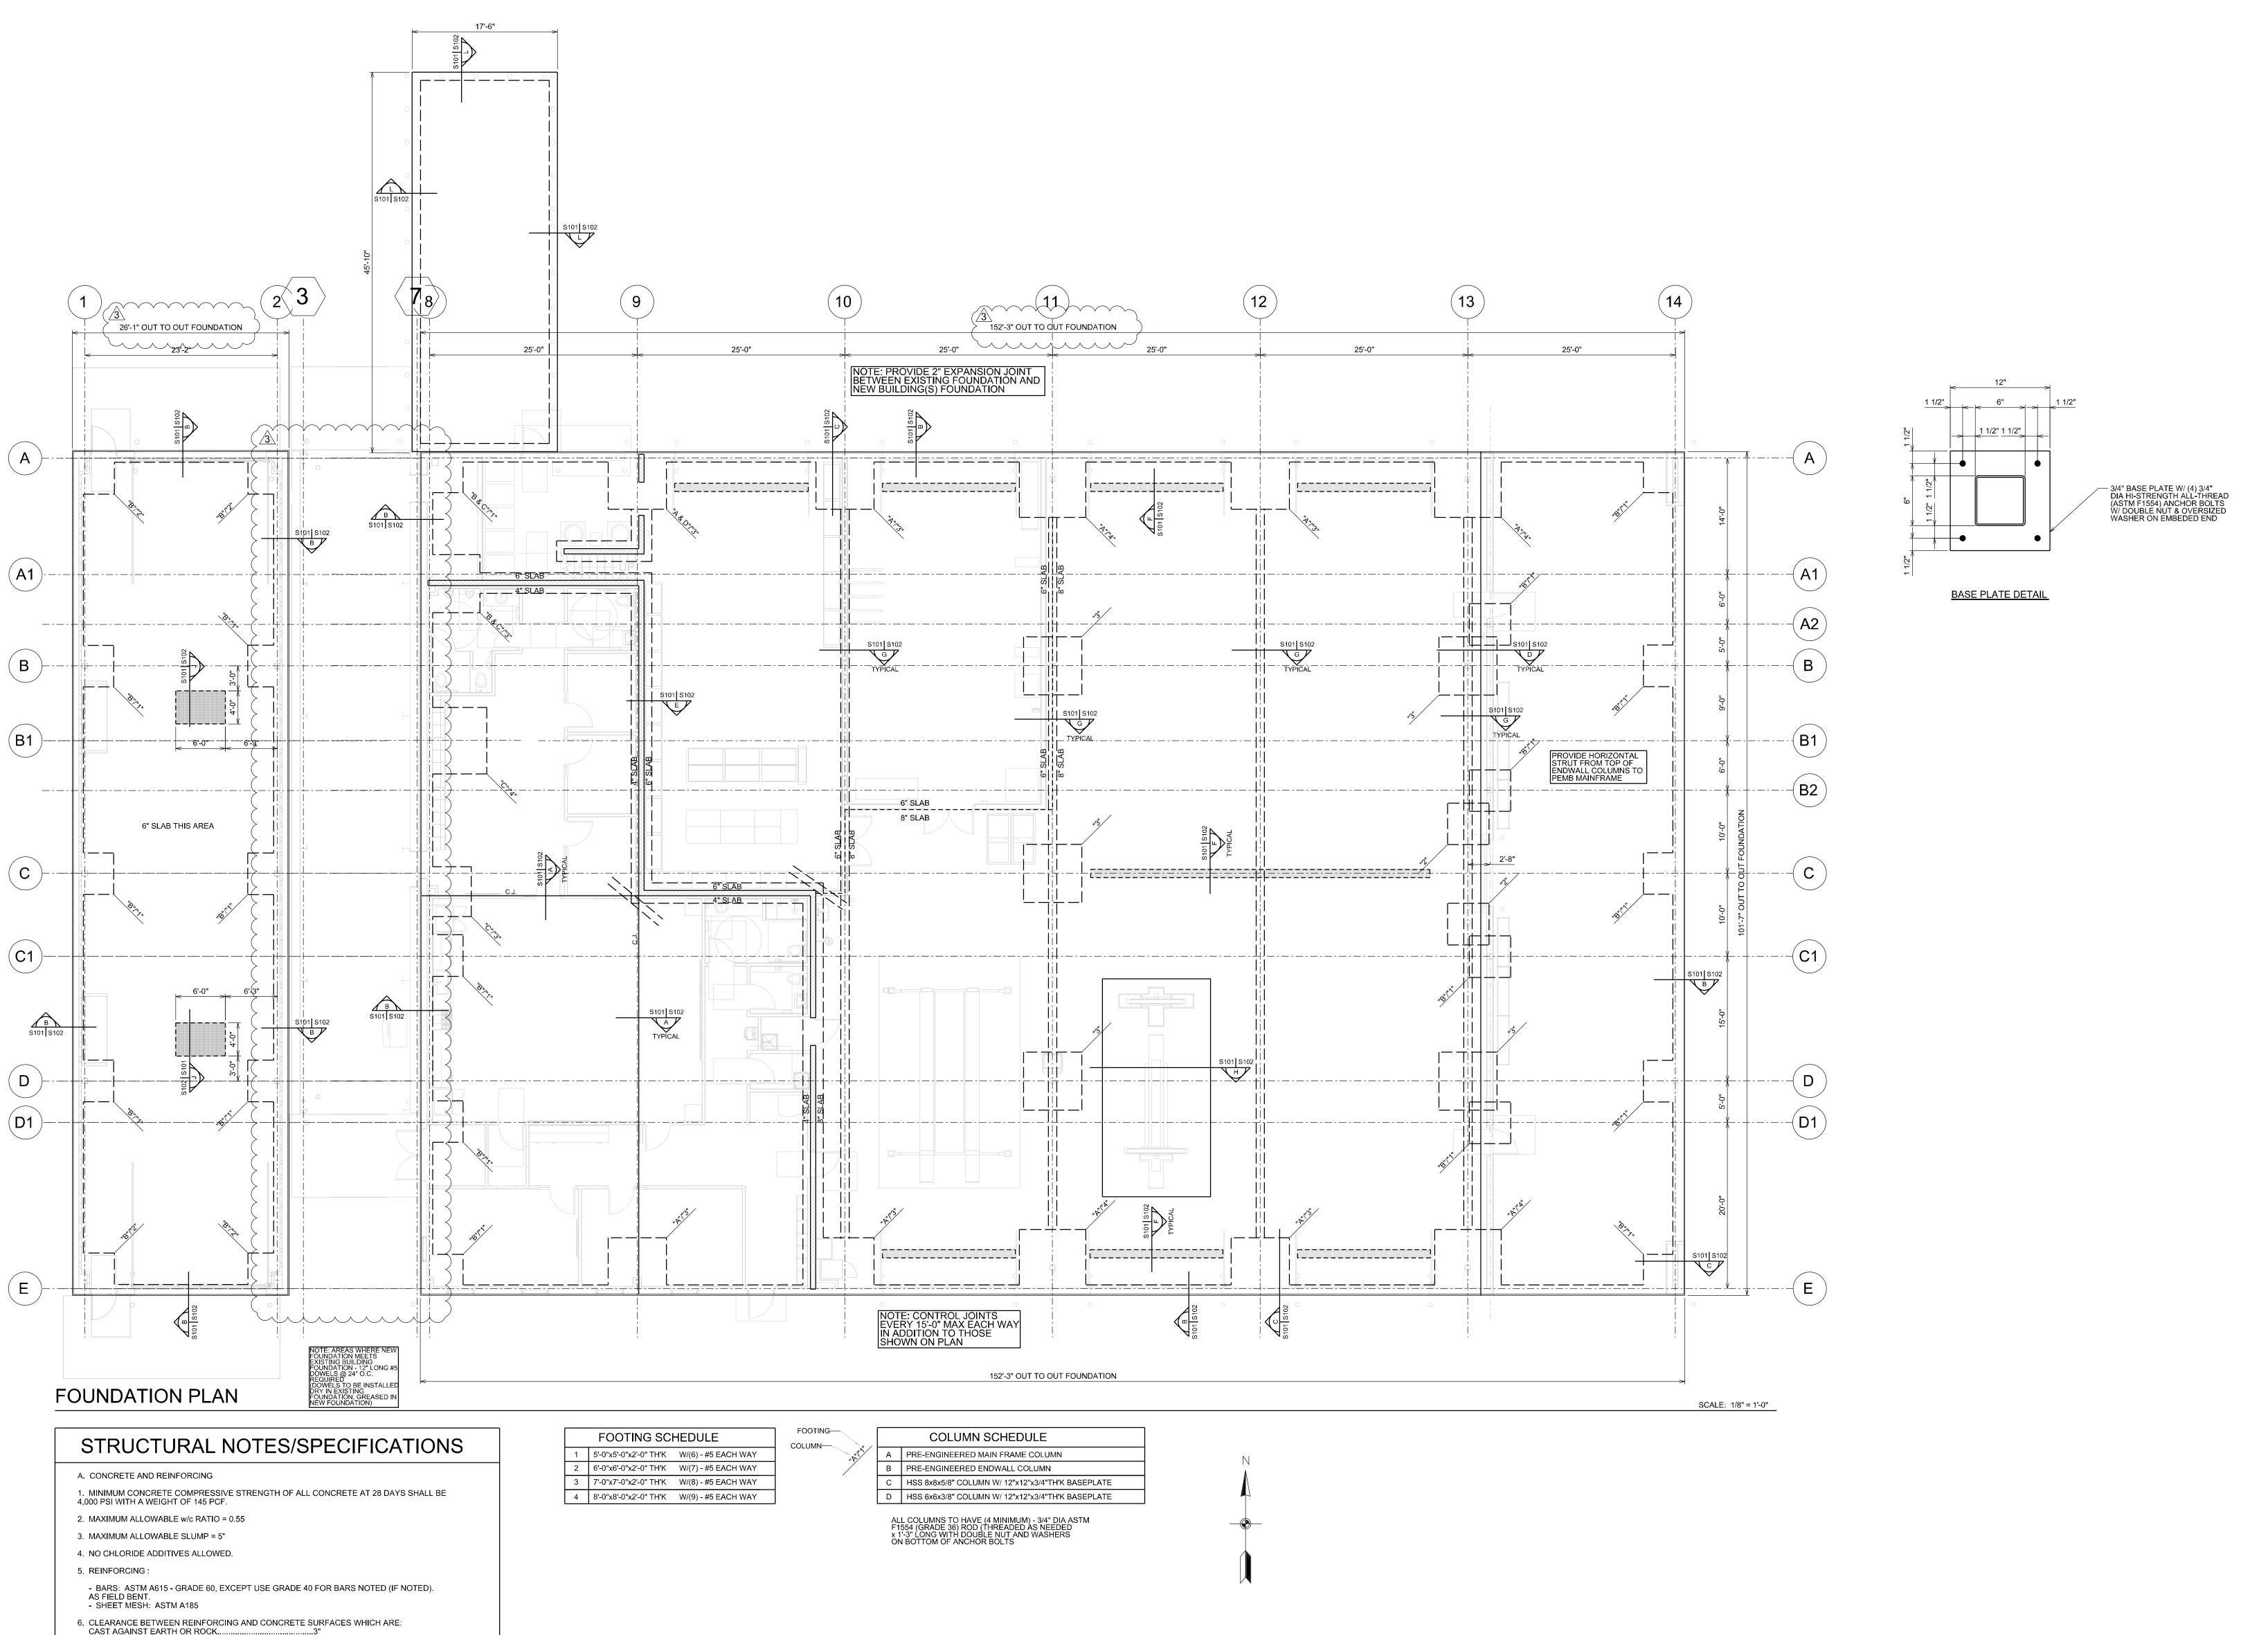



- 7. MAXIMUM WATER/ CEMENT RATIO = 0.55 AND MAXIMUM SLUMP OF 5" 8. UNLESS OTHERWISE SHOWN IN THE ARCHITECTURAL DRAWINGS, PROVIDE 3/4" CHAMFERS AT ALL COLUMNS, BEAMS, WALLS, AND SLAB EDGES THAT ARE EXPOSED TO VIEW IN THE FINISHED STRUCTURE.
- 9. REFER TO ARCHITECTURAL DRAWINGS FOR CONCRETE FINISHES. WHERE FORM FINISH IS NOT SPECIFIED, CONFORM TO REQUIREMENTS OF ACI 301 AS MODIFIED BY THE SPECIFICATIONS. 10. "C.J." REPRESENTS CONTROL JOINT. SAWCUT ALL CONTROL JOINTS WITHIN 8 HOURS OF POUR. 11. PROVIDE PLAN (PER ACI RECOMMENDATIONS) FOR COLD (40°F & BELOW) OR HOT (90°F & ABOVE) WEATHER CONCRETE CURING. FOLLOW ACI RECOMMENDATIONS SPECIFIED IN ACI 306R-16 (COLD) & ACI 305R-20 (HOT WEATHER)







SCALE: 3/4"=1'-0"

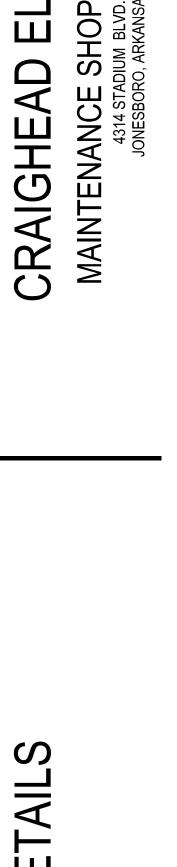

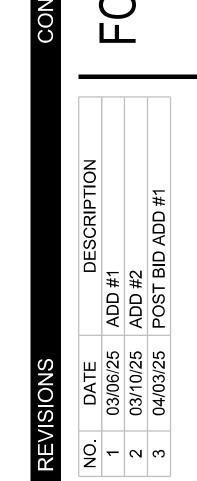

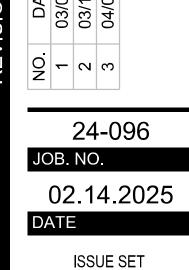



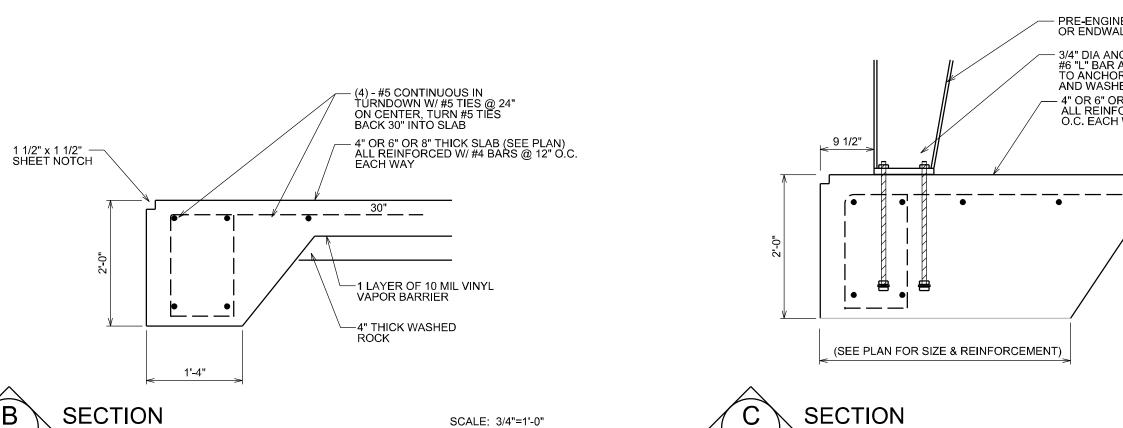



-1/2 " DIA EMBED ANCHORS


\[-----

— 4" OR 6" OR 8" THICK SLAB (SEE PLAN) ALL REINFORCED W/ #4 BARS @ 12" O.C. EACH WAY

(G`

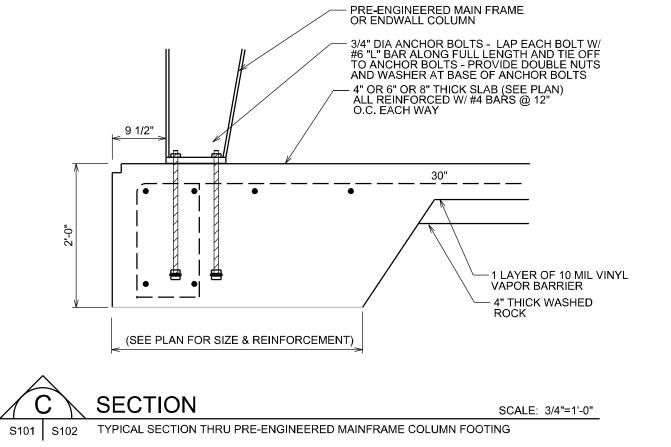

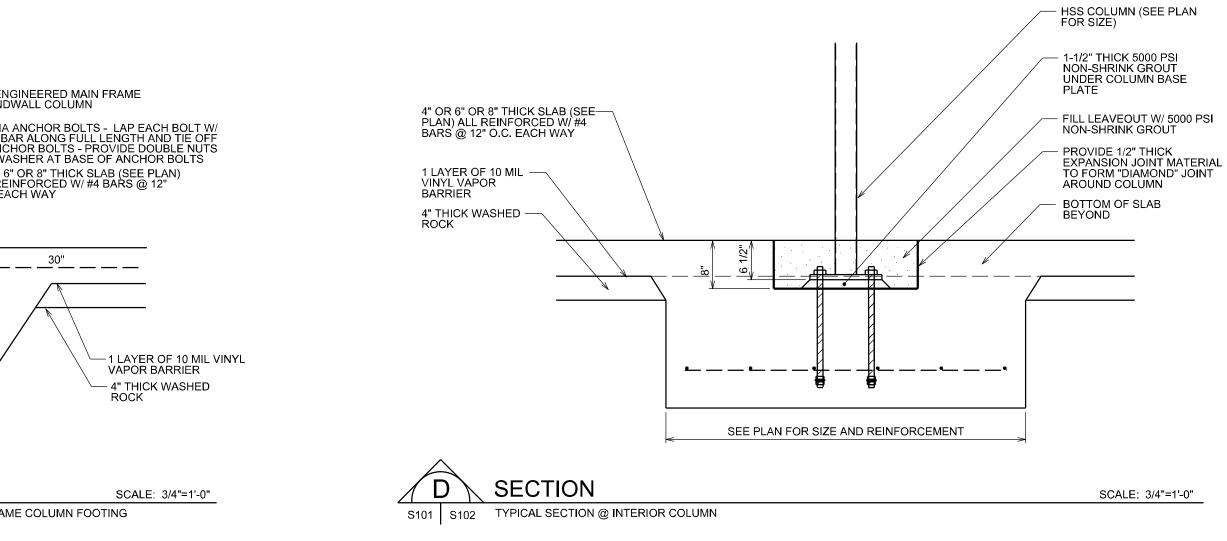

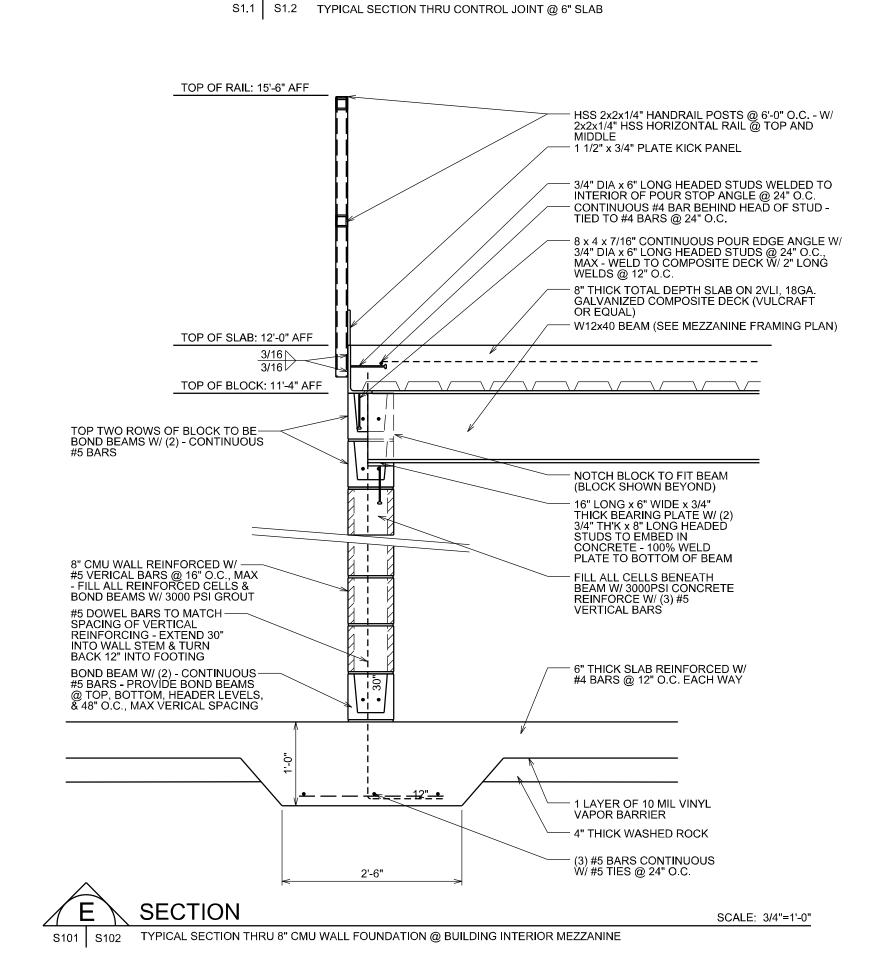


– 4" OR 6" OR 8" THICK SLAB (SEE PLAN) ALL REINFORCED W/#4 BARS @ 12" O.C. EACH WAY

SCALE: 3/4"=1'-0"

CUT CONTROL JOINTS 1/3rd DEPTH OF SLAB

SECTION

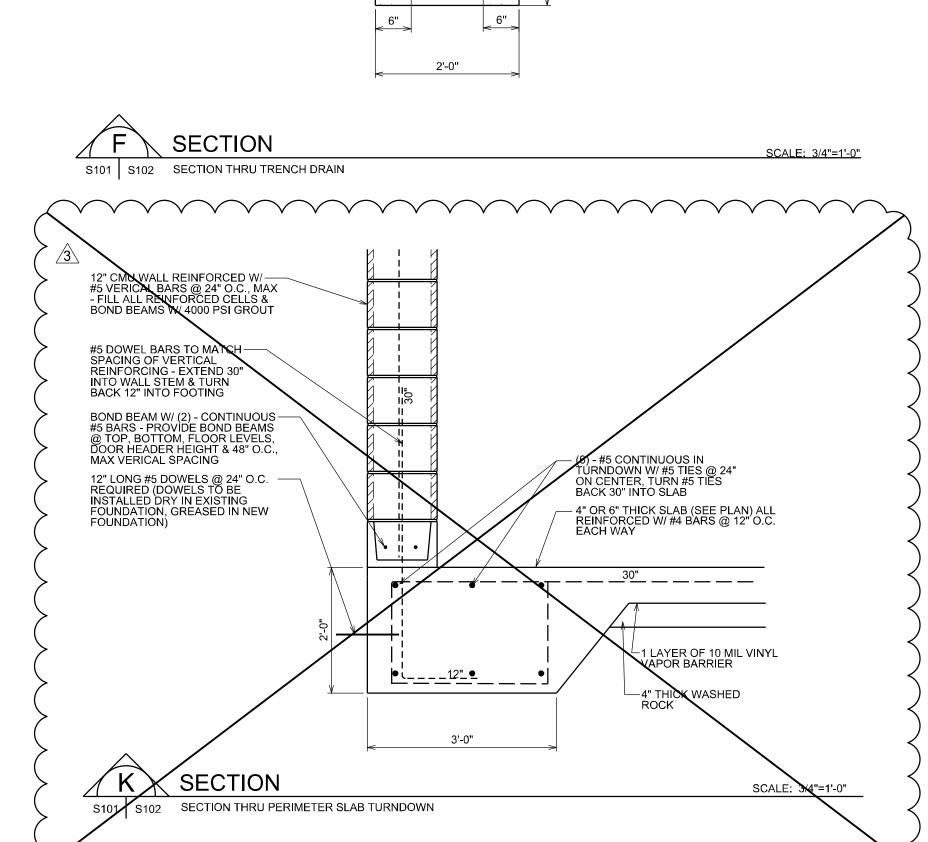


•------


S101 | S102 SECTION THRU PERIMETER SLAB TURNDOWN


1" GRATING IN—


SLOPE


ANGLE FRAME

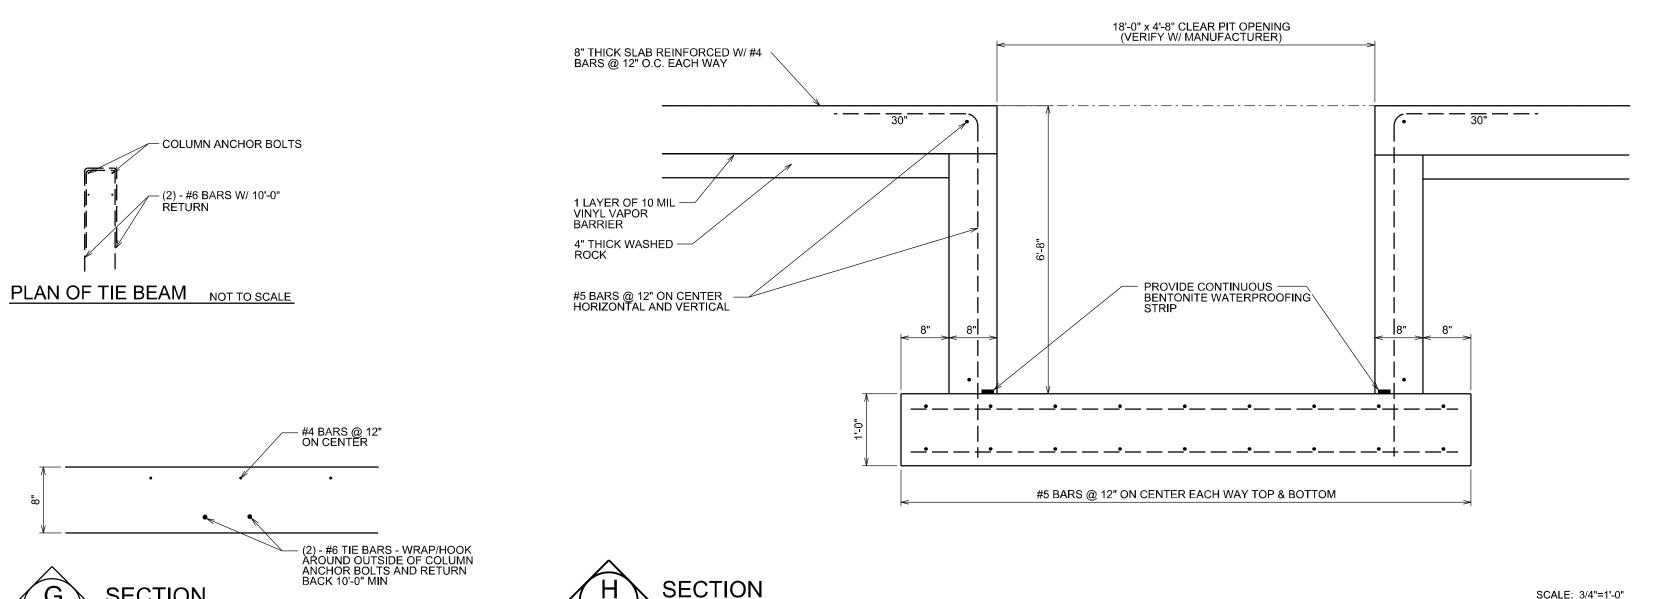


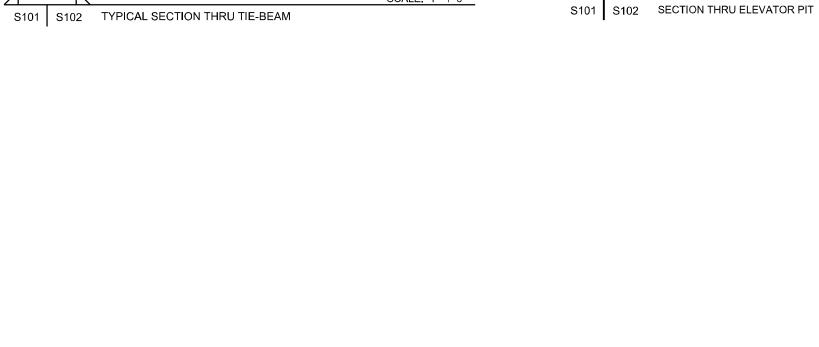

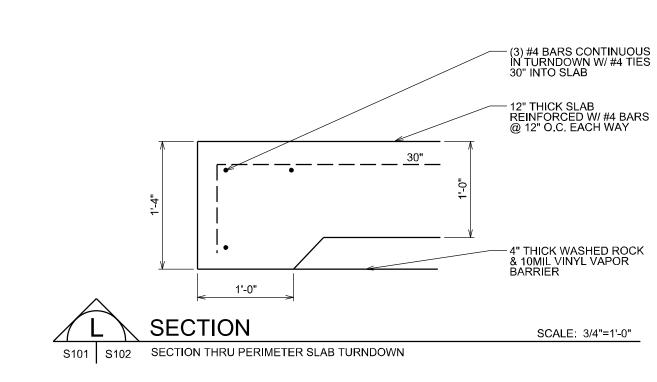

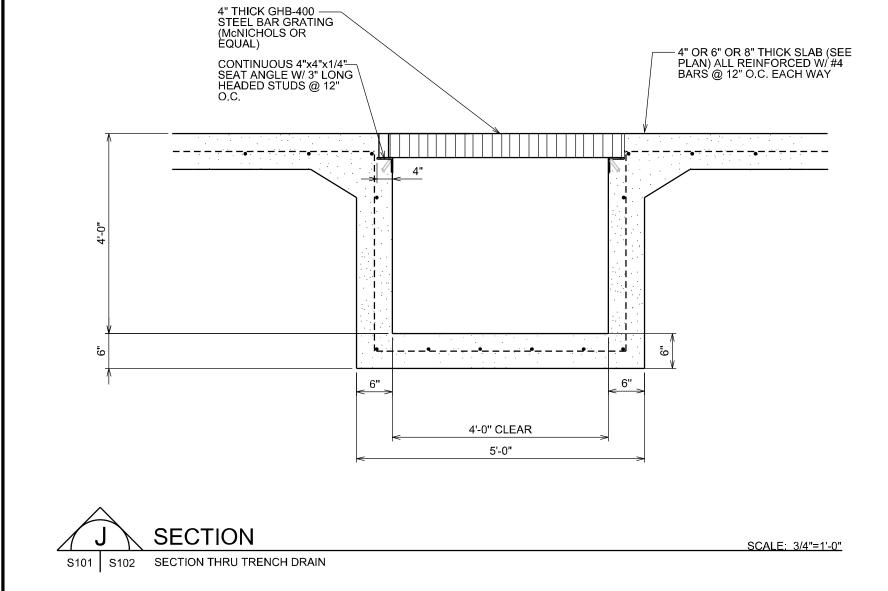

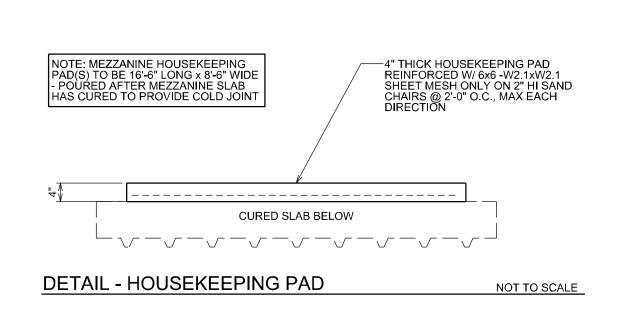

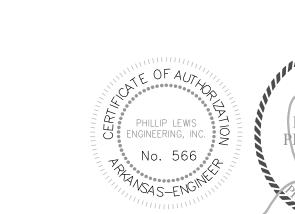


02.14.2025 DATE

S103

PEMB CANOPY SUPPORT FRAMING

ELEVATION - FRONT

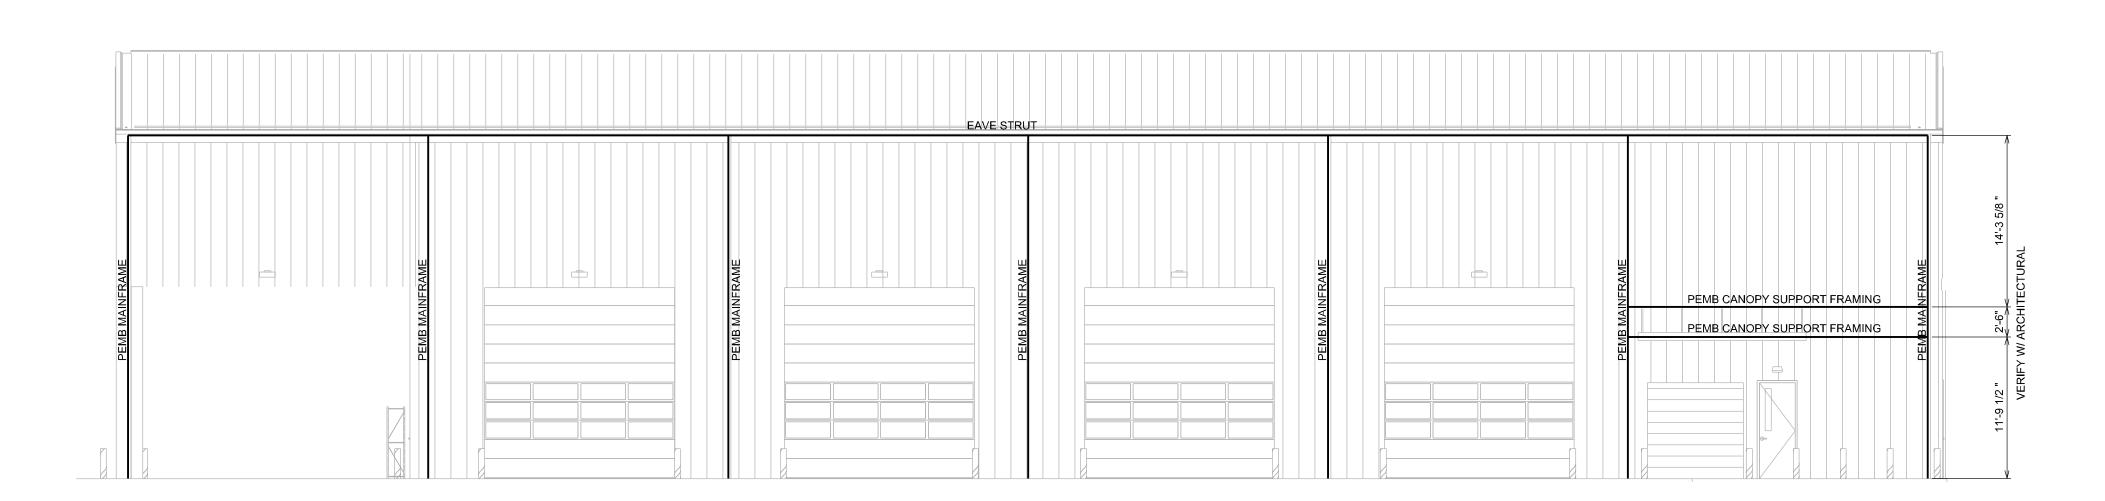

SCALE: 1/8" = 1'-0"

ELEVATION - REAR





TRIC

CRAIGHE/

ADDITION

S201

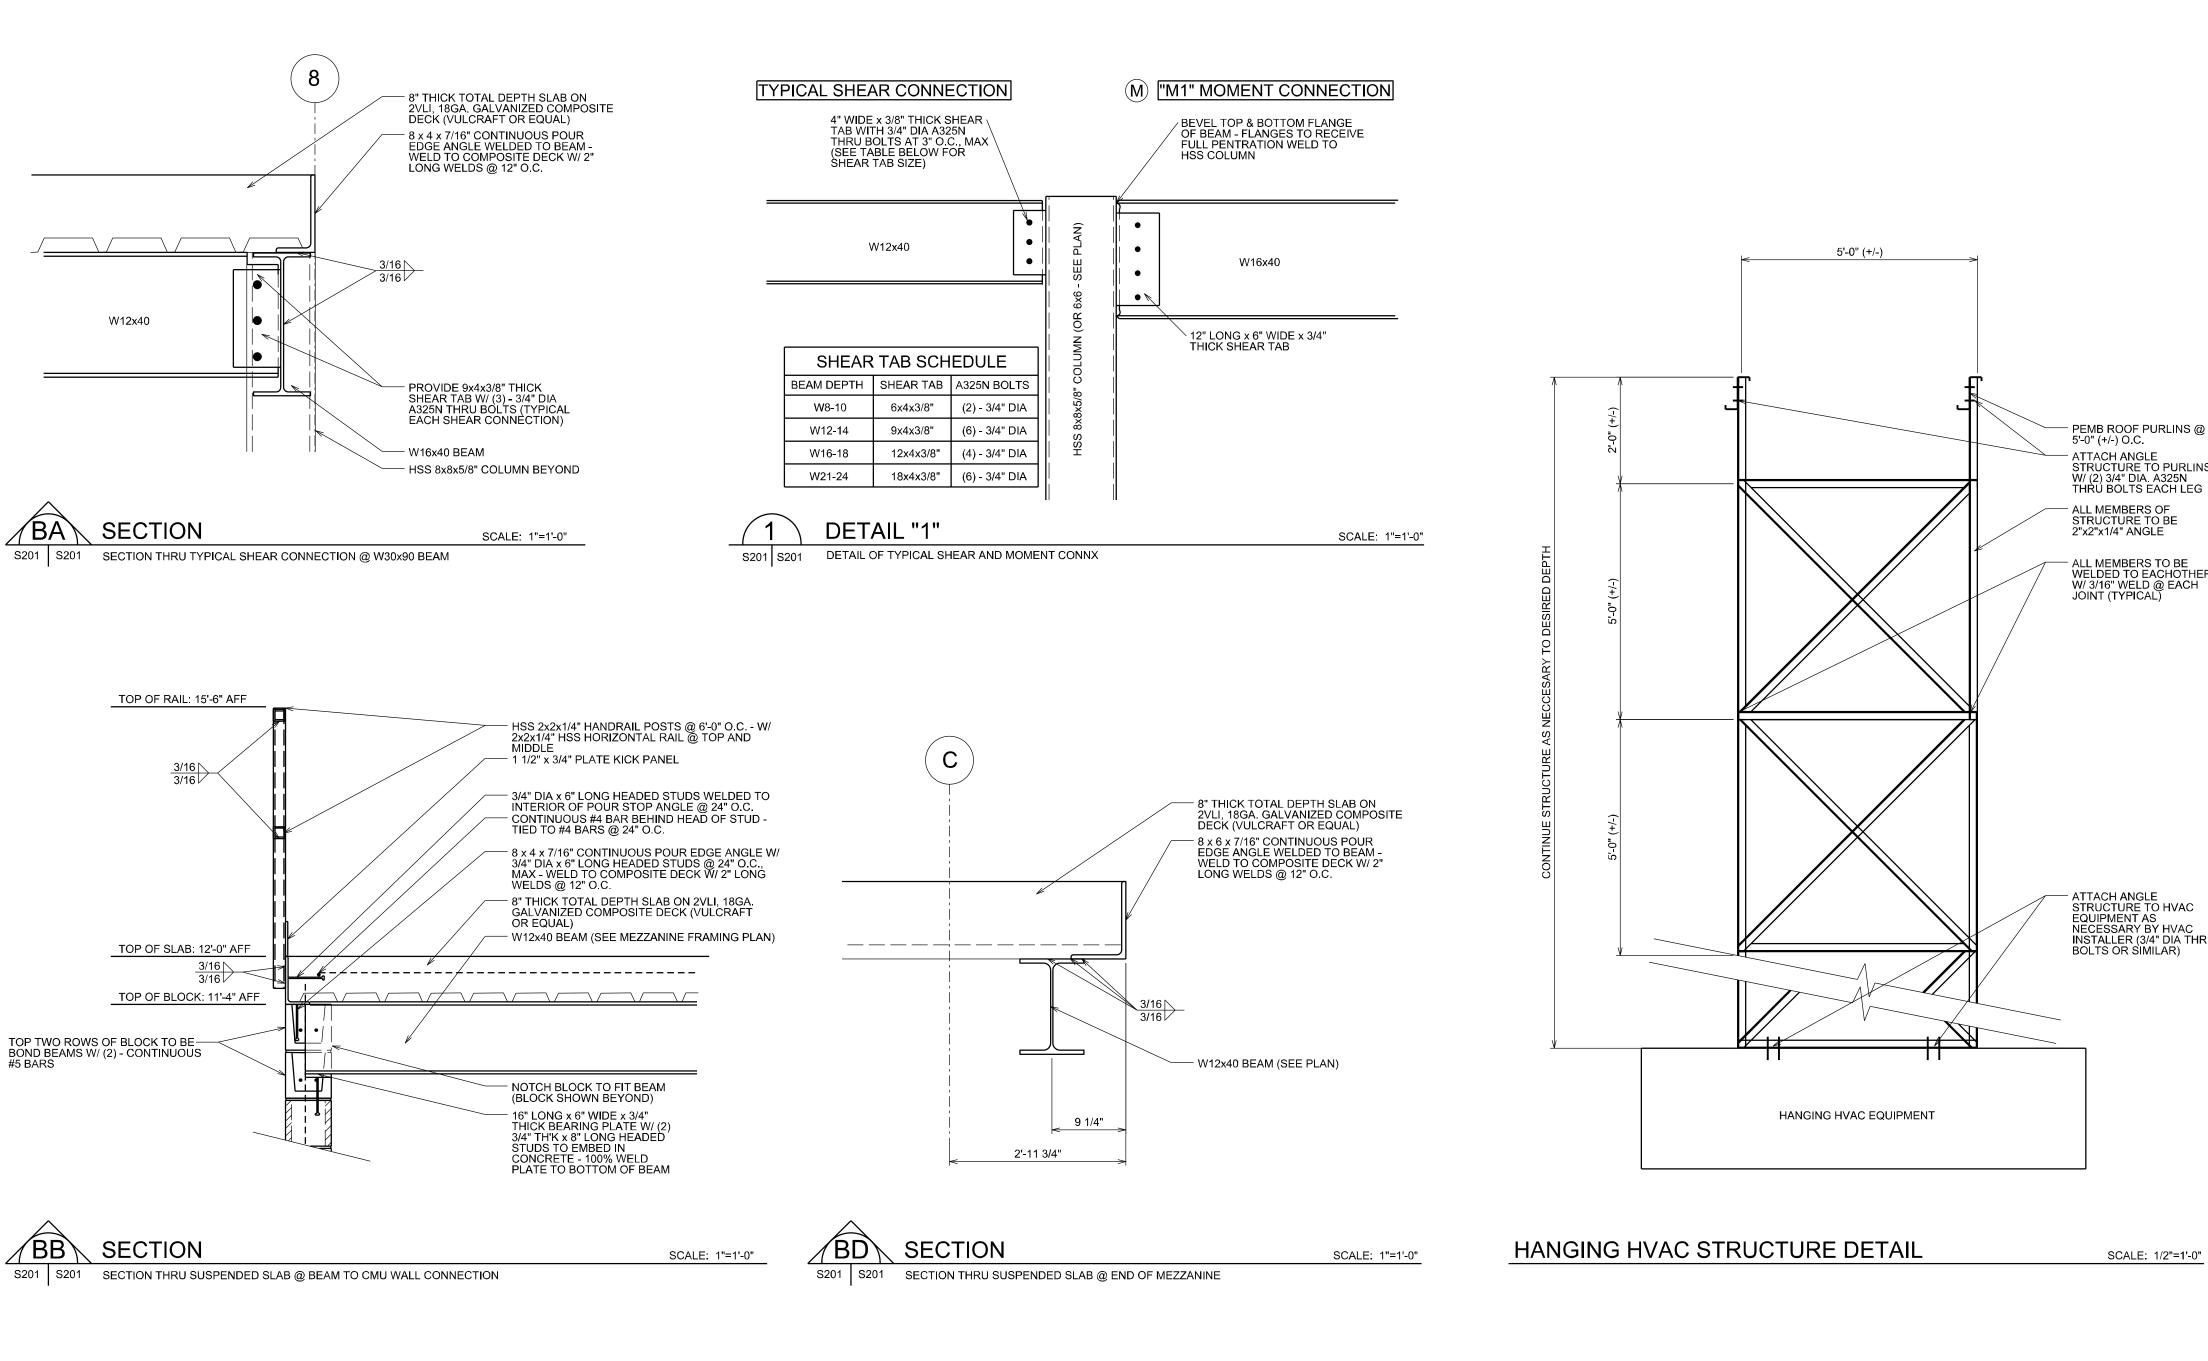

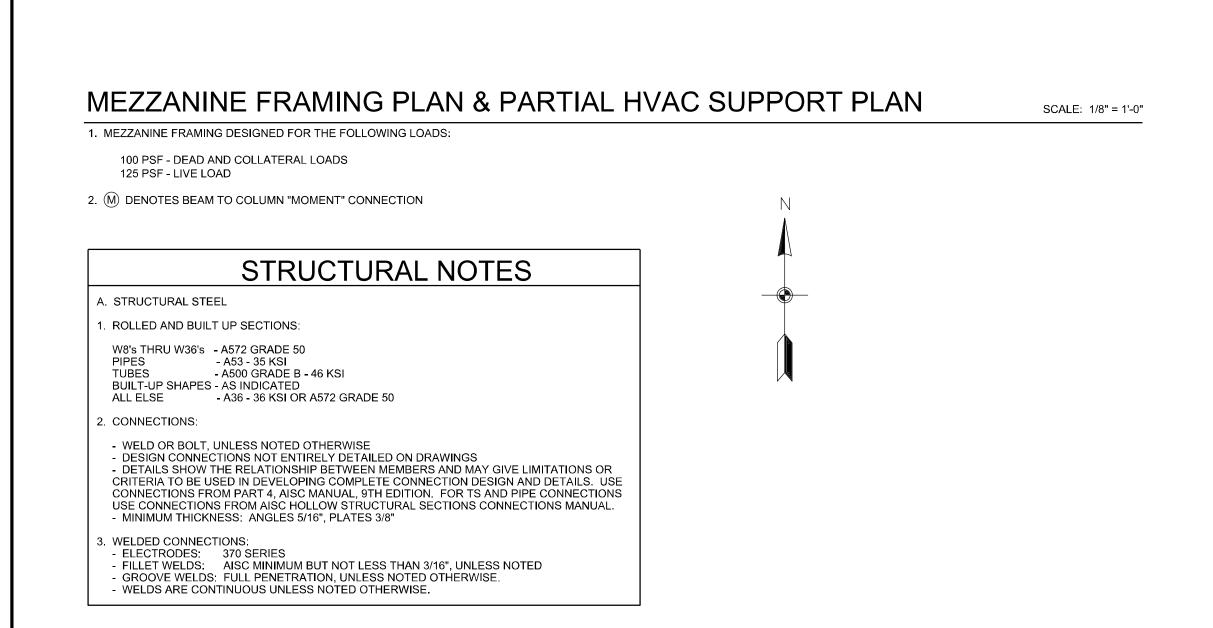

9

25'-0"


ATTACH STEEL DECK-TO-STEEL BEAMS—
WITH 5/8" DIA PUDDLE WELDS ON 36/4
PATTERN ALONG SHEET ENDS AND AT
3'-0" O.C., MAX ALONG SHEET
INTERIORS - ATTACH DECK SIDELAPS
WITH 1 1/2" LONG SEAM WELDS AT 12"
O.C. MAX

25'-0"

W12x40

EDGE OF MEZZANINE

NOTE: SEE DETAIL FOR HANGING HVAC ANGLE STRUCTURE - LOCATIONS AND SIZE OF HANGING HVAC UNITS ARE APPROXIMATE, REFER TO MECH. SHEETS FOR MORE DETAIL

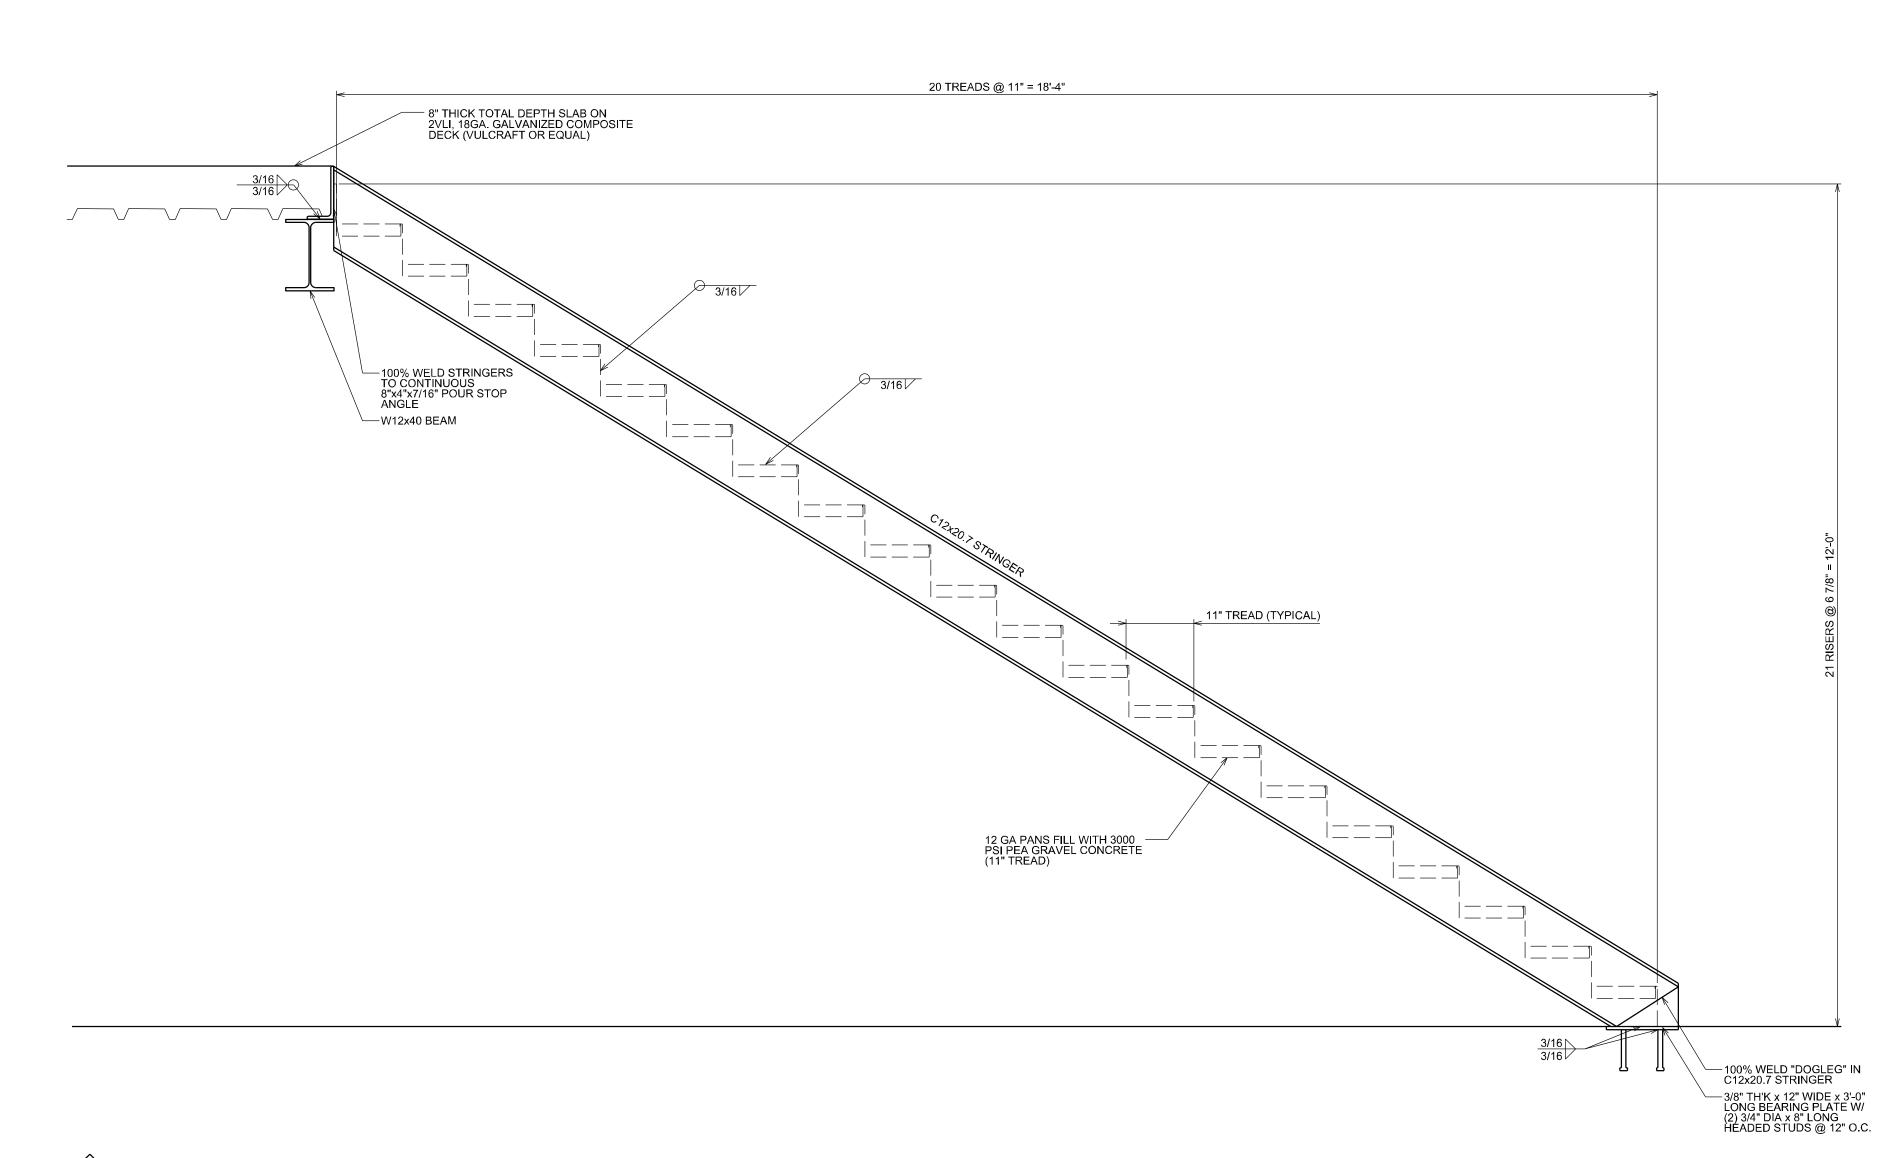

S201 S201 SECTION THRU STAIRS

2. REFER TO ALL PROJECT DRAWINGS FOR DETAILS OF CONSTRUCTION AND INSTALLATION REQUIREMENTS.

3. REFER TO GENERAL CONDITIONS AND SUPPLEMENTARY GENERAL CONDITIONS FOR THE CONTRACT. THE GENERAL CONTRACTOR IS RESPONSIBLE FOR FULL COORDINATION OF

PROJECT INCLUDING THE EQUIPMENT AND INSTALLATION OF THE MECHANICAL WORK.

4. CONTRACTOR SHALL BECOME, PRIOR TO BID, THOROUGHLY FAMILIAR WITH THE REQUIREMENTS OF THESE NOTES AS WELL AS OTHER NOTES SHOWN ON THE CONTRACT DOCUMENTS.

5. THESE DRAWINGS REFLECT A SYSTEM DESIGNED AROUND SPECIFIC REFERENCE PRODUCTS (SEE SCHEDULES), THE SELECTION OF WHICH HAS INFLUENCED THE DESIGNS OF OTHER TRADES (ELECTRICAL, STRUCTURAL, ETC.). IF SUBSTITUTE MANUFACTURERS, SIZES, OR MODEL NUMBERS ARE BID, OR SUBMITTED, IT IS THE RESPONSIBILITY OF THE MECHANICAL CONTRACTOR AND ALL HIS SUBCONTRACTORS TO COORDINATE ALL DIFFERENCES PRIOR TO BID. ALL COSTS OF ALL TRADES ASSOCIATED WITH THE SUBSTITUTION SHALL BE INCLUDED IN THE BID.

6. COORDINATION OF ALL MODIFICATIONS TO EACH DISCIPLINE WHICH RESULT FROM SUBSTITUTION OF EQUIPMENT OR MATERIALS SHALL BE THE RESPONSIBILITY OF THE CONTRACTOR. SUBSTITUTIONS WHICH ARE INSTALLED AND SUBSEQUENTLY ARE PROVEN UNSATISFACTORY BY OWNER AND/OR ENGINEER, WITHIN THE WARRANTY PERIOD, SHALL BE REMOVED COMPLETELY BY THE CONTRACTOR AND REPLACED WITH THE ORIGINAL DESIGN OR CORRECTED AS DIRECTED BY THE ENGINEER WITHOUT ADDITIONAL COST TO THE OWNER.

7. ALL DRAWINGS ARE DIAGRAMMATIC AND INDICATE THE GENERAL ARRANGEMENTS OR GEOMETRICAL RELATIONSHIPS OF EQUIPMENT AND SERVICES. THEY ARE NOT INTENDED TO SPECIFY OR SHOW EVERY OFFSET, SEQUENCE, DEVICE, OPTION, FITTING, OR COMPONIENT.

8. INFORMATION AND COMPONENTS SHOWN ON RISER DIAGRAMS OR DETAILS, BUT NOT SHOWN ON PLANS, AND VICE VERSA, SHALL BE PROVIDED AS IF EXPRESSLY REQUIRED

9. CONTRACTOR SHALL NOT SCALE DRAWINGS. DRAWINGS SPECIFIC TO THIS DISCIPLINE DO NOT LIMIT THE RESPONSIBILITY OF WORK REQUIRED BY THE CONTRACT

DO NOT LIMIT THE RESPONSIBILITY OF WORK REQUIRED BY THE CONTRACT DOCUMENTS.

10. UNLESS NOTED OTHERWISE, THE INDICATION AND/OR DESCRIPTION OF ANY ITEM, IN

THE DRAWINGS OR SPECIFICATIONS CARRIES WITH IT THE INSTRUCTION TO FURNISH

AND INSTALL THE ITEM.

11. EXACT LOCATIONS OF ALL EQUIPMENT, ROOF CURBS, DUCTS, DIFFUSERS, ETC. SHALL BE COORDINATED WITH OTHER TRADES. CEILING MOUNTED SPRINKLER, LIGHTING, AND ELECTRICAL REQUIREMENTS TAKE PRECEDENCE OVER CEILING MOUNTED MECHANICAL REQUIREMENTS. SEE ARCHITECTURAL REFLECTED CEILING PLANS FOR CEILING GRID AND LIGHTING LAYOUT FOR COORDINATION OF FINAL DIFFUSER LOCATIONS.

 SEE ARCHITECTURAL AND STRUCTURAL DRAWINGS FOR BUILDING DETAILS AND DIMENSIONS.

13. COORDINATE PLACEMENT OF ALL THERMOSTATS, ROOF MOUNTED EQUIPMENT, ETC. WITH ARCHITECTURAL AND STRUCTURAL TRADES.

14. CONTRACTOR SHALL BE RESPONSIBLE FOR COORDINATING ALL WORK WITH THAT OF OTHER TRADES. REFER TO ARCHITECTURAL, STRUCTURAL, ELECTRICAL, AND OTHER DRAWINGS FOR COMPLETE INFORMATION PRIOR TO BID.

15. ROUGH-IN OR INSTALLATION OF OWNER FURNISHED EQUIPMENT SHALL NOT BEGIN UNTIL APPROVED EQUIPMENT DRAWINGS ARE OBTAINED FROM OWNER OR ARCHITECT. DO NOT SUBMIT SHOP DRAWINGS FOR ANY EQUIPMENT WHICH MAY BE COORDINATED WITH OWNER FURNISHED ITEMS UNTIL THE APPROVED DRAWINGS ARE OBTAINED FROM OWNER OR ARCHITECT. VERIFY THE APPROVED EQUIPMENT HAS THE SAME ROUGH-IN AND FINAL CONNECTION REQUIREMENTS AND DESIGN CRITERIA AS THE DOCUMENTS. NOTIFY ENGINEER OF ANY CHANGES, INCOMPATIBILITY, OR UNUSUAL CONDITIONS IMMEDIATELY. SEE SPECIFICATIONS OR DRAWINGS FOR LIST OF OWNER FURNISHED EQUIPMENT (WHERE APPLICABLE).

16. ALL MECHANICAL CONSTRUCTION DETAILS SHALL BE AS SHOWN AND AS REQUIRED TO MAINTAIN "UL" ASSEMBLY RATINGS AS SHOWN ON ARCHITECTURAL SHEETS. SEAL AROUND ALL PENETRATIONS THOROUGH UL RATED ASSEMBLIES, FIRE AND SMOKE WALLS. COORDINATE WITH GENERAL CONTRACTOR.

17. NO OTHER TRADES, I.E., ELECTRICAL, CEILING, PLUMBING, ETC., SHALL BE SUSPENDED, HUNG, OR SUPPORTED FROM DUCTWORK OR PIPING.

18. ROOFING CONTRACTOR SHALL BE RESPONSIBLE FOR FLASHING AND SEALING OF ALL ROOF PENETRATIONS.

19. SPECIAL CARE SHALL BE TAKEN ON THE ROOFS TO PREVENT DAMAGE. ANY DAMAGE SHALL BE PROMPTLY REPAIRED AT NO EXPENSE TO THE OWNER. COMPLY WITH BONDING REQUIREMENTS OF EXISTING ROOF.

20. PROVIDE CONCRETE PADS FOR ALL GROUND-MOUNTED EQUIPMENT.

21. REPLACE ALL ARCHITECTURAL FEATURES REMOVED OR DAMAGED DURING THE COURSE OF THE WORK.

REFRIGERATION PIPING NOTES:

 ALL INSTALLATION PROCEDURES SHALL BE AS DIRECTED BY THE REFRIGERATION CONTRACTOR TO INSURE THAT ALL OF THE SYSTEMS ARE COMPATIBLE.

 REFER TO THE SPECIFICATIONS FOR ADDITIONAL REQUIREMENTS.
 ALL REFRIGERATION PIPING SHALL USE THE SIZES AND DETAILS OF CONSTRUCTION AS DIRECTED BY THE EQUIPMENT MANUFACTURER.

4. DO NOT VENT REFRIGERANT TO THE ATMOSPHERE. RECOVER OR RECLAIM PER THE LATEST REGULATIONS AND ASHRAE GUIDELINES.

HVAC NOTES:

REFER TO GENERAL NOTES ON DRAWING FOR ADDITIONAL REQUIREMENTS.

1. PROVIDE ACCESS DOORS TO ALL FIRE DAMPERS, SMOKE DAMPERS, EQUIPMENT, COILS, ETC. WHERE NOT DIRECTLY ACCESSIBLE THROUGH AIR DEVICES OR REMOVABLE CEILING GRID. MINIMUM SIZE SHALL BE 18" X 18" UNLESS NOTED OTHERWISE.

SEE STRUCTURAL PLANS FOR EXACT DIMENSIONS AND DETAILS OF THE BUILDING.
 MAINTAIN A MINIMUM OF 15'-0" BETWEEN ALL FRESH AIR INTAKES AND PLUMBING VENTS, EXCHANGE FAMILY FAMILY FOR THE CONTRACTORS.

EXHAUST FAN DISCHARGE, FLUES, ETC. COORDINATE WITH ALL OTHER CONTRACTORS ON SITE.
 SEAL ALL ROOF AND WALL PENETRATIONS. FLASH AND COUNTERFLASH ROOF

PENETRATIONS. MINIMUM HEIGHT OF FLASHING IS EIGHT (8) INCHES ABOVE ROOF.

5. ALL HVAC WORK TO BE PER SMACNA AND ALL APPLICABLE CODES.

6. ALL DUCTS SHALL BE MOUNTED HIGH AS POSSIBLE AGAINST BOTTOM OF JOISTS EXCEPT AS REQUIRED TO AVOID CONFLICTS WITH INTERSECTING DUCTS. DIAGONALLY OFFSET DUCTS IMMEDIATELY BEFORE AND AFTER PASSING UNDER INTERSECTING DUCTS OR LARGE STRUCTURAL MEMBERS TO MAINTAIN DUCT TIGHT TO STRUCTURE.

 PROVIDE TURNING VANES AT ALL ELBOWS GREATER THAN 45 DEGREES. TURNING VANES SHALL BE DOUBLE THICKNESS.

8. MAXIMUM 4'-0" FLEX DUCT ON ALL DIFFUSER RUNOUTS. CONNECTIONS TO FLEX DUCT SHALL BE SMOOTH ON AIRFLOW SIDE.

9. PROVIDE INDICATED BRANCH TAKEOFF AND DAMPER AT EACH CONNECTION OF ROUND BRANCH DUCTS TO A RECTANGULAR DUCT.
 10. PROVIDE FLEXIBLE CONNECTIONS AND TRANSITIONS ON DUCT INLET AND OUTLET

CONNECTIONS TO ALL ROOF TOP UNITS, EXHAUST FANS, AIR BOXES, ETC. WHERE EQUIPMENT HAS ROTATING PARTS (MOTORS, ETC.).

12. WHERE DUCT LINER IS INDICATED, THE DUCT SIZES ON THE DRAWINGS SHALL BE INCREASED IN SIZE TO ACCOMMODATE LINER THICKNESS. SIZES SHOWN ON THE

11. SEE ARCH REFLECTED CEILING PLAN FOR EXACT LOCATION OF ALL CEILING MOUNTED

INCREASED IN SIZE TO ACCOMMODATE LINER THICKNESS. SIZES SHOWN ON THE DRAWINGS ARE THE REQUIRED CLEAR INSIDE DIMENSIONS OF THE LINER WHERE USED.

13. INTERNALLY INSULATE ALL RECTANGULAR SUPPLY AND RETURN AIR DUCTS. ALL BRANCH DUCTS TO BE EXTERNALLY INSULATED WITH FIBERGLASS DUCT INSULATION

14. THE DUCT SIZES ON THE DRAWINGS SHALL BE INCREASED IN SIZE TO ACCOMMODATE LINER THICKNESS. SIZES SHOWN ON THE DRAWINGS ARE THE REQUIRED CLEAR INSIDE DIMENSIONS OF THE LINER WHERE USED.

WRAP UNLESS OTHERWISE INDICATED.

15. PROVIDE ALUMINUM JACKETS ON ALL EXTERIOR PIPE INSULATION.
16. INSTALL SCHEDULED FILTERS AT THE COMPLETION OF CONSTRUCTION. USE ONE SET OF SCHEDULED FILTERS DURING CONSTRUCTION AS INDICATED ON THE SCHEDULE.

INSTALL FINAL SET PRIOR TO TEST AND BALANCE.

17. BALANCE AIR SYSTEM TO PROVIDE INDICATED AIR FLOWS. SEE SPECIFICATIONS FOR

OTHER TEST AND BALANCE REQUIREMENTS. SUBMIT FINAL BALANCE OF AIR SYSTEMS (FLOW AND TEMPERATURE) FOR REVIEW.

18. MECHANICAL CONTRACTOR (MC) SHALL COORDINATE AND VERIFY THE FOLLOWING WITH THE ELECTRICAL CONTRACTOR (EC) PRIOR TO BID:
 A) ALL STARTERS: FURNISHED BY MC, INSTALLED BY EC.

B) DUCT SMOKE DETECTORS: FURNISHED BY EC, INSTALLED BY EC.
C) ELECTRIC DAMPER ACTUATORS: FURNISHED BY MC, INSTALLED BY MC.
DISCONNECTS:
WHERE NOT FURNISHED WITH EQUIPMENT: FURNISHED BY EC
INSTALLED BY EC.
WHERE FURNISHED WITH EQUIPMENT: FURNISHED BY MC,

INSTALLED BY EC.

19. INSTALL SMOKE DETECTORS IN SUPPLY OR RETURN DAMPERS WHERE INDICATED ON

20. COORDINATE FINAL PLACEMENT OF ALL THERMOSTATS WITH ARCHITECT AND ENGINEER. ANY THERMOSTAT THAT IS REQUIRED TO BE MOUNTED ON AN EXTERIOR

WALL SHALL BE MOUNTED ON AN INSULATED PAD.

21. PROVIDE HVAC CONDENSATE DRAIN. INSTALL WITH TRAP AND AIR VENT PER CODE AND

22. PROVIDE AUXILIARY DRAIN PAN FOR COOLING COILS ABOVE THE CEILING. PROVIDE MOISTURE SENSOR IN PAN TO STOP UNIT AND SIGNAL ALARM.

CONTROL NOTES:

REFER TO GENERAL NOTES ON DRAWING.

ALL CONTROL DEVICES SHALL BE BY ONE MANUFACTURER. ALL CONTROL SET POINTS
 SHALL BE ADJUSTABLE. THERMOSTATS AND WIRING FOR FANS SHALL BE INCLUDED
 WITH CONTROLS.

2. THE CONTROL SYSTEM SHALL BE SUITABLE FOR THE LOCATIONS SHOWN ON THE

3. SEE THE SPECIFICATIONS FOR ADDITIONAL REQUIREMENTS.

IS INDICATED AND FULL SIZE OF DRAIN PAN CONNECTION.

PROVIDE LOCKABLE COVERS AND GUARDS FOR ALL THERMOSTATS AND SENSORS.
 ALL THERMOSTATS, SENSORS, AND OTHER EXPOSED CONTROL DEVICE LOCATIONS

SHALL BE COORDINATED WITH THE ENGINEER AND ARCHITECT BEFORE ROUGHING IN.

6. ALL CONTROLS SHALL BE TESTED AND CALIBRATED BEFORE TESTING AND BALANCING

IS PERFORMED.PROVIDE LAMINATED TAGS AT ALL CONTROL DEVICES INDICATING EQUIPMENT BEING

8. INTERLOCK CONTROLS WITH THE ELECTRICAL FIRE AND SMOKE ALARM SYSTEM COORDINATE WITH THE ELECTRICAL SYSTEMS CONTRACTOR FOR INTERFACE REQUIREMENTS OF THE SYSTEMS.

 PROVIDE AUXILIARY CONTACTORS AS REQUIRED FOR OPERATIONS OF CONTROLSEQUENCES.

10. ALL WIRING SHALL BE IN CONDUIT. REFER TO SPECIFICATIONS.11. PROVIDE MONITORING AND CONTROL OF HEAT TAPE

		HVAC	LEGEND		
ABBREVIATION OR SYMBOL	DESCRIPTION	ABBREVIATION OR SYMBOL	DESCRIPTION	ABBREVIATION OR SYMBOL	DESCRIPTION
AD AH A.F.F.	AIR DOOR AIR HANDLING UNIT ABOVE FINISHED FLOOR		NEW EQUIPMENT	├──── CD────	CONDENSATE DRAIN HOT WATER RETURN
AV B	ATTIC VENT BOILER	00	CEILING CLIDDLY	├────HWS───── ├────RS/RL──── 	HOT WATER SUPPLY REFRIGERANT SUCTION / LIQUID
BHP BTUH CFM	BRAKE HORSE POWER BRITISH THERMAL UNIT PER HOUR	CS DG CE	CEILING SUPPLY DOOR GRILLE CEILING EXHAUST	├───MUP	MAKE-UP WATER
CH CV	CUBIC FEET PER MINUTE CHILLER CONSTANT VOLUME	LSD CR	LINEAR SLOT DIFFUSER CEILING RETURN	\	BALL VALVE
CVB DB	CONSTANT VOLUME TERMINAL DRY BULB TEMPERATURE	TR SWE	TRANSFER GRILLE SIDE WALL EXHAUST	}	BUTTERFLY VALVE CHECK VALVE
DP EA	DIFFERENTIAL PRESSURE EXHAUST AIR	SWS SWR	SIDE WALL SUPPLY SIDE WALL RETURN		GATE VALVE
EAT EF	ENTERING AIR TEMPERATURE OF THE COIL EXHAUST FAN				GLOBE VALVE
ERU ESP	ENERGY RECOVERY UNIT EXTERNAL STATIC PRESSURE	CS-1 — MARK 150 — AIR FLOW (CFM)	AIR DEVICE DESIGNATION	₹	NEEDLE VALVE
EUH EWT FAS	ELECTRIC UNIT HEATER ENTERING WATER TEMPERATURE FACILITY AUTOMATION SYSTEM		CEILING SUPPLY DIFFUSER	1	PLUG VALVE
FCU FO	FAN COIL UNIT FLAT OVAL		CEILING SUPPLY DIFFUSER	\	PRESSURE REGULATING VALVE
FPMB FPM	FAN POWERED MIXING TERMINAL FEET PER MINUTE (VELOCITY)		CEILING RETURN GRILLE	[S]	RELIEF VALVE
GH GPM	GRAVITY HOOD GALLONS PER MINUTE		CEILING EXHAUST GRILLE	\\	SOLENOID VALVE
GUH HP	GAS UNIT HEATER HORSEPOWER			\	VALVE IN RISER PIPE UNION
KW L LAT	KILOWATT LOUVER LEAVING AIR TEMPERATURE OF THE COIL		LINEAR SLOT DIFFUSER	\	AUTO AIR VENT
LBS LWT	POUNDS LEAVING WATER TEMPERATURE		GRILLE OR REGISTER ON BOTTOM	4	MANUAL AIR VENT
MAU MAX.	MAKE-UP AIR UNIT MAXIMUM		OF DUCTWORK	\ \ \ \ \ \ \ \ \ \ \ \ \ \ \ \ \ \ \	ECCENTRIC TRANSITION
MBH MCA	1000 BTUH MINIMUM CIRCUIT AMPACITY		SIDEWALL SUPPLY/RETURN	\ \ \	CONCENTRIC TRANSITION
MIN. MHP	MINIMUM MOTOR HORSE POWER	18/24	DUCT SIZE (FOR DOUBLE LINE DUCT)	₩	PRESSURE GAUGE
MOCP N/A NC	MAXIMUM OVER CURRENT PROTECTION NOT APPLICABLE NOISE CRITERIA		SUPPLY DUCT UP	\	STEAM TRAP
N.C. NIC	NORMALLY CLOSED NOT IN CONTRACT		SUPPLY DUCT DOWN	}	STRAINER (Y-TYPE)
N.O. NK.	NORMALLY OPEN NECK			\	TEMPERATURE & PRESSURE PLUG
NTS OBD	NOT TO SCALE OPPOSED BLADE DAMPER		RETURN OR EXHAUST DUCT UP	}	THERMOMETER DIRECTION OF FLOW
OFCI OSA	OWNER FURNISHED/CONTRACTOR INSTALLED OUTSIDE AIR		RETURN OR EXHAUST DUCT DOWN		DIRECTION OF FLOW
P PBD	PUMP PARALLEL BLADE DAMPER		RECTANGULAR/ROUND TRANSITION (DOUBLE LINE DUCT)		FLEXIBLE PIPE CONNECTION
PDU PRV	POOL DEHUMIDIFIER UNIT PRESSURE REDUCING VALVE	(F) (S)	FLEXIBLE DUCT CONNECTION		FLEXIBLE PIPE CONNECTION
PSF PSI	POUNDS PER SQUARE FOOT POUNDS PER SQUARE INCH	(1) (3)	(1) FIRE DAMPER, (2) COMBINATION FIRE/SMOKE DAMPER, (3) SMOKE DAMPER	\ 	FLEXIBLE PIPE CONNECTION
PSIG RA	POUNDS PER SQUARE INCH GAUGE RETURN AIR	O ₍₁₎		G+	PIPE DOWN
RC RF RH	REMOTE CONDENSER RELIEF FAN RELATIVE HUMIDITY		(1) OPPOSED BLADE DAMPER, (2) PARALLEL BLADE DAMPER,		TEE DOWN PIPE UP
RHP RPM	RADIANT HEATING PANEL REVOLUTION PER MINUTE	P ₍₂₎ SD (3)	(3) SMOKE DETECTOR	+0+	TEE UP
RTH RTU	RADIANT TUBE HEATER ROOF TOP (AIR CONDITIONING) UNIT		THERMOSTAT OR SENSOR CO2 SENSOR	+\$+	BRANCH - BOTTOM OF PIPE
SA SC	SUPPLY AIR SENSIBLE CAPACITY	2	KEYED NOTE	__\\\\\\\\\\\\\\\\\\\\\\\\\\\\\	BRANCH - TOP OF PIPE
SP SPEC.	STATIC PRESSURE SPECIFICATION			<u></u>	ELBOW
TC TSP T'STAT	TOTAL CAPACITY TOTAL STATIC PRESSURE THERMOSTAT			+ +	TEE
TYP. UH	TYPICAL UNIT HEATER			×	45° ELBOW CAP
VAV VAVB	VARIABLE AIR VOLUME VARIABLE AIR VOLUME TERMINAL			<u> </u>	END OF LINE CLEANOUT
VSD WB	VARIABLE SPEED (FREQUENCY) DRIVE WET BULB TEMPERATURE			, "	
WG '	WATER GAUGE FEET				
ø	INCHES ROUND DUCT				
∠ DETAIL/SECTION I	NUMBER				
X X X	DETAIL/SECTION DESIGNATION				
X SHEET NUMBER					

* NOT ALL SYMBOLS MAY APPLY TO THIS PROJECT



M001 MECHANICAL NOTES, LEGEND, & INDEX

M101 HVAC FLOOR PLAN

M102 MEZZANINE MECHANICAL PLANS

M201 MECHANICAL PIPING FLOOR PLAN

M301 MECHANICAL SECTIONS

M401 MECHANICAL DETAILS

M402 MECHANICAL DETAILS

M501 MECHANICAL SCHEDULES



ODITION

MAINTENANCE SHOP A

4314 STADIUM BLVD.
JONESBORO, ARKANSAS

HANICAL NOTES, LE

DESCRIPTION 04/03/25 Post Bid ADD #1

24-096

ISSUE SET

02.14.2025

M001



CRAIGHEAD ELECTF
MAINTENANCE SHOP ADDITION
AND AND STANKING BIND

HVAC FLOOR PLAN

 NO.
 DATE
 DESCRIPTION

 1
 03/06/25
 ADD #1

 2
 04/03/25
 Post Bid ADD #1


24-096

02.14.2025

ISSUE SET

M101

M102

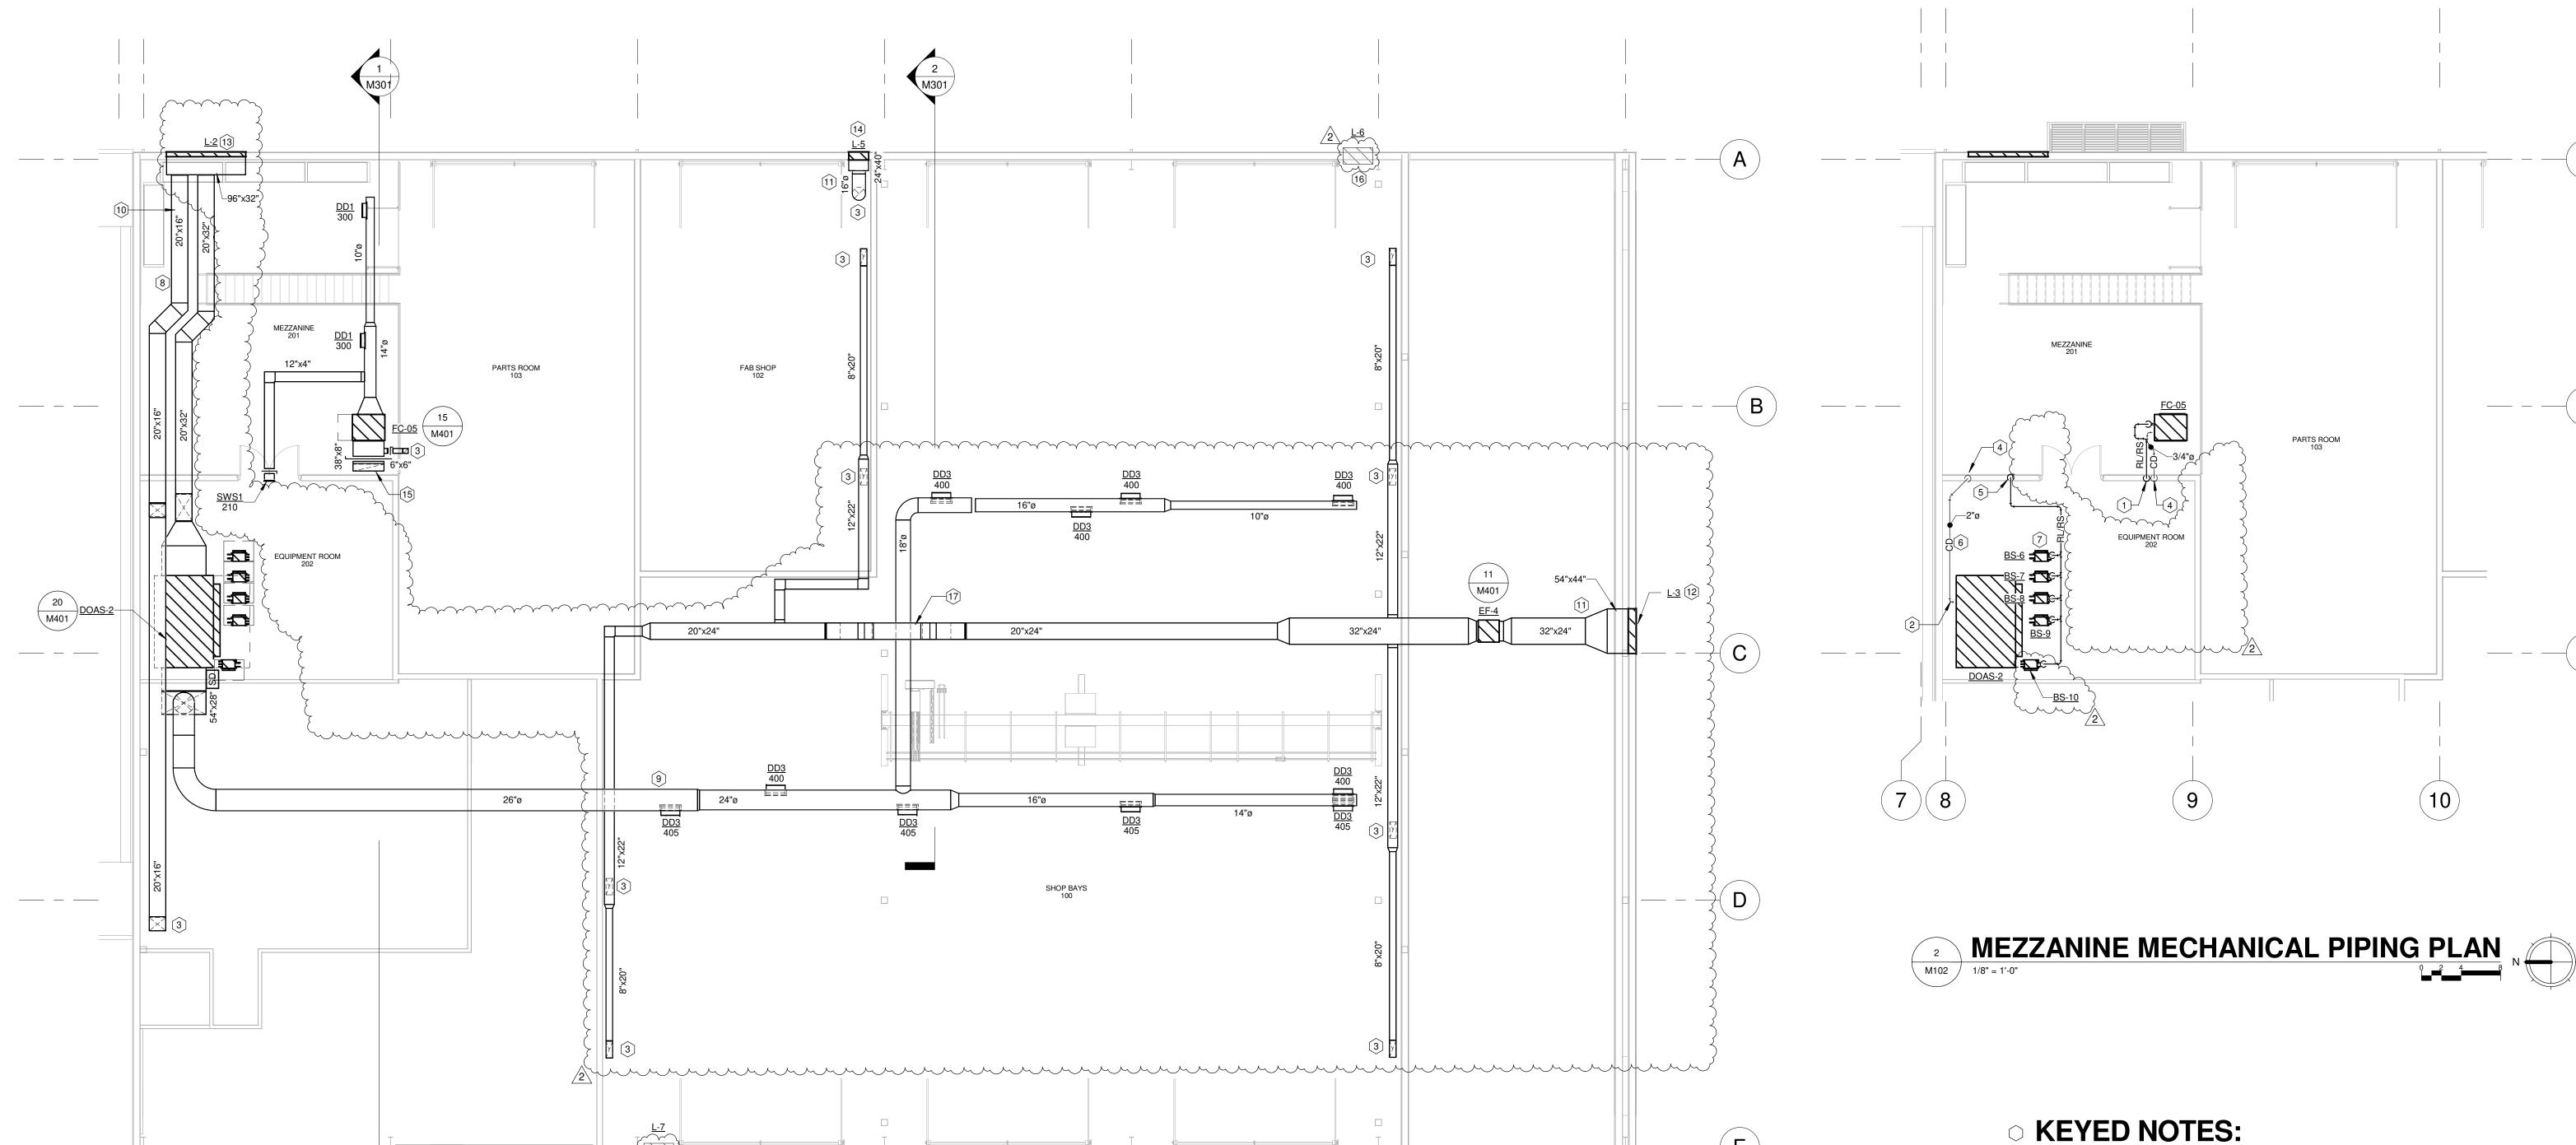


MEZZANINE HVAC PLAN
N102 1/8" = 1'-0"
N

- 1 REFRIGERANT LINE SET RISE UP FROM BRANCH SELECTOR BS-1 BELOW.
- 2 PROVIDE CONDENSATE TRAP PER DETAIL 13/M401.
- 3 DUCT DROPS TO FLOOR BELOW. SEE 1/M101 FOR CONTINUATION.
- 4 CONDENSATE LINE DROPS IN WALL TO PLENUM BELOW. SEE 1/M201 FOR CONTINUATION.
- 5 REFRIGERANT LINE SETS RISE IN WALL FROM PLENUM BELOW. SEE 1/M201 FOR CONTINUATION.
- 6 CONDENSATE DRAIN LINE SUPPORTED OFF EQUIPMENT ROOM FLOOR PER DETAIL 12/M401.
- 7 BRANCH SELECTOR MOUNTED HIGH IN SPACE. SUPPORT FROM ROOF STRUCTURE SIMILAR TO FAN COILS AND EXHAUST FANS. (TYPICAL)
- 8 OUTSIDE AIR INTAKE DUCTS TO BE INSULATED WITH 2" FIBERGLASS WRAP.
- 9 SUPPLY AIR DUCTS FROM DOAS-2 AND 3 TO BE DOUBLE WALL LINED SHEET METAL. 10 OUTSIDE AIR INTAKE DUCTS TO CONNECT TO LOUVER L-2 WITH LINED SHEET METAL PLENUM.
- 11 EXHAUST DUCT TO CONNECT TO LOUVER WITH SHEET METAL PLENUM.
- 12 BOTTOM OF LOUVER MOUNTED 26'-3" A.F.F.
- 13 BOTTOM OF LOUVER MOUNTED 23'-6"" A.F.F.
- 14 BOTTOM OF LOUVER MOUNTED 23'-2" A.F.F.
- 15 TERMINATE RETURN DUCT WITH DOWN-TURNED ELBOW.
- COVER OPENING WITH EXPANDED WIRE MESH.
- 16 TOP OF LOUVER MOUNTED 26'-0" A.F.F. 17 EXHAUST DUCT RISES ABOVE 18"Ø OUTSIDE SUPPLY AIR DUCT ABOVE CRANE.



ISSUE SET

M201

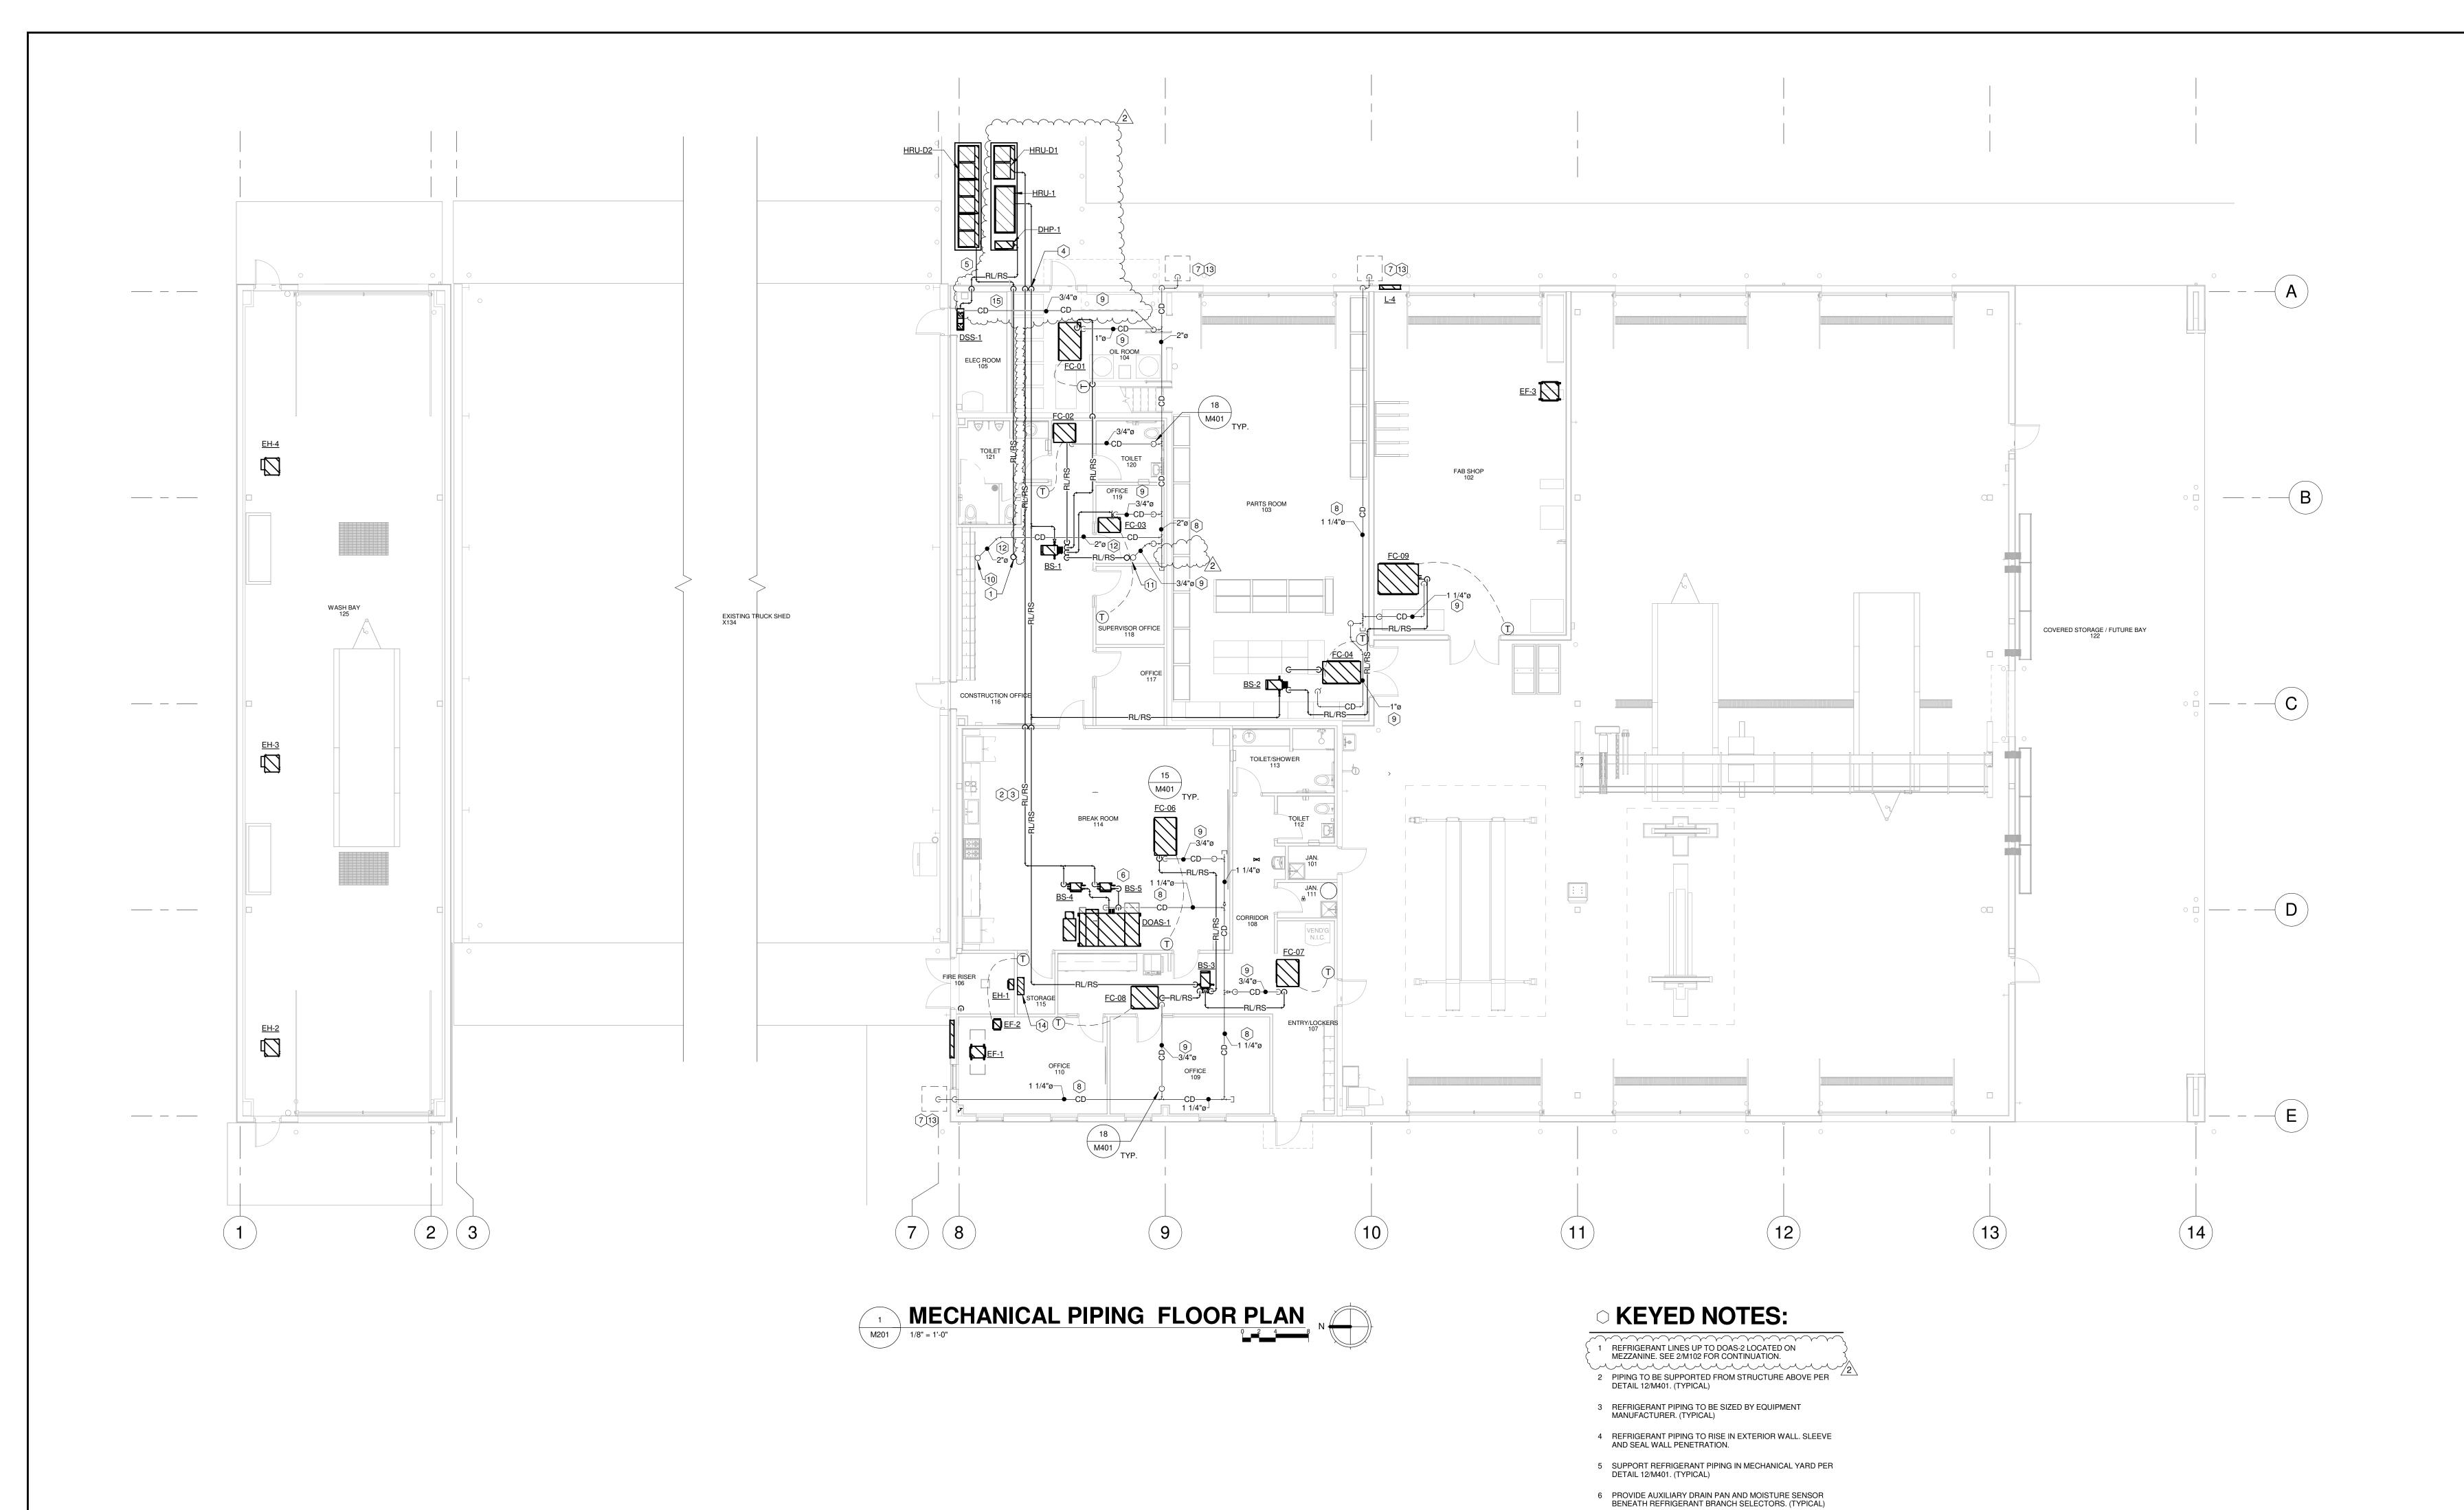

7 CONDENSATE DRAIN PIT PER DETAIL 14/M401.

8 ROUTE TYPE 'L' COPPER GRAVITY CONDENSATE DRAIN LINE TO CONDENSATE DRAIN PIT. (TYPICAL)

9 ROUTE TYPE 'L' COPPER PUMPED CONDENSATE DRAIN LINE FROM FAN COIL UNITS TO HUB DRAIN IN GRAVITY CONDENSATE LINE. (TYPICAL)

11 REFRIGERANT LINE SET AND CONDENSATE LINE UP TO FAN COIL FC-05 LOCATED ON MEZZANINE.

10 2" CONDENSATE LINE DROPS FROM MEZZANINE ABOVE.

12 CONDENSATE DRAIN LINE ROUTED HIGH IN BETWEEN

14 BAS CONTROL PANEL.

13 CONDENSATE DRAIN LINE DROPS WITHIN EXTERIOR WALL TO CONDENSATE DRAIN PIT. SLEEVE AND SEAL WALL PENETRATION.

15 COORDINATE EXACT ROUTING OF CONDENSATE DRAIN PIPING AND REFRIGERANT PIPING WITH ELECTRICAL GEAR.

 $\frac{2}{2}$

Vulley Market Ma

IN FESSIONAL ENGINEER No. 9419


Batson Inc.

1300 Brookwood Drive Little Rock Arkansas 72202 501-664-3311 www.batson.com

ISSUE SET

M301

Batson Inc.

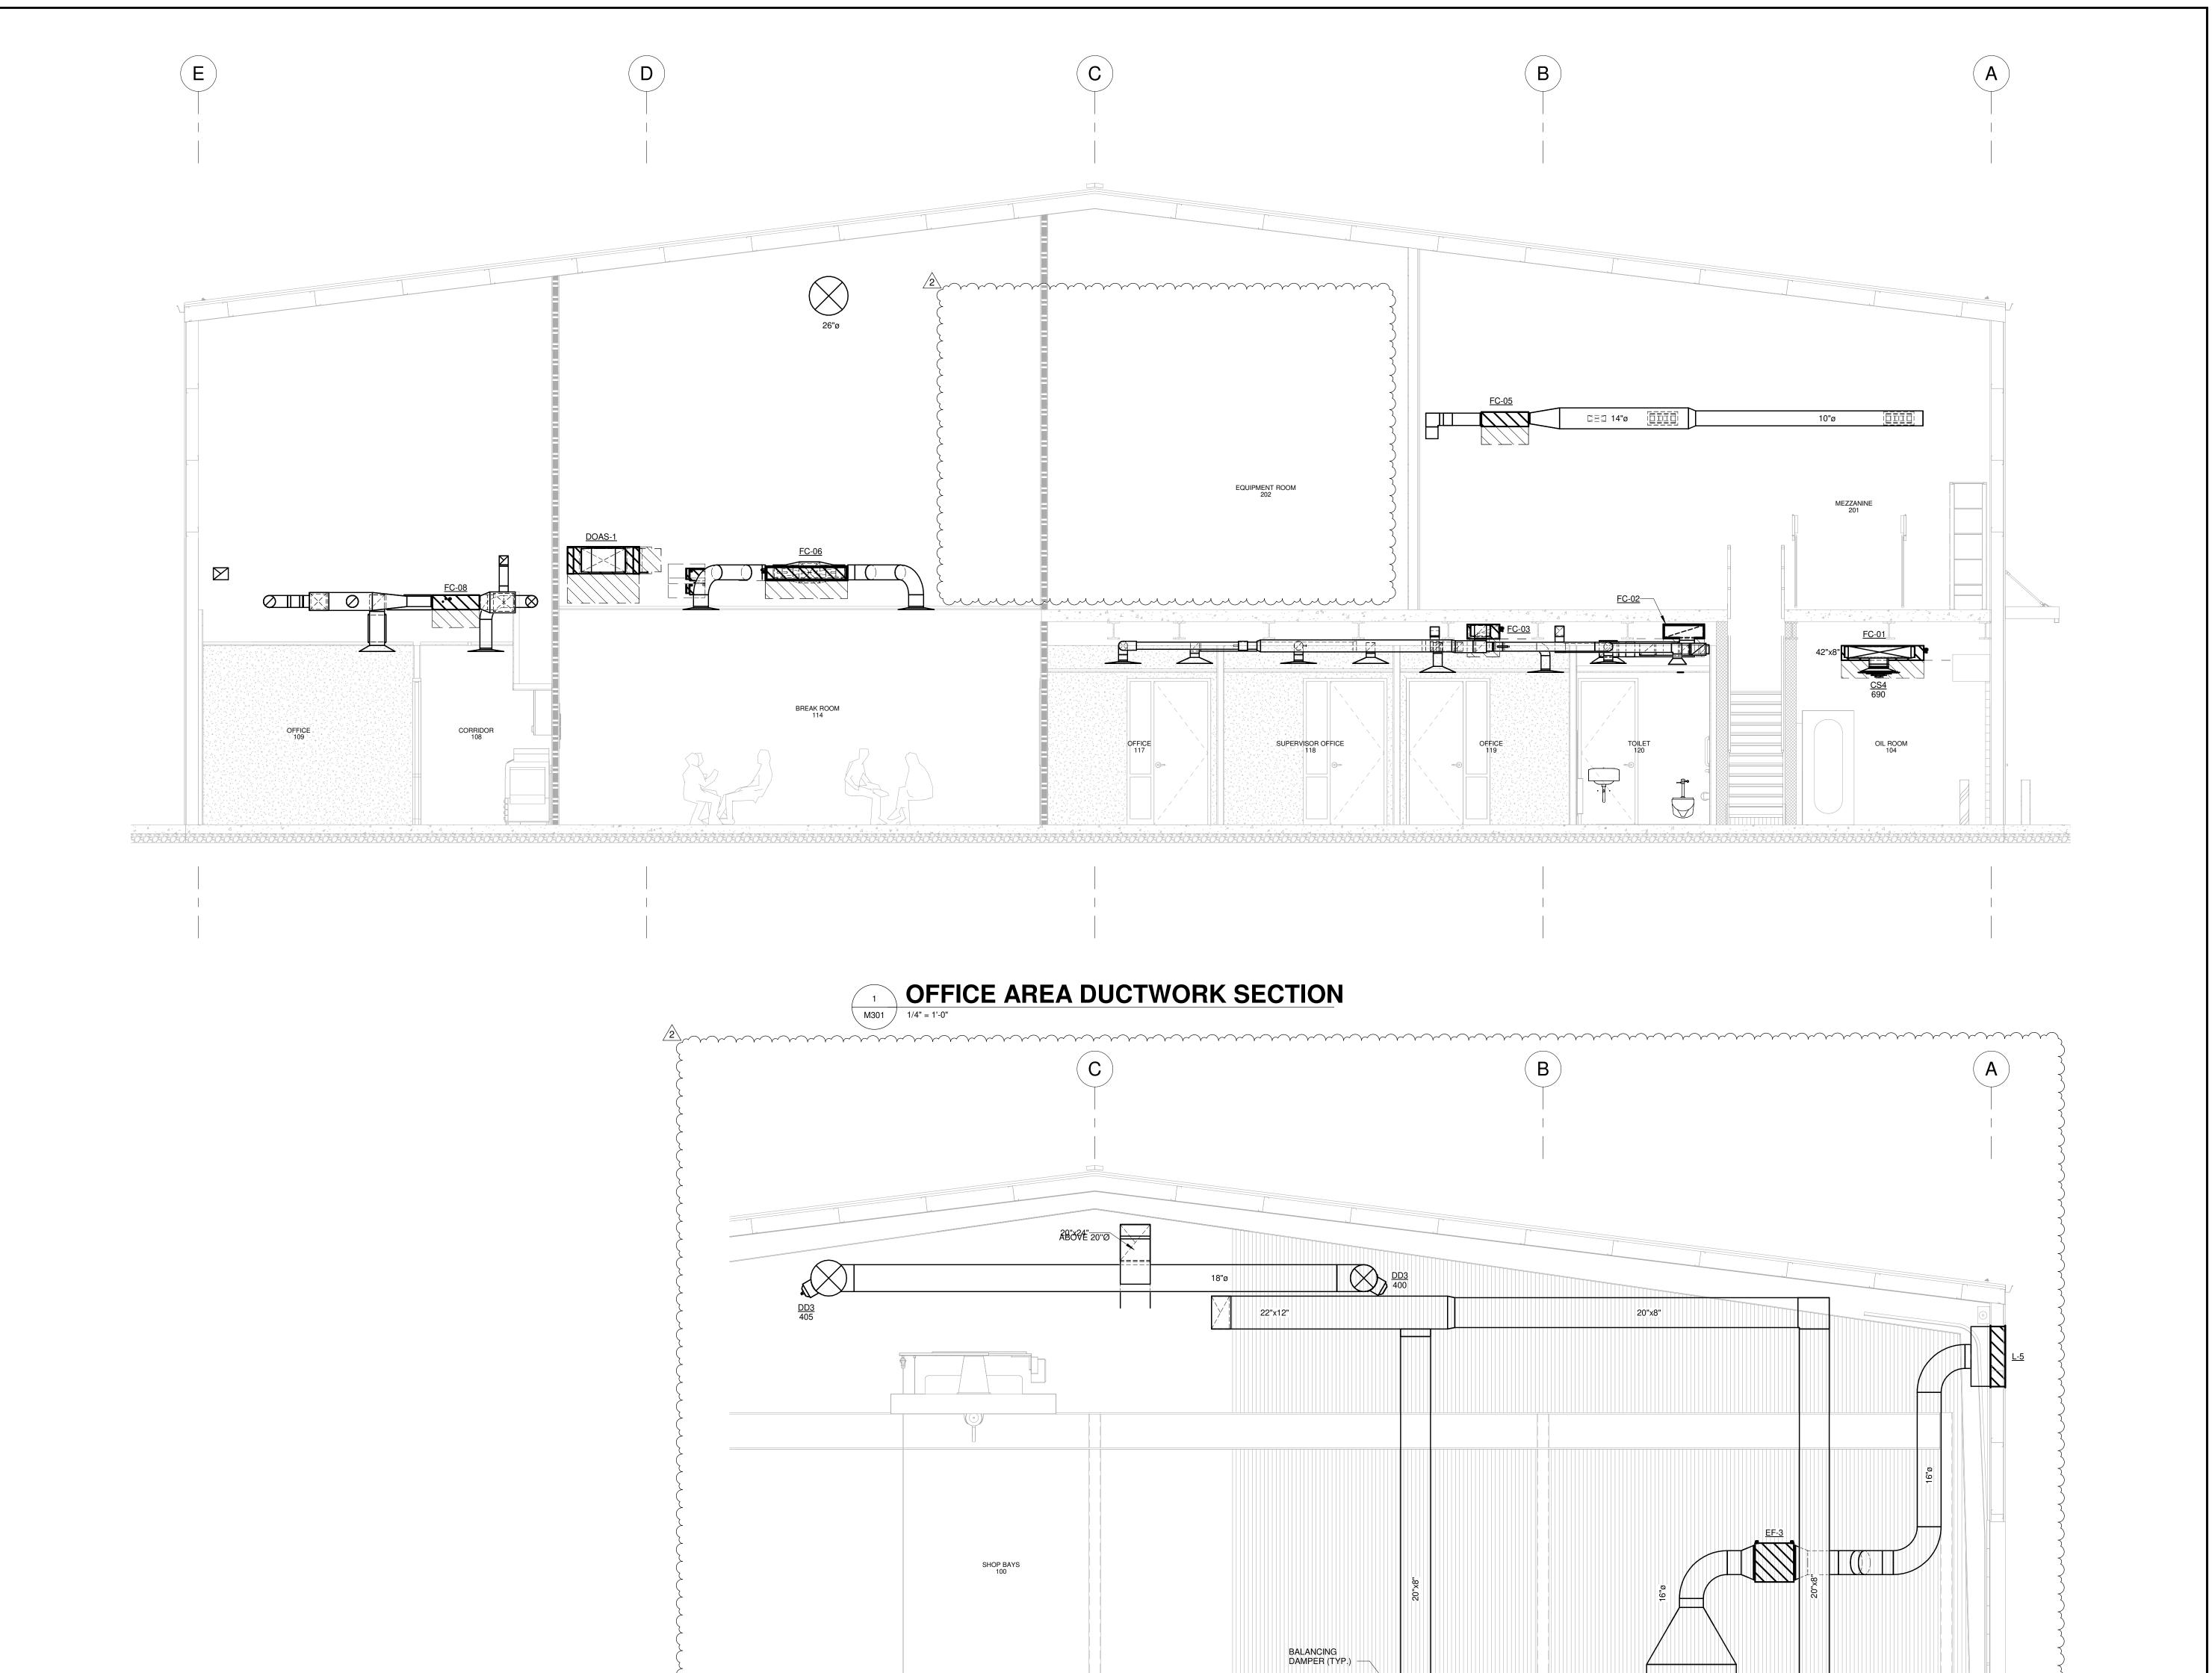

municum municum manus ma

PER DETAIL 13/M401

DOAS-2

NOTTOSCALE

MEZZANINEFLOOR -

WALL DUCT SUPPORT

M401 NOT TO SCALE

SEE PLANS FOR-

CONDENSATE SIZE AND ROUTING



V D D

ARCHITECTS

SHEAD ELECTRIC

NANCE SHOP ADDITION
4314 STADIUM BLVD.
JONESBORO, ARKANSAS

MECHANICAL DETAILS

 NO.
 DATE
 DESCRIPTION

 1
 03/06/25
 ADD #1

 2
 04/03/25
 Post Bid ADD #1

24-096

02.14.2025


ISSUE SET

M401

CRAIGHEAD ELECTRIC
MAINTENANCE SHOP ADDITION
4314 STADIUM BLVD.
JONESBORD ARKANSAS


M402



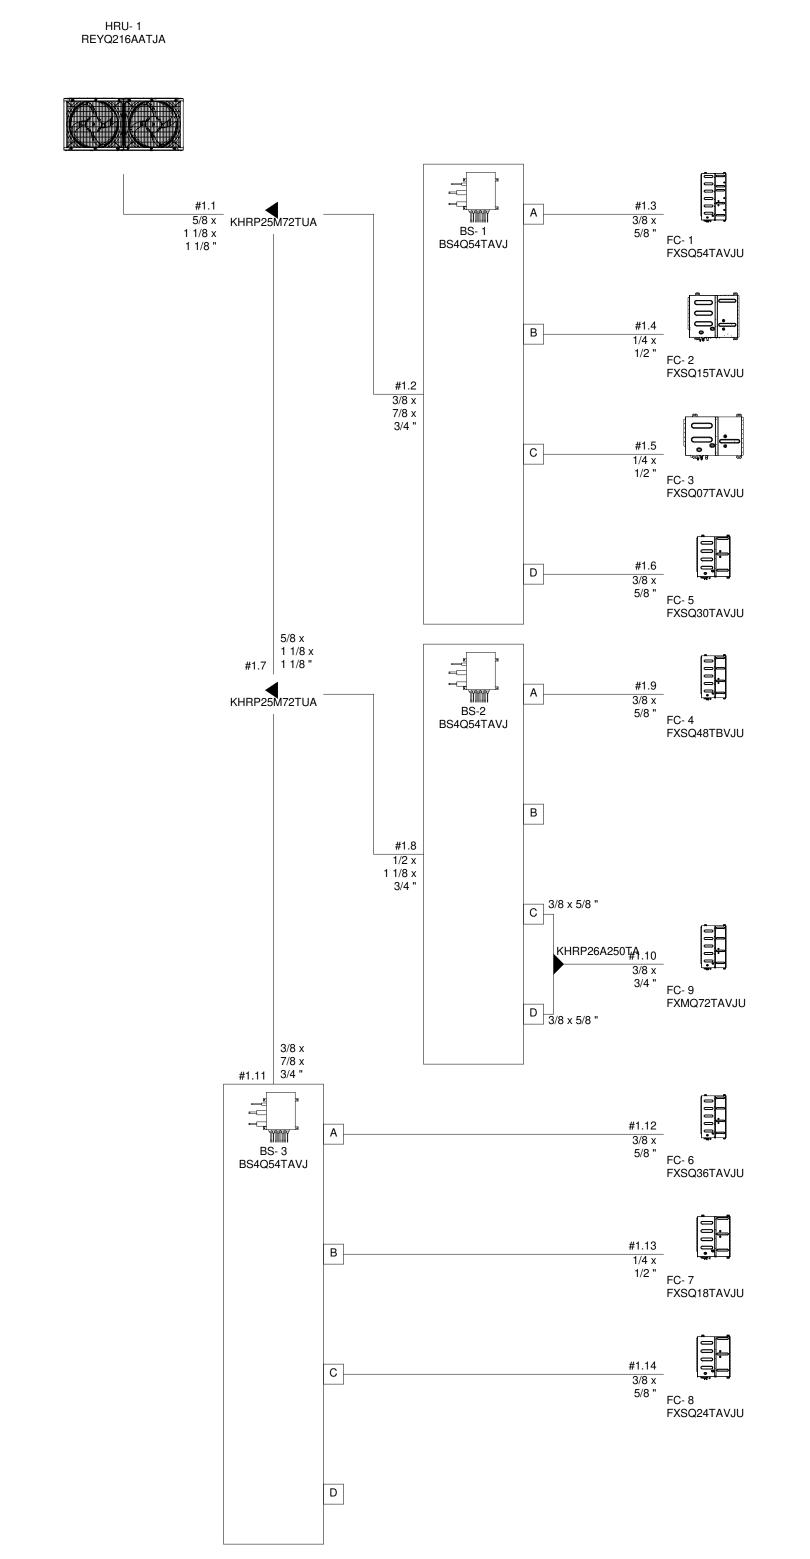


HRU-1 VRV PIPING

M402 NOT TO SCALE

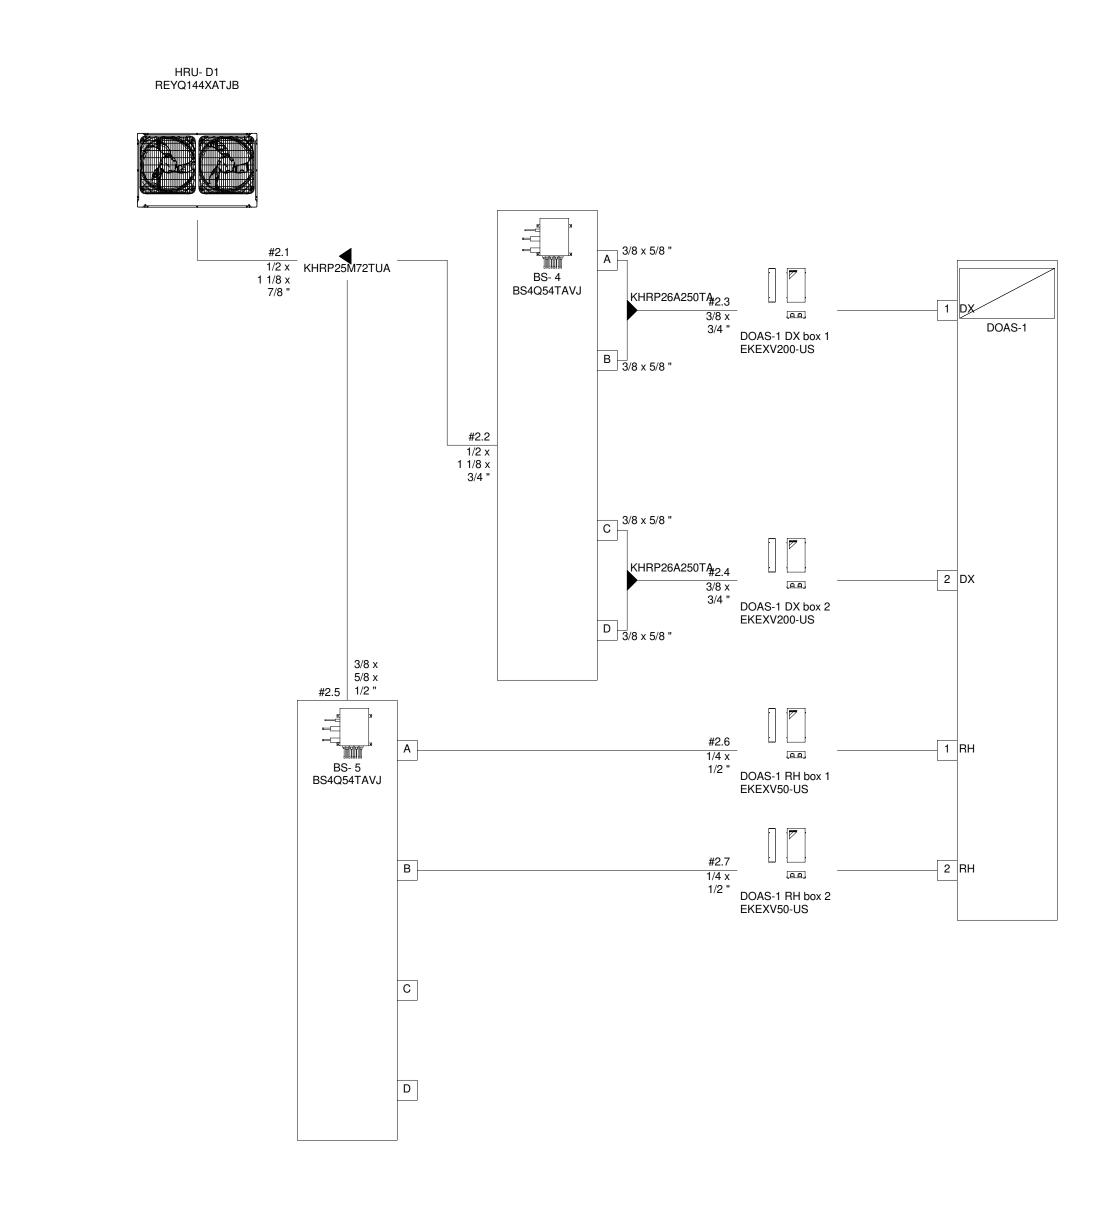



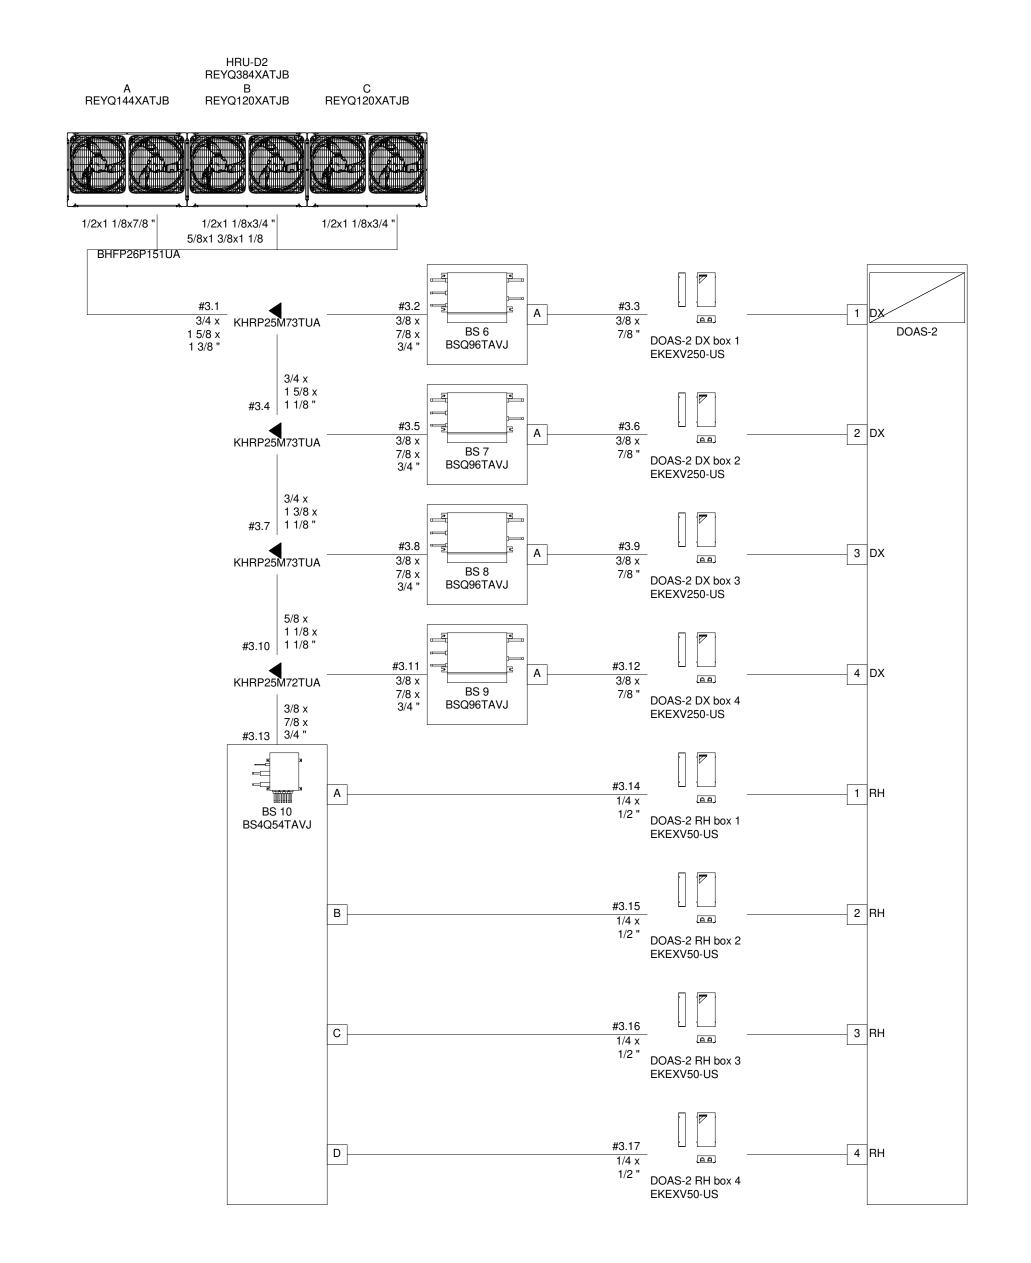



M501

Batson Inc.

	NOMBIAI		COOL	ING CAPACITY	HEATI	NG CAPACITY	REFRIGERANT CHARGE	CONNECTION						ELECTRIC	CAL										FFICIENCY	,		
MARK	NOMINAL TONNAGE	DESCRIPTION	COOL	ING CALACITI	IILAIII		TELLINGENANT CHANGE	RATIO	VOLTAGE /		MCA	A			MOP			RLA		MANUFACTURER	MODEL	WEIGHT			- I I I I I I I I I I I I I I I I I I I			REMARKS
			BTU/h	AMBIENT DESIGN (°F DB)	BTU/H	AMBIENT DESIGN (°F DB / WB)	FACTORY CHARGE (LBS)	(%)	PHASE	MOD #1	MOD #2	MOD #3	TOTAL	MOD #1	MOD #2	MOD #3 TOTAL	MOD #1	MOD #2 MOD #3	TOTAL			(LBS)	EER	IEER	COP47	COP17	SCHE	
HRU- 1	18	AIR COOLED HEAT RECOVERY (1)	210,157	100	173,914	10.0 / 8.0	25.79	141	208V / 3	67.2			67.2	70.0		70.0	40.0		40.0	DAIKIN	REYQ216AATJA	956.8	11	20.5	3.25	2.05	21.9	
HRU-D1	12	AIR COOLED HEAT RECOVERY (1)	140,838	100	137,685	10.0 / 8.0	25.79	100	208V / 3	58.3			58.3	70.0		70.0	42.6		42.6	DAIKIN	REYQ144XATJB	727	11.6	21.6	3.42	2.12	22	
HRU-D2	32	AIR COOLED HEAT RECOVERY (3)	372,618	100	287,936	10.0 / 8.0	77.4	100	208V / 3	58.3	43.0	43.0	144.3	70.0	50.0	50.0 170.0	42.6	28.2 28.2	99.0	DAIKIN	REYQ384XATJB	727.0 / 727.0/727.0	9.9	17.6	3.2	20.6	17	
HRU-D3		NOT USED																										NOT USED

			1	AN DATA		COOLING DX			HEATING	G DX	HGRH C	OIL	ELE	ECTRIC PREHEAT	UNIT	ELECTR	ICAL DATA				
MARK	LOCATION	SERVES	CFM E	SP POWER (K	N) TOTAL CAPACIT (MBH)	SENSIBLE CAPACITY (MBH)	EDB/EWB	LDB/LWB	CAPACITY (MBH)	EDB/LDB C	CAPACITY (BTUH)	EDB/LDB	KW	SEAPARATE ELECTRICAL CONNETION	VOLTS/PHASE	MCA	МОР	FLA	MANUFACTURER	MODEL	REMARKS
DOAS-1	BREAKROOM 114	OFFICE AREA / FAB SHOP/ PARTS ROOM	1590 0	75 0.78	127.3	72.5	96/77	54.7/53.7	108.2	17/80	43.4	55/80	6	YES	208/1	8.8	15.0	8.6	OXYGEN 8	T18IN	PROVIDE DAIKIN VALVE INTEGRATION KIT
DOAS-2	EQUIPMENT ROOM 202	SHOP BAYS 100	4020 0	75 1.6	372.5	210.8	99/78	51.5/51.0	238.8	17/72	79.5	52/70	15	NO O O O	208/3	52.1	60.0	41.7	OXYGEN 8	T48IN	PROVIDE DAIKIN VALVE INTEGRATION KIT
DOAS-3	NOT USED	NOT USED																			NOT USED

VAR	IABLE	REFRIGERA	ANT VOL	UME - I	NDOC	R UN	IT SC	HEDU	LE											
			CONNEC	CTED TO:				COOLING	CAPACITY		HEATING	CAPACITY	(ELECTRICAL				DIMENSIONS		
MARK	NOMINAL TONNAGE	TYPE	CONDENSING	ZONE	DESIGN AIRFLOW	OSA AIRFLOW	TOTAL	SENSIBLE	E	AT	TOTAL	EAT				MANUFACTURER	MODEL	WxHxD	WEIGHT	REMARKS
			UNIT	CHANGEOVER DEVICE	(CFM)	(CFM)	BTU/h	BTU/h	°F DB	°F WB	BTU/h	°Fdb	VOLTS - PHASE	MCA	MOP			inch	lbs	
FC-01	4.5	MSP Concealed Ducted Unit	HRU-1	Yes	1.377	20	43,675	32,943	72.5	61	59,932	68	208-230V 1ph	3.3	15	DAIKIN	FXSQ54TAVJU	61.0 x 9.6 x 31.5	104	
FC-02	1.3	MSP Concealed Ducted Unit	HRU-1	Yes	441	320	12,079	8,902	70.5	61	16.411	68	208-230V 1ph	1.4	15	DAIKIN	FXSQ15TAVJU	27.6 x 9.6 x 31.5	60	
FC-03	0.6	MSP Concealed Ducted Unit	HRU-1	Yes	230	50	6,210	4,684	71.4	61	8,308	68	208-230V 1ph	0.8	15	DAIKIN	FXSQ07TAVJU	21.7 x 9.6 x 31.5	55	
FC-04	4	MSP Concealed Ducted Unit	HRU-1	Yes	1307	75	38,834	28,200	71.6	61	53,295	68	208-230V 1ph	2.8	15	DAIKIN	FXSQ48TAVJU	55.1 x 9.6 x 31.5	104	
FC-05	2.5	MSP Concealed Ducted Unit	HRU-1	Yes	812	80	24,226	18,186	71.1	61	33,505	68	208-230V 1ph	1.8	15	DAIKIN	FXSQ30TAVJU	39.4 x 9.6 x 31.5	82	
FC-06	3	MSP Concealed Ducted Unit	HRU-1	Yes	1130	420	29,140	18,221	68.2	61	37,839	68	208-230V 1ph	2.5	15	DAIKIN	FXSQ36TAVJU	55.1 x 9.6 x 31.5	101	
FC-07	1.5	MSP Concealed Ducted Unit	HRU-1	Yes	600	320	14,500	11,788	72.7	61	19,960	68	208-230V 1ph	1.6	15	DAIKIN	FXSQ18TAVJU	39.4 x 9.6 x 31.5	77	
FC-08	2	MSP Concealed Ducted Unit	HRU-1	Yes	742	90	19,279	13,885	73.1	61	26,494	68	208-230V 1ph	1.8	15	DAIKIN	FXSQ24TAVJU	39.4 x 9.6 x 31.5	82	
FC-09	6	Concealed Ducted (Medium Static)	HRU- 1	Yes	2047	215	56,900	45,116	71.6	61	84,000	68	208-230V 1ph	9	15	DAIKIN	FXMQ72MVJU	54.3 x 18.1 x 43.3	302	

MARK	CONDENSING UNIT SERVED	VOLTAGE- PHASE	(MCA)	(MOP)	MAX CAPACITY (PER PORT)	DIMENSIONS (WxHxD IN)	MANUFACTURER	MODEL	WEIGHT (lbs) REMARKS
BS-1	HRU- 1	208-230V 1ph	0.4	15	54	14.6 x 11.7 x 18.9	DAIKIN	BS4Q54TAVJ	48.5
BS-2	HRU- 1	208-230V 1ph	0.4	15	54	14.6 x 11.7 x 18.9	DAIKIN	BS4Q54TAVJ	48.5
BS-3	HRU- 1	208-230V 1ph	0.4	15	54	14.6 x 11.7 x 18.9	DAIKIN	BS4Q54TAVJ	48.5
BS-4	HRU- D1	208-230V 1ph	0.4	15	54	14.6 x 11.7 x 18.9	DAIKIN	BS4Q54TAVJ	48.5
BS-5	HRU- D1	208-230V 1ph	0.4	15	54	14.6 x 11.7 x 18.9	DAIKIN	BS4Q54TAVJ	48.5
BS-6	HRU-D2	208-230V 1ph	0.1	15	96	15.3 x 8.1 x 12.8	DAIKIN	BSQ96TAVJ	33.1
BS-7	HRU-D2	208-230V 1ph	0.1	15	96	15.3 x 8.1 x 12.8	DAIKIN	BSQ96TAVJ	33.1
BS-8	HRU-D2	208-230V 1ph	0.1	15	96	15.3 x 8.1 x 12.8	DAIKIN	BSQ96TAVJ	33.1
BS-9	HRU-D2	208-230V 1ph	0.1	15	96	15.3 x 8.1 x 12.8	DAIKIN	BSQ96TAVJ	33.1
BS-10	HRU-D2	208-230V 1ph	0.4	15	54	14.6 x 11.7 x 18.9	DAIKIN	BS4Q54TAVJ	48.5
BS-11	NOT USED								NOT USED
BS-12	NOT USED								NOT USED
BS-13	NOT USED								NOT USED
BS-14	NOT USED								NOT USED
BS-15	NOT USED								NOT USED

VARIABLE REFRIGERANT VOLUME - AIR-COOLED CONDENSING UNIT SCHEDULE

DUCT	TLESS SI	PLIT SYS	STEM S	SCHEDU	JLE								
MARK	LOCATION	SERVES	SENSIBLE CAPACITY	COOLING CFM HIGH/MED/LOW	HEAT CAPACITY			ICAL DATA VOLTS/PHASE	SEER	EER	MANUFACTURER	MODEL	REMARKS
DSS-1/DHP-1	ELEC ROOM 105/MECH YARD	ELEC ROOM 105	8,800 BTUH	431/322/249	9,400 BTUH	12.35	15	208/1	18.0	11.0	DAIKIN	FTX08BXVJU-RXB09BXVJU	PROVIDE WITH LOW AMBIENT KIT, THERMOSTAT AND CONDENSATE PUMP.

MARK	SYSTEM	STYLE	NECK SIZE	FACE SIZE	MAX CFM	APD (IN-WG)	MAX N.C.	MATERIAL	FINISH	MANUFACTURER	MODEL	REMARKS
CS1	SUPPLY AIR	SQUARE LOUVERED DIFFUSER	6"Ø	24"X24"	100	0.1	30	STEEL	WHITE	PRICE	SMD SERIES	Column13
CS2	SUPPLY AIR	SQUARE LOUVERED DIFFUSER	8"Ø	24"X24"	210	0.1	30	STEEL	WHITE	PRICE	SMD SERIES	
CS3	SUPPLY AIR	SQUARE LOUVERED DIFFUSER	10"Ø	24"X24"	400	0.1	30	STEEL	WHITE	PRICE	SMD SERIES	
CS4	SUPPLY AIR	ROUND CONE DIFFUSER	12"Ø	27"Ø	700	0.1	30	STEEL	WHITE	PRICE	RCD SERIES	
SWS1	SUPPLY AIR	LOUVERED SUPPLY	4"X12"	6"X14"	300	0.1	30	STEEL	WHITE	PRICE	520L	DOUBLE DEFLECTION
SWS2	SUPPLY AIR	LOUVERED SUPPLY	6"X16"	8"X18"	400	0.1	30	STEEL	WHITE	PRICE	520L	DOUBLE DEFLECTION
DD1	SUPPLY AIR	HIGH CAPACITY DRUM DIFFUSER	6"X18"	8"X20"	325	0.1	30	STEEL	WHITE	PRICE	HCD SERIES	PROVIDE WITH INTEGRAL DAMPER
DD2	SUPPLY AIR	HIGH CAPACITY DRUM DIFFUSER	10"X24"	12"X26"	805	0.1	30	STEEL	WHITE	PRICE	HCD SERIES	PROVIDE WITH INTEGRAL DAMPER
DD3	SUPPLY AIR	HIGH CAPACITY DRUM DIFFUSER	10"X18"	12"X20"	450	0.1	30	STEEL	WHITE	PRICE	HCD SERIES	PROVIDE WITH INTEGRAL DAMPER
CR1	RETURN AIR	EGG CRATÉ FACE RETURN	6"X6"	24"X24"	100	0.1	30	ALUMINUM	WHITE	PRICE	80 SERIES	
CR2	RETURN AIR	EGG CRATE FACE RETURN	10"X10"	24"X24"	480	0.1	30	ALUMINUM	WHITE	PRICE	80 SERIES	
CR3	RETURN AIR	EGG CRATE FACE RETURN	12"X12"	24"X24"	610	0.1	30	ALUMINUM	WHITE	PRICE	80 SERIES	
CR4	RETURN AIR	EGG CRATE FACE RETURN	14"X14"	24"X24"	900	0.1	30	ALUMINUM	WHITE	PRICE	80 SERIES	
CR5	RETURN AIR	EGG CRATE FACE RETURN	22"X22"	24"X24"	2200	0.1	30	ALUMINUM	WHITE	PRICE	80 SERIES	
CE1	EXHAUST AIR	EGG CRATE FACE RETURN	6"X6"	12"X12"	100	0.1	30	ALUMINUM	WHITE	PRICE	80 SERIES	
CE2	EXHAUST AIR	EGG CRATE FACE RETURN	8"X8"	24"X24"	260	0.1	30	ALUMINUM	WHITE	PRICE	80 SERIES	
SWE1	EXHAUST AIR	HEAVY DUTY GYM (GRILLE	16"X24"	18"X26"	630	0.1	30	STEEL	WHITE	PRICE	91S SERIES	

3 PROVIDE FRAME STYLE / INSTALLATION TYPE AS REQUIRED FOR CEILING TYPE.

4 PROVIDE RAPID MOUNT FRAMS FOR AIR DEVICES MOUNTED IN CEILINGS OTHER THAN LAY-IN CEILINGS.


MARK	SERVES	TYPE		FAN DATA	1	l N	MOTOR DAT	Έ	SONNES	TOTAL UNIT	MANUFACTURER	MODEL	REMARKS
IVIANIN	SERVES	ITE	CFM	ESP	RPM	HP	VOLTS	PHASE	SOMMES	WEIGHT (LBS)	WANDFACTURER	MODEL	NEWANKS
EF-1	OFFICE AREA RESTROOM AND JANITOR	CENTRIFUGAL INLINE	725	0.5	1725	0.25	115	1	12.7	61	GREENHECK	SQ-99-VG	1,2,3
EF-2	STORAGE 115	INLINE CABINET	100	0.25	971	52 W	115	1	0.3	18	GREENHECK	CSP-A125	1,2,4
EF-3	FAB SHOP 102 WELDING HOOD	CENTRIFUGAL INLINE	3000	0.25	1160	1	115	1	8.4	120	GREENHECK	SQ-160-VG	1,2,5
EF-4	SHOP BAYS 100	CENTRIFUGAL INLINE	5025	0.5	1666	2	208	1	8.8	151	GREENHECK	SQ-16-VG	1,2,6
EF-5	NOT USED										GREENHECK		NOT USED
NOTES:													
	1 PROVIDE WITH DISCONNECT	4	. PROVIDE W	ITH LINE-VOLT	TAGE THERMO	OSTAT							
	2 PROVIDE WITH HANGING SPRING ISOLATOR	5	PROVIDE W	ITH LINE-VOLT	ΓAGE 1-HOUR	TIMER SWIT	CH (ADJ.)						
	3 PROVIDE WITH 24/7 PROGRAMMABLE TIMER	6	FAN TO INTE	RLOCK WITH	DOAS-2 AND	3 CONTROLS	SYSTEM						

MARK	EQUIPMENT SERVED	USE	MAX AIRFLOW	SI	ZE	FREE AREA	APD (IN-WG)	MANUFACTURER	MODEL	REMARKS
WANK	EQUIPIVIENT SERVED	USE	(CFM)	W"	H"	(SF)	APD (IIN-WG)	MANUFACTUREN	MODEL	NEWANNO
L-1	EF-1 & 2	EXHUAST	1,250	54	16	2.14	0.046	GREENHECK	ESD-635	1,2
L-2	DOAS-1&2	INTAKE AIR	2 5,610	96	32	9.7	0.122	GREENHECK	ECD-601	1,2,3
L-3	EF-4 2	EXHAUST AIR	5,025	54	44	5.6	0.10	GREENHECK	EACC-601	1,2,3,4 \ 2
L-4	EF-3	INTAKE AIR	2 3,000	30	40	3.54	0.101	GREENHECK	ECD-601 2	1,2,3
L-5	EF-3 2	EXHAUST AIR	3,000	24	44	3.26	0.115	GREENHECK	ECD-601	1,2,3
L-6	{ EF-4 }	INTAKE AIR	2,010	36	36	2.51	0.06	GREENHECK	EACC-601	1,2,3,4
L-7	EF- 4	INTAKE AIR	2,010	36	36	2.51	0.06	GREENHECK	EACC-601	1,2,8,4
NOTES:							2			

MARK	SERVES	TYPE	KW	MOTOR	ELE	CTRICAL [DATA	MANUFACTURER	MODEL	REMARKS
	322			HP/CFM	AMP	VOLTS	PHASE			
EH-1	FIRE RISER 106	SEMI-RECESS WALL MOUNT	1.5	1/125 HP	12.5	120	1	MARKEL	E3323TD-RP	1&2
EH-2	WASH BAY 125	WASHDOWN FAN FORCED UNIIT HEATER	5.0	400 CFM	24.1	208	1	MARKEL	F1F5505T-304	1&2
EH-3	WASH BAY 125	WASHDOWN FAN FORCED UNIIT HEATER	5.0	400 CFM	24.1	208	1	MARKEL	F1F5505T-304	1&2
EH-4	WASH BAY 125	WASHDOWN FAN FORCED UNIIT HEATER	5.0	400 CFM	24.1	208	1	MARKEL	F1F5505T-304	1&2
NOTES:										

S


P101

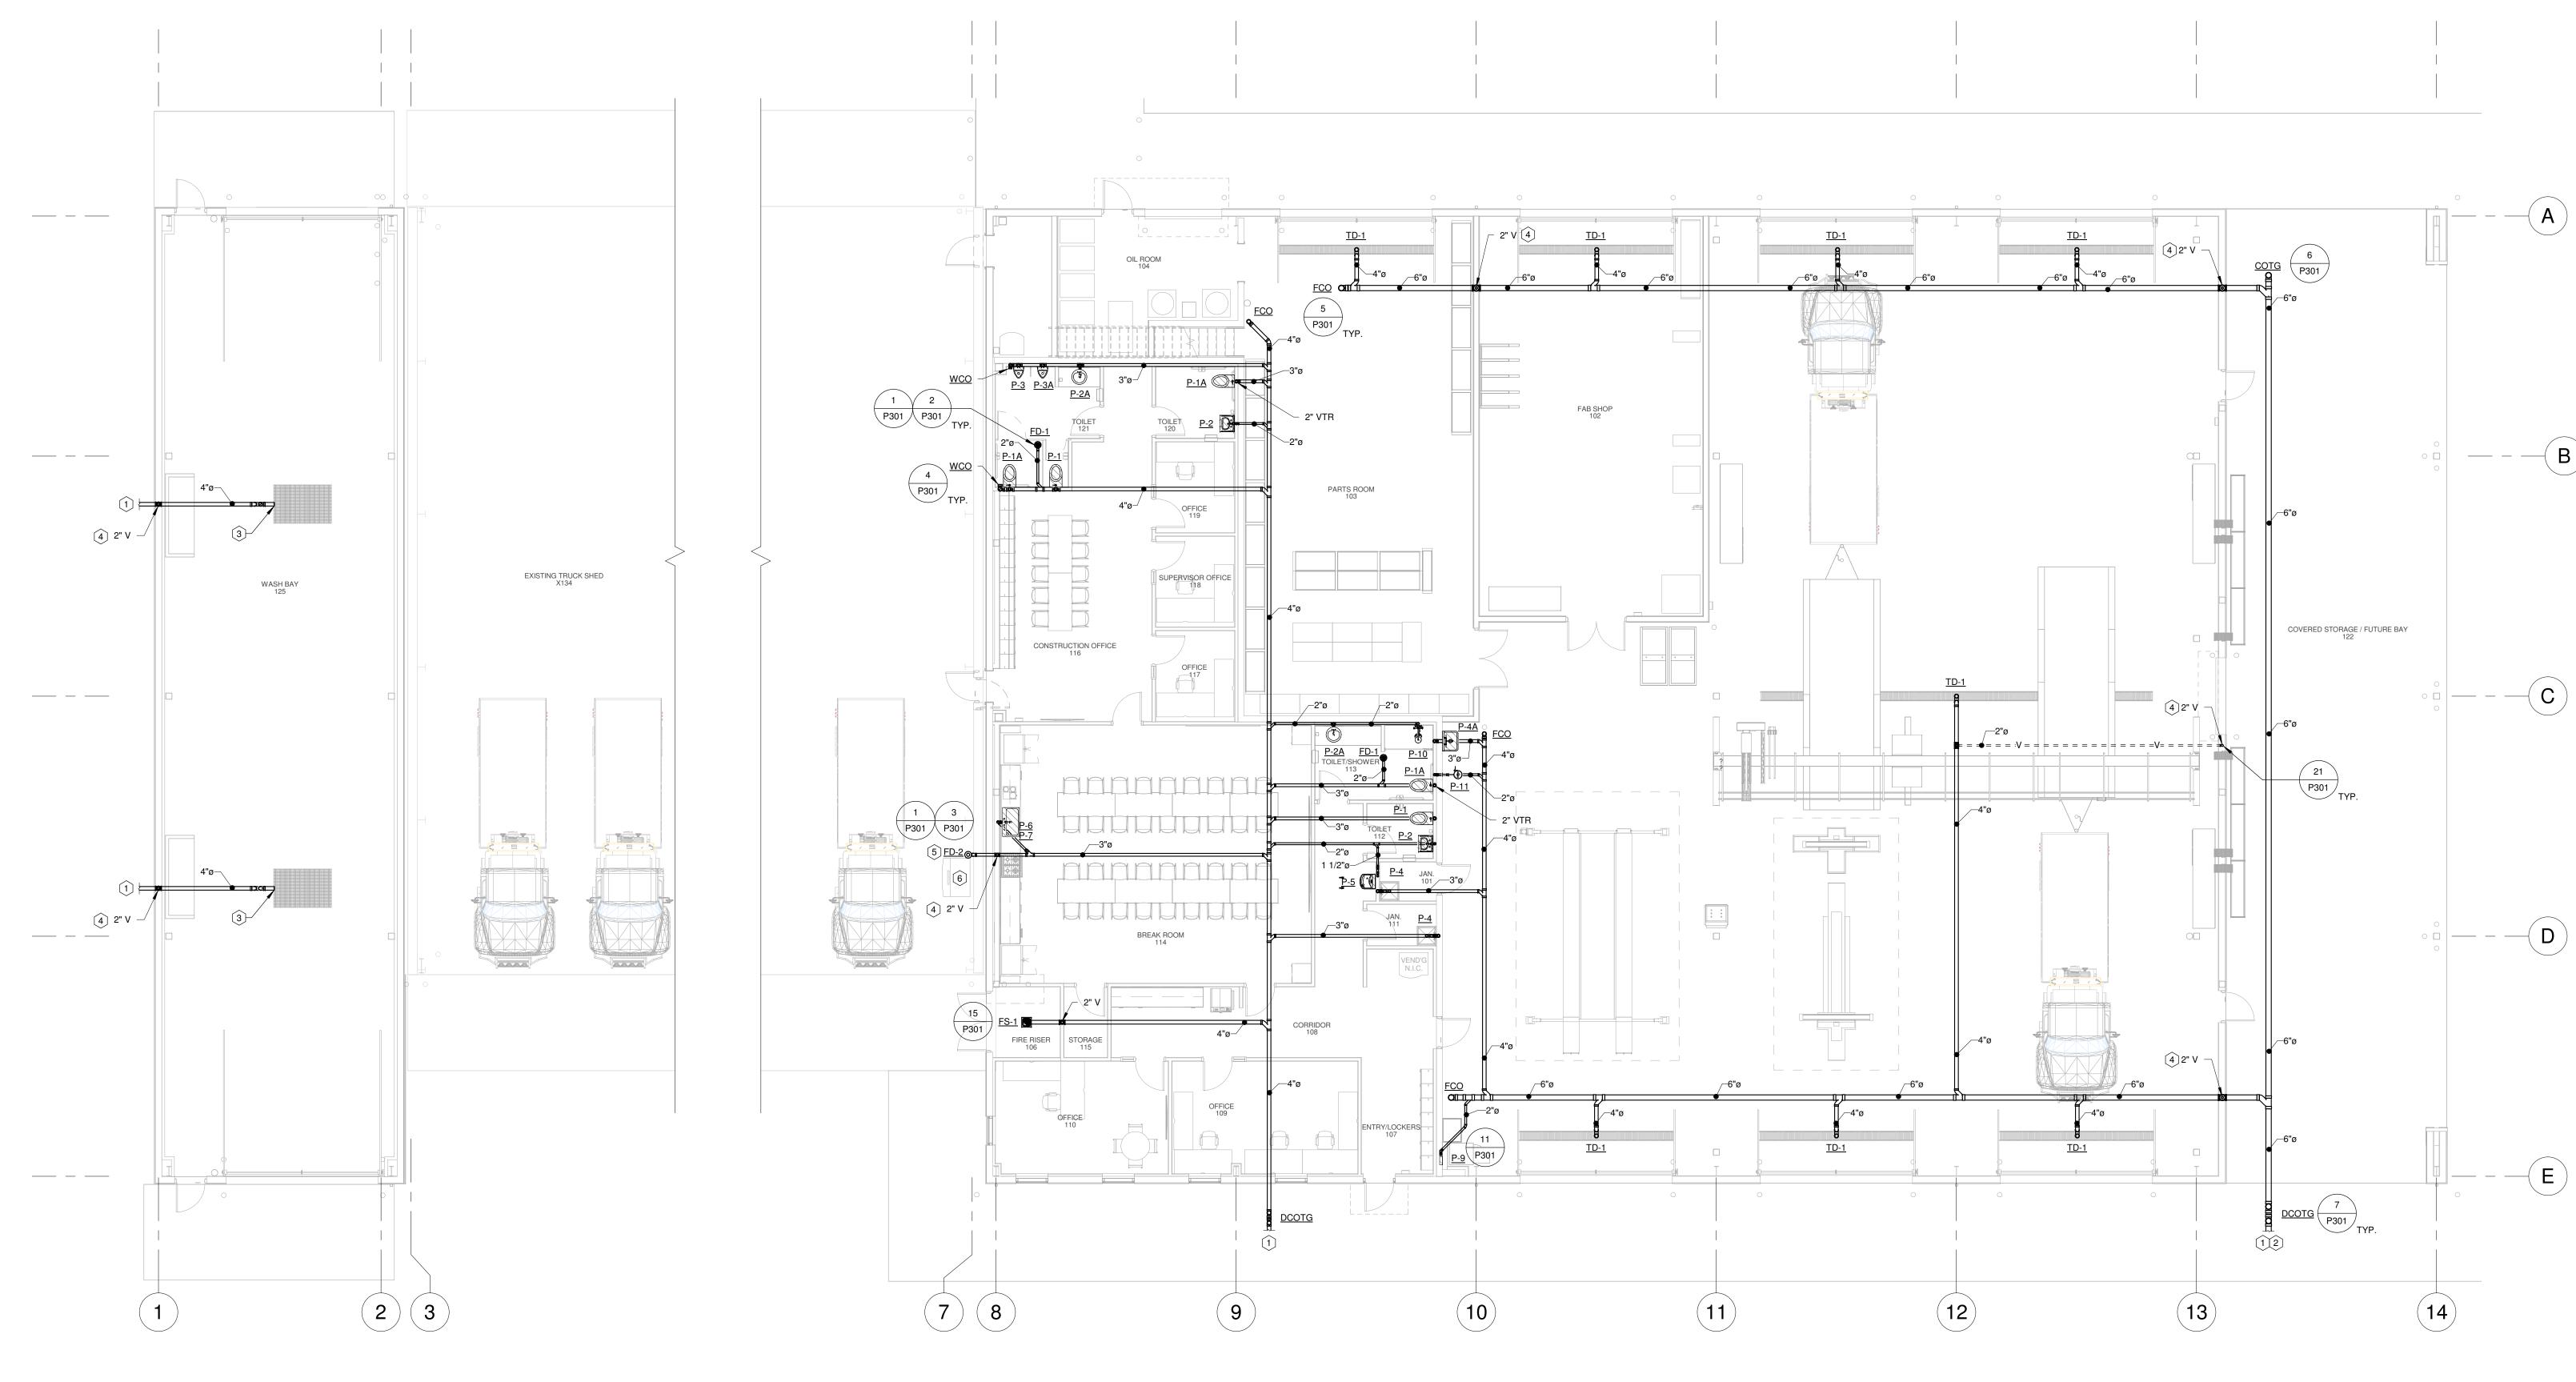



KEYED NOTES:

- 1 REFER TO CIVIL PLANS FOR CONTINUATION.
- 2 EXTEND SANITARY DRAIN LINE TO OIL/WATER SEPARATOR. SEPARATOR BY CIVIL.
- 3 4" DRAIN LINE CONNECTS TO DRAINAGE PIT 1'-0" BELOW FINISHED SLAB.
- 4 ROUTE 2" VENT UP THROUGH ROOF AND OFFSET AS REQUIRED TO MAINTAIN A MINIMUM OF 3'-0" FROM ROOF EDGE.
- 5 FLOOR DRAIN TO SERVE ICE MACHINE.
- 6 COORDINATE ICE MAKER EXACT LOCATION WITH EXHAUST CAP FROM VENT HOOD, TO AVOID CONFLICTS.

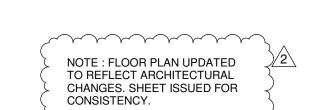






Batson Inc.

ENGINEERING SOLUTIONS

1300 Brookwood Drive Little Rock Arkansas 72202 501-664-3311 www.batson.com


ENGINEER

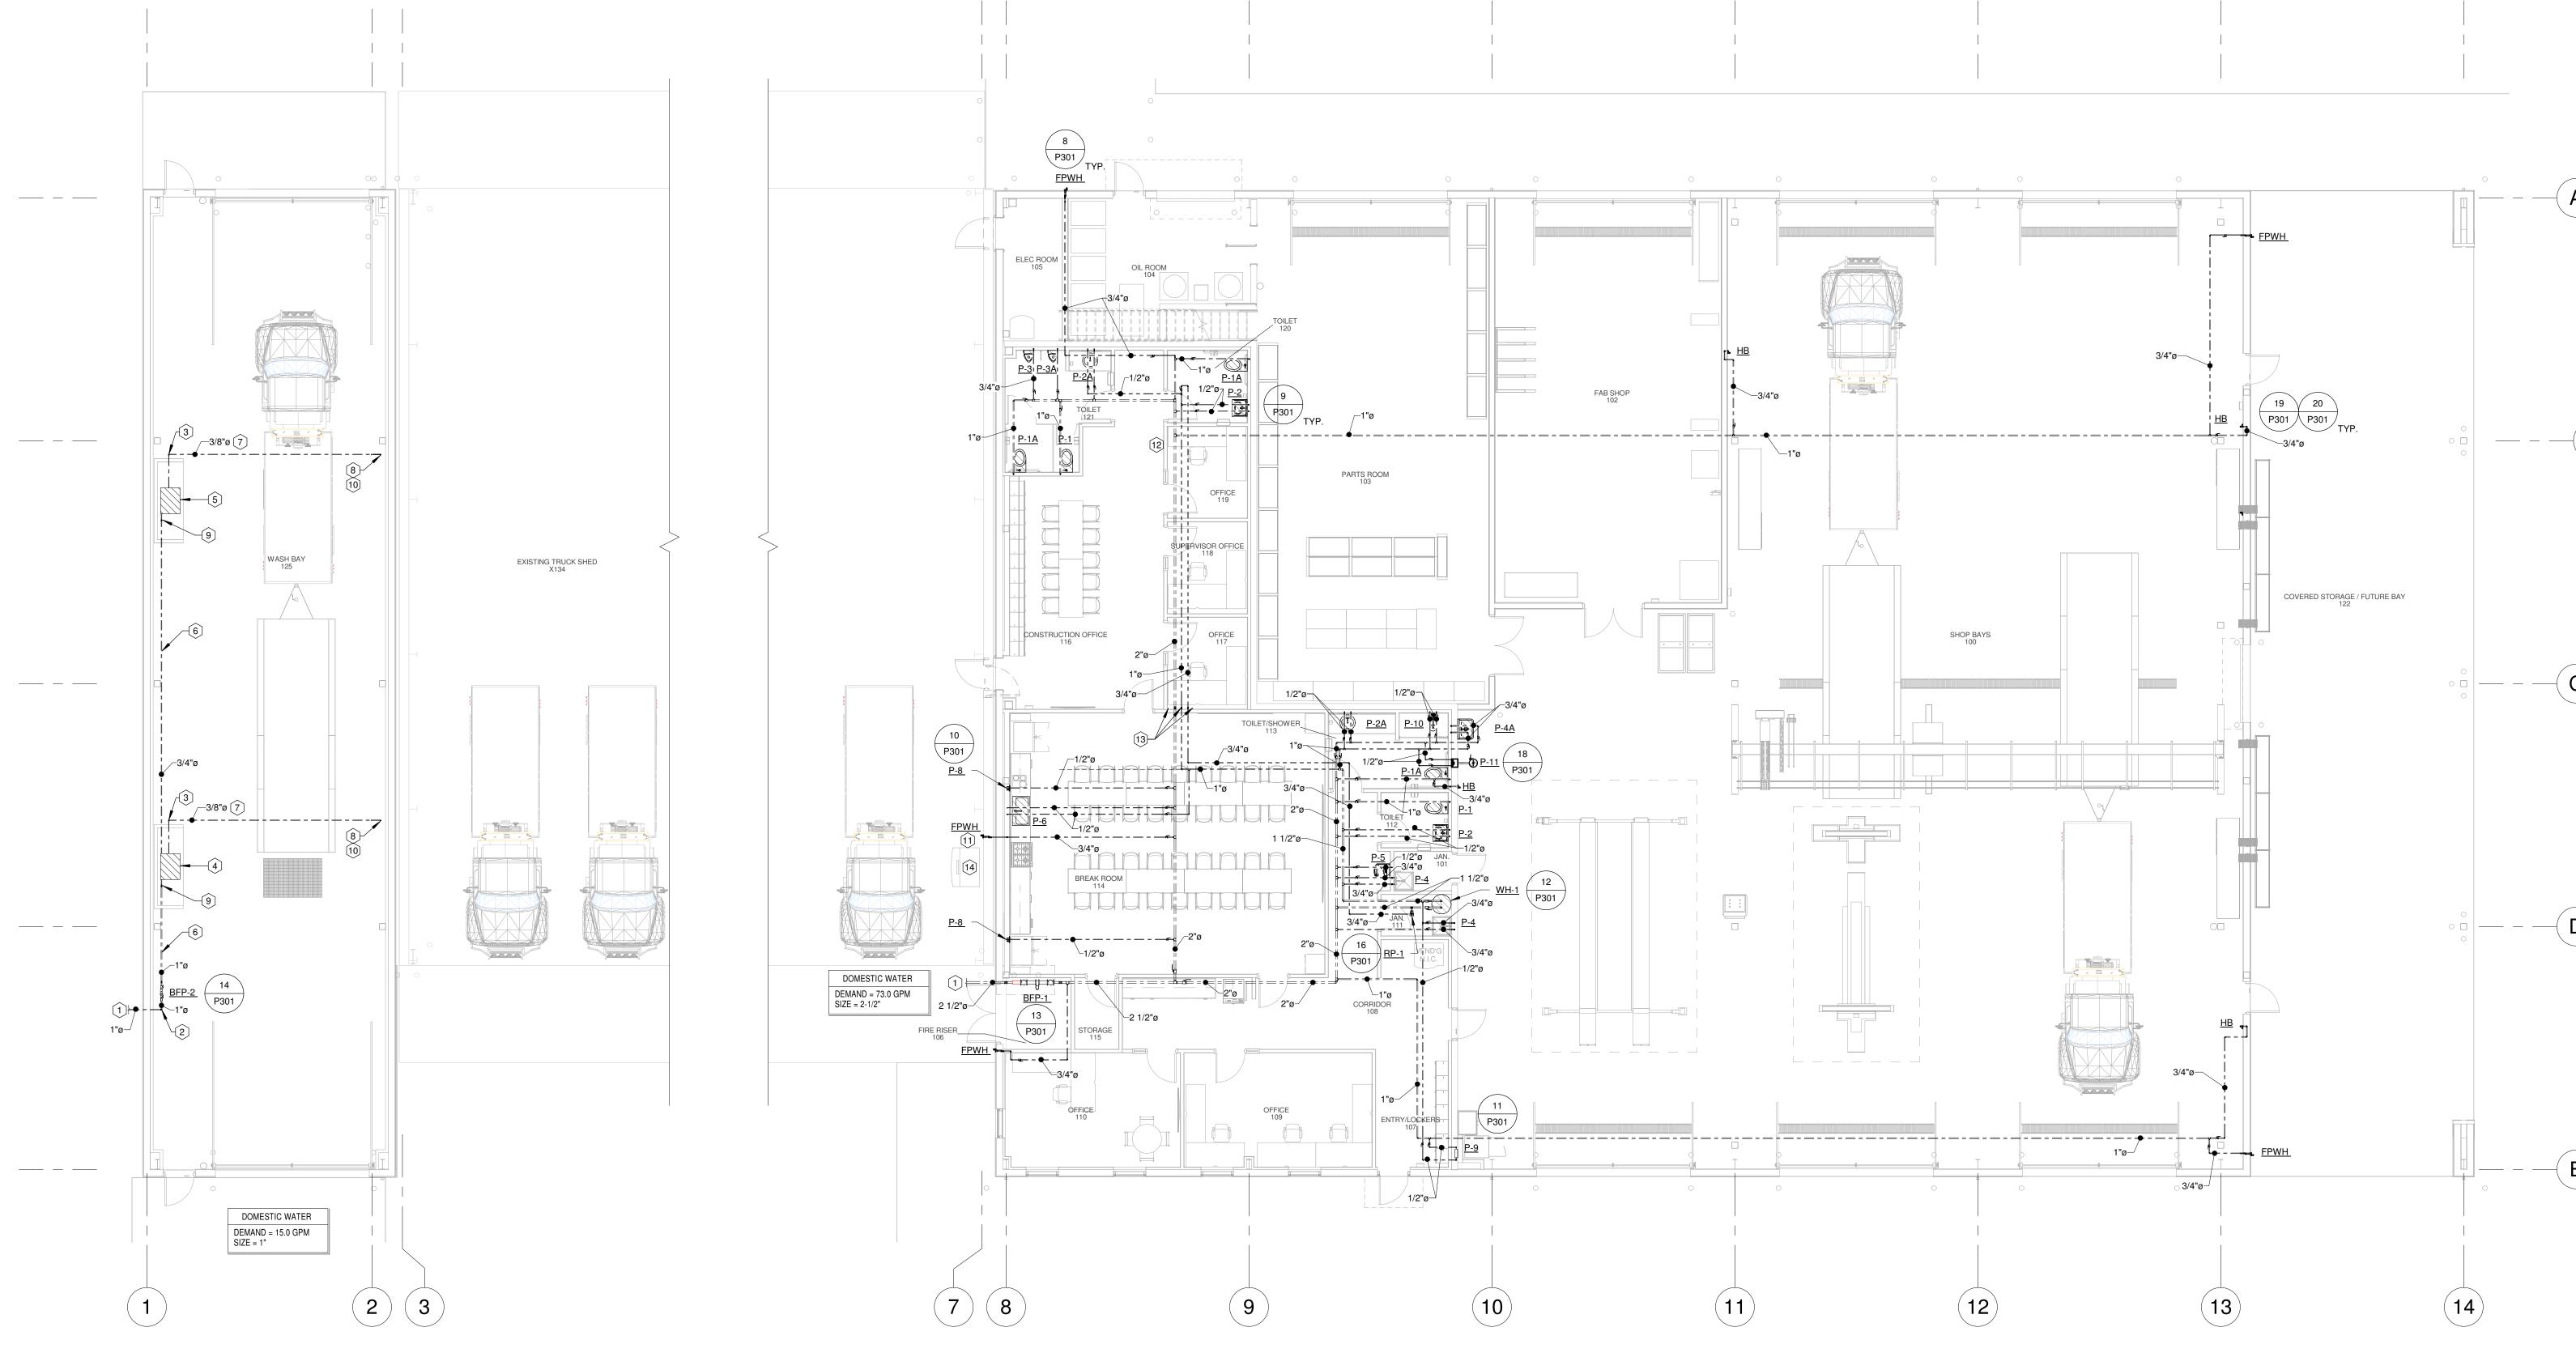


DOMESTIC WATER PLAN 1 | P201 | 1/8" = 1'-0"

KEYED NOTES:

- 1 SEE CIVIL FOR CONTINUATION.
- 2 WATER LINE RISES UP FROM BELOW SLAB. SLEEVE AND SEAL SLAB PENETRATION.
- 3 DISCHARGE PRESSURIZED WATER LINE FROM WASHER DROPS BELOW GRADE TO ROUTE BELOW SLAB TO SOUTH SIDE OF WASH BAY.
- 4 PSC MODEL ES429K424A PRESSURE WASHER.
- 5 OWNER FURNISHED, CONTRACTOR INSTALLED PRESSURE

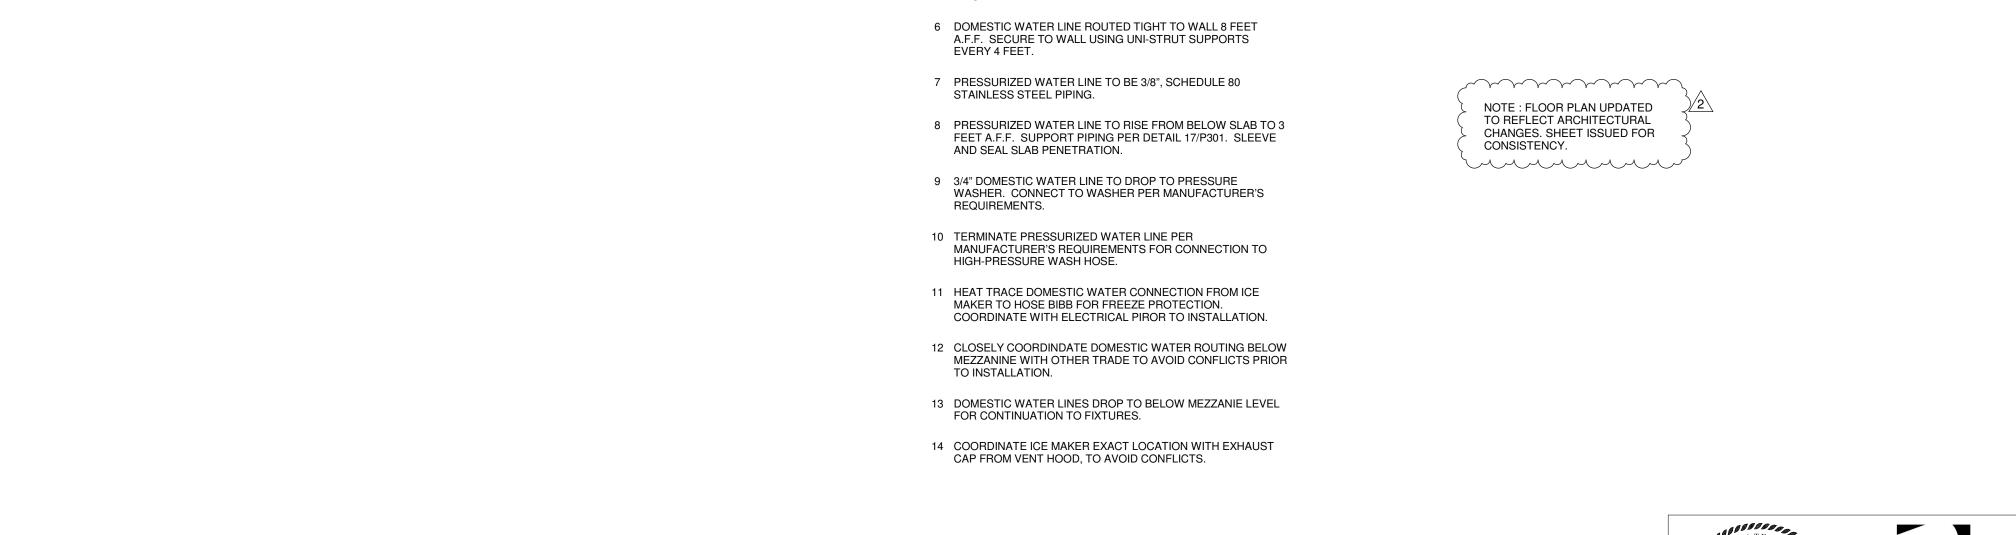

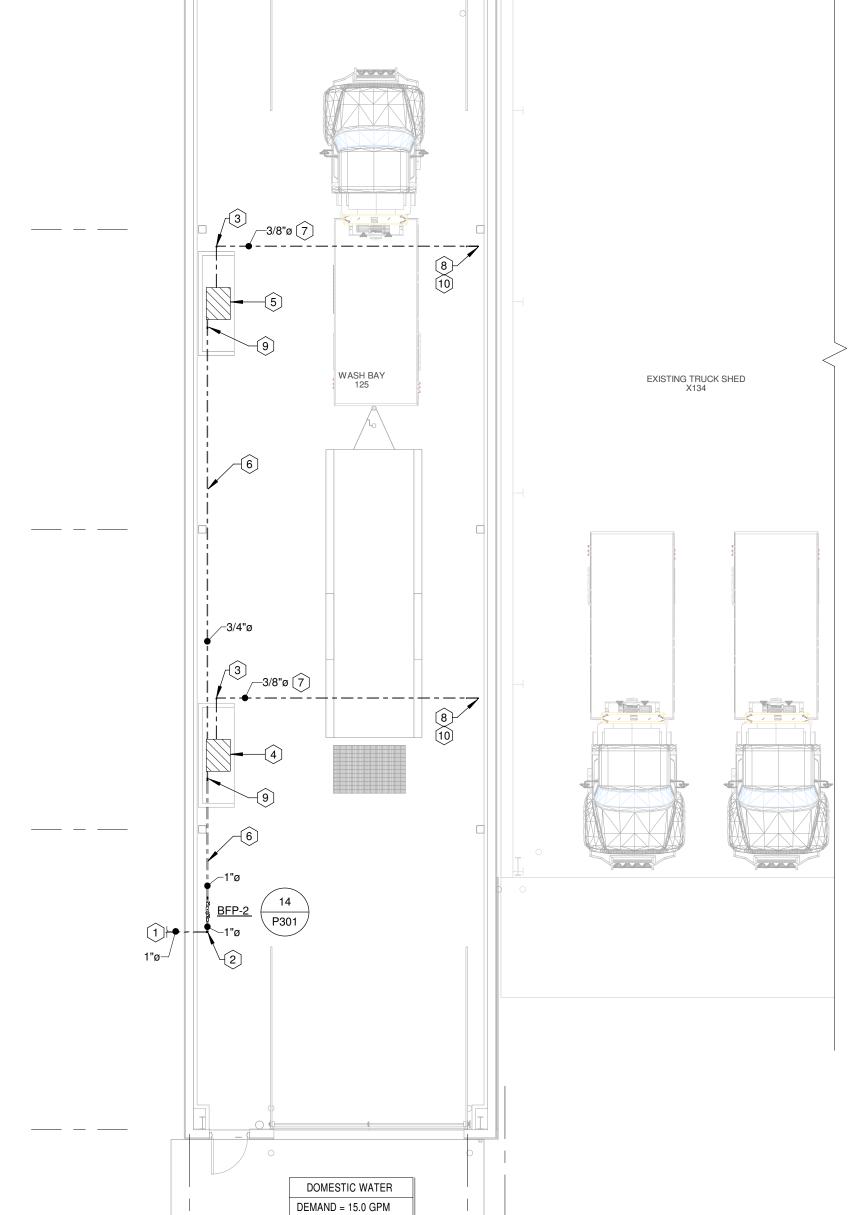



		CALLON		ELECTRIC	C DATA	MANUFACTURER	CONNE	CTIONS	
MARK	LOCATION	GALLON CAPACITY	SERVES	VOLTS/ PHASE	KW	& MODEL NO. OR EQUAL	CW	HW	REMARKS
WH-1	JAN 111	80	SHOP AND OFFICE AREA	208/3	8.0	A.O. SMITH DEN-80	1-1/2"	1-1/2"	DUAL ELEMENT, SIMULTANEOUS OPERATION. PROVIDE HOLDRITE WATER HEATER FLOOR STAND 40-S-24-A AND HOLDRITE WATER HEATER DRAIN PAN QP-24. PROVIDE WITH T&P VALVE AND WATTS EXPANSION TANK PER MANUFACTURERS SPECIFICATION AND HOLDRITE EXPANSION TANK MOUNTING BRACKET. HEATER TEMPERATURE SET POINT TO BE 120 °F. COORDINATE WITH ELECTRICAL FOR DISCONNECT LOCATION.
sp-1	JAN 111		WATER HEATER WH-1	120/1	25 WATTS	GRUNDFOS UP 15-10 BUC7-LC		3/4"	4 GPM WHEN OPERATING AT TOTAL DEVELOPED HEAD OF 3.2 FT OF WATER COLUMN. 3/4" SWEAT CONNECTION. 2 POLE, SINGLE PHASE. 1/25 HP. PROVIDE WITH PRE-TERMINATED LINE CORD.

MARK	DESCRIPTION	WASTE	VENT	C.W.	H.W.	MOUNTING	REMARKS
P-1	WATER CLOSET	4"	2"	1"		FLOOR	AMERICAN STANDARD MADERA 3451.001, VITREOUS CHINA, WHITE. SLOAN ROYAL 111-1.28 FLUSH VALVE. CHURCH 9500NSSC, ELONGATED, OPEN FRONT SEAT, BOLT CAPS.
P-1A	WATER CLOSET - ADA	4"	2"	1"		FLOOR	AMERICAN STANDARD MADERA 3043.001, VITREOUS CHINA, WHITE. SLOAN ROYAL 111-1.28 FLUSH VALVE. CHURCH 9500NSSC, ELONGATED, OPEN FRONT SEAT, BOLT CAPS. INSTALL PER ADA REQUIREMENTS.
P-2A	LAVATORY - ADA	2"	2"	1/2"	1/2"	COUNTERTOP	AMERICAN STANDARD AQUALYN 0476.028 VITREOUS CHIN, WHITE. AMERICAN STANDARD FAUCET MONTERREY, 4 " ON CENTER, CENTERSET GOOSENECK WITH LIMITED SWIVEL, WRIST BLADE HANDLES, 1.5 GPM. PROVIDE WITH THERMOSTATIC MIXING VALVE. PROVIDE MCGUIRE 1149 OFFSET GRIDSTRAINER, 8872 P-TRAP WITH ESCUTCHEON. MCGUIRE LF2165 SUPPLY KIT WITH ESCUTCHEONS. INSTALL PER ADA REQUIREMENTS.
P-2	LAVATORY - ADA	2"	2"	1/2"	1/2"	WALL	AMERICAN STANDARD LUCERNE 0355.012 VITREOUS CHIN, WHITE. AMERICAN STANDARD FAUCET MONTERREY, 4 " ON CENTER, CENTERSET GOOSENECK WITH LIMITED SWIVEL, WRIST BLADE HANDLES, 1.5 GPM. PROVIDE WITH THERMOSTATIC MIXING VALVE. PROVIDE MCGUIRE 1149 OFFSET GRIDSTRAINER, 8872 P-TRAP WITH ESCUTCHEON. MCGUIRE LF2165 SUPPLY KIT WITH ESCUTCHEONS. INSTALL PER ADA REQUIREMENTS. PROVIDE WITH WALL CARRIER.
P-3	URINAL	2"	2"	3/4"		WALL	AMERICAN STANDARD LYNBROOK 6601.012, VITREOUS CHINA, WHITE. SLOAN ROYAL 186-1.0 FLUSH VALVE. WADE 400-AM11 CARRIER.
P-3A	URINAL - ADA	2"	2"	3/4"		WALL	AMERICAN STANDARD LYNBROOK 6601.012, VITREOUS CHINA, WHITE. SLOAN ROYAL 186-1.0 FLUSH VALVE. WADE 400-AM11 CARRIER. INSTALL PER ADA REQUIREMENTS.
P-4	JANITOR SINK	3"	2"	3/4"	3/4"	FLOOR	STERN-WILLIAMS SB-901, WITH SATAINLESS STEEL CAP, TILTING FLANGE, CAST BRASS DRAIN BODY, STAINLESS STEEL STRAINER AND LINT BASKET, STAINLESS STEEL SPLASH PANELS, T-35 HOSE AND WALL HOOK, T-40 S.S. MOP HANGER WITH 3 WALL GRIPS. T&S FAUCET #B-0665-BSTP WITH BUILT-IN STOPS, VACUUM BREAKER, LEVER HANDLES, WALL BRACE, AND 3/4" GARDEN HOSE OUTLET.
P-4A	JANITOR SINK	3"	2"	3/4"	3/4"	FLOOR	ELKAY RNSF8118 #16 GAUGE, TYPE 304, STAINLESS STEEL SCULLERY SINK. PROVIDE WITH FAUCET MODEL LK940AT08L2H AND DRAIN MODEL LK18B. PROVIDE WITH TWO MCGUIRE SUPPLY STOPS.
P-5	ELECTRIC WATER COOLER	1-1/2"	1-1/2"	1/2"		WALL	OASIS PGF8SBF, BARRIER-FREE VERSACOOLER II WITH VERSAFILTER AND VERSAFILTER. 8.0 GPH OF 50°F WATER AT 90°F AMBIENT AND 80°F INLET WATER. 1/4 HP, 115V, 60HZ, 4.4AMPS. PROVIDE WITH BOTTLE FILLER VERSAFILLER KIT. PROVIDE WITH CARRIER. PROVIDE MCGUIRE #BV-2165 STOP AND #8872 TRAP.
P-6	SINGLE COMPARTMENT SINK	2"	2"	1/2"	1/2"	COUNTERTOP	ELKAY LR-2219 OVERALL 22"L X 19-1/2"W (16" X 16" X 7-1/2" BOWL), 18 GAUGE STAINLESS STEEL, CENTER OUTLET, WITH CHROME P-TRAP. DELTA 27C4834 FAUCET WITH WRIST BLADE HANDLES. PROVIDE MCGUIRE 8904 P-TRAP WITH ESCUTCHEON AND MCGUIRE 177 SUPPLY KIT WITH ESCUTCHEONS. PROVIDE WITH REMOVABLE STRAINER BASKET.
P-7	DISPOSAL	2"				BELOW SINK	IN-SINK-ERATOR, BADGER 500, CONTINUOUS FEED. 1/2 HP, 120V/1 , STAINLESS STEEL GRINDING ELEMENTS WITH TWO STAINLESS STEEL 360° SWIVEL LUGS, WITH DISHWASHER INLET.
P-8	WATER BOX			1/2"		WALL	WATER TITE #AB1200, 1/2" VALVE CONNECTION, 1/4" TURN BALL INSTALLED, CONTOUR DESIGN FOR EASY VALVE ACCESS. THIS BOX SERVICES ONLY ONE ICE MACHINE.
P-9	WASHER BOX	2"	2"	1/2"	1/2"	WALL	WATER TITE #W4700, 2" DRAIN LINE, 1/2" VALVE CONNECTION, 1/4" TURN BALL INSTALLED, CONTOUR DESIGN FOR EASY VALVE ACCESS. PROVIDE WITH FACTORY HAMMER ARRESTERS.
P-10	SHOWER - ADA	2"	2"	1/2"	1/2"	WALL/FLOOR	HAMILTON G 6233 IBSF-WHT ACRYIX ALCOVE ONE-PIECE ROLL-IN SHOWER, WITHFOLD UP SEAT, 2 HORIZONTAL AND ONE VERTICAL GRAB BARS, VALVE PACKAGE INCLUDES HAND HELD SHOWER SET, 60" FLEX HOSE, VACUUM BREAKER, 30" SLIDE BAR, WALL OUTLET FITTINGS, CURTAIN AND HOOKS, CENTER DRAIN. ZURN FD2251-CI SHOWER DRAIN. INSTALL FOR COMPLIANCE WITH ADA.
P-11	EYE WASH STATION	1-1/2"	1-1/2"		ID WATER (ING VALVE	WALL	GUARDIAN GBF1724 BARRIER-FREE WIDEAREA EYE /FACE WASH, WALL MOUNTED. PROVIDE WITH GUARDIAN G6021-1R6 THERMOSTATIC MIXING VALVE WITH STEEL CABINET. INSTALL PER MANUFACTURER REQUIREMENTS.
FPWH	FREEZE PROOF WALL HYDRAT			3/4"		WALL	WOODFORD B67, AUTOMATIC DRAINING, FREEZELESS WALL HYDRANT WITH HOSE CONNECTION BACKFLOW PROTECTION. PROVIDE WITH STANDARD CHROME FINISH WITH KEY OPERATED BOX.
НВ	HOSE BIBB			3/4"		WALL	WOODFORD B24, ANTI-SIPHON WALL FAUCET, PROVIDE WITH STANDARD CHROME FINISH WITH KEY OPERATED BOX. FOR INSTALLATION IN MODERATE CLIMATE.
FD-1	FLOOR DRAIN	2"				FLOOR	ZURN Z415B ROUND FLOOR DRAIN, DURA-COATED CAST IRON BODY WITH BOTTOM OUTLET AND POLISHED NICKLE BRONZE STRAINER. PROVIDE INLINE TRAP PROTECTION, REFER TO DETAIL 1/P301. INSTALL DRAIN SO THAT TOP OF RIM IS FLUSH WITH FLOOR.
FD-2	FLOOR DRAIN	3"				FLOOR	ZURN Z415E ROUND FLOOR DRAIN WITH FUNNEL, DURA-COATED CAST IRON BODY WITH BOTTOM OUTLET AND POLISHED NICKLE BRONZE STRAINER. PROVIDE INLINE TRAP PROTECTION, REFER TO DETAIL 1/P301. INSTALL DRAIN SO THAT TOP OF RIM IS FLUSH WITH FLOOR.
FS-1	FLOOR SINK	4"				FLOOR	ZURN Z1849-3 FLOOR SINK, 12"x12"x4" 14 GAUGE, TYPE 304 STAINLESS STEEL WITH BOTTOM OUTLET WITH LIGHT DUTY PERFORATED GRATE AND SEDIMENT BASKET. PROVIDE WITH 3/4 GRATE. PROVIDE INLINE TRAP PROTECTION, REFER TO DETAIL 1/P301. INSTALL DRAIN SO THAT TOP OF RIM IS FLUSH WITH FLOOR.
TD-1	TRENCH DRAIN	4"				FLOOR	ZURN Z886-HD TRENCH DRAIN. EACH TRENCH DRAIN TO START WITH SECTION 8604 AT SHALLOW END WITH BOTTOM OUTLET DRAIN DRAIN AT THE MID POINT. PROVIDE INLINE TRAP PROTECTION, REFER TO DETAIL 1/P301. INSTALL DRAIN SO THAT TOP OF RIM IS FLUSH WITH FLOOR.
BFP-1	BACKFLOW PREVENTER			2 1/2"		SEE PLANS	WATTS LF909 2 1/2" BACKFLOW PREVENTER, PROVIDE WITH AIR GAP AND STRAINER. ROUTE DRAIN LINE TO FLOOR SINK.
BFP-2	BACKFLOW PREVENTER			1"		SEE PLANS	WATTS LF909 1" BACKFLOW PREVENTER, PROVIDE WITH AIR GAP AND STRAINER. ROUTE DRAIN LINE TO DRAIN PIT.
FCO	FLOOR CLEANOUT	SEE PLANS				FLOOR	ZURN OR EQUAL.
COTG	CLEANOUT TO GRADE	SEE PLANS				GRADE	ZURN OR EQUAL.
DCOTG	DOUBLE CLEANOUT TO GRADE	SEE PLANS				GRADE	ZURN OR EQUAL.

EQUIPMENT NOTES:

- 1. REFER TO THE SPECIFICATIONS FOR ADDITIONAL EQUIPMENT REQUIREMENTS.
- 2. MANUFACTURER'S INDICATED ARE TO ESTABLISH MINIMUM CAPACITIES, EFFICIENCIES, QUALITY, ACCESSORIES AND STANDARDS. UNLESS OTHERWISE INDICATED ON THE SCHEDULES OR IN THE SPECIFICATIONS, EQUAL EQUIPMENT BY OTHER MANUFACTURERS MAY BE USED.
- 3. ANY CHANGES TO THE ELECTRICAL, STRUCTURAL, ARCHITECTURAL, OR OTHER MECHANICAL SYSTEMS WHICH RESULT FROM SUBSTITUTED EQUIPMENT SHALL BE COORDINATED FULLY PRIOR TO BID. ALL COSTS RESULTING FROM CHANGES REQUIRED BY THE SUBSTITUTION SHALL BE INCLUDED IN THE BIDS.

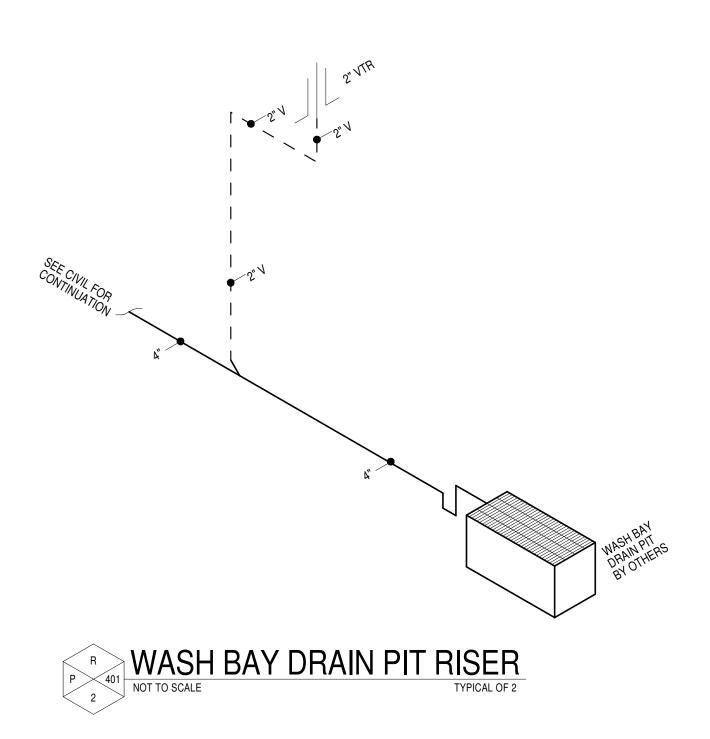

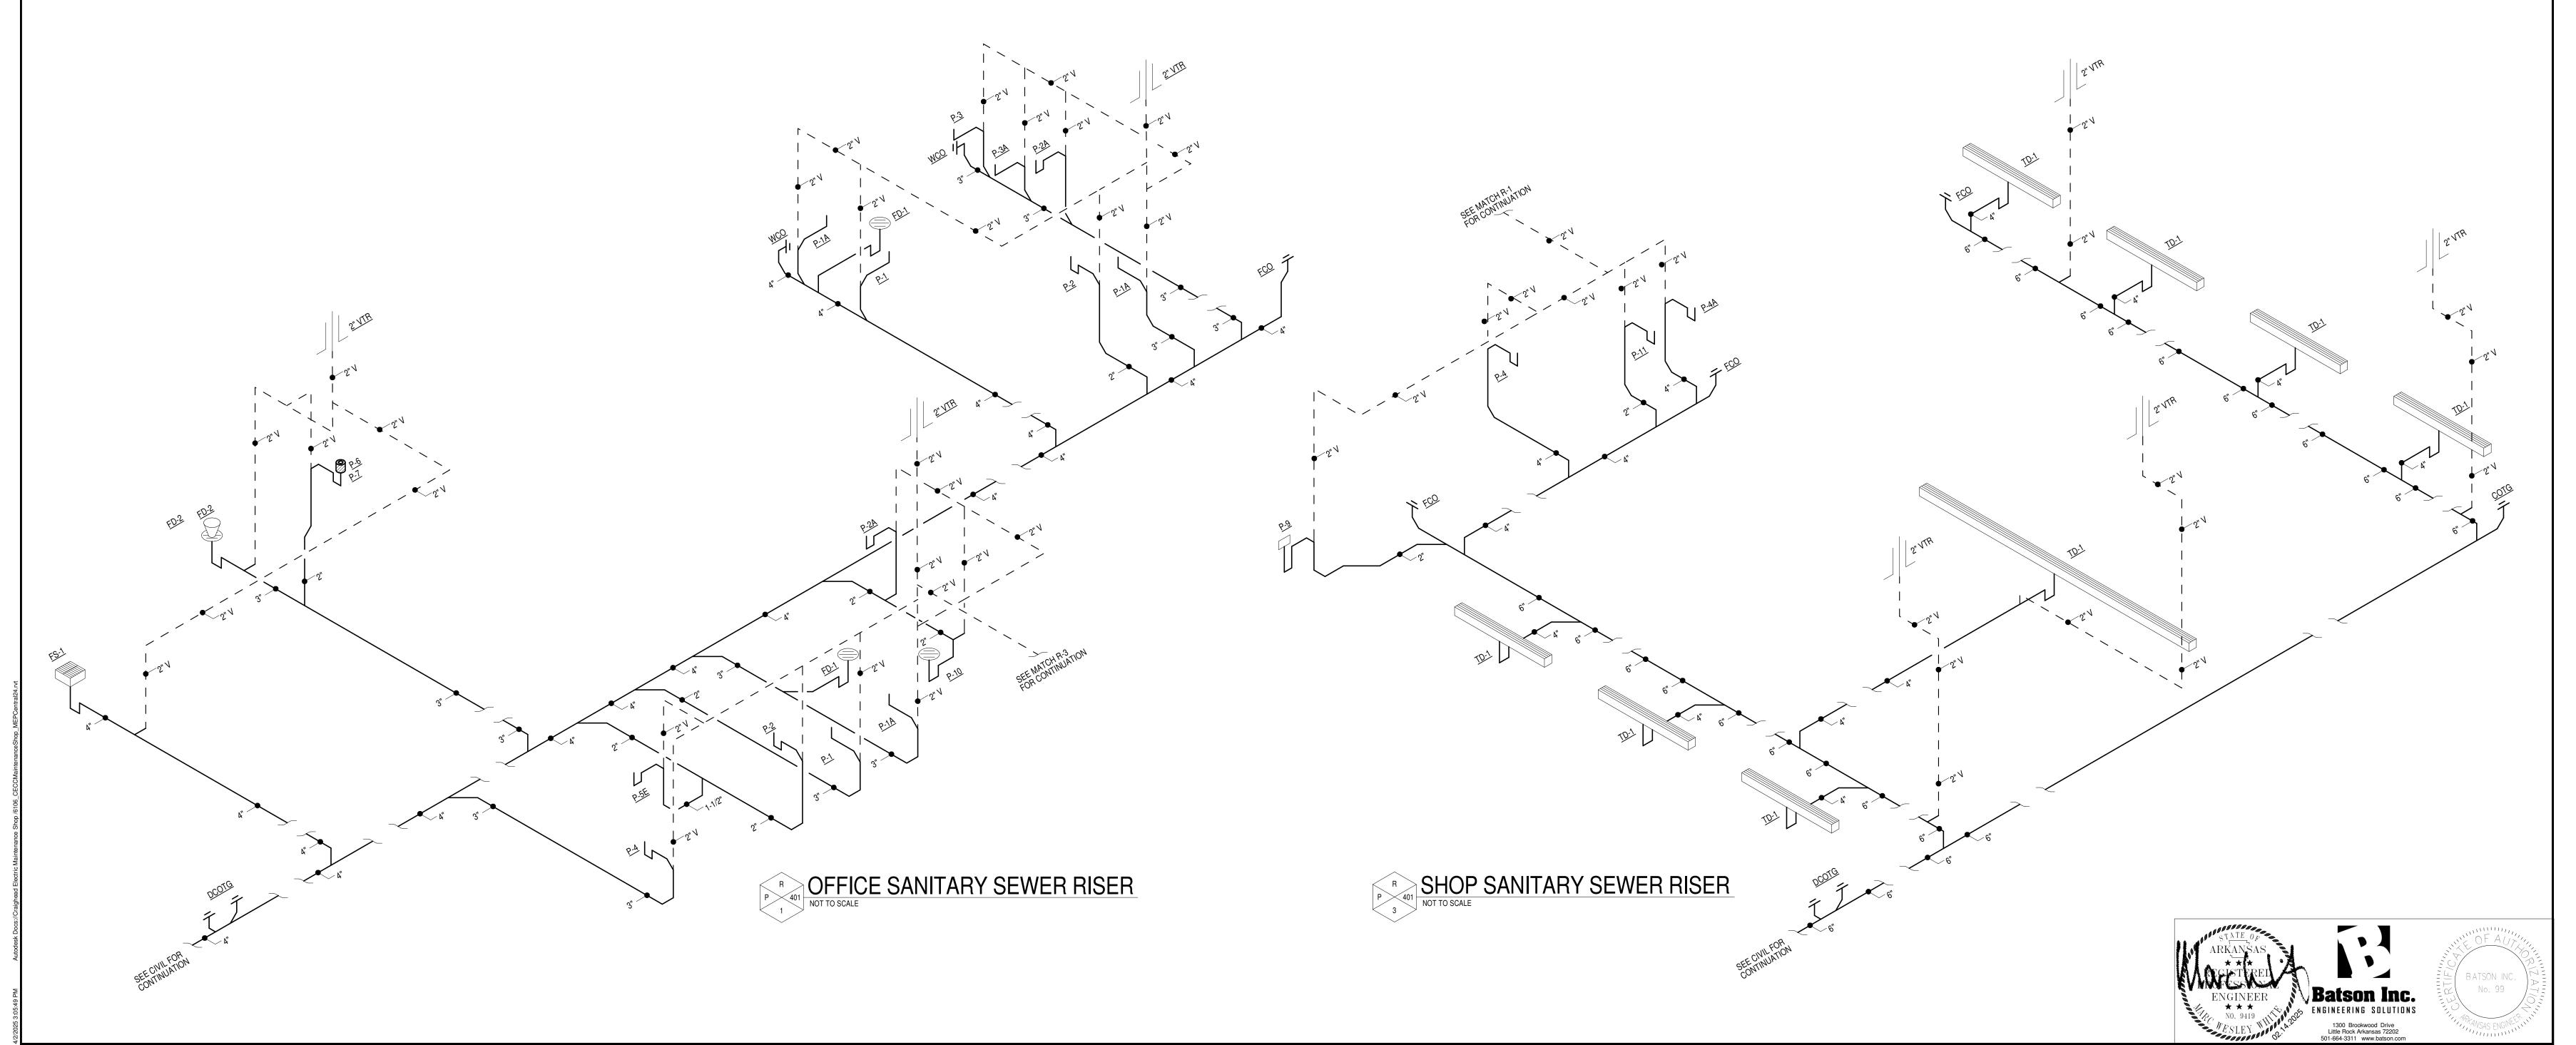

ISSUE SET

P401

ELECTRICAL GENERAL NOTES

- 1. PRIOR TO BID, CONTRACTOR SHALL BECOME THOROUGHLY FAMILIAR WITH THE REQUIREMENTS OF THESE NOTES AS WELL AS OTHER NOTES SHOWN ON THE CONTRACT DOCUMENTS.
- 2. REFER TO SPECIFICATIONS. SPECIFICATIONS AND DRAWINGS ARE COMPLIMENTARY EXCEPT THAT, IN CASE OF CONFLICT, SPECIFICATIONS WILL GOVERN.
- BY NECESSITY, THESE DRAWINGS REFLECT A SYSTEM DESIGNED AROUND SPECIFIC REFERENCE PRODUCTS (SEE SCHEDULES), THE SELECTION OF WHICH HAS IMPACTED THE DESIGNS OF OTHER TRADES (MECHANICAL, STRUCTURAL, ETC.). IF SUBSTITUTE MANUFACTURERS, SIZES, OR MODEL NUMBERS ARE SUBMITTED OR BID, IT IS THE RESPONSIBILITY OF THE ELECTRICAL CONTRACTOR AND HIS SUBCONTRACTORS TO COORDINATE ALL DIFFERENCES PRIOR TO BID. NO EXTRAS WILL BE ALLOWED FOR CHANGES REQUIRED TO OTHER TRADES IF SUBSTITUTE EQUIPMENT IS BID OR INSTALLED AT THE CONTRACTORS OPTION.
- 4. COORDINATION OF ALL MODIFICATIONS TO EACH DISCIPLINE WHICH RESULT FROM SUBSTITUTION OF EQUIPMENT OR MATERIALS SHALL BE THE RESPONSIBILITY OF THE CONTRACTOR. ALL PROPOSED SUBSTITUTIONS SHALL BE SUBMITTED FOR REVIEW. SUBSTITUTIONS WHICH ARE INSTALLED AND SUBSEQUENTLY ARE PROVEN UNSATISFACTORY BY OWNER AND/OR ENGINEER, WITHIN THE WARRANTY PERIOD, SHALL BE REMOVED COMPLETELY BY THE CONTRACTOR AND REPLACED WITH THE ORIGINAL DESIGN OR CORRECTED AS DIRECTED BY THE ENGINEER WITHOUT ADDITIONAL COST TO THE OWNER.
- CONTRACTOR SHALL GIVE ALL NECESSARY NOTICES; OBTAIN ALL PERMITS, AND PAY ALL GOVERNMENTAL TAXES, FEES AND OTHER COSTS IN CONNECTION WITH WORK; FILE ALL NECESSARY PLANS; PREPARE ALL DOCUMENTS AND OBTAIN ALL NECESSARY APPROVALS OF ALL GOVERNMENTAL DEPARTMENTS HAVING JURISDICTION AND OBTAIN REQUIRED CERTIFICATES OF
- 6. CONTRACTOR SHALL INCLUDE IN THE WORK ALL LABOR, MATERIALS, SERVICES, APPARATUS, DRAWINGS, ETC. IN ORDER TO COMPLY WITH ALL LAWS, ORDINANCES, CODES, RULES, AND REGULATIONS OF LOCAL, STATE AND FEDERAL GOVERNMENTS, WHETHER OR NOT SHOWN ON THE DRAWINGS.
- UNLESS OTHERWISE NOTED, CONTRACTOR SHALL PROVIDE COMPLETE TIE-IN WITH UTILITY LINES AT NO EXTRA COST TO THE OWNER. THE CONTRACTOR SHALL PAY ALL COSTS REQUIRED BY UTILITY COMPANY PERTAINING TO CONSTRUCTION AND TIE-IN. DEPOSITS REQUIRED FOR PERMANENT SERVICE SHALL BE PAID BY THE OWNER.
- 8. ALL DRAWINGS ARE DIAGRAMMATIC AND INDICATE THE GENERAL ARRANGEMENTS OR GEOMETRICAL RELATIONSHIPS OF EQUIPMENT AND SERVICES. THEY ARE NOT INTENDED TO SPECIFY OR SHOW EVERY COMPONENT, DEVICE OR OPTION. THE EQUIPMENT LOCATIONS SHOWN ON THE DRAWINGS ARE APPROXIMATE. THE FINAL LOCATIONS SHALL BE ESTABLISHED IN THE FIELD TO FIT THE AVAILABLE SPACE.
- 9. CONTRACTOR SHALL BE RESPONSIBLE FOR COORDINATING ALL ELECTRICAL WORK WITH THAT OF OTHER TRADES. EXACT LOCATIONS OF ALL EQUIPMENT SHALL BE COORDINATED WITH OTHER TRADES. SEE ARCHITECTURAL AND STRUCTURAL DRAWINGS FOR BUILDING DETAILS AND
- 10. INFORMATION AND COMPONENTS SHOWN ON RISER DIAGRAMS OR DETAILS, BUT NOT SHOWN ON PLANS, AND VICE VERSA, SHALL BE PROVIDED AS IF EXPRESSLY REQUIRED BY BOTH.
- 11. CONTRACTOR SHALL NOT SCALE DRAWINGS. DRAWINGS SPECIFIC TO THIS DISCIPLINE DO NOT LIMIT THE RESPONSIBILITY OF WORK REQUIRED BY THE CONTRACT DOCUMENTS.
- 12. UNLESS NOTED OTHERWISE, THE INDICATION AND/OR DESCRIPTION OF ANY ITEM IN THE DRAWINGS OR SPECIFICATIONS CARRIES WITH IT THE INSTRUCTION TO FURNISH AND INSTALL
- 13. ROUGH-IN OR INSTALLATION OF OWNER FURNISHED EQUIPMENT SHALL NOT BEGIN UNTIL APPROVED EQUIPMENT DRAWINGS ARE OBTAINED FROM OWNER OR ARCHITECT. SEE ARCHITECTURAL SPECIFICATIONS OR DRAWINGS FOR LIST OF OWNER FURNISHED EQUIPMENT
- 14. CONTRACTOR SHALL VERIFY ALL EQUIPMENT LOCATIONS, POWER REQUIREMENTS, ROUTING, CONDUCTOR SIZE, AND CONDUCTOR COUNT PRIOR TO ROUGH-IN.
- COORDINATE FINAL HEIGHTS AND LOCATIONS OF ALL DEVICES WITH MILLWORK, FURNITURE OR OTHER EQUIPMENT.
- 16. ALL DEVICES LOCATED IN SAME GENERAL LOCATION ON THE SAME WALL SHALL BE GROUPED AND ALIGNED HORIZONTALLY OR VERTICALLY, AS NECESSARY.
- 17. GROUPED SWITCHES SHALL BE GANG MOUNTED.

INSPECTION.

- 8. COLOR AND TYPE OF DEVICE COVER PLATES TO BE SELECTED BY ARCHITECT.
- 19. COORDINATE FRAMES AND ACCESSORIES FOR FIXTURE MOUNTING WITH ARCHITECTURAL FINISH SCHEDULE
- 20. REPLACE ALL ARCHITECTURAL FEATURES REMOVED OR DAMAGED DURING THE COURSE OF THE
- 21. SEAL ALL ROOF AND WALL PENETRATIONS. ROOFING CONTRACTOR SHALL BE RESPONSIBLE FOR FLASHING AND SEALING OF ALL ROOF PENETRATIONS. COORDINATE WITH GENERAL CONTRACTOR PRIOR TO BID FOR ALL REQUIRED FLASHINGS AT ROOF PENETRATIONS. MINIMUM
- HEIGHT OF FLASHING IS 8 IN. ABOVE ROOF.

 22. SPECIAL CARE SHALL BE TAKEN ON THE ROOF TO PREVENT DAMAGE. ANY DAMAGE SHALL BE PROMPTLY REPAIRED AT NO EXPENSE TO THE OWNER.
- 23. SEAL ALL ELECTRICAL PENETRATIONS THROUGH RATED ASSEMBLIES, FIRE WALLS AND SMOKE WALLS. FIREPROOFING SEALANT SHALL BE UL APPROVED AND SHALL BE INSTALLED IN A MANNER THAT MAINTAINS THE RATING OF THE ASSEMBLY BEING PENETRATED.

					RE	Q'D LAMPS		
	\IB\\	MANUFACTURER M	MODEL-NO.	VOLTAGE	WHM.	TYPE	MOHNTING	DESCRIPTION
}	А	LA LIGHTING	HBN200-48-4-FRA-DRDM-UNV-3-840-YTCS10	120V	-	LED	PENDANT	PENDANT MOUNTED LED HIGH BAY FIXTURE
$\left\{ \left[\right] \right\}$	В	NORA LIGHTING	NPDBLSW-E22/334-W	120V	-	LED	RECESSED	2X2 RECESSED LED FLAT PANEL; SET TO 30W LUMENS; VERIFY CCT SETTING W/ARCHITECT
$\left\{ \left[\right] \right.$	BE		DELETED FROM PROJECT					
	B1	NORA LIGHTING	NPDBLSW-E22/334-W-NPDBL-22RFK/W	120V	-	LED	RECESSED	2X2 RECESSED LED FLAT PANEL W/ DRYWALL RECESSED KIT; SET TO 30W LUMENS; VERIFY CCT SETTING W/ ARCHITECT
}	B2		DELETED FROM PROJECT					
4	ren !	LA LIGHTING	CIT100-4-AL-DRFA-WL-SSL-DRDM-UNV-1-840	1200	nin	MILED MA	SURFACE/WALL	4FT VAPÓR-TÍGHT STRÍP FÍXTURE 4000 LÚMEN
	CE	LA LIGHTING	CIT100-4-4L-DRFA-WL-SSL-BPLSL1.5-DRDM-UNV-1-840	120V	-	LED	SURFACE/WALL	4FT VAPOR-TIGHT STRIP FIXTURE W/ EMERGENCY BATTERY BACKUP
	C1	LA LIGHTING	CIT100-6-4L-DRFA-WL-SSL-DRDM-UNV-1-840	120V	-	LED	SURFACE/WALL	4FT VAPOR-TIGHT STRIP FIXTURE; 6000 LUMEN
	D	KURTZON LIGHTING	WL-SEG-1540-3HI-840-FP-UNV-DIM1-MOUNTING	120V	-	LED	PENDANT	PENDANT MOUNTED LED WET LOCATION VAPOR-TIGHT FIXTURE
	F	ALPHABET LIGHTING	NU2RD-SW-10LM-40K-80-55D-DL-FINISH-RET-UNV-DIM10	120V	-	LED	RECESSED	2" ROUND RECESSED LED ACCENT LIGHT
	G	LA LIGHTING	STW100-6-4L-FRWA-DRDM-UNV-1-840-VHOOK	120V	-	LED	PENDANT	4FT LENSED LED STRIP FIXTURE
	GE	LA LIGHTING	STW100-6-4L-FRWA-BPLSL1.5-DRDM-UNV-1-840-VHOOK	120V	-	LED	PENDANT	4FT LENSED LED STRIP FIXTURE W/ EMERGENCY BATTERY BACKUP
	G1	LA LIGHTING	STW100-4.5-3L-FRWA-DRDM-UNV-1-840-VHOOK	120V	-	LED	PENDANT	3FT LENSED LED STRIP FIXTURE
	Н	ALPHABET LIGHTING	NU4RD-SW-20LM-40-80-65D-SBL-FINISH-FINISH-RET-UNV-DIM10	120V	-	LED	RECESSED	4" ROUND RECESSED LED CAN LIGHT
	Y-HEY-Y	~ALPHABETLEIGHTING~	~~~~~~~~~~~~~~~~~~~~~~~~~~~~~~~~~~~~~~	120V	-	LED	RECESSED	4" ROUND RECESSED LED CAN LIGHT W/ EMERGENCY BATTERY BACKUP W/ INTEGRAL TEST SWITCH
-	J	AMERICAN LINEAR LIGHTING	2W-4-VLD-40-UNV-FINISH	120V	-	LED	WALL	4FT DIRECT WALL-MOUNTED LED LIGHT
	J1	AMERICAN LINEAR LIGHTING	2W-5-VLD-40-UNV-FINISH] 120V	-	LED	WALL	5FT DIRECT WALL-MOUNTED LED LIGHT
	J2	AMERICAN LINEAR LIGHTING	2W-6-VLD-40-UNV-FINISH) 120V	-	LED	WALL	6FT DIRECT WALL-MOUNTED LED LIGHT
	J3	AMERICAN LINEAR LIGHTING	2W-7-VLD-40-UNV-FINISH	120V	-	LED	WALL	7FT DIRECT WALL-MOUNTED LED LIGHT
\\-_	w	M OLF FILICHTING MAN	Q-tink-sst-dry-40-dk-finish-12	120V	-	LED	UNDERCABINET	12" LINE VOLTAGE LED UNDERCABINET FIXTURE
	V1	QTL LIGHTING	Q-LINK-SST-DRY-40-DF-FINISH-24	120V	-	LED	UNDERCABINET	24" LINE VOLTAGE LED UNDERCABINET FIXTURE
	W	EVENLITE	TEBL6-FINISH-SD	120V	-	LED	WALL	LED HIGH OUTPUT EMERGENCY EGRESS LIGHTING UNIT
-	~#¥ 1 ~~		TEBL6-FINISH-SQ-VRWP	1204	\\-\-\-\-\-\-\-\-\-\-\-\-\-\-\-\-\-\-\	~~~tĘD~~~	WALLY WALLY	LED HIGH OUTPUT EMERGENCY EGRESS LIGHTING UNIT W/ WET LOCATION COVER
	Х	EVENLITE	TCXCOM-COLOR-U-FINISH-SD	120V	-	LED	SURFACE UNIVERSAL	THERMOPLASTIC COMBINATION EXIT/EMERGENCY LIGHT - SINGLE FACE - CHEVRONS AS SHOWN ON PLANS
Ţ	XWY		TW!COMCO!OR-1-FINISH	1204	m	M LÉDMM	UNIVERSAL UNIVER	WET LOCATION RATED COMBINATION EXIT/EMERGENCY LIGHT - SINGLE FACE - CHEVRONS AS SHOWN ON PLANS
	XS	EVENLITE	TDCOM-COLOR-U-FINISH	120V	-	LED	UNIVERSAL	COMBINATION EXIT/EMERGENCY LIGHT - SINGLE FACE - CHEVRONS AS SHOWN ON PLANS
_	\Z\			\\\\\\\\\\\\\\\\\\\\\\\\\\\\\\\\\\\\\\	~~~~		~~~~~~~~~~~~~~~~~~~~~~~~~~~~~~~~~~~~~~	EXTERIOR EGRESS EMERGENCY LIGHT
	AA	TECHBRITE	MWP07-135-27V-DDK-FINISH	120V	-	LED	WALL	LUMEN SELECTABLE EXTERIOR WALL-MOUNTED AREA LIGHT; SET TO 81W (60%)
-	ВВ	TECHBRITE	MWP07-70-27V-DDK-FINISH	120V	-	LED	WALL	EXTERIOR WALL-MOUNTED AREA LIGHT - SMALL HOUSING; SET TO 28W (40%)
- [BBE	TECHBRITE	MWP07-70-27V-DDK-FINISH-B	120V	-	LED	WALL	EXTERIOR WALL-MOUNTED AREA LIGHT - SMALL HOUSING W/ EMERGENCY BATTERY BACKUP; SET TO 28W (40%)
\downarrow				m	m	mmm	mmmm	

LIGHTING FIXTURE SCHEDULE

SYMBOL	DESCRIPTION	SYMBOL	DESCRIPTION	SYMBOL	DESCRIPTION
0	2X4 LAY-IN OR SURFACE-MOUNTED FIXTURE	 	QUADRAPLEX RECEPTACLE	FA	FIRE ALARM HORN / STROBE DEVICE
0	2X4 LAY-IN OR SURFACE-MOUNTED FIXTURE; SHADING INDICATES EMERGENCY FIXTURE	ф	SPECIALTY RECEPTACLE	S	FIRE ALARM SPEAKER / STROBE DEVICE
\bigcirc	2X2 LAY-IN OR SURFACE-MOUNTED FIXTURE	0	FLOOR RECEPTACLE	€<	FIRE ALARM STROBE DEVICE
\bigcirc	2X2 LAY-IN OR SURFACE-MOUNTED FIXTURE; SHADING INDICATES EMERGENCY FIXTURE	⊙▼	FLOOR BOX	(Ē)	CEILING-MOUNTED FIRE ALARM STROBE DEVICE
	SURFACE, STRIP OR PENDANT-MOUNTED FIXTURE	110	HOMERUN: HOT, NEUTRAL, GROUND	€ _H	CEILING-MOUNTED FIRE ALARM HORN / STROBE DEVICE
	WALL-MOUNTED SURFACE OR STRIP FIXTURE	다	DISCONNECT SWITCH	© _s	CEILING-MOUNTED FIRE ALARM SPEAKER / STROBE DEVIC
\$	SURFACE-MOUNTED OR RECESSED CAN LIGHT FIXTURE	۵ı	FUSED DISCONNECT SWITCH	Z _{C,M,I}	ZAM FIRE ALARM DEVICE: CONTROL, MONITOR, IAM
Q	WALL-MOUNTED SURFACE FIXTURE	⊠ _l	COMBINATION STARTER / FUSED SWITCH	ML	MAGNETIC LOCK
 	CEILING-MOUNTED EXIT LIGHT; SHADING INDICATES FACES CHEVRONS AS SHOWN ON PLANS	×	MOTOR STARTER	TS FS	FIRE ALARM TAMPER / FLOW SWITCHES
<u>\overline{\Omega}</u>	WALL-MOUNTED EXIT LIGHT; SHADING INDICATES FACES CHEVRONS AS SHOWN ON PLANS	J	JUNCTION BOX (FLUSH MOUNTED)		SECURITY CAMERA
S	SINGLE-POLE SWITCH	•	PUSH-BUTTON	CR	CARD READER (BOX ONLY)
S ₃	THREE-WAY SWITCH	▼	TELEPHONE OUTLET	K	KEYPAD (BOX ONLY)
S ₄	FOUR-WAY SWITCH	₩ ▼	WALL-MOUNTED TELEPHONE OUTLET	P	PAGING SPEAKER
S _D	DIMMER SWITCH	∇	DATA OUTLET	V	PAGING SPEAKER VOLUME CONTROL
So	WALL-MOUNTED OCCUPANCY SENSOR SWITCH	V	COMBINATION TELEPHONE / DATA OUTLET	a	INDICATES ABOVE COUNTER
S _{OD}	WALL-MOUNTED OCCUPANCY SENSOR DIMMING SWITCH	HDMI	HDMI OUTLET	GFI	INDICATES GROUND FAULT PROTECTION
S _{LV}	LOW VOLTAGE SWITCH	(AP)	WIRELESS ACCESS POINT	WR	INDICATES WEATHER RESISTANT
S _M	MANUAL MOTOR STARTER SWITCH	<u>s</u>	SMOKE DETECTOR	TR	INDICATES TAMPER RESISTANT
<u>(S)</u>	CEILING-MOUNTED LOW VOLTAGE OCCUPANCY SENSOR	(S) _D	DUCT SMOKE DETECTOR	AFF	INDICATES ABOVE FINISH FLOOR
(S) _{120V/277V}	CEILING-MOUNTED LINE VOLTAGE OCCUPANCY SENSOR	Θ	HEAT DETECTOR	AFG	INDICATES ABOVE FINISH GRADE
PP	OCCUPANCY SENSOR POWER PACK	©	CARBON MONOXIDE DETECTOR	NS	INDICATES NON-SWITCHED
Ф	SIMPLEX RECEPTACLE	(D)	DOOR HOLDER	ER	INDICATES EXISTING RELOCATED
Ф	DUPLEX RECEPTACLE	F	FIRE ALARM PULL STATION	ETR	INDICATES EXISTING TO REMAIN

^{***} NOTE: NOT ALL SYMBOLS SHOWN IN LEGEND ARE APPLICABLE TO THIS PROJECT. ***

ELECTRICAL DRAWING INDEX

E001 ELECTRICAL NOTES, LEGEND, & INDEX

E201 ELECTRICAL LIGHTING PLAN

E301 ELECTRICAL POWER & SYSTEMS PLAN

E302 ELECTRICAL MEZZANINE AND ENLARGED PLANS

E401 HVAC EQUIPMENT POWER PLAN

E501 ELECTRICAL ONE-LINE DIAGRAM AND PANEL SCHEDULES

E601 ELECTRICAL PANEL SCHEDULES

E701 ELECTRICAL DETAILS

NO. DATE DESCRIPTION
1 03/06/25 ADD #1
2 04/03/25 Post Bid ADD #1

02.14.2025

DATE


ISSUE SET

E001

02.14.2025 ATE

ISSUE SET

E201

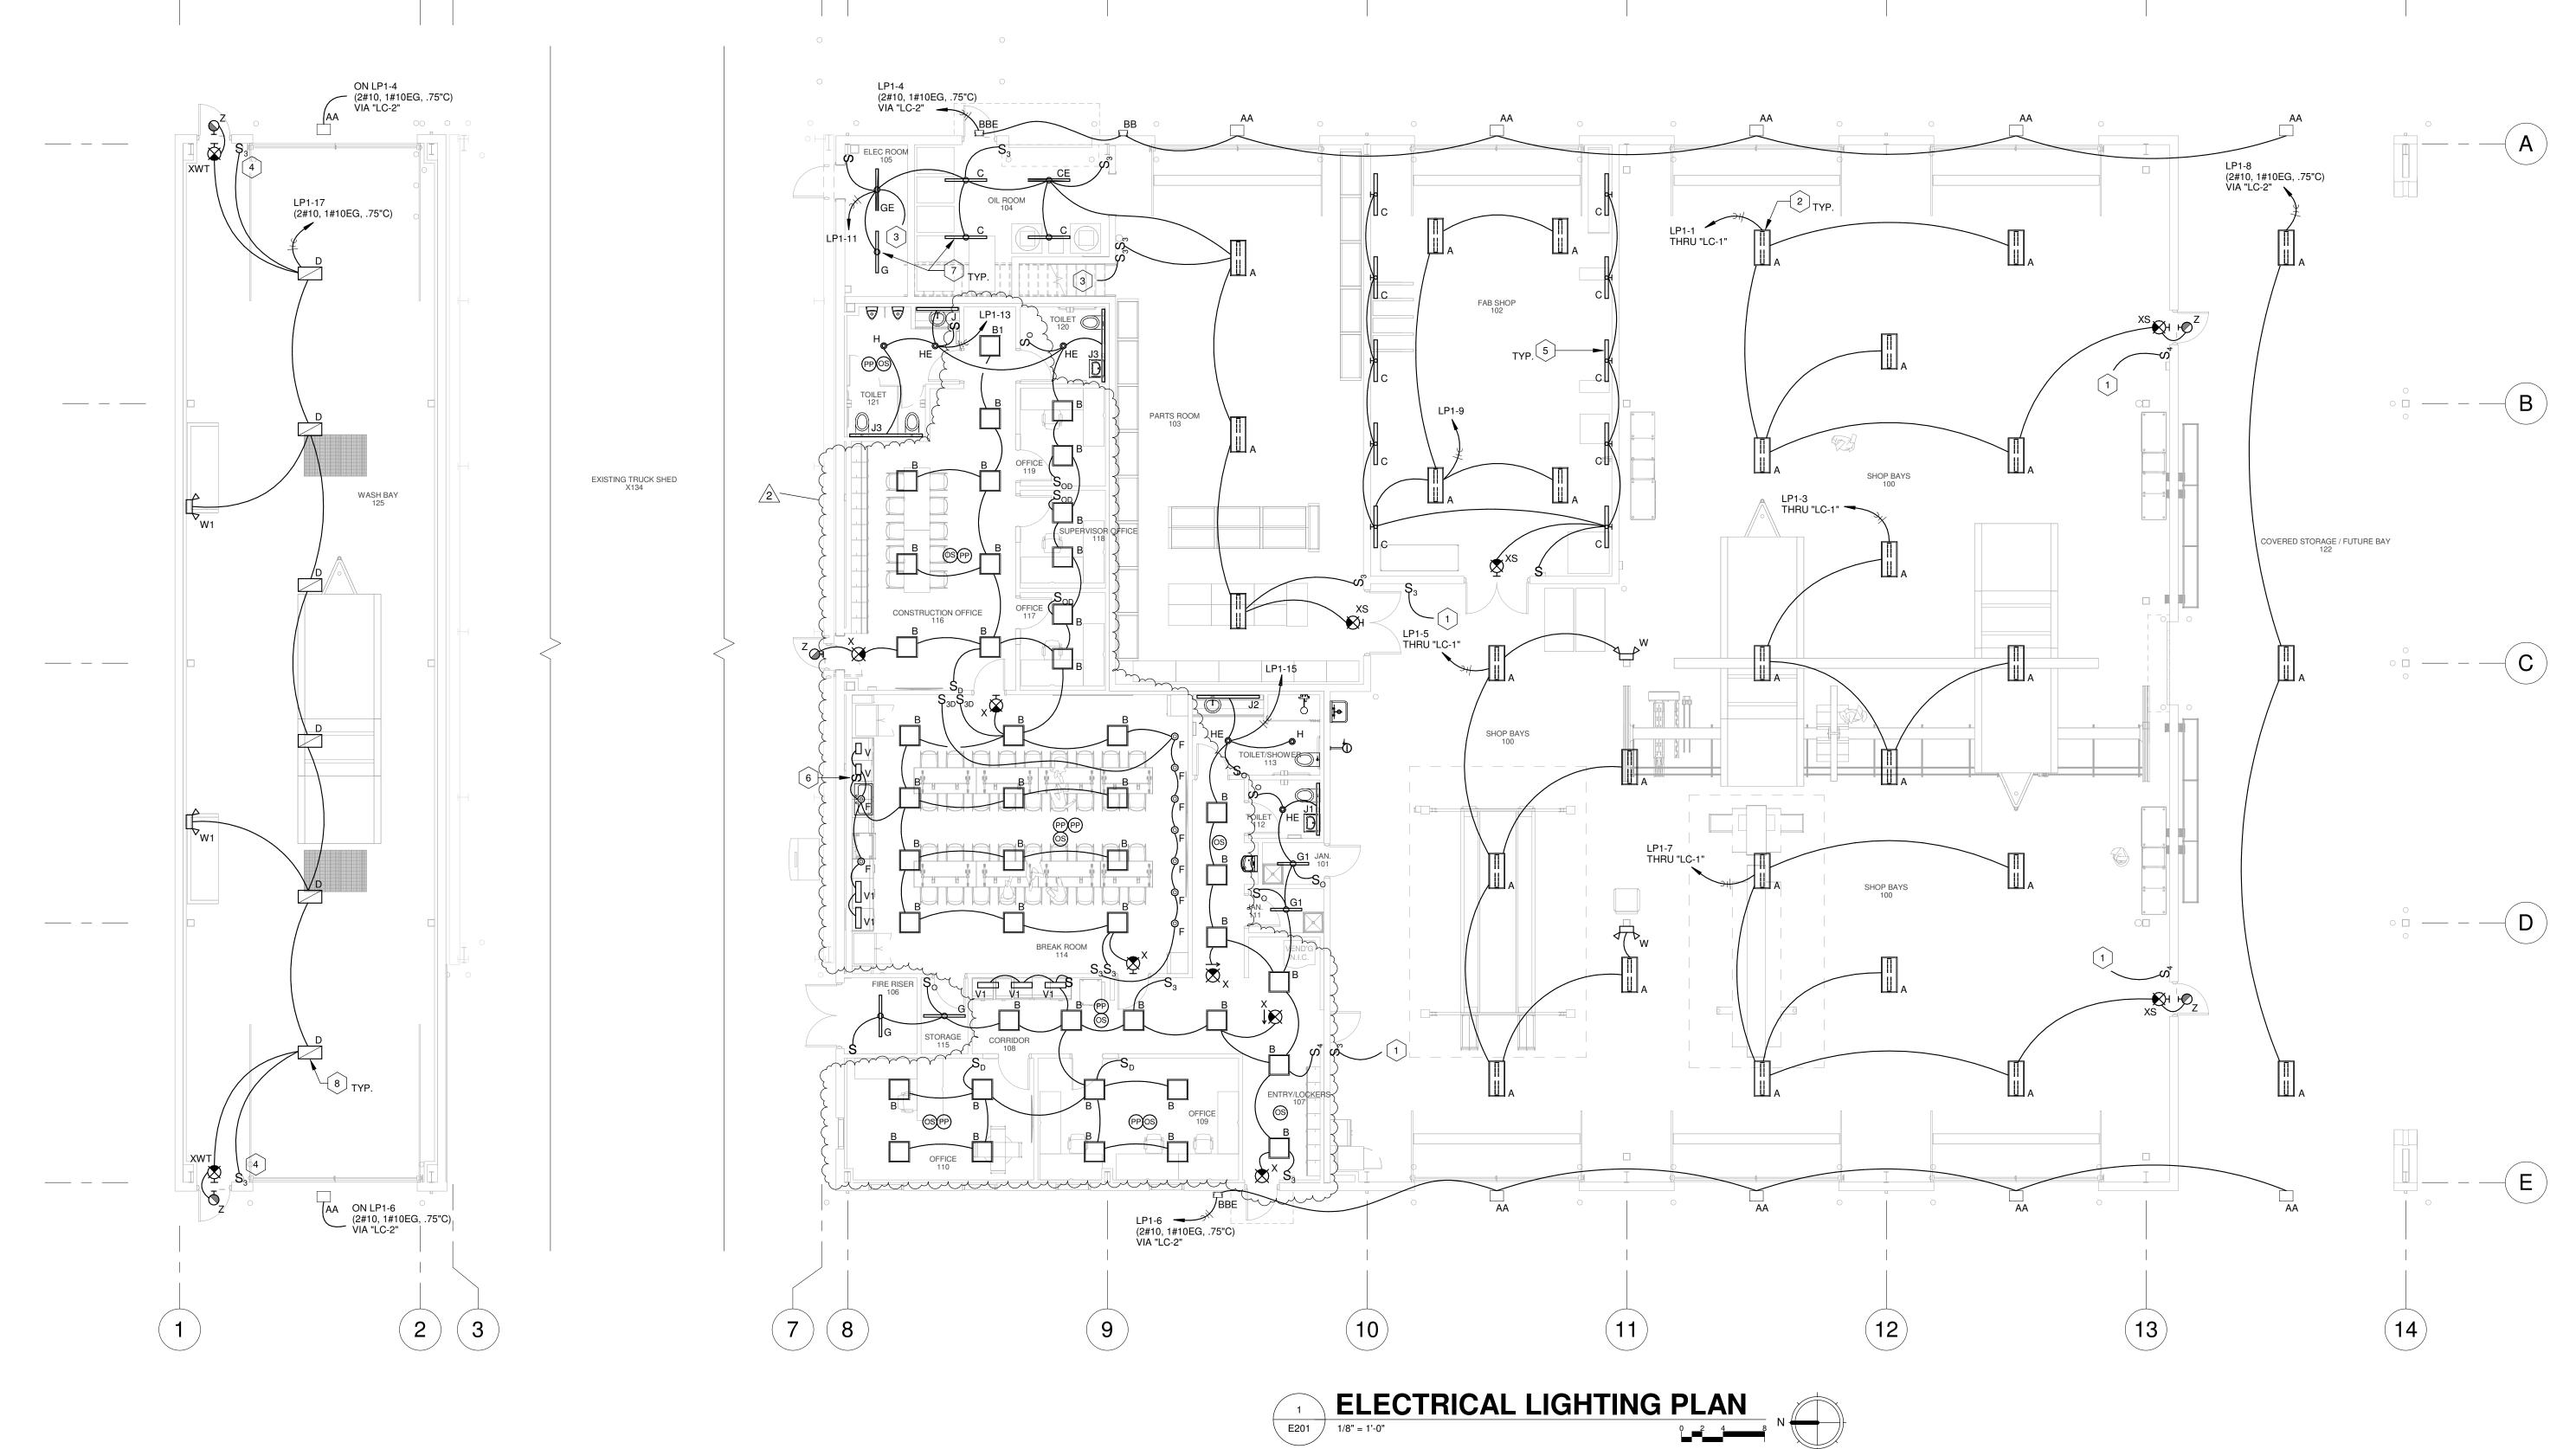

GENERAL ELECTRICAL NOTES

- ALL EXIT LIGHTS AND BATTERY BACKUP FOR EMERGENCY FIXTURES SHALL BE CIRCUITED WITH AN UN-SWITCHED HOT.
- 2. COORDINATE FINAL LOCATIONS AND MOUNTING HEIGHTS OF FIXTURES WITH ARCHITECT PRIOR TO BEGINNING ROUGH-IN.
- FIXTURES WITH ARCHITECT PRIOR TO BEGINNING ROUGH-IN.

 3. ALL CONDUIT, WIRING AND ELECTRICAL CONNECTIONS IN WASH BAY SHALL BE WATERTIGHT.
- 4. ALL CONDUIT INSTALLED ACROSS EXISTING TRUCK SHED SHALL BE ROUTED AS HIGH AS POSSIBLE. COORDINATE ROUTING WITH EXISTING STRUCTURE AND UTILITIES.

KEYED ELECTRICAL NOTES

- 1 TO LIGHTING CONTACTOR "LC-1" FOR SWITCHING OF SHOP BAY FIXTURES.
- MOUNT TYPE "A" LIGHTING FIXTURES AT 28'-0" ABOVE FINISH FLOOR TO BOTTOM OF FIXTURE. TYPICAL ALL FIXTURES IN SHOP BAY, FAB SHOP, AND PARTS ROOM.
- UP TO MEZZANINE STRIP FIXTURES. SEE SHEET E302 FOR CONTINUATION.
- INSTALL SWITCHES THIS ROOM WITH FLIP-COVER TYPE COVER PLATES.
- WALL MOUNT FIXTURES AT 9'-0" ABOVE FINISH FLOOR TO CENTERLINE OF FIXTURE.
- GANG DISPOSAL AND UNDERCABINET LIGHTING SWITCH TOGETHER.
 UNDERCABINET LIGHTING SWITCH SHALL BE INSTALLED CLOSEST TO
- 7 MOUNT FIXTURES AT 9'-0" ABOVE FINISH FLOOR TO BOTTOM OF FIXTURES.
- 8 MOUNT FIXTURES AT 20'-0" ABOVE FINISH FLOOR TO BOTTOM OF FIXTURES.

REGISTERED
ENGINEER


ENGINEER

Batson Inc.
ENGINEERING SOLUTIONS

JZ.14.2023 TE

ISSUE SET

E301

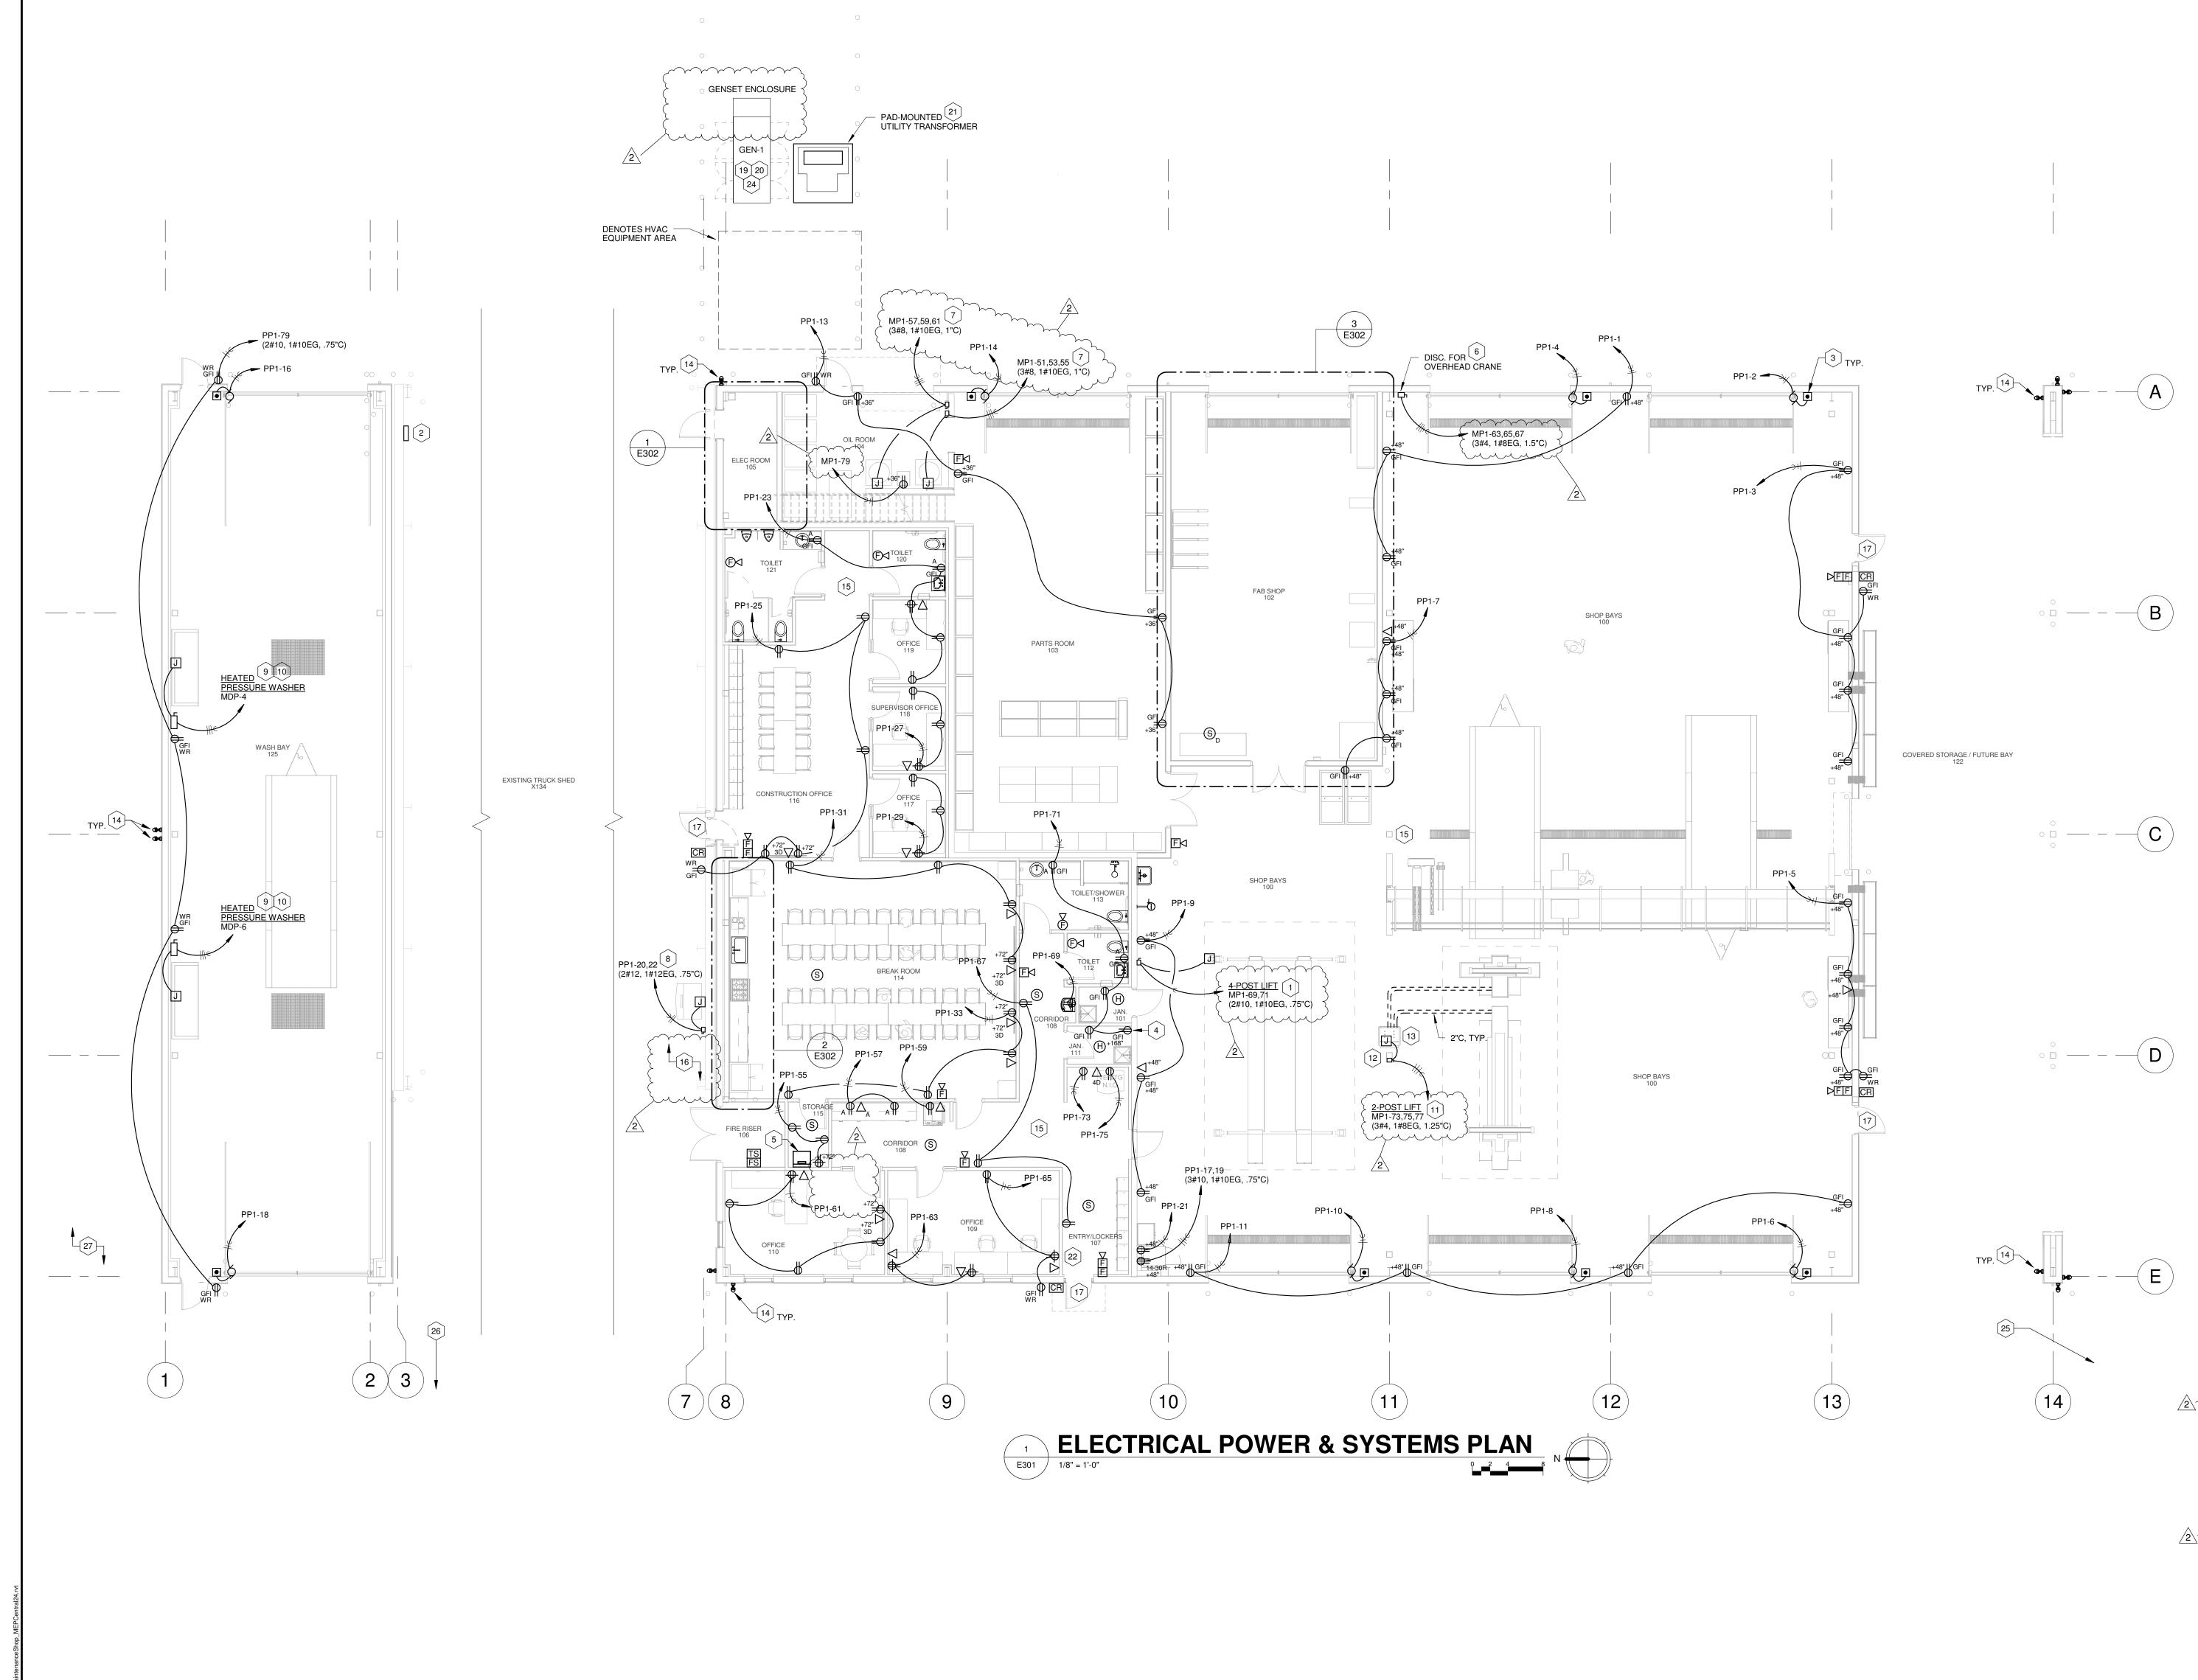

GENERAL ELECTRICAL NOTES

- 1. VERIFY EXACT LOCATIONS OF ALL EQUIPMENT PRIOR TO BEGINNING ROUGH-IN AND PLACEMENT OF WIRING DEVICES, DISCONNECTS, ETC.
- 2. ALL CONDUIT, WIRING AND ELECTRICAL CONNECTIONS IN WASH BAY SHALL BE WATERTIGHT.
- 3. ALL CONDUIT INSTALLED ACROSS EXISTING TRUCK SHED SHALL BE ROUTED AS HIGH AS POSSIBLE. COORDINATE ROUTING WITH EXISTING STRUCTURE AND UTILITIES.
- 4. ALL WIRING DEVICES NOTED AS 'ABOVE COUNTER' WITH AN 'A'
 DESIGNATION AND ARE AT LOCATIONS WITH A BACKSPLASH SHALL BE
 INSTALLED AT 48" ABOVE FINISH FLOOR TO CENTERLINE OF THE BACK
- 5. ALL WIRING DEVICES INSTALLED IN SHOP BAYS, PARTS & OIL ROOMS AND FAB SHOP SHALL BE INSTALLED WITH STAINLESS STEEL COVER

KEYED ELECTRICAL NOTES

- PROVIDE AND INSTALL NEMA 1 NON-FUSIBLE DISCONNECT RATED 240V/30A/3P.
- 2 APPROXIMATE LOCATION OF EXISTING TRUCK SHED PANELBOARD. RE-FEED PANELBOARD FROM NEW TRANSFORMER "TTS". REFER TO ONE-LINE DIAGRAM.
- PROVIDE AND INSTALL ALL CONDUIT AND WIRING BETWEEN DOOR OPERATOR AND DOOR CONTROLLER. VERIFY EXACT MOUNTING LOCATION OF DOOR OPERATOR WITH DOOR INSTALLER PRIOR TO
- OUTLET FOR RECIRCULATION PUMP. COORDINATE EXACT OUTLET HEIGHT WITH PLUMBING CONTRACTOR. MOUNT OUTLET WITHIN 6'-0"
- 5 PROVIDE AND INSTALL WALL-MOUNTED 12U NETWORK RACK.
 6 PROVIDE AND INSTALL NEMA 1 NON-FUSIBLE DISCONNECT RATED 240V/100A/3P. STUB UP CONDUIT AND WIRING UP WALL NEAR

OVERHEAD CRANE BUS BARS. COORDINATE WITH OVERHEAD CRANE INSTALLER FOR EXACT STUB LOCATION AND AMOUNT OF EXTRA SLACK NEEDED TO MAKE CONNECTIONS. OVERHEAD CRANE

- INSTALLER TO MAKE CONNECTIONS TO CRANE BUS BARS.

 7 PROVIDE AND INSTALL NEMA 1 NON-FUSIBLE DISCONNECT RATED
- 8 PROVIDE AND INSTALL NEMA 3R NON-FUSIBLE DISCONNECT RATED 240V/30A/2P.
- 9 PROVIDE AND INSTALL NEMA 4X NON-FUSIBLE DISCONNECT RATED 240V/200A/3P.
- 10 REFER TO ONE-LINE DIAGRAM FOR FEEDER REQUIREMENTS.
- PROVIDE AND INSTALL NEMA 1 NON-FUSIBLE DISCONNECT RATED 240V/100A/3P.
- MOUNT DISCONNECT TO COLUMN AND ROUTE WIRING UNDERGROUND OVER TO 2-POST LIFT POWER UNIT. INSTALL SEAL-OFFS IN CONDUIT AS REQUIRED PER MANUFACTURER'S INSTALLATION INSTRUCTIONS.
- COORDINATE WITH OWNER'S EQUIPMENT INSTALLER TO PROVIDE AND INSTALL 2"C IN SLAB FROM LIFT POWER UNIT TO LIFT. INSTALL SEAL-OFFS IN CONDUIT ENTERING POWER UNIT AS REQUIRED BY MANUFACTURER'S INSTALLATION INSTRUCTIONS. VERIFY EXACT CONDUIT ROUTING AND CONNECTION LOCATIONS PRIOR TO BEGINNING ROUGH-IN.
- SECURITY CAMERA ROUGH-IN: PROVIDE AND INSTALL 2-GANG BACK BOX WITH (2) CAT 6 CABLES IN EACH BOX. VERIFY MOUNTING HEIGHTS OF ALL CAMERAS PRIOR TO BEGINNING ROUGH-IN. ROUTE CAT 6 CABLES BACK TO STORAGE 115.
- PROVIDE AND INSTALL (2) CAT 6 CABLES AT THIS APPROXIMATE LOCATION FOR WIRELESS ACCESS POINT.
- PROVIDE AND INSTALL (1) 4"C FROM STORAGE ROOM 115 OVERHEAD TO THIS APPROXIMATE LOCATION FOR FIBER OPTIC CABLING (BY OWNER). VERIFY EXACT STUB LOCATION AND HEIGHT WITH OWNER
- PRIOR TO BEGINNING ROUGH-IN.

 17 SECURE DOOR REQUIRING ACCESS CONTROLS. REFER TO TYPICAL DOOR ACCESS CONTROL DETAIL FOR ADDITIONAL REQUIREMENTS.
- DIESEL GENERATOR (OWNER-FURNISHED, OWNER-INSTALLED).
 INSTALL EMPTY CONDUIT STUB-UPS BETWEEN GENERATOR AND
 TRANSFER SWITCH. REFER TO ONE-LINE DIAGRAM FOR
- REQUIREMENTS.

 PROVIDE (2) 1"C BETWEEN GENERATOR PAD AND ATS FOR CONTROLS.
 VERIFY STUB-UP LOCATION AT GENERATOR PAD. INSTALL PULL
 STRINGS IN EMPTY CONDUITS.
- ELECTRICAL CONTRACTOR IS RESPONSIBLE FOR INSTALLING
 TRANSFORMER PAD AND ALL SECONDARY CONDUIT AND WIRING.
 COORDINATE PAD REQUIREMENTS AND FINAL PLACEMENT OF
 TRANSFORMER WITH CECC.
- 22 APPROXIMATE LOCATION OF FIRE ALARM ANNUNCIATOR PANEL. CONFIRM LOCATION WITH OWNER PRIOR TO REGINNING ROUGH-IN.

 23 NOT USED.
- (2) 1"C STUB-UPS BETWEEN GENERATOR AND PANEL "EQ1" FOR BATTERY CHARGER AND BLOCK HEATER CIRCUITS. VERIFY STUB UP LOCATION AND INSTALL PULL STRINGS IN EMPTY CONDUITS.
- PROVIDE AND INSTALL (2) 1"C (POWER/COMMUNICATIONS) FOR SOUTH GATE ENTRY. REFER TO ARCHITECTURAL SITE PLAN FOR GATE LOCATION. CONNECT GATE OPERATOR TO "PP1-26" AND ROUTE (2#6, 1 #6EG, 1"C). STUB UP COMMUNICATIONS CONDUIT IN STORAGE 115.
- PROVIDE AND INSTALL (1) 1.25"C (POWER) AND (1) 1"C (COMMUNICATIONS) FOR WEST GATE ENTRY. REFER TO ARCHITECTURAL SITE PLAN FOR GATE LOCATION. CONNECT GATE OPERATOR TO "PP1-28" AND ROUTE (2#4, 1#4EG, 1.25"C). STUB UP COMMUNICATIONS CONDUIT IN STORAGE 115.
- GRINDER STATION. REFER TO CIVIL PLAN FOR EXACT LOCATION.
 CONNECT GRINDER STATION CONTROL PANEL TO "MP1-50,52".
 INSTALL SEAL-OFFS AT GRINDER STATION CONTROL PANEL. ROUTE
 (3#10, 1#10EG, 1"C) FROM PANELBOARD TO CONTROL PANEL. VERIFY
 EXACT LOCATION OF CONTROL PANEL WITH INSTALLING
 CONTRACTOR.

 28 NOT USED.




24-096 JOB. NO. 02.14.2025


DATE
ISSUE SET

E302

Batson Inc.
ENGINEERING SOLUTIONS

1300 Brookwood Drive Little Rock Arkansas 72202 501-664-3311 www.batson.com

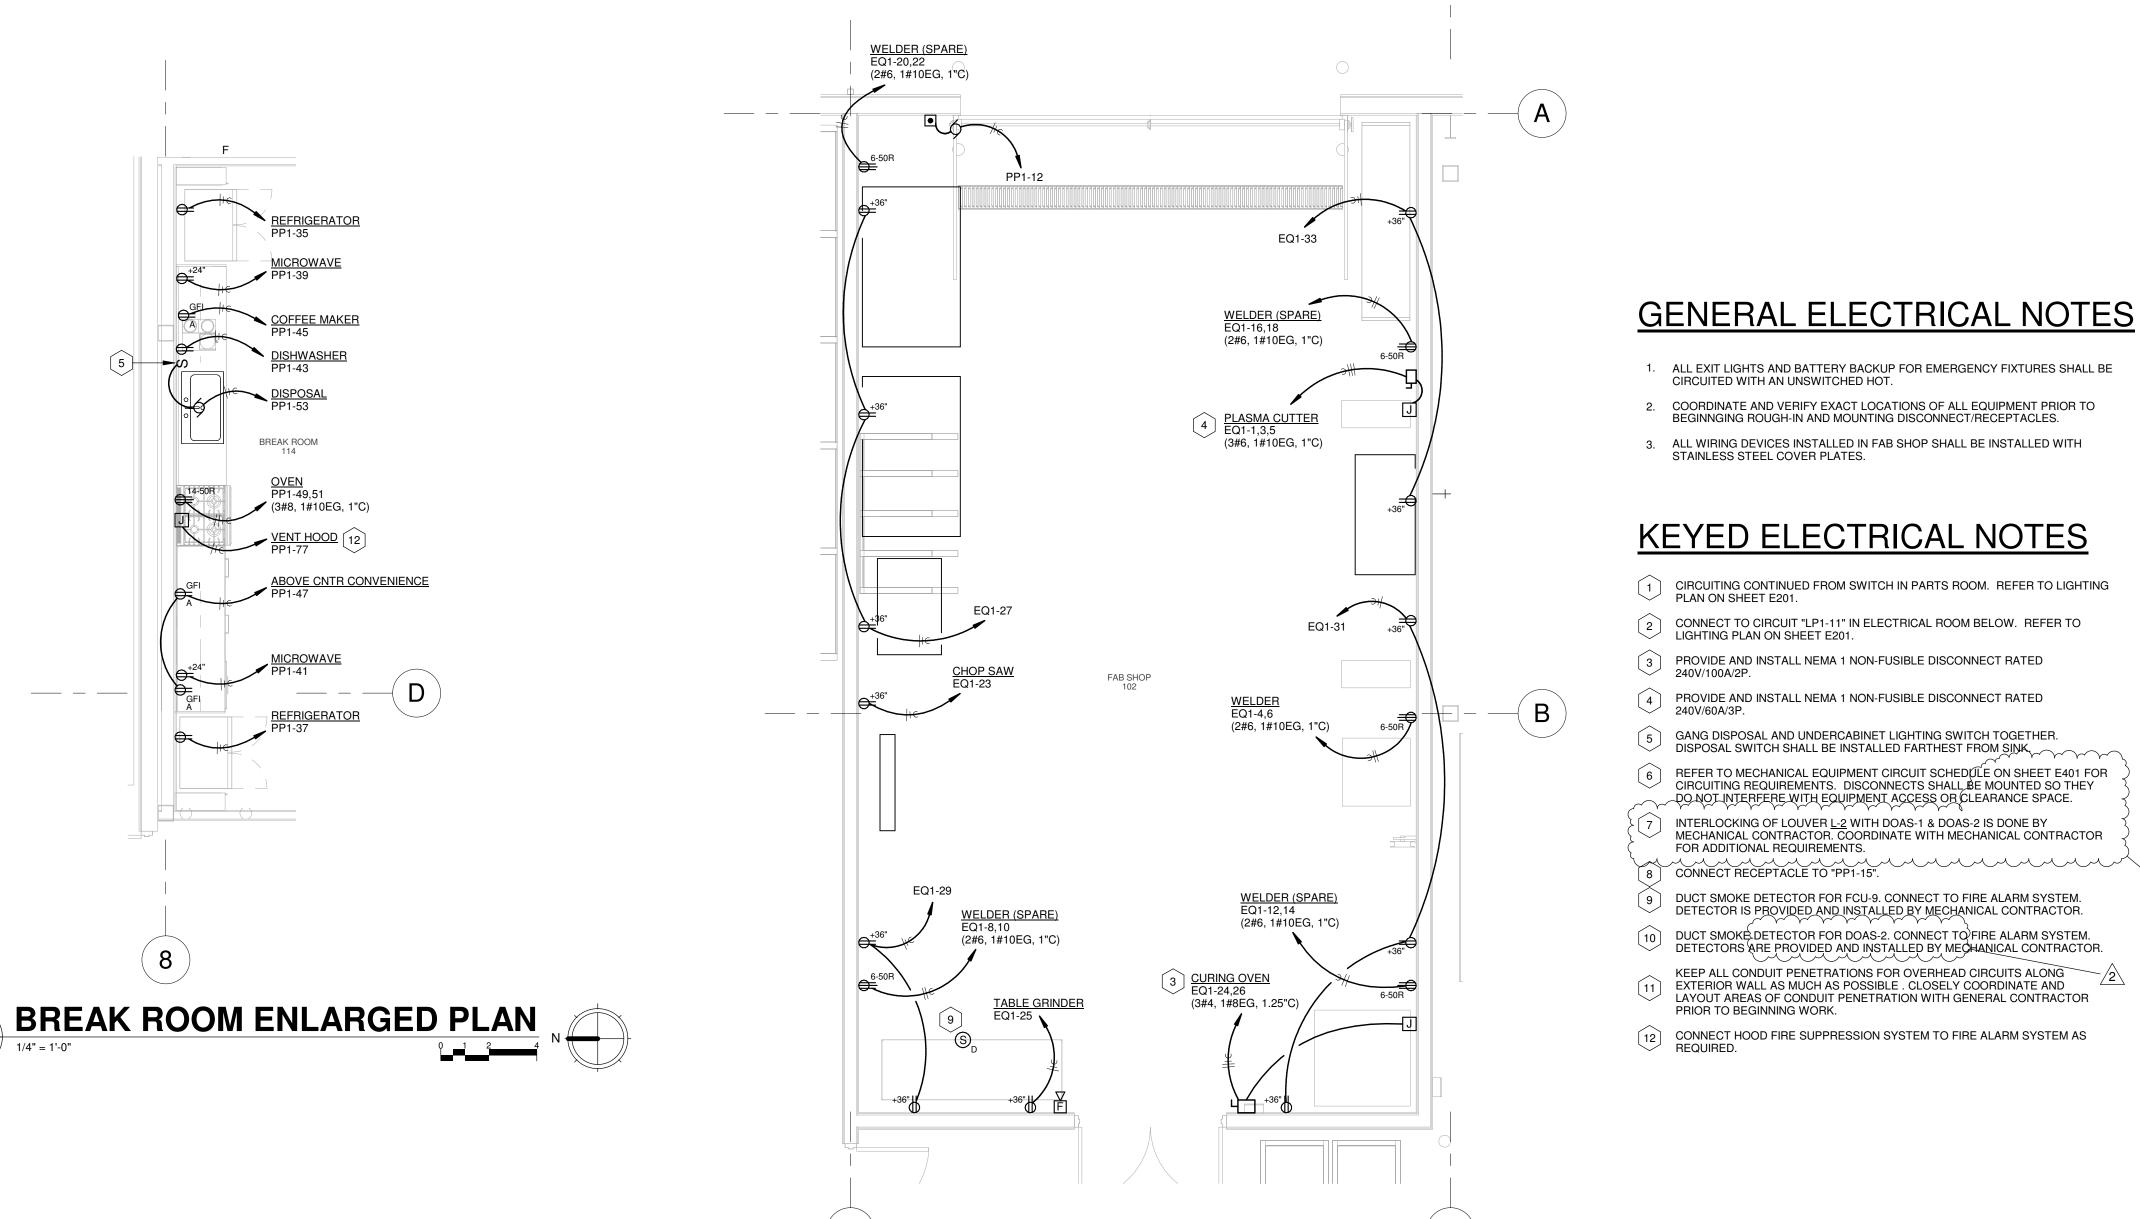

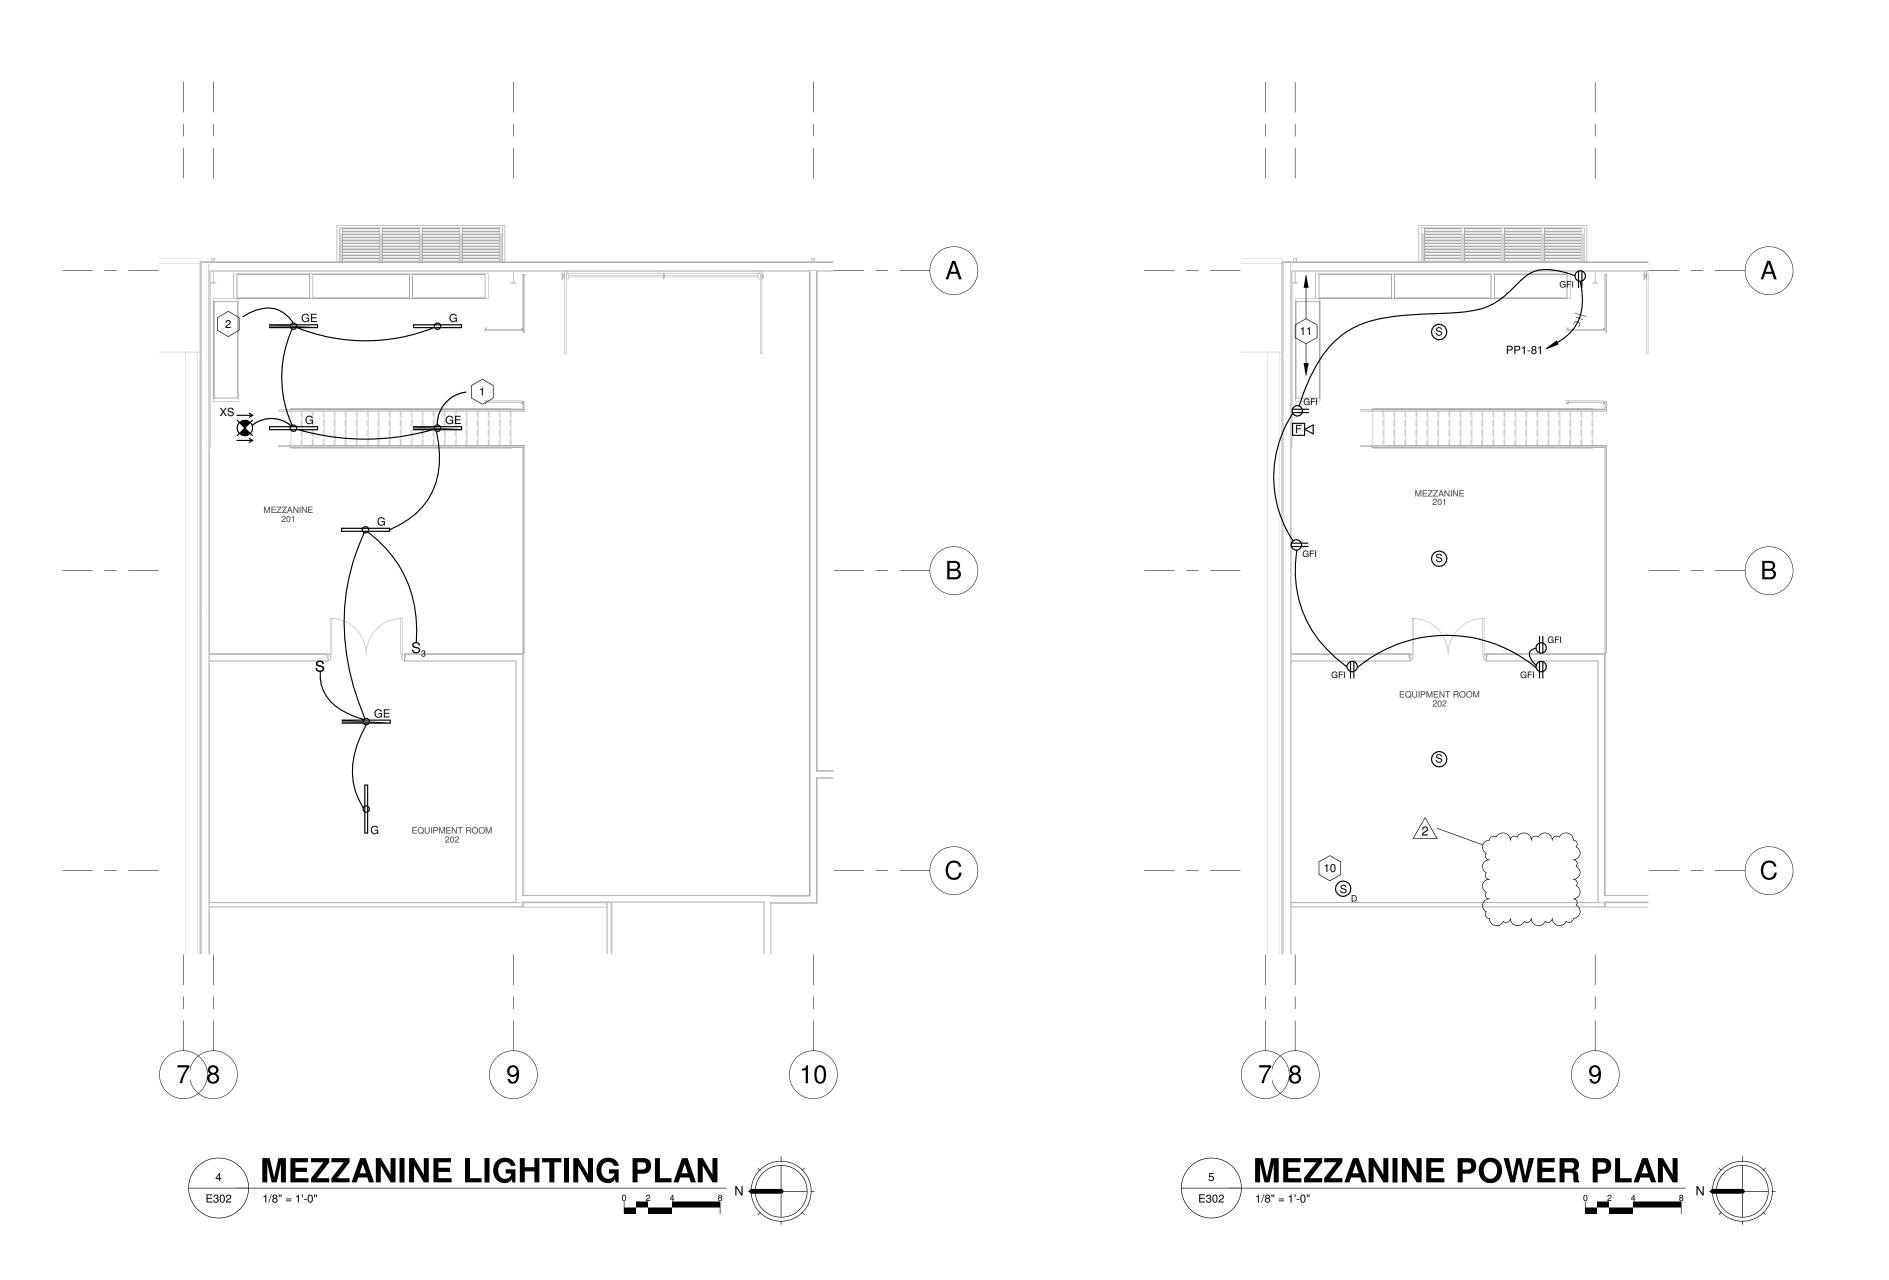

- AUTOMATIC TRANSFER

FIRE ALARM

TRANSFORMER "TTS"

TRUCK SHED

SECONDARY ENCLOSED CIRCUIT BREAKER


ENLARGED ELECTRICAL ROOM


CONTROL PANEL


SWITCH

ELEC ROOM 105

PANEL "MP1" -

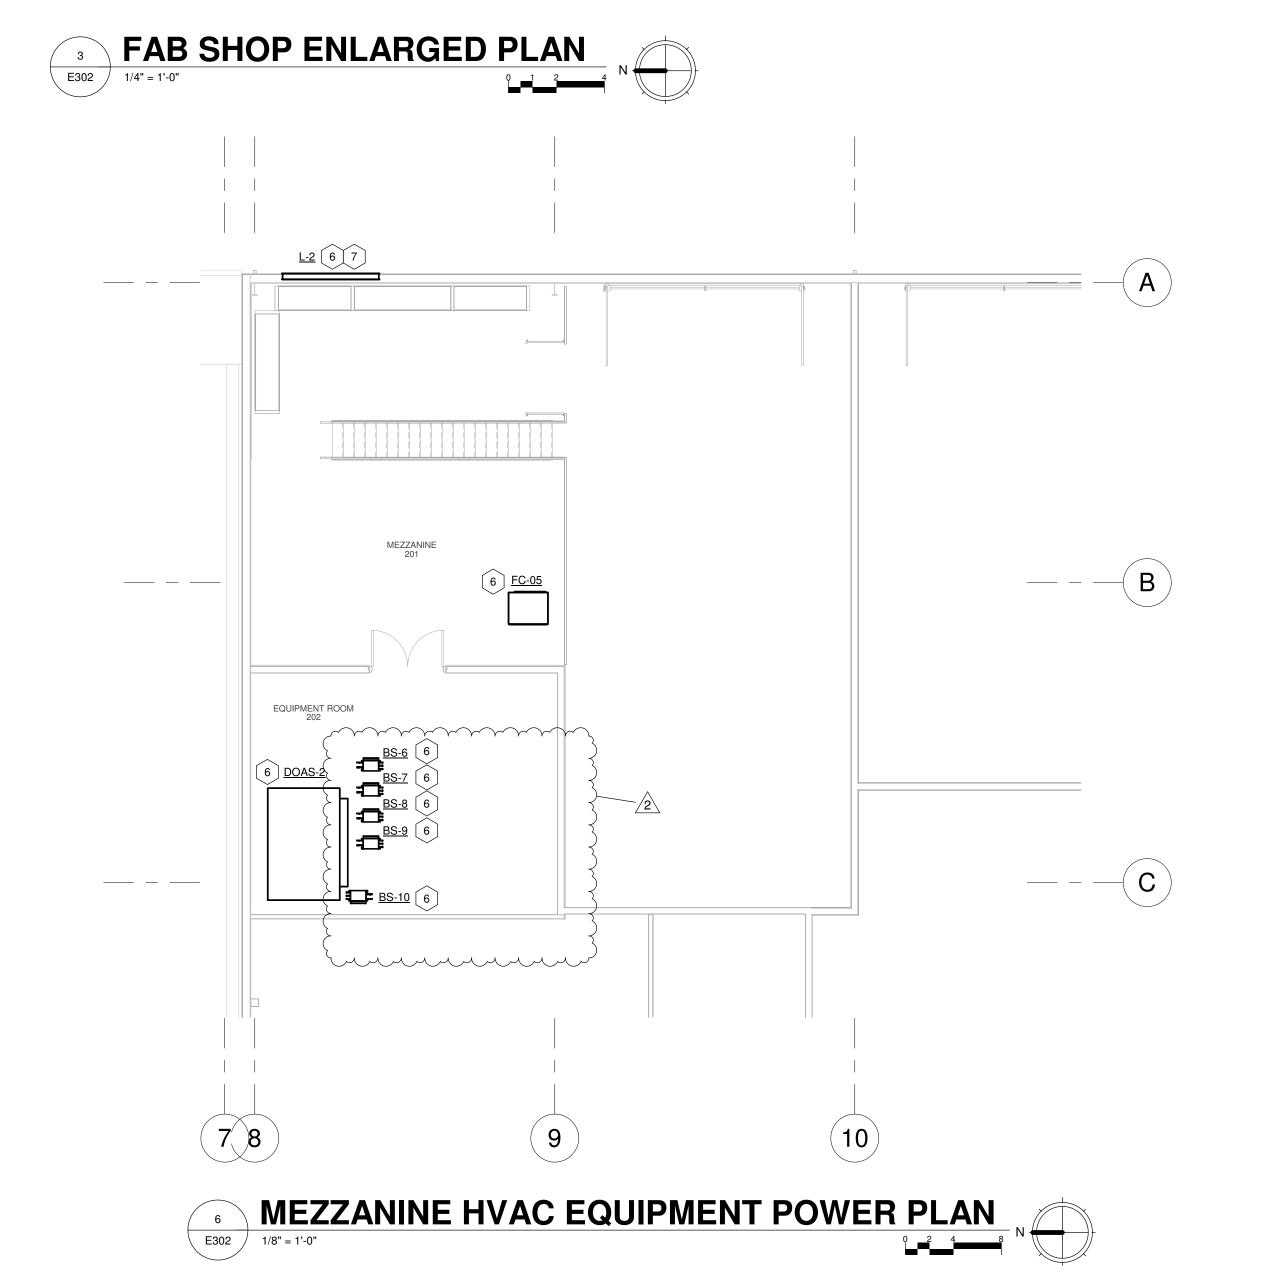

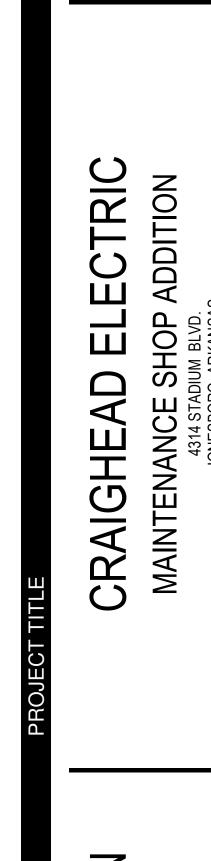

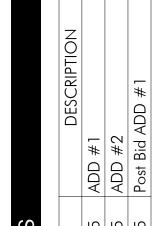

6 PROVIDE AND INSTALL 120V FOR HEAT TRACE AT ICE MACHINE. CONNECT TO CIRCUIT "PP1-24".

DISCONNECTS FOR OUTDOOR HRU UNITS SHALL BE INSTALLED ALONG THIS WALL.

8 PROVIDE AND INSTALL 120V CIRCUIT FOR HVAC BMS CONTROL PANEL. CONNECT TO CIRCUIT "MP1-44".

9 INTERLOCKING OF LOUVERS L-6 & L-7 WITH EF-4 IS DONE BY MECHANICAL CONTRACTOR. COORDINATE WITH MECHANICAL CONTRACTOR FOR ADDITIONAL REQUIREMENTS.

DRY-PIPE SPRINKLER SYSTEM AIR COMPRESSOR LOCATED THIS ROOM. VERIFY EXACT LOCATION WITH FIRE PROTECTION CONTRACTOR.

ENGINEER * * *

Batson Inc.

ENGINEERING SOLUTIONS

1300 Brookwood Drive Little Rock Arkansas 72202 501-664-3311 www.batson.com


| C | C |

24-096

Job. No. 02.14.2025


ISSUE SET

E401

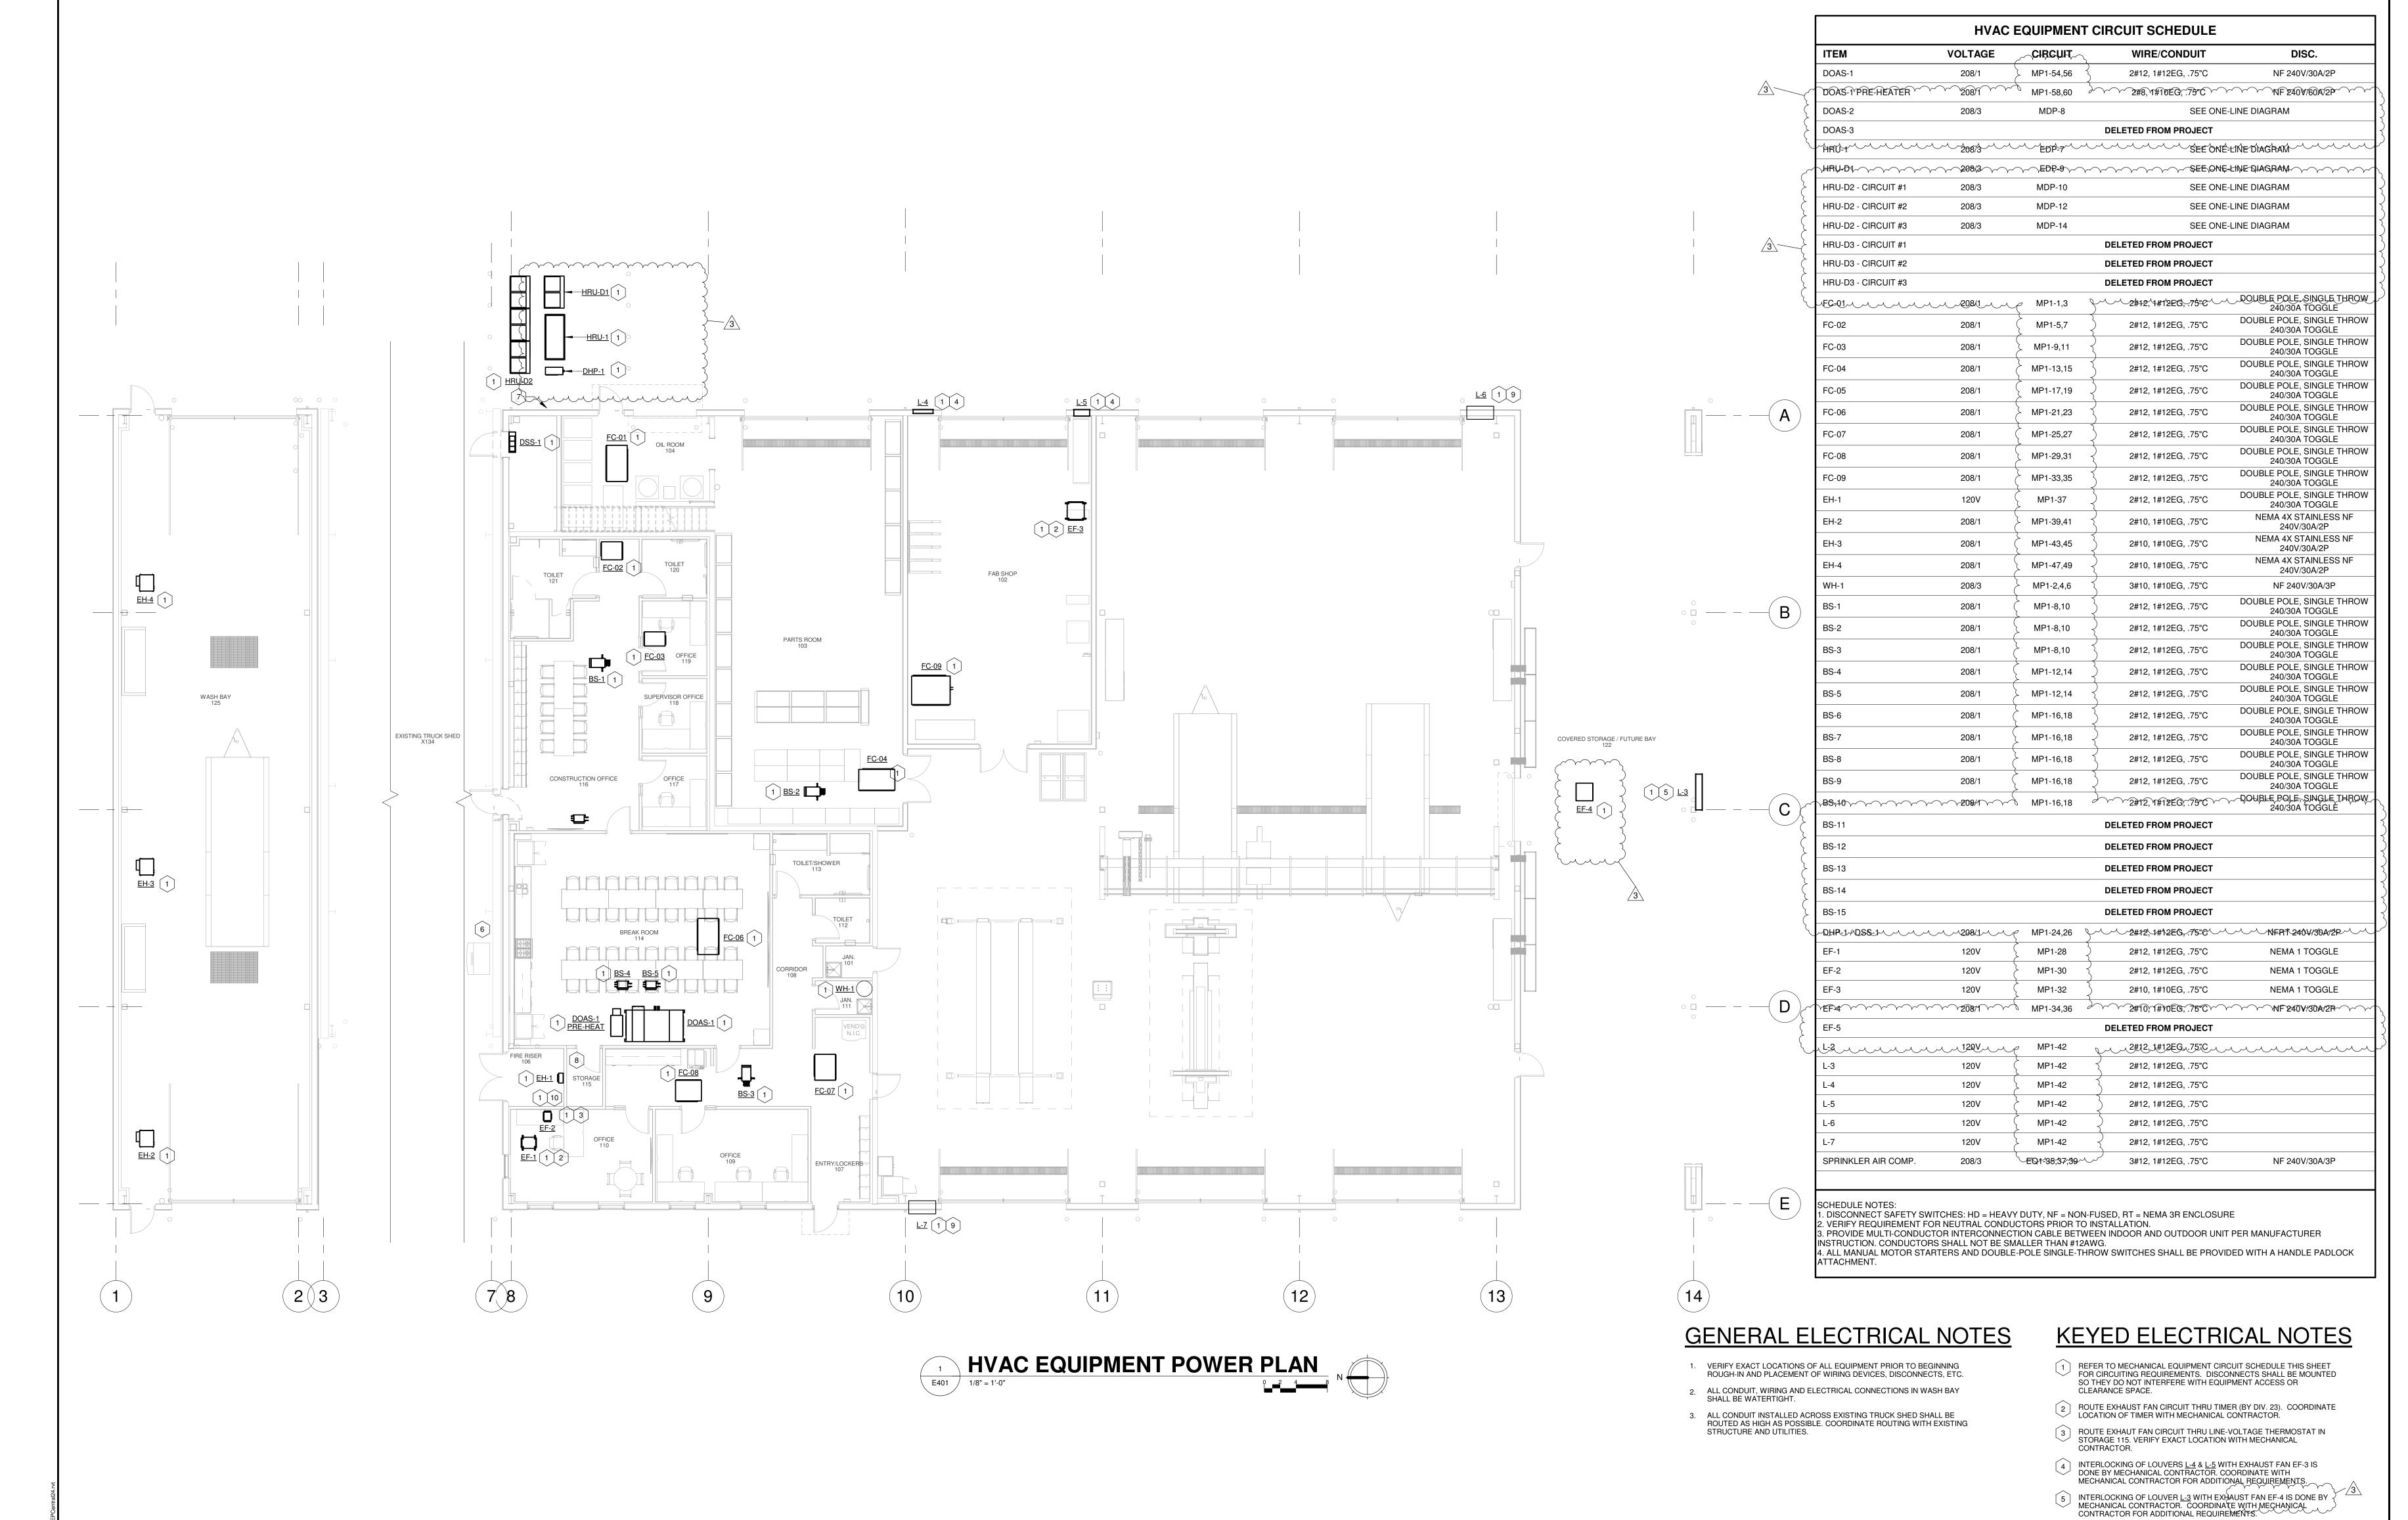

E501

Batson Inc. engineering solutions

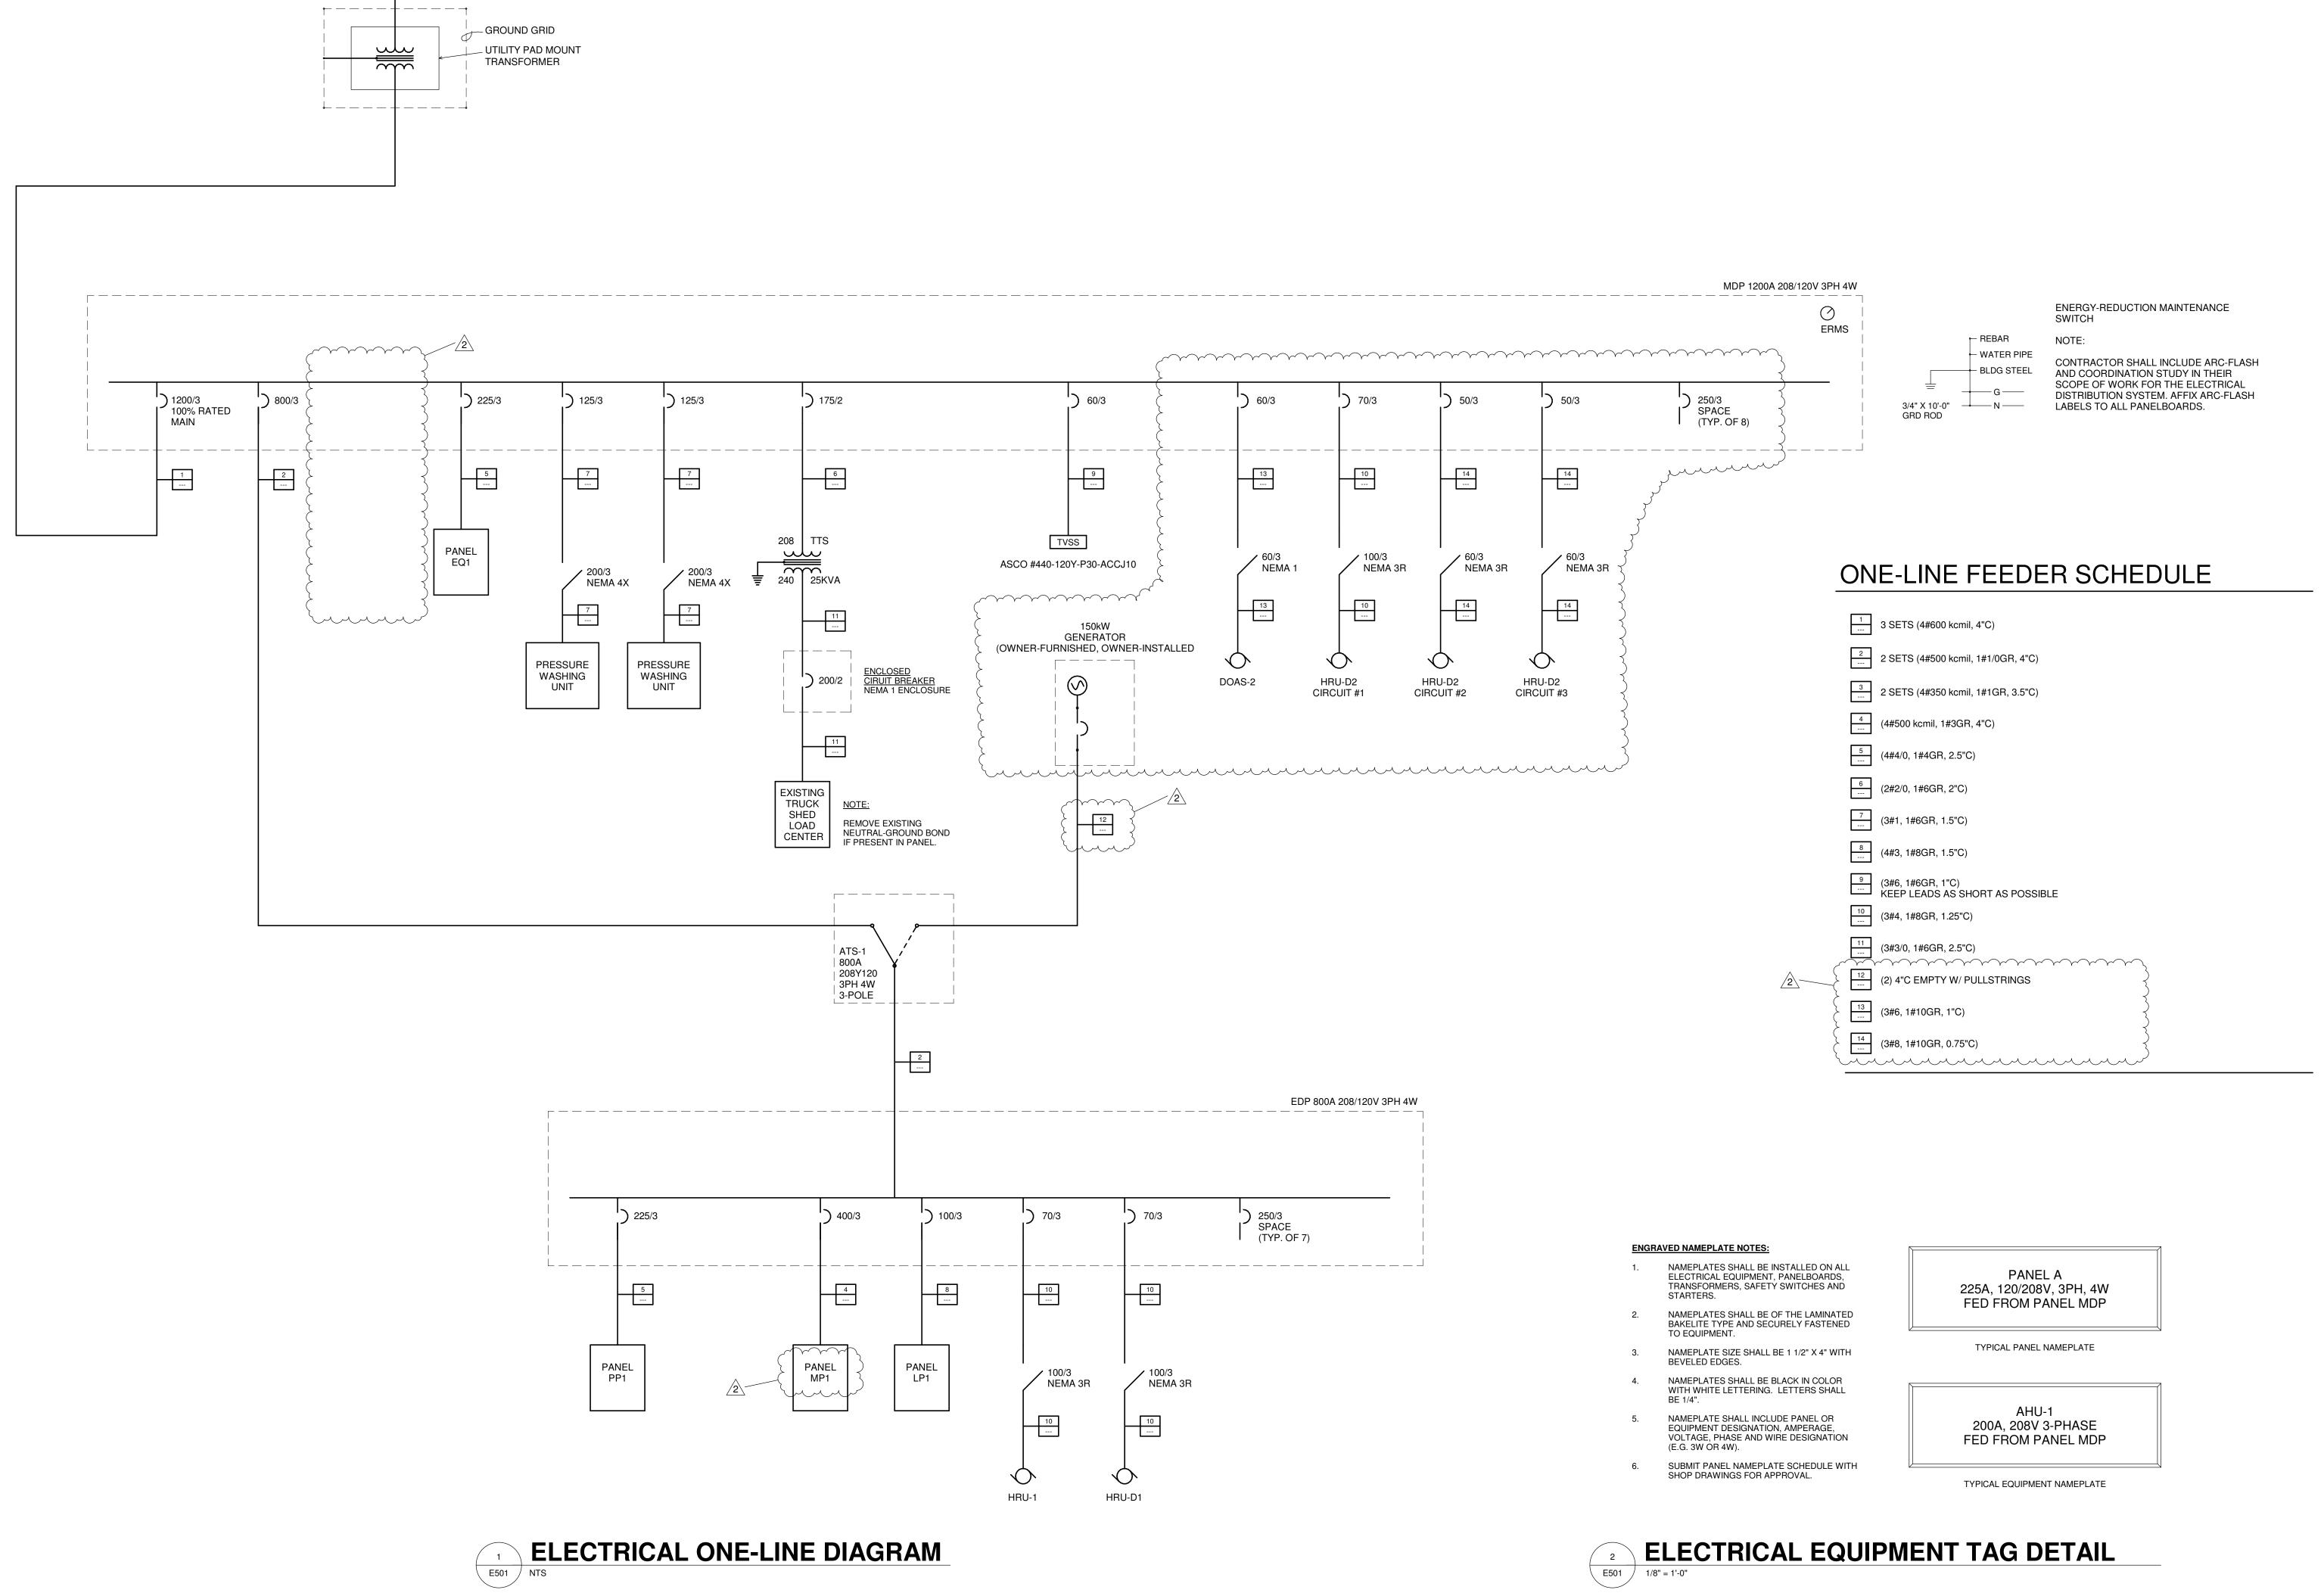


2 ELECTRICAL EQUIPMENT TAG DETAIL
E501 1/8" = 1'-0"

	1		PA	NELB							T
Panel Name:	Volts			Mains:		Fed Fr		l	ATS		Interrupting Ratin
EDP	1	20/2	08	80	0A	Mounti	ng:	Feeder	r:		22kA
TYPE:	1.	phase:			breaker	surface flush		top	bottom		COPPER BU
SQUARE D "HCP-SU"	3	3	4	X		X				X	GROUND BA
				BRA	ANCH E	BREAKE	ERS		1	1	
ITEM	CKT	СКТ	L	OAD (KV	۹)	L	OAD(KV	A)	СКТ	СКТ	ITEM
PANEL "PP1"	BKR	NO.	Α	В	С	Α	В	С	NO.	BKR	PANEL "LP1"
PANEL "PPI"	225/3		24.22			4.27				100/3	PANEL "LPT"
		1		23.30			4.38		2		
SPACE W/ BUSSING	250/3				18.46			4.90		250/2	SPACE W/ BUSSING
SI AGE W/ BOSSING	250/5									230/3	SI ACE W/ BOSSING
		3							4		
PANEL "MP1"	400/3									250/3	SPACE W/ BUSSING
· · · · · · · · · · · · · · · · · · ·	100/0		33.14							200/0	017102 117 20001110
		5		34.53					6		
HRU-1	70/3				34.26					250/3	SPACE W/ BUSSING
		7	6.46						8		
		′		6.46	6.46				"		
HRU-D1	70/3		F CO		6.46					250/3	SPACE W/ BUSSING
		9	5.60	5.60					10		
				5.60	5.60						
SPACE W/ BUSSING	250/3				3.00					250/3	SPACE W/ BUSSING
		11							12		
PROVIDE WITH 4-PIECE TRIM WITH	1	-	69.42	69.89	64.78	4.27	4.38	4.90		1	PROVIDE PANEL WITH 54" CIRCUIT
DOOR.			73.69	74.27		TOTALS					BREAKER MOUNTING SPACE.
				•				O A D 10/4			
				217.64		TOTAL	JONIN. L	OAD KVA			

Interrupting Ratin			EDP		om:	Fed Fr		Mains:		i	Volts:	Panel Name:			
22k			:	Feeder	ng:	Mounti	0A	10	80	20/2	1	LP1			
COPPER BU	1	ttom	bot	top	surface flush		breaker	lugs	wire:		phase:	TYPE:			
GROUND BA		Χ	2	·		X		X	4	3	3	SQUARE D "NQ"			
	•				RS	REAKE	ANCH E	BR			-				
ITEM	кт	CKT	CKT	A)	OAD(KVA	L	A)	OAD (KV	L	CKT	CKT	ITEM			
ITEM	KR	BKR	NO.	С	В	Α	С	В	Α	NO.	BKR	ITEM			
-2 COIL VOLTAGE	0/1 LC-1 & LC	20/1	2			0.01			1.42	1	20/1	LIGHTS SHOP BAY LIGHTS			
EXT. WALL PACKS (EAST)	_{0/1} LIGHTS	20/1	4		1.12			1.14		3	20/1	LIGHTS SHOP BAY LIGHTS			
EXT. WALL PACKS (WEST)	_{0/1} LIGHTS	20/1	6	0.91			1.42			5	20/1	LIGHTS SHOP BAY LIGHTS			
EXTERIOR COVERED BAY	_{0/1} LIGHTS	20/1	8			0.52			1.42	7	20/1	LIGHTS SHOP BAY LIGHTS			
	_{0/1} SPARE	20/1	10		0.00			1.41		9	20/1	LIGHTS FAB SHOP			
	_{0/1} SPARE	20/1	12	0.00			1.20			11	20/1	LIGHTS PARTS/OIL ROOM, ELEC RM, MEZZ			
	_{0/1} SPARE	20/1	14			0.00			0.90	13	20/1	LIGHTS CONSTR. OFF, BREAK RM			
/ BUSSING	_{0/1} SPACE W	20/1	16					0.71		15	20/1	LIGHTS TLTS, CORRIDOR, OFFICE 109-110			
/ BUSSING	_{0/1} SPACE W	20/1	18				1.37			17	20/1	LIGHTS WASH BAY			
/ BUSSING	_{0/1} SPACE W	20/1	20						0.00	19	20/1	SPARE			
/ BUSSING	0040514	20/1	22					0.00		21	20/1	SPARE			
/ BUSSING	_{0/1} SPACE W	20/1	24				0.00			23	20/1	SPARE			
/ BUSSING	_{0/1} SPACE W	20/1	26						0.00	25	20/1	SPARE			
/ BUSSING	CDACE VA	20/1	28					0.00		27	20/1	SPARE			
/ BUSSING	_{0/1} SPACE W	20/1	30				0.00			29	20/1	SPARE			
/ BUSSING	_{0/1} SPACE W	20/1	32							31		SPACE W/ BUSSING			
/ BUSSING	CDACE M	20/1	34							33	20/1	SPACE W/ BUSSING			
/ BUSSING	_{0/1} SPACE W	20/1	36							35	20/1	SPACE W/ BUSSING			
/ BUSSING	_{0/1} SPACE W	20/1	38							37	20/1	SPACE W/ BUSSING			
/ BUSSING	0040514	20/1	40							39	20/1	SPACE W/ BUSSING			
/ BUSSING	_{0/1} SPACE W	20/1	42							41	20/1	SPACE W/ BUSSING			
				0.91	1.12	0.53	3.99	3.26	3.74						
			ı			TOTALS	4.90	4.38	4.27						
				0 A D 1/1/4				•							
				OAD KVA	CONN. LC	TOTAL (13.55							

Panel Name:	Volts:			Mains:		Fed Fr	om:		EDP		Interrupting Rating		
PP1	1	20/2	208	22	5A	Mounti	ng:	Feeder	·:		22kA		
TYPE:	phase:		wire:	lugs	hreaker	surface	ı	top		ttom	COPPER BU GROUND BA		
SQUARE D "NQ"	3		4	X	broaker	X	liadii	liop		X			
SQUALL D ITQ			7			I A BREAKERS			4	^	GROUND BAI		
				DN	ANONE		Ino						
ITEM	CKT	CKT		OAD (KV	Τ'		OAD(KV	Τ'	CKT	CKT	ITEM		
	BKR	NO.	Α	В	С	Α	В	С	NO.	BKR			
RECPTS SHOP BAYS	20/1	1	0.60			1.50			2	20/1	OVERHEAD DOOR - SHOP BAY		
RECPTS SHOP BAYS, EXTERIOR	20/1	3		1.00			1.50		4	20/1	OVERHEAD DOOR - SHOP BAY		
RECPTS SHOP BAYS, EXTERIOR	20/1	5			1.00			1.50	6		OVERHEAD DOOR - SHOP BAY		
RECPTS SHOP BAYS	20/1	7	0.80			1.50			8		OVERHEAD DOOR - SHOP BAY		
RECPTS SHOP BAYS	20/1	9		0.60			1.50		10		OVERHEAD DOOR - SHOP BAY		
RECPTS SHOP BAYS	20/1	11			0.80			1.50	12		OVERHEAD DOOR - FAB SHOP		
RECPTS PARTS & OIL ROOMS, EXTERIOR	20/1	13	1.00			1.50			14		OVERHEAD DOOR - PARTS ROOM		
RECPTS ELECTRICAL ROOM DRYER - SHOP BAY	20/1 30/2	15		0.60			1.50		16		OVERHEAD DOOR - WASH BAY		
DITTERT SHOP BAT	30/2	17			2.50			1.50	18	20/1	OVERHEAD DOOR - WASH BAY ICE MACHINE - TRUCK SHED		
		19	2.50			1.24			20	20/2	IOE WAOTINE - TROOK SHED		
WASHING MACHINE - SHOP BAY	20/1	21		1.80	4.00		1.24	0.40	22	00/4	LOE MACHINE LIEAT TRACE		
RECPTS OFFICE 119, TLTS 120, 121	20/1	23	1.00		1.20	4.40		0.18	24		ICE MACHINE HEAT TRACE		
RECPTS CONSTR. OFFICE 116, EXT.	20/1	25	1.20	0.00		1.18	1.10		26		WEST ENTRY GATE		
RECPTS SUPERVISER OFFICE 118	20/1	27		0.80	0.80		1.18	0.00	28		SOUTH ENTRY GATE SPARE		
RECPTS OFFICE 117	20/1	29	0.90		0.80	0.00		0.00	30				
RECPTS BREAK ROOM 114 RECPTS BREAK ROOM 114	20/1	31	0.80	0.60		0.00	0.00		32 34		SPARE SPARE		
REFRIGERATOR - BREAK ROOM 114	20/1	35		0.60	1.00		0.00	0.00	36		SPARE		
REFRIGERATOR - BREAK ROOM 114	20/1	37	1.00		1.00			0.00	38		SPARE		
MICROWAVE - BREAK ROOM 114	20/1	39	1.00	1.20					40		SPARE		
MICROWAVE - BREAK ROOM 114 MICROWAVE - BREAK ROOM 114	20/1	41		1.20	1.20				42	20/1	SPACE W/ BUSSING		
DISHWASHER - BREAK ROOM 114	20/1	43	1.00		1.20				44		SPACE W/ BUSSING		
COFFEE MAKER - BREAK ROOM 114	20/1	45	1.00	1.20					46		SPACE W/ BUSSING		
ABOVE COUNTER - BREAK ROOM 114	20/1	47		1.20	0.40				48		SPACE W/ BUSSING		
OVEN - BREAK ROOM 114	50/2	49	4.00		0.40				50		SPACE W/ BUSSING		
		51	7.00	4.00					52		SPACE W/ BUSSING		
DISPOSAL BREAK ROOM 114	20/1	53		1.00	1.18				54		SPACE W/ BUSSING		
RECPTS STORAGE 115	20/1	55	0.80		11.10				56		SPACE W/ BUSSING		
ABOVE CNTR WORK AREA - CORRIDOR 108	20/1	57	0.00	0.40					58		SPACE W/ BUSSING		
COPIER - WORK AREA IN CORRIDOR 108	20/1	59			1.00				60		SPACE W/ BUSSING		
RECPTS OFFICE 110	20/1	61	1.20						62		SPACE W/ BUSSING		
RECPTS OFFICE 109	20/1	63		0.80					64		SPACE W/ BUSSING		
RECPTS OFFICE 109, EXTERIOR	20/1	65			0.80				66		SPACE W/ BUSSING		
RECPTS ENTRY 107, CORRIDOR 108	20/1	67	0.60						68		SPACE W/ BUSSING		
ELECTRIC WATER COOLER - CORRIDOR 108	20/1	69		1.18					70		SPACE W/ BUSSING		
RECPTS TLTS 112,113, JAN 101, 111, RECIRC	20/1	71			1.00				72		SPACE W/ BUSSING		
VENDING MACHINE - CORRIDOR 108	20/1	73	1.00						74		SPACE W/ BUSSING		
VENDING MACHINE - CORRIDOR 108	20/1	75		1.00					76		SPACE W/ BUSSING		
VENT HOOD BREAK ROOM 114	20/1	77			0.30				78		SPACE W/ BUSSING		
RECPTS WASH BAY	20/1	79	0.80						80		SPACE W/ BUSSING		
RECPTS MEZZANINE & MEZZ EQUIP ROOM	20/1	81		1.20					82		SPACE W/ BUSSING		
FIRE ALARM CONTROL PANEL	20/1	83			0.60				84		SPACE W/ BUSSING		
PROVIDE GFCI TYPE BREAKERS FOR			17.30	16.38	13.78	6.92	6.92	4.68			PROVIDE GFEP TYPE CIRCUIT		
THE FOLLOWING CKTS: #1 THRU #13, #	:		24.22	23.30	18.46	TOTALS	i				BREAKERS FOR THE FOLLOWING		
21, #35 THRU #43, #49/51, #69, #73, #75,											CKTS: #24.		

Panel Name:	Volts:			Mains:		Fed Fro	om:		EDP		Interrupting Rating:	
EQ1	120/20			08 225A		Mounting:		Feeder:			22kAl(
TYPE:	phase:		wire:	lugs	breaker	surface	flush	top	bot	ttom	COPPER BUS	
SQUARE D "NQ"	3		4	X		X			X		GROUND BAR	
ITEM	CKT	CKT	L	OAD (KV	A)	Lo	OAD(KV)	4)	СКТ	СКТ	ITEM	
ITEM	BKR	NO.	Α	В	С	Α	В	С	NO.	BKR	ITEM	
PLASMA CUTTER	50/3	1	3.72						2		SPARE	
		3		3.72			3.27		4	50/2	WELDING OUTLET - FAB SHOP	
\\\\\\\\\\\\\\\\\\\\\\\\\\\\\\\\\\\\\\	~~	5	~~~	~~~	3.72			3.27	6			
SPARE	20/1	7							8	50/2	SPARE WELDING OUTLET - FAB SHOP	
SPARE	20/1	9			3				10			
SPARE	£0/11	_111_		m	رار.				12	50/2	SPARE WELDING OUTLET - FAB SHOP	
SPACE W/ BUSSING		13							14			
SPACE W/ BUSSING		15							16	50/2	SPARE WELDING OUTLET - FAB SHOP	
SPACE W/ BUSSING		17							18			
GRINDER STATION	30/2	19							20	50/2	SPARE WELDING OUTLET - FAB SHOP	
		21							22			
CHOP SAW FAB SHOP	20/1	23			1.80			5.82	24	70/2	CURING OVEN - FAB SHOP	
GRINDER FAB SHOP	20/1	25	0.72			5.82			26			
RECPTS FAB SHOP CONVENIENCE	20/1	27		0.60					28	20/1	SPACE W/ BUSSING	
RECPTS FAB SHOP CONVENIENCE	20/1	29			0.40				30	20/1	SPACE W/ BUSSING	
RECPTS FAB SHOP CONVENIENCE	20/1	31	0.60						32	20/1	SPACE W/ BUSSING	
RECPTS FAB SHOP CONVENIENCE	20/1	33		0.40					34	20/1	SPACE W/ BUSSING	
DRY-PIPE SPRINKLER SYSTEM AIR COMPRESSOR	20/3	35			0.54				36	20/1	SPACE W/ BUSSING	
		37	0.54						38	20/1	SPACE W/ BUSSING	
		39		0.54					40	20/1	SPACE W/ BUSSING	
SPACE W/ BUSSING		41							42	20/1	SPACE W/ BUSSING	
			5.58	5.26	6.46	5.82	3.27	9.09				
			11.4	8.53	15.55	TOTALS						

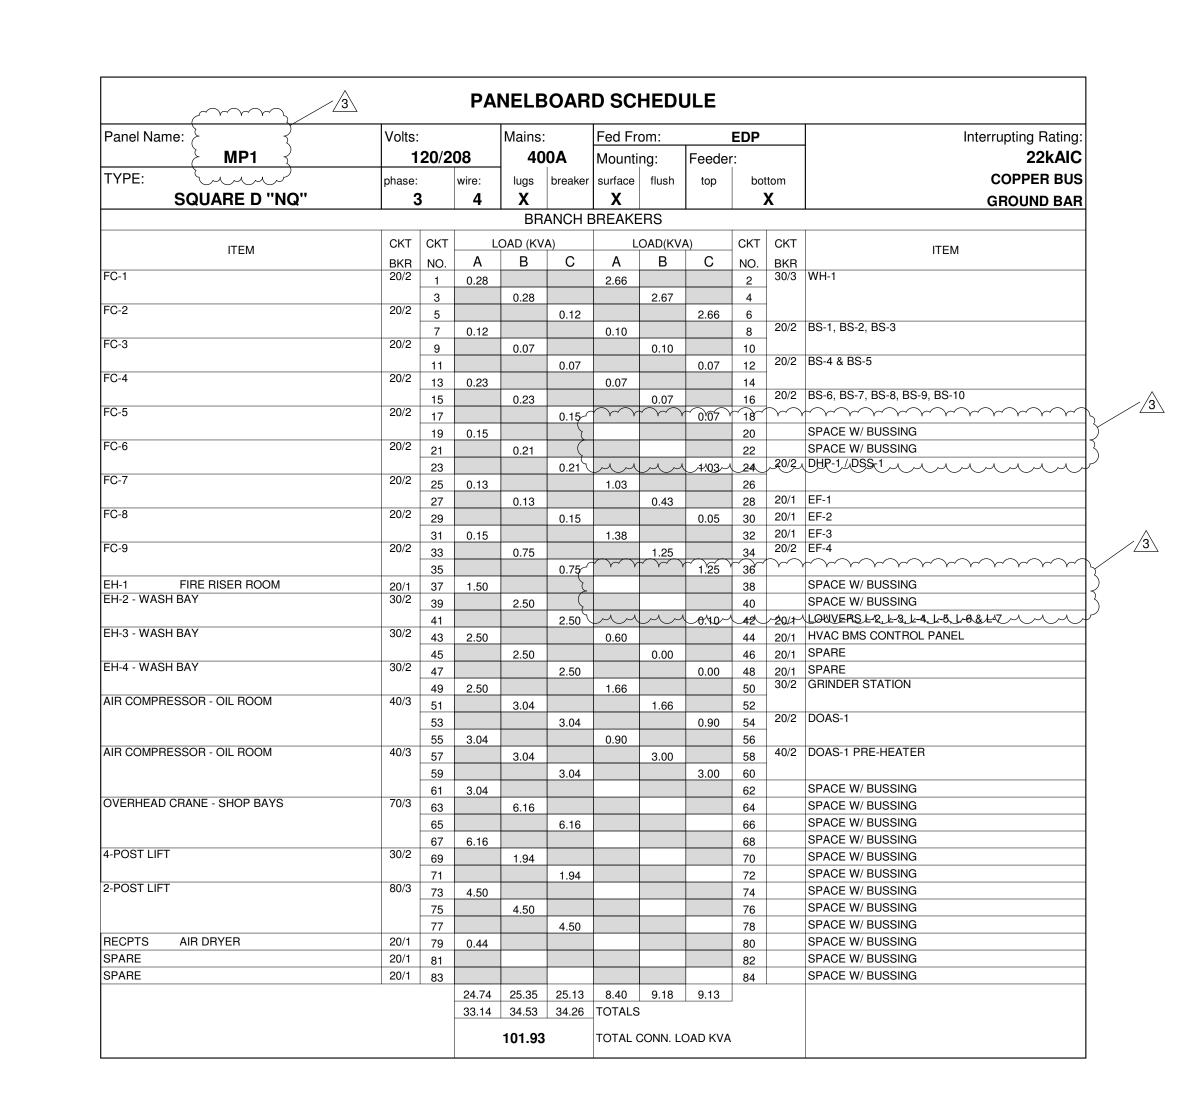



TRIC

AD

ADDITION

수

CRAIGHEAL
MAINTENANCE

CHEDULI

S ANE Δ AL TRIC,


#1 #2 Bid, ADD ADD Post B EVISIONS

JOB. NO. 02.14.2025

E601

Batson Inc.
ENGINEERING SOLUTIONS

F101

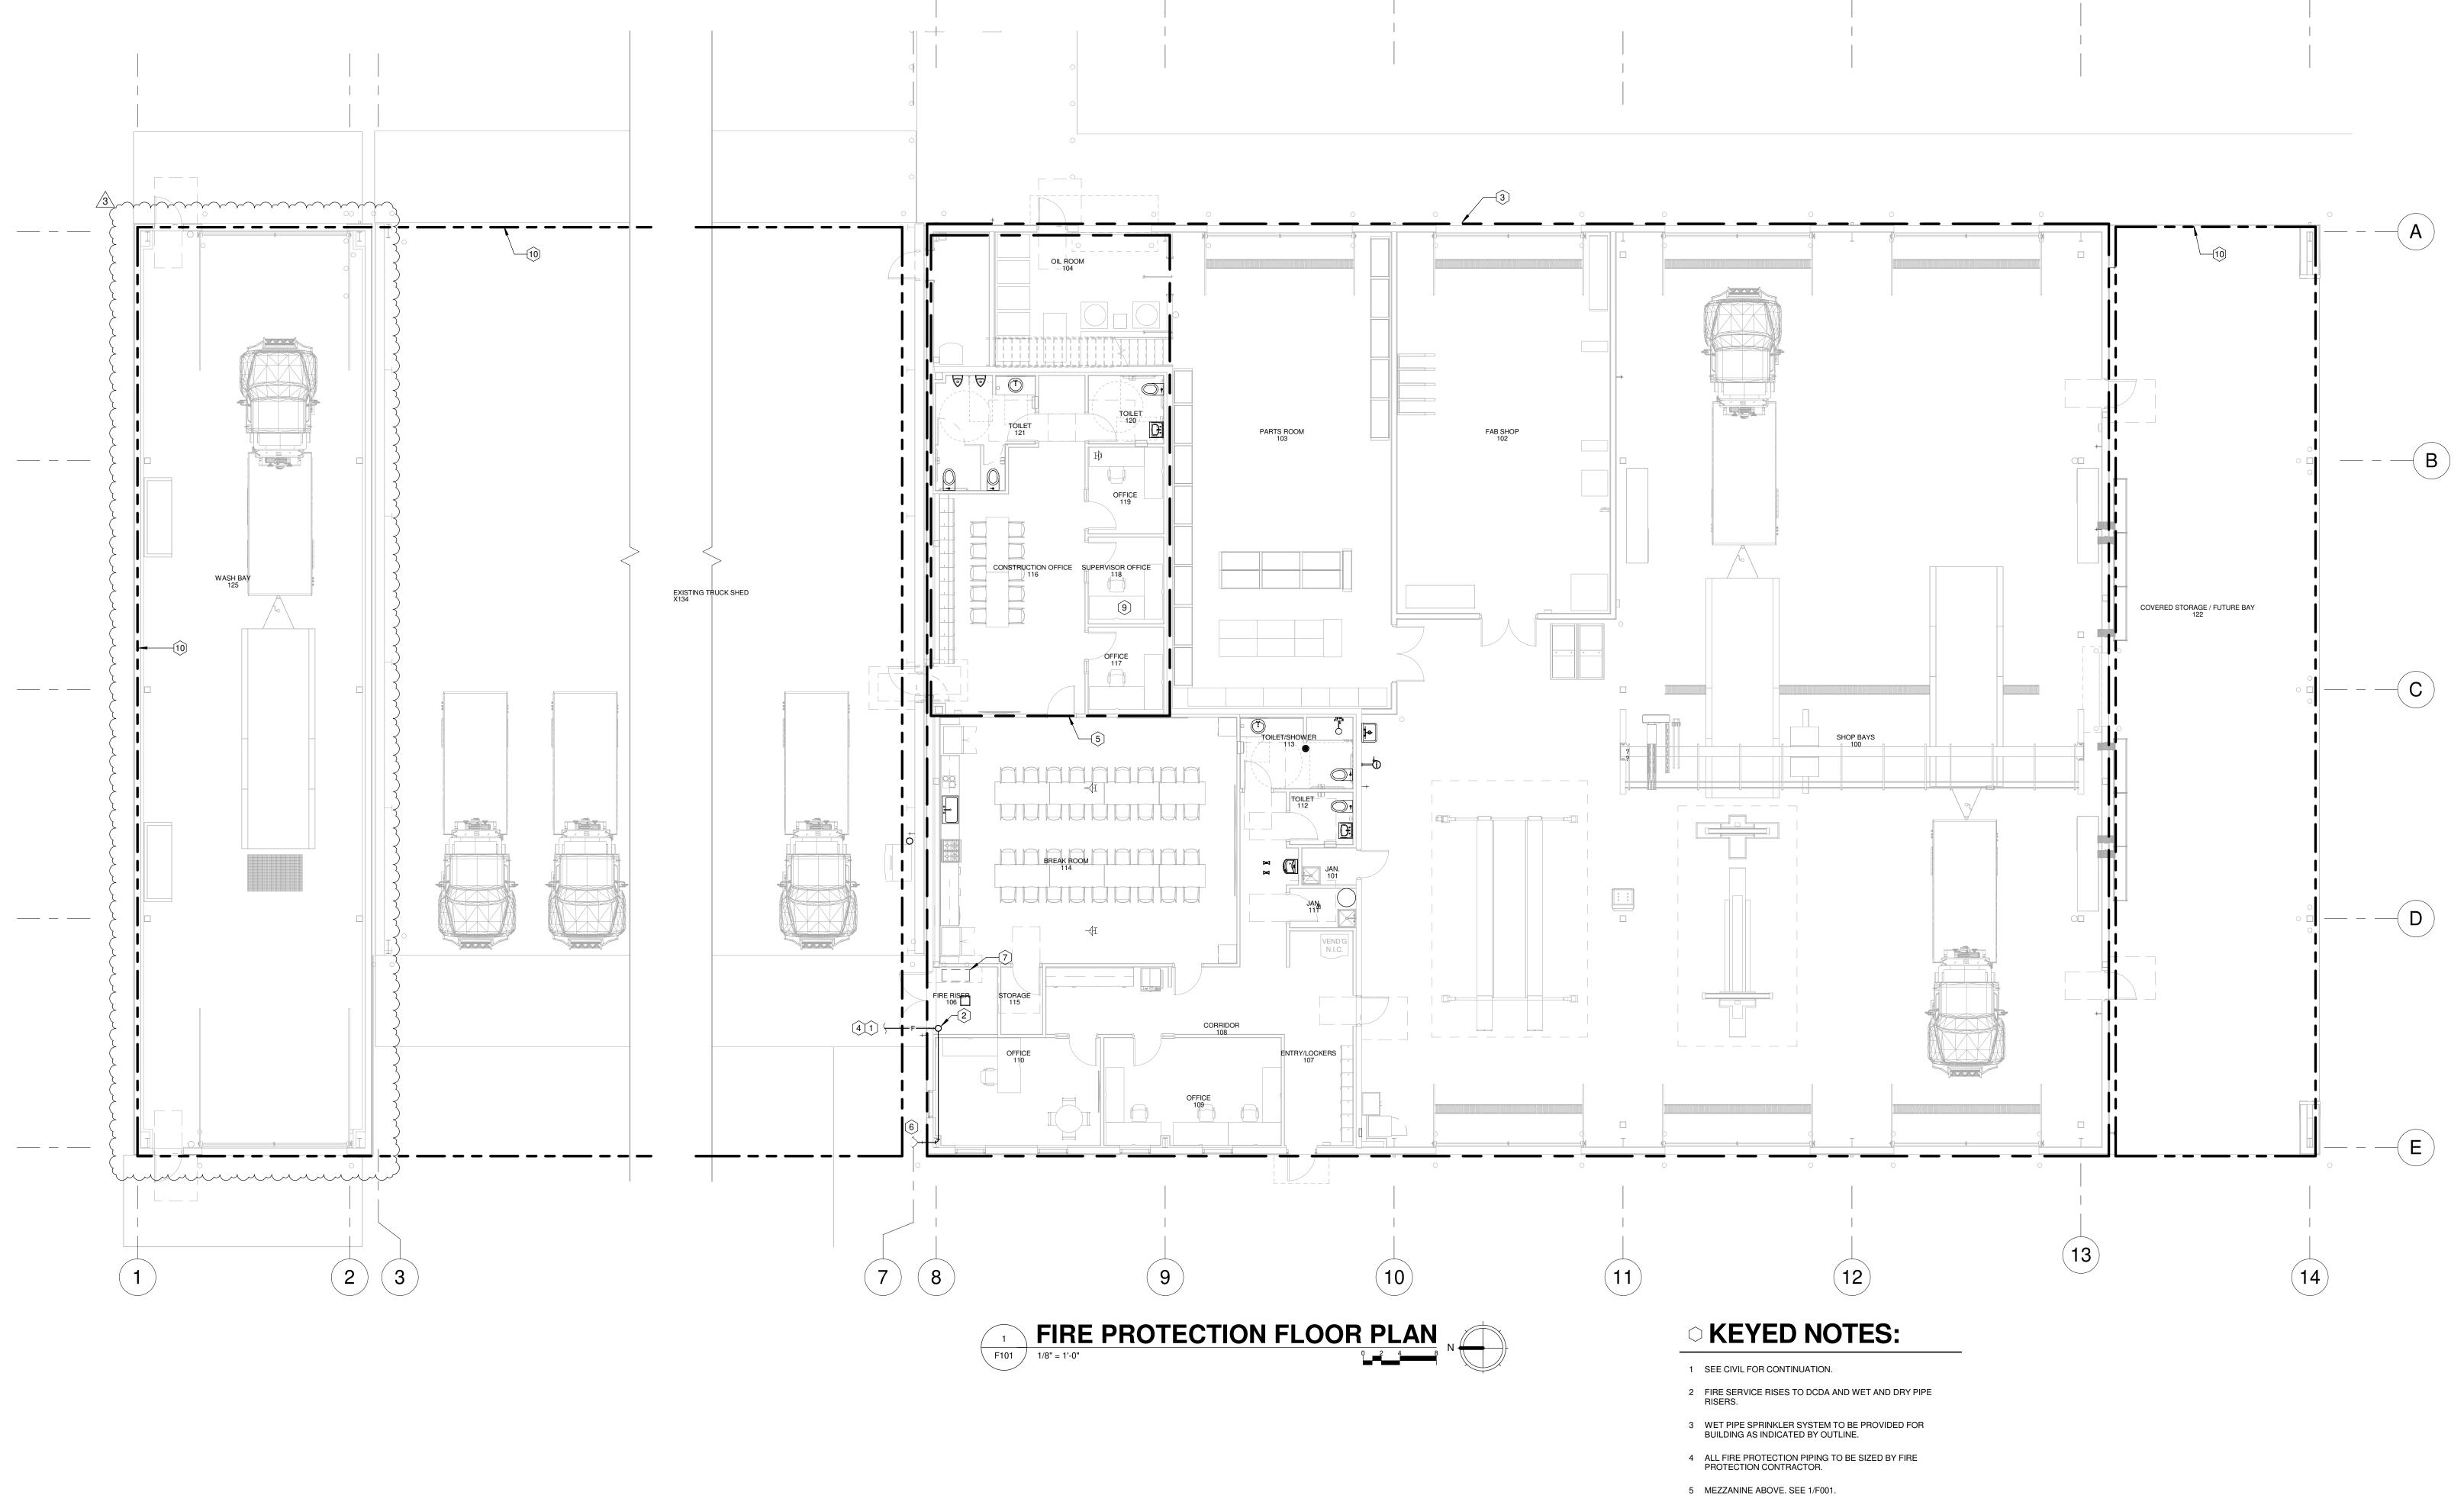

6 FIRE DEPARTMENT SIAMESE CONNECTION. COORDINATE EXACT LOCATION WITH FIELD VERIFIED FIRE HYDRANT LOCATION, SEE CIVIL PLANS FOR EXACT LOCATION. PROVIDE 'FDC' SIGN ABOVE WITH MINIMUM 4" RED LETTERS.

7 DOMESTIC WATER BACKFLOW PREVENTER. COORDINATE WITH PLUMBING.

8 NOT USED

9 BELOW MEZZANINE, SPRINKLER MAINS TO ROUTE OVER LOWER CEILINGS OF OFFICES. BRANCH LINES TO RISE AND ROUTE BETWEEN BEAMS SUPPORTING MEZZANINE.

 $\sqrt{3}$

10 AREA INDICATED BY OUTLINE PROTECTED BY DRY PIPE
SPRINKLER SYSTEM. PROTECTED AREAS TO INCLUDE
COVERED STORAGE/FUTURE BAY122, EXISTING TRUCK SHED 134 AND WASH BAY 125.

ENGINEER

NO. 9419

Batson Inc.

1300 Brookwood Drive Little Rock Arkansas 72202 501-664-3311 www.batson.com