ADDENDUM NO. 1
PUBLIC WORKS ADDITIONS
CITY OF PARAGOULD
PARAGOULD, ARKANSAS
Project No. 23044

September 5, 2024

Lewis, Elliott, McMorran, Vaden,
Ragsdale & Woodward, Inc.
11225 Huron Lane, Suite 104
Little Rock, AR 72211
Telephone: (501) 223-9302

The proposed Contract Documents, dated August 16, 2024, have been modified as follows:

Pertaining to the Specifications:

ALL APPROVED SUBSTITUTION REQUESTS SHALL BE HELD TO THE SPECIFICATIONS AS WRITTEN SPECIFICALLY FOR THIS PROJECT.

Item #1: Section 08 71 00 – Door Hardware (Revised): Attached with hardware sets.

Pertaining to the Drawings:

Item #2: Sheet AD1.1 (attached): Sill detail shown for all new sectional doors with the intent to direct water away from the interior of the building.

Item #3: Sheet A1.0, detail 1, Demolition Plan – Building A: Add note to demolish slab of existing pit as required for install of new concrete slab.

Item #4: Sheet A2.1, detail 1, Building B – Floor Plan: Lobby 108 should be in the space to the east of Reception 201 (between grids B3 and B6). See Life Safety Plan for location of Lobby 108. Door 203.2 shall swing out.

Item #5: Sheet A2.1, detail 2, Building A, Clarification: Mechanical platform is intended to be above Cust. 104, TLT 103, and TLT 102. See 3/S4.1.

Item #6: Sheet A3.1, Building A (existing) Elevations, Clarifications: Intent is to remove existing metal wall panels on the south, east, and west sides of Building A, and reinstall new concealed fastener metal wall panels (MTL-2) in place of the removed panels.

Item #7: Sheet A4.1, Revised 2024 09-05 (attached): Revised to better show accurate and applicable wall section cut marks.

Item #8: Sheet A8.1, Door Schedule: Door 104.1 shall be 3’-0” in width.

Item #9: Sheet A9.1, Material Key: At Ceiling Category, EXP-1 should read ‘Exposed Structure-Paint’. Intent at Building C, Building D, and Tools 105 is for all exposed structure (PEMB frames, girts, purlins, etc) to be painted.

Item #10: Sheet S2.1, Foundation Plan – Building B: Floor Drain shown in corridor should be located in Women's restroom as shown on Plumbing drawings.

Item #11: Sheets E1.0 and E7.1– Electrical Site Plan and Lighting Schedule (Revised 2024 09-05): Attached.

END OF ADDENDUM NO. 1

Section 08 71 00

DOOR HARDWARE

PART ONE - GENERAL

1.1 DESCRIPTION

1.1.1 Work included: Furnish and deliver to the job site all finish hardware required to complete the Work as indicated on the Drawings and specified herein. Provide all trim attachments, and fastenings specified or required for proper complete installation.

1.2 QUALITY ASSURANCE

1.2.1 Qualifications of manufacturers: Products used in the work of this Section shall be produced by manufacturers regularly engaged in manufacture of similar items and with a history of successful production acceptable to the Architect.

1.2.2 Fire rated openings: Comply with the requirements of Underwriters' Laboratories, Inc.

1.2.3 Supplier Qualifications: A recognized architectural door finish hardware supplier, with warehouse facilities in the project's vicinity and that employs an Architectural Hardware Consultant (AHC).

1.3 SUBMITTALS

1.3.1 General: Comply with the provisions of Section 01 33 23.

1.3.2 Product data: If proposed products are other than as specified, within 35 calendar days after award of the Contract, submit:

A. Complete materials list of all items proposed to be furnished and delivered under this Section.

1. Identify each hardware item by manufacturer, the manufacturer's catalog number, and the location of the item in the Work.
2. Submit a detailed, vertical type hardware schedule conforming to DHI format organized into "hardware sets".

B. Manufacturer's specifications, catalog cuts, and other data required to demonstrate compliance with specified hardware.

Approval of the hardware list by the Architect shall not relieve the Contractor from the responsibility for furnishing all required finish hardware.

1.3.3 Templates: In a timely manner to ensure orderly progress of the Work, deliver templates or physical samples of the approved finish hardware items to pertinent manufacturers of interfacing items such as doors and frames.

1.4 PRODUCT HANDLING

1.4.1 Packing and marking: Individually package each unit of finish hardware, complete with proper fastenings and appurtenances, clearly marked on the outside to indicate the contents and specific location in the Work.

1.4.2 Protection: Use all means necessary to protect materials of this Section before, during and after delivery to the job site and to protect the Work and materials of all other trades.

1.4.3 Replacements: In the event of damage, immediately make all repairs and replacements necessary to the approval of the Architect and at no additional cost to the Owner.

PART TWO - PRODUCTS

2.1 SUBSTITUTIONS

2.1.1 Hinges: McKinney as specified, Stanley or Ives equal. No other substitutions.

2.1.2 Locksets and Cylinders: Sargent as specified, Schlage, or Best equal. No other substitutions.

2.1.3 Exit Devices: Sargent as specified, Von Duprin or Best equal. No other substitutions.

2.1.4 Closers: Sargent as specified, LCN or Stanley equal. No other substitutions.

2.1.5 Fasteners:

2.1.5.1 Furnish all finish hardware with all necessary screws, bolts, and other fasteners of suitable size and type to anchor the hardware in position for long life under hard use.

2.1.5.2 Furnish fastenings where necessary with expansion shields, toggle bolts, hex bolts, and other anchors approved by the Architect, according to the material to which the hardware is to be applied and the recommendations of the hardware manufacturer.

2.1.5.3 All fastenings shall harmonize with the hardware as to material and finish.

2.1.6 Finishes of all hardware shall match the finish of the locksets. Take special care to coordinate all the various manufactured items furnished under this Section, to ensure acceptably uniform finish.

2.2 MISCELLANEOUS

2.2.1 All hardware meets criteria for Handicap Accessibility Requirements of ADA.

2.2.2 All other items, not specifically described but required for a complete and proper installation of finish hardware, shall be as selected by the Contractor subject to the approval of the Architect.

2.3 KEYING

All locksets shall be keyed to a new Master Key System. All locksets shall be keyed alike in groups or keyed different as directed. Furnish six Master Keys. Furnish four keys for each keyed alike set and two keys for each keyed different lockset. Stamp key bows with key set symbol. BEFORE ORDERING, CONFIRM IF OWNER HAS EXISTING KEY SYSTEM.

It will be the responsibility of the hardware supplier to call or meet with the Owner to obtain keying requirements for this project.

2.4 MANUFACTURERS INDEX

Mc – McKinney Mfg. Co.	R – Rockwood Mfg. Co.
F – Folger Adam	H – HES
N – Norton	P – Pemko Products
S – Sargent Lock Co	ST – Stanley Hardware

2.5 HARDWARE GROUPS

The following is a general listing of the minimum hardware requirements. Any item of hardware normally required by good practice as to meet state or local codes shall be furnished even though it may not be specifically mentioned.

HW-1 – Each door (ALUM Exterior Door) to have:

Mc	3	Hinges	TA2714 4.5 x 4.5 US26D NRP
S	1	Exit Device	8804 PSB US32D
H	1	Electric Strike	9600 US32D
S	1	Door Closer	EN281-CPS
R	1	Kick Plate	K3125 10” x DW-2 US32D
P	1	Threshold	170 A x Opening Width
P	1	Door Bottom	315 CN x Door Width
P	1	Weatherstrip	303AV W x H
P	1	Drip Cap	346D x DW + 4”

HW-2 – Each door to have: (Exterior Steel Door with Exit Device and Access Control)

Mc	3	Hinges	TA2714 4.5 x 4.5 US26D NRP
S	1	Exit Device	8804 PSB US32D
H	1	Electric Strike	9600 US32D
S	1	Door Closer	EN281-CPS
R	1	Kick Plate	K3125 10” x DW-2 US32D
P	1	Threshold	170 A x Opening Width
P	1	Door Bottom	315 CN x Door Width
P	1	Weatherstrip	303AV W x H
P	1	Drip Cap	346D x DW + 4”

HW-3 – Each door (Exterior Office Steel Door) to have:

Mc	3	Hinges	TA2714 4.5 x 4.5 US26D NRP
S	1	Exit Device	8804 PSB US32D
H	1	Electric Strike	9600 US32D
S	1	Door Closer	EN281-CPS
R	1	Kick Plate	K3125 10" x DW-2 US32D
P	1	Threshold	170 A x Opening Width
P	1	Door Bottom	315 CN x Door Width
P	1	Weatherstrip	303AV W x H
P	1	Drip Cap	346D x DW + 4"

HW-4 – Each door to have:

Mc	3	Hinges	TA2714 4.5 x 4.5 US26D NRP
S	1	Exit Device	8804 PSB US32D
H	1	Electric Strike	9600 US32D
S	1	Door Closer	EN281-CPS
R	1	Kick Plate	K3125 10" x DW-2 US32D
P	1	Threshold	170 A x Opening Width
P	1	Door Bottom	315 CN x Door Width
P	1	Weatherstrip	303AV W x H
P	1	Drip Cap	346D x DW + 4"

Note: Door hardware is for future access control capabilities.

HW-5 – Each door to have:

Mc	3	Hinges	TA2714 4.5 x 4.5 US26D
S	1	Lockset	28-10G04 LL US26D
H	1	Electric Strike	8000C US32D
S	1	Closer	EN1431-UO x TB
R	1	Wall Stop	409 US32D
R	3	Silencers	608

HW-6 – each door to have:

Mc	3	Hinges	TA2714 4.5 x 4.5 US26D
S	1	Lockset	28-10G05 LL US26D
R	1	Wall Stop	409 US32D
R	3	Silencers	608

HW-7 – each door (Interior Wood door) to have:

Mc	3	Hinges	TA2714 4.5 x 4.5 US26D NRP
S	1	Exit Device	8804 PSB US32D
H	1	Electric Strike	9600 US32D
S	1	Door Closer	EN281-CPS
R	1	Kick Plate	K3125 10” x DW-2 US32D

HW-8 – Each door to have:

Mc	3	Hinges	TA2714 4.5 x 4.5 US26D
S	1	Privacy Set	28-10U65 LL US26D
S	1	Closer	EN1431-UO x TB
R	1	Wall Stop	409 US32D
R	3	Silencers	608

HW-9 – each door (Interior Wood door) to have:

Mc	3	Hinges	TA2714 4.5 x 4.5 US26D
R	1	Push Plate	70C US32D
R	1	Pull Plate	70C x 107 US32D
R	1	Kick Plate	K1050 10 x DW-2” US32D
S	1	Closer	EN1431-UO x TB
R	1	Wall Stop	409 US32D
R	3	Silencers	608

PART THREE – EXECUTION

Not Used.

END OF SECTION

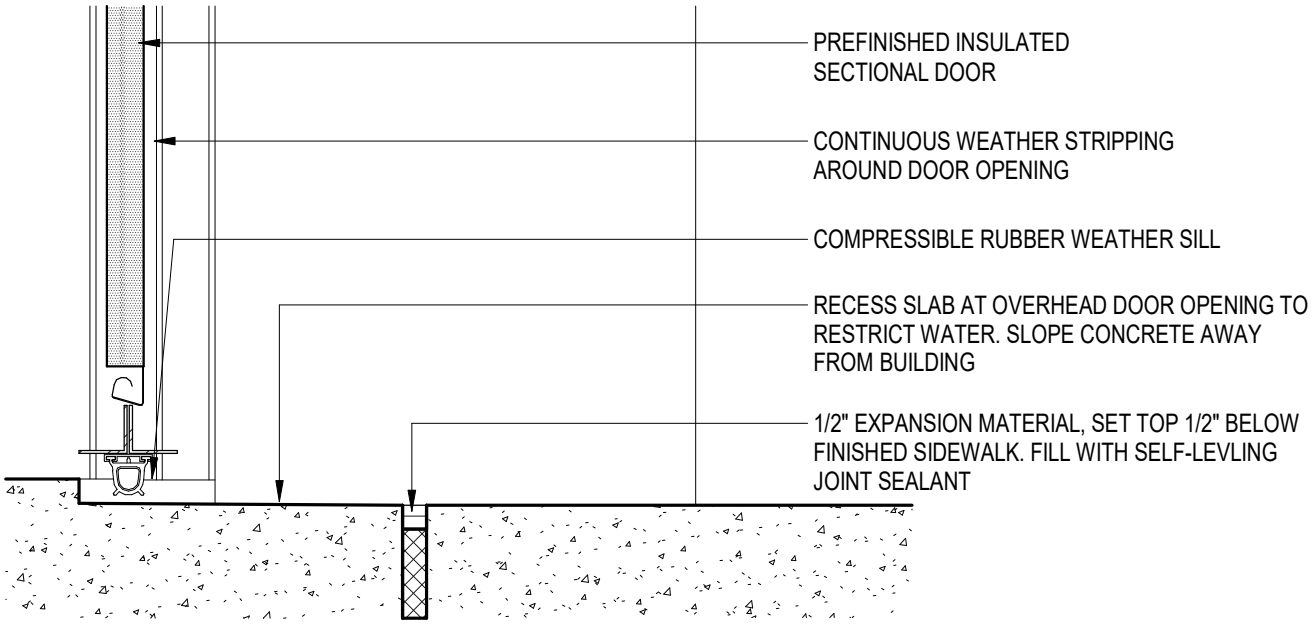

1
AD1.1

INSULATED DOOR - SILL

3" = 1'-0"

PUBLIC WORKS ADDITIONS

CITY OF PARAGOULD
PARAGOULD, AR

LEWIS ARCHITECTS ENGINEERS
ELLIOTT • MCMORRAN • VADEN
RAGSDALE • WOODWARD • INCORPORATED
501 223 9302 • WWW.LEMVRW.COM

JOB NO:	DATE:	SCALE:	DRAWING NO:
23044		AS SHOWN	AD1.1

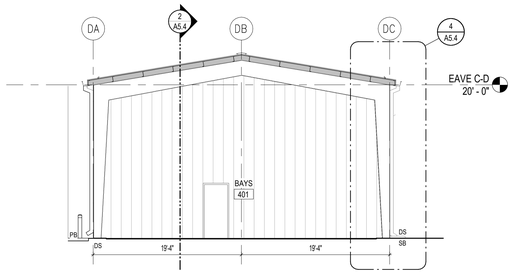

7 A4.1 SECTION BUILDING D
1/8" = 1'-0"

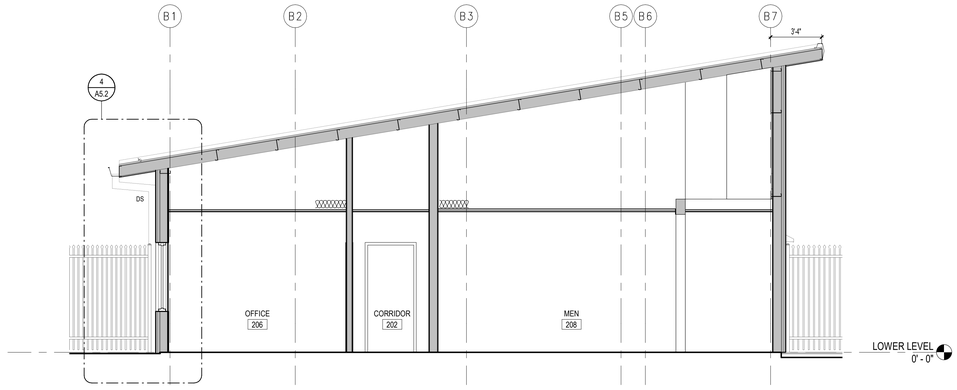

6 A4.1 SECTION BUILDING B
1/4" = 1'-0"

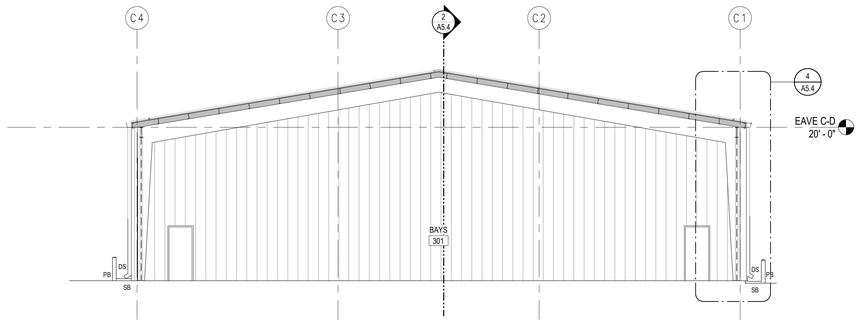

5 A4.1 SECTION BUILDING C
1/8" = 1'-0"

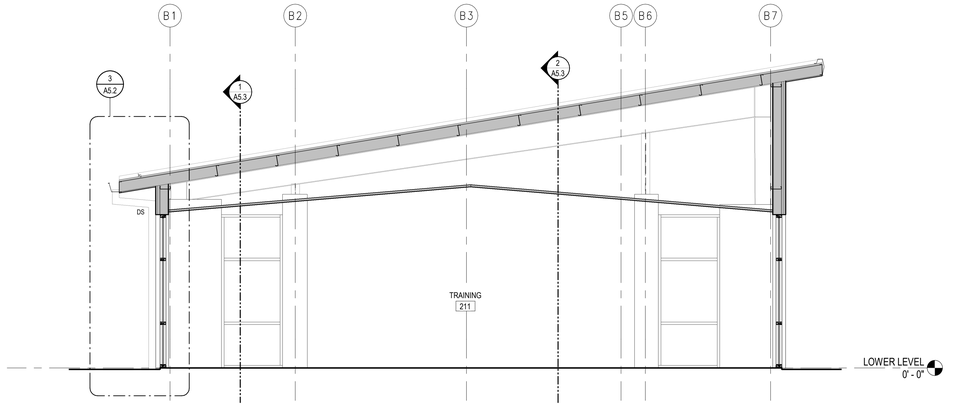

4 A4.1 SECTION BUILDING B
1/4" = 1'-0"

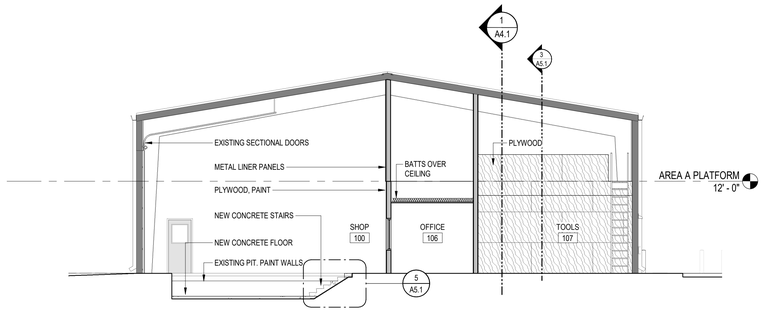

3 A4.1 SECTION BUILDING A
1/8" = 1'-0"

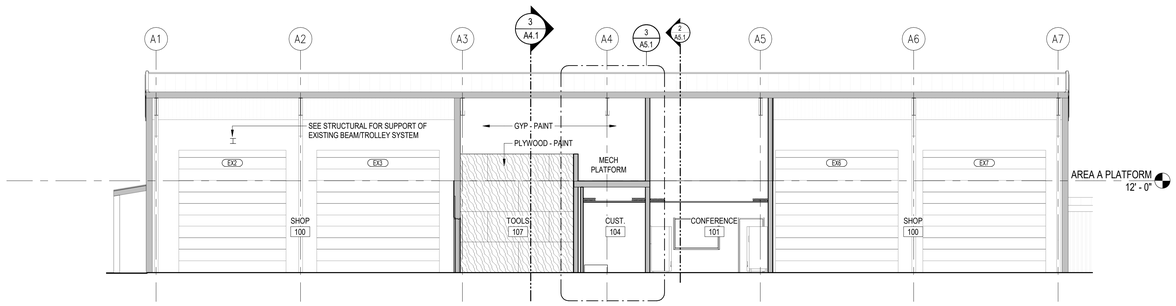

1 A4.1 SECTION BUILDING A
1/8" = 1'-0"

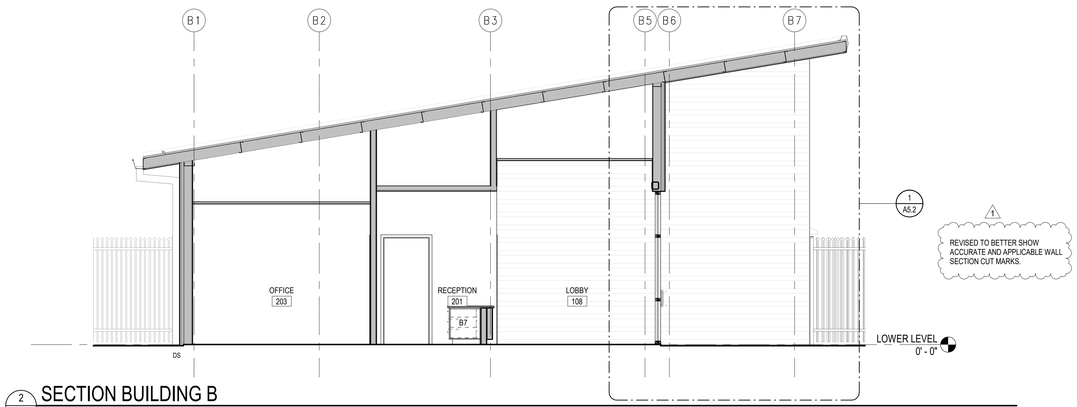

2 A4.1 SECTION BUILDING B
1/4" = 1'-0"

LEWIS ARCHITECTS ENGINEERS
ELLIOTT • MCMORRAN • VADEN
RAGSDALE • WOODWARD • INCORPORATED
501 223 9302 • WWW.LEMVRW.COM

BUILDING SECTIONS

PUBLIC WORKS ADDITIONS
CITY OF PARAGOULD
PARAGOULD, AR

DATE: 2024 08-16
PROJECT NO: 23044
DRAWN BY: R.P
REV: 1 01-01-2021

A4.1

SITE ELECTRICAL LEGEND

Symbol	Description
EOHE	EXISTING OVERHEAD ELECTRICAL
EUGE	EXISTING UNDERGROUND ELECTRICAL
EUT	EXISTING UNDERGROUND TELEPHONE
EUTV	EXISTING UNDERGROUND CABLE (TELEVISION)
EUFO	EXISTING UNDERGROUND FIBER OPTIC
EUC	EXISTING UNDERGROUND SYSTEMS CONDUIT
OHE	OVERHEAD ELECTRICAL
UGE	UNDERGROUND ELECTRICAL
UT	UNDERGROUND TELEPHONE
UTV	UNDERGROUND CABLE (TELEVISION)
UFO	UNDERGROUND FIBER OPTIC
UC	UNDERGROUND SYSTEMS CONDUIT
-X-	INDICATES UTILITY TO BE REMOVED
(P) - (S)	(P-INDICATES PRIMARY; S-INDICATES SECONDARY)
J	JUNCTION BOX - CONNECT TO EQUIPMENT AS REQUIRED
	DISCONNECT SWITCH - w/GROUNDING LUG, SIZE AS NOTED
	FUSIBLE DISCONNECT SWITCH-w/GROUND LUG, SIZE AS NOTED
	MOTOR - SIZE AS NOTED ON PLANS
	SURFACE MOUNTED PANEL BOARD
	WIRE AND CONDUIT - AS NOTED
	HOMERUN TO PANEL-ARROWS INDICATE NUMBER OF CIRCUITS.
	WEATHERHEAD - SIZE AS NOTED ON PLANS
	POWER POLE
T	TELEPHONE PEDESTAL

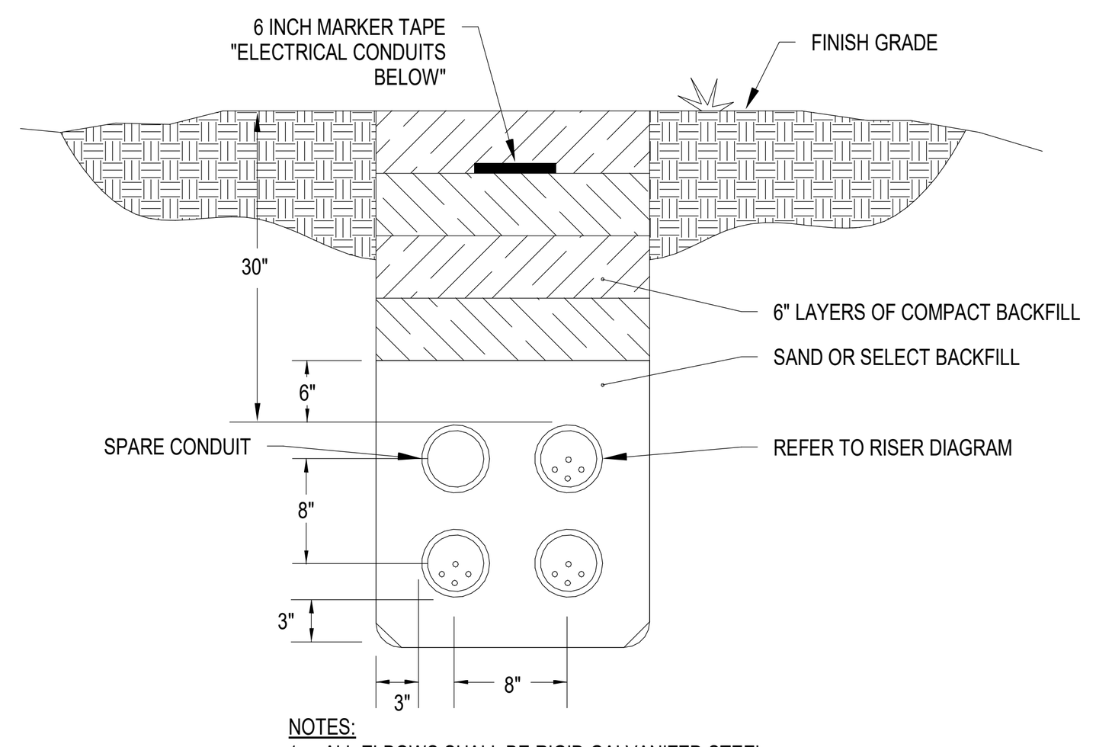

NOTES:
1. ALL ELBOWS SHALL BE RIGID GALVANIZED STEEL.
2. ALL EXPOSED CONDUITS ABOVE GRADE SHALL BE RIGID GALVANIZED STEEL.

4 E1.0 POWER TRENCH DETAIL
NOT TO SCALE

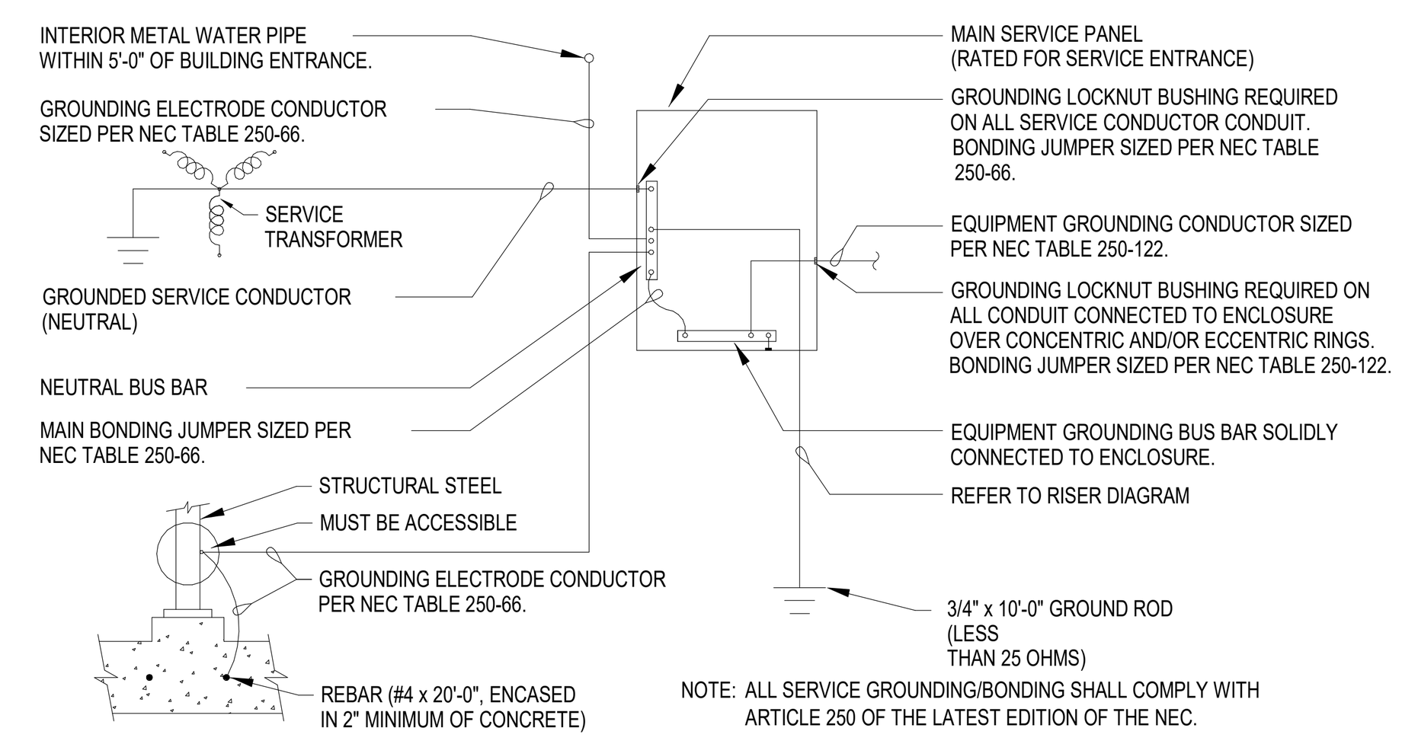

NOTE: ALL SERVICE GROUNDING/BONDING SHALL COMPLY WITH ARTICLE 250 OF THE LATEST EDITION OF THE NEC.

3 E1.0 POWER SERVICE GROUND
NOT TO SCALE

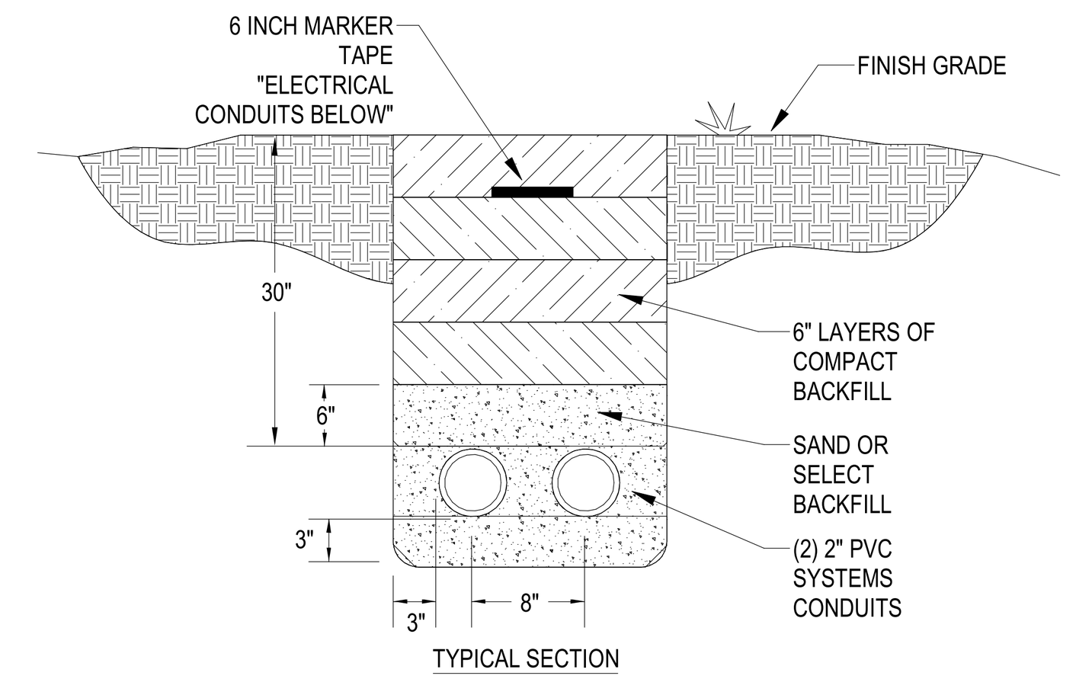

NOTES:
1. ALL ELBOWS SHALL BE RIGID GALVANIZED STEEL.
2. ALL EXPOSED CONDUITS ABOVE GRADE SHALL BE RIGID GALVANIZED STEEL.
3. SYSTEMS CONDUITS SHALL BE KEPT AT LEAST 12" AWAY FROM POWER CONDUITS.
4. VERIFY REQUIREMENTS WITH UTILITY PRIOR TO BEGINNING WORK.

6 E1.0 SYSTEMS TRENCH DETAIL
NOT TO SCALE

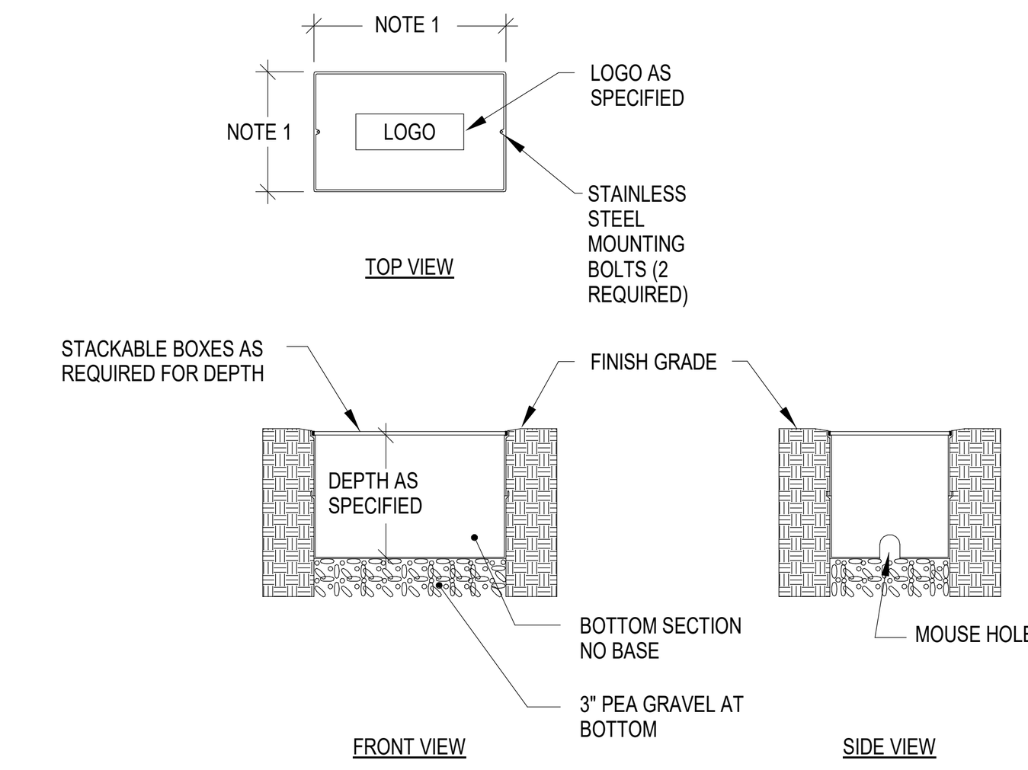

NOTES:
1. DIMENSIONS AS SPECIFIED, MINIMUM 24" x 36".
2. BOXES EQUIVALENT TO QUAZITE. COVER RATED LIGHT TRAFFIC (TIER15).

5 E1.0 QUAZITE BOX
NOT TO SCALE

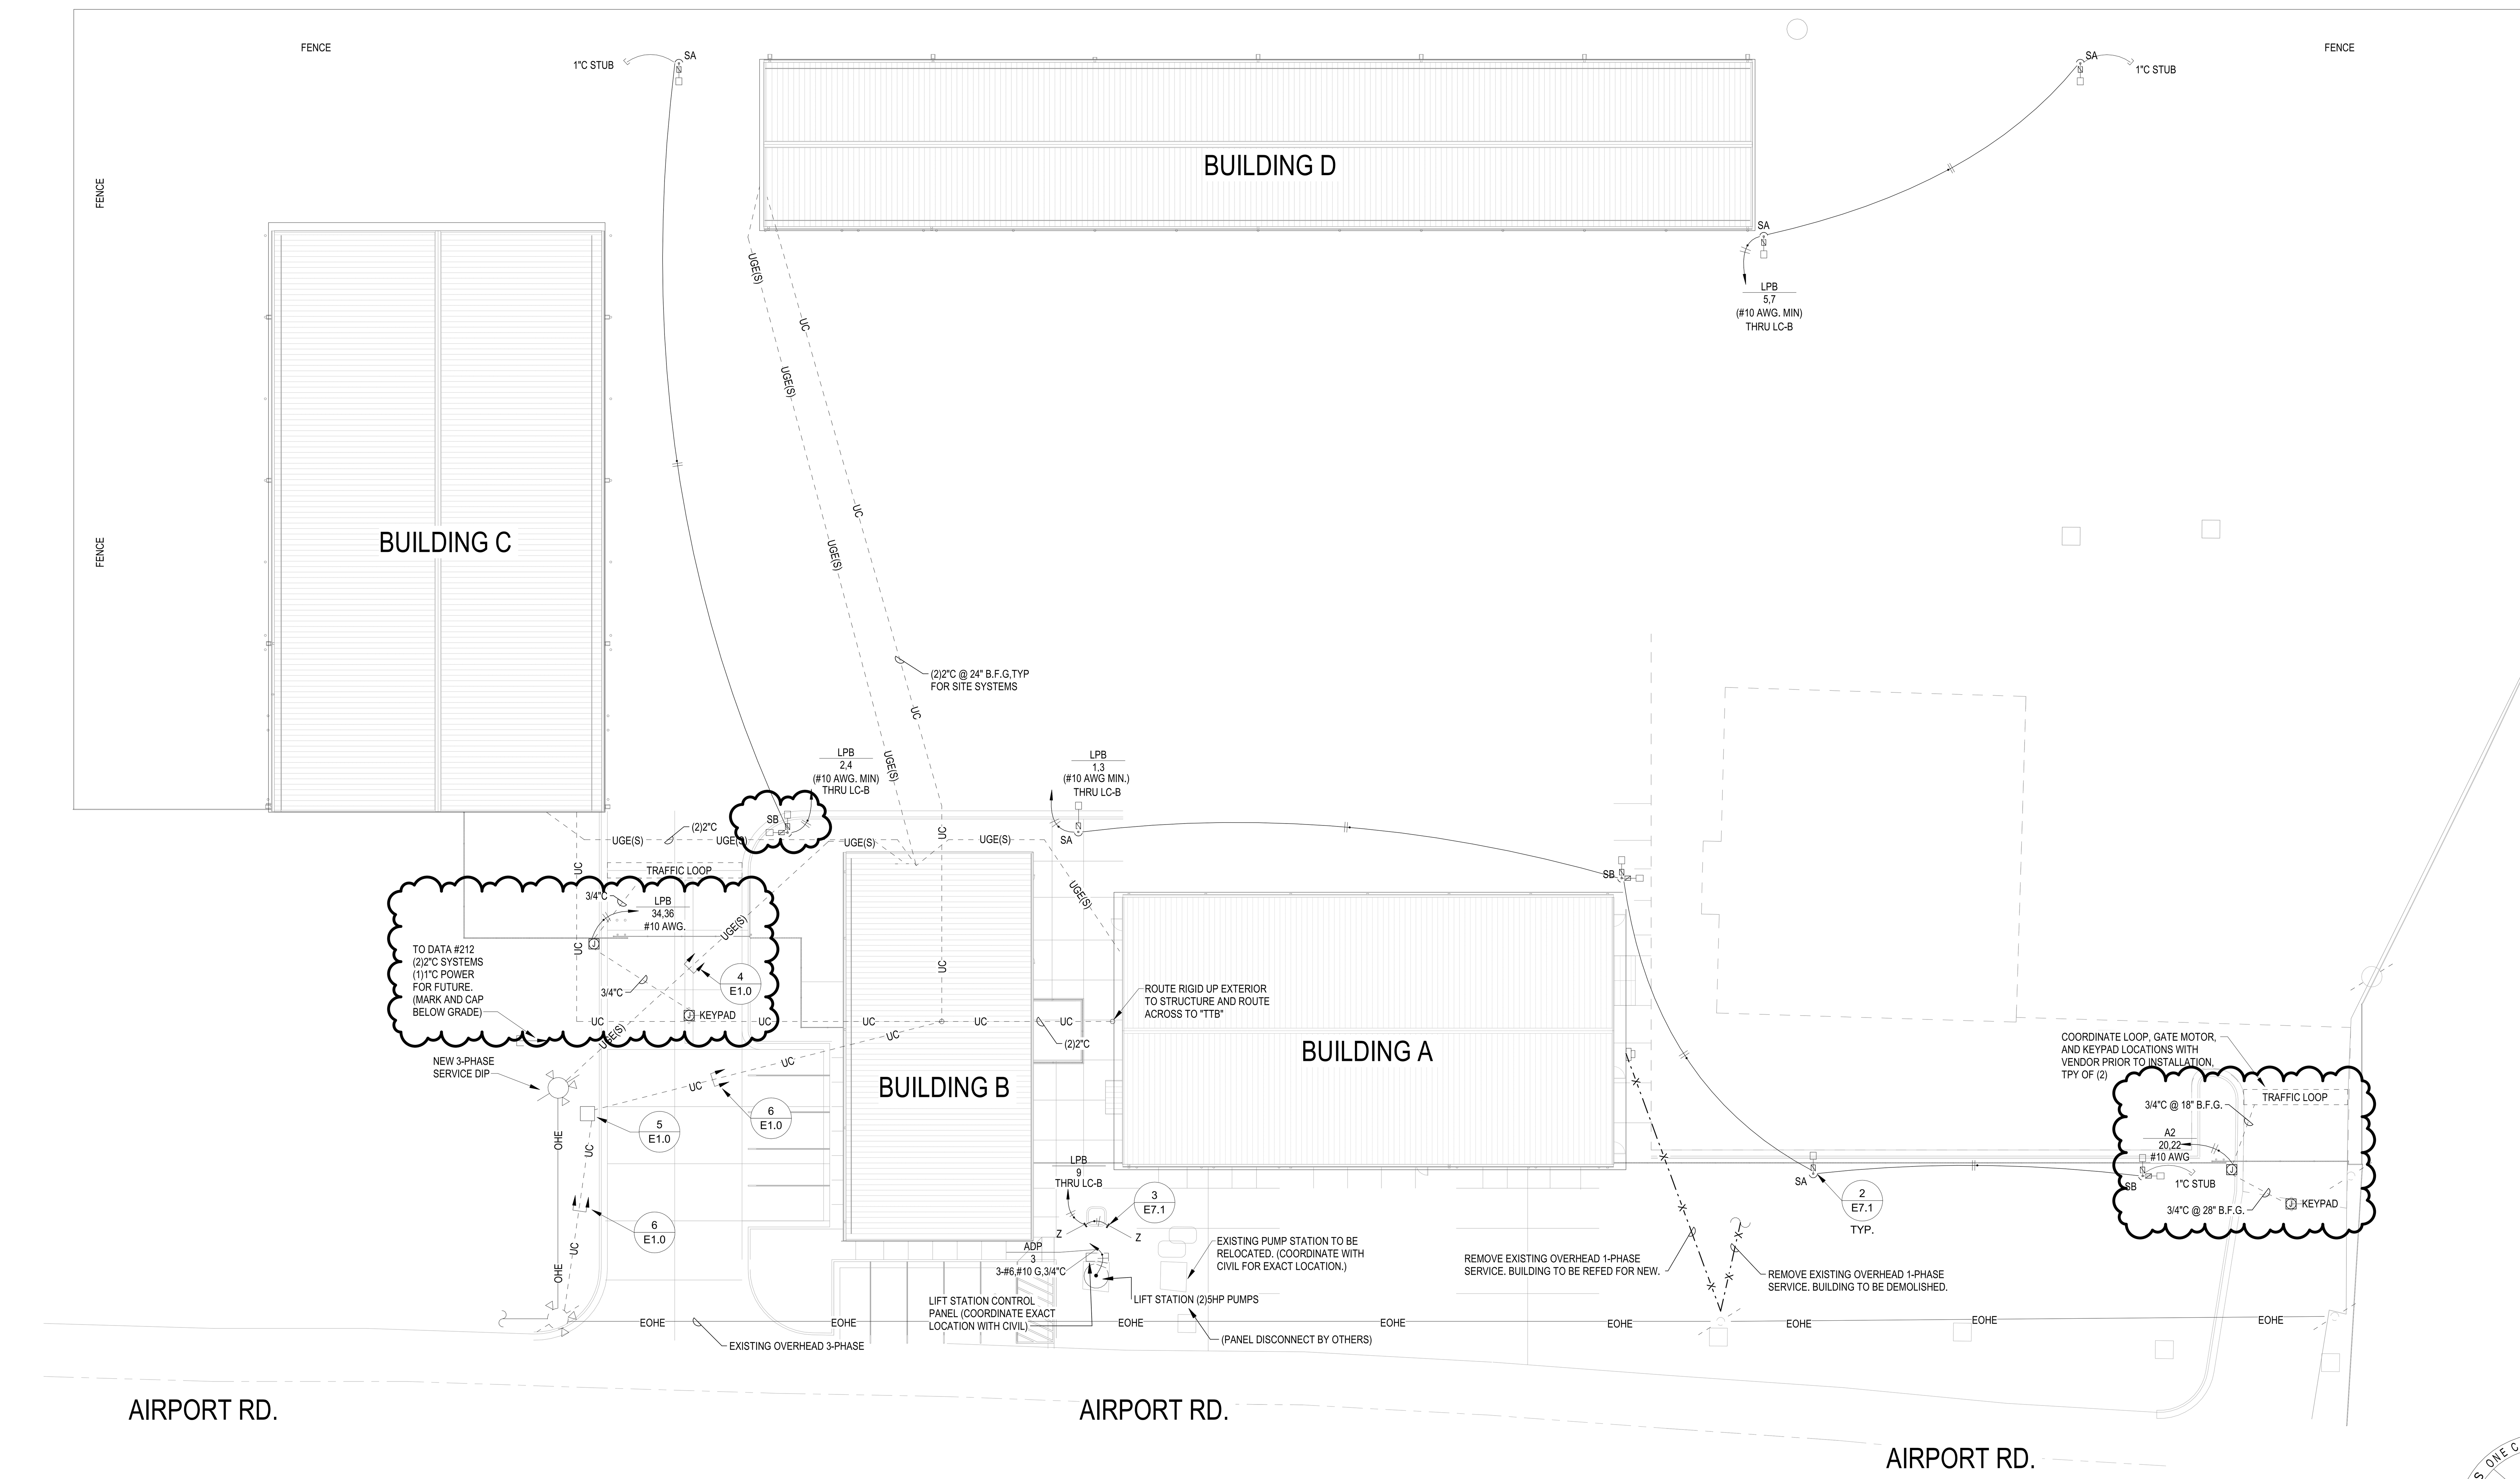

NORTH

1 E1.0 SITE PLAN - ELECTRICAL
1" = 20'-0"

ARKANSAS ONE CALL SYSTEM, INC. 811 STOP-CALL BEFORE YOU DIG!

CAUTION !!!

CONTRACTOR MUST HAVE ONE CALL LOCATE AND MARK ALL EXISTING UTILITIES PRIOR TO TRENCHING OR BORING. ELECTRIC CONTRACTOR MUST LOCATE AND MARK ALL EXISTING CONDUITS AND PIPES OWNED BY PROPERTY OWNER PRIOR TO TRENCHING OR BORING.

ELLIOTT • MCMORRAN • VADEN
RAGSDALE • WOODWARD • INCORPORATED
501 223 9302 • WWW LEMVRW COM
LEWIS ARCHITECTS ENGINEERS

SITE PLAN - ELECTRICAL

PUBLIC WORKS ADDITION
CITY OF PARAGOULD
PARAGOULD, ARKANSAS

CERTIFICATE OF AUTHORIZATION LEWIS ARCHITECTS ENGINEERS No. 186 ARKANSAS ENGINEERS

STATE OF ARKANSAS REGISTERED PROFESSIONAL ENGINEER NO. 11659 SCOTT P. WOODWARD

DATE:	2024 08-16
PROJECT NO:	23044
DRAWN BY:	SW/CH
REVISION: 2	Date 2

ELECTRICAL GENERAL NOTES

1. DUE TO THE SMALL SCALE OF THE PLANS AND THE DIAGRAMMATIC NATURE OF ELECTRICAL PLANS IN GENERAL IT IS NOT POSSIBLE TO INDICATE ALL OFFSETS, FITTINGS, JUNCTION BOXES, ETC. WHICH MAY BE REQUIRED. THE CONTRACTOR SHALL INVESTIGATE THE STRUCTURAL AND FINISH CONDITIONS AFFECTING HIS WORK AND SHALL COORDINATE AND ARRANGE HIS WORK ACCORDINGLY.

2. PROVIDE LAMINATED NAMEPLATES ON ALL ELECTRICAL GEAR PER THE SPECIFICATIONS. SCREW OR POP RIVET TO COVERS. ALL SAFETY SWITCHES SHALL BE HEAVY DUTY, NON-FUSED, 240V OR 600V, SOLID NEUTRAL, NEMA 1 OR NEMA 3R AS APPLIES UNLESS NOTED OTHERWISE.

3. MINIMUM CONDUIT SIZE SHALL BE 3/4" UNLESS NOTED OTHERWISE. SLEEVE ALL RACEWAYS ROUTED THRU FOOTINGS OR GRADE BEAMS. CONTRACTOR SHALL FIRESTOP PER SPECIFICATIONS ALL CONDUIT PENETRATIONS THRU RATED WALLS. VERIFY FIRE RATED WALL LOCATIONS WITH ARCHITECTURAL PLANS. CONTRACTOR SHALL COORDINATE WITH PLUMBING CONTRACTOR AND AVOID ANY WATER CARRYING PIPE INSTALLATION ABOVE ELECTRICAL GEAR AND/OR APPARATUS. SET SCREW AND INDENTER TYPE CONDUIT FITTINGS ARE NOT ALLOWED. ALL INTERIOR EXPOSED RACEWAY SHALL BE PAINTED AS DIRECTED BY ARCHITECT.

4. ALL CONDUIT, JUNCTION AND OUTLET BOXES, AND RELATED ROUGH-IN MATERIAL ARE TO BE CONCEALED UNDER FLOORS, IN WALLS AND ABOVE FINISHED CEILINGS WHERE POSSIBLE UNLESS NOTED OTHERWISE IN THE SPECIFICATIONS OR ON THE DRAWINGS. ALL CONDUITS SHALL BE ROUTED OVERHEAD UNLESS NOTED OTHERWISE OR SHOWN AS BELOW GRADE TO A DEVICE.

5. ALL CONDUCTORS SHALL BE COPPER WITH A MINIMUM SIZE CONDUCTOR OF #12 A.W.G. PROVIDE SOLID TYPE 'THW' OR 'THHN' FOR #12 A.W.G. AND #10 A.W.G. ALL FEEDER AND MOTOR/EQUIPMENT CONDUCTORS SHALL BE COPPER TYPE 'THHN' OR 'THWN'.

6. ALL EQUIPMENT SHALL BE BRACED FOR EARTHQUAKE. LIGHT FIXTURES TO HAVE EARTHQUAKE CLIPS AND INDEPENDENT SUPPORT WIRES AT OPPOSITE CORNERS. ALL CEILING MOUNTED EQUIPMENT SUCH AS LIGHT FIXTURES SHALL BE SECURED TO THE STRUCTURE WITH #12 GA STEEL WIRE ON TWO (2) SIDES. IN ADDITION, LIGHT FIXTURES SHALL BE SECURED TO THE CEILING WITH FACTORY UL LISTED EARTHQUAKE CLIPS.

7. AT LOCATIONS WHERE TRENCHES ARE BELOW BOTTOM OF FOOTING ELEVATION AND WITHIN SIX FEET OF THE EDGE OF THE FOOTING, TRENCHES SHALL BE BACKFILLED IN LIFTS, COMPACTED AND TESTED. REFER TO STRUCTURAL DRAWINGS FOR FOUNDATION NOTES FOR BACKFILL PROCEDURES. PROVIDE PULLSTRINGS FOR ALL CONDUIT STUBS/SLEEVES.

8. PROVIDE A MIN. OF (2) 4"C ON BOTH SIDES OF CORRIDOR PARTITIONS. PROVIDE (2) 3M# PT4RD FIRE-RATED SEALS AT FIRE-RATED PARTITIONS. PROVIDE SPEC-SEAL FIRESTOP PILLOWS IN ALL OTHER SLEEVES AND PENETRATIONS AT FIRE-RATED WALLS.

9. ALL CIRCUITS, LIGHTING AND POWER, SHALL HAVE DEDICATED NEUTRAL CONDUCTORS WITH ONE PER EACH HOT CONDUCTOR-(NO SHARING OF NEUTRALS). ONLY 3 "HOT" CIRCUITS ALLOWED PER HOMERUN - U.N.O.

10. ALL OF THE FOLLOWING RECEPTACLES SHALL BE GFCI TYPE:
    a.) RECEPTACLES FOR ELECTRIC WATER COOLERS
    b.) RECEPTACLES IN BATHROOMS OR WITHIN 6'-0 OF A SINK
    c.) NEMA 5-20R RECEPTACLES FOR A KITCHEN OR CONCESSION AREA.
    d.) EXTERIOR RECEPTACLES SHALL BE GFCI AND WEATHER RESISTANT "WR" TYPE.
    Note: FEED THROUGH PROTECTION OF GFCI OUTLETS ARE NOT ALLOWED.

11. PROVIDE EXTRA HEAVY DUTY HOSPITAL GRADE TYPE RECEPTACLES FOR ALL PATIENT TREATMENT AREAS SUCH AS, BUT NOT LIMITED TO: EXAM, TREATMENT, TRIAGE, SLEEPING, X-RAY AND DIAGNOSTIC OR IMAGING ROOMS.

12. MOUNT EXTERIOR DISCONNECTS FOR HVAC/MECHANICAL EQUIPMENT AT +48"A.F.G. TO TOP OF DISCONNECT OR, WHERE APPLICABLE, TOP OF DISCONNECT AT TOP OF ADJACENT SURROUNDING SCREEN WALL; WHICHEVER IS LOWER. COORDINATE LOCATIONS OF ALL DISCONNECTS WITH FINAL EQUIPMENT LOCATIONS PRIOR TO BEGINNING WORK AS NOT TO IMPEDE ANY EQUIPMENT ACCESS OR VIOLATE ANY NEC CLEARANCES REQUIREMENTS.

13. THE FINAL TYPEWRITTEN ELECTRICAL PANEL SCHEDULES SHALL REFLECT THE ACTUAL ROOM DESCRIPTIONS AND NUMBERS DEPICTED ON FINAL INSTALLED ROOM SIGNAGE. (FIELD VERIFY FOR ACCURACY).

14. LOW-VOLTAGE, AUDIO/VISUAL AND INTERACTIVE DISPLAY BOARD CONDUITS ARE SIZED IN ACCORDANCE WITH VENDORS INSTALLING/UTILIZING "RAPIDRUN" OR "EZ-PULL" TYPE CABLES TO EQUIPMENT. CONTRACTORS PROVIDING AUDIO/VISUAL CABLING UNDER THIS PROJECT/CONTRACT SHALL UTILIZE THESE TYPES OF CABLES.

15. LIGHT FIXTURES SUBMITTED/PROVIDED SHALL MEET THE REQUIREMENTS OF THE DESIGNLIGHTS CONSORTIUM AND/OR BE ENERGYSTAR CERTIFIED.

16. CONTRACTOR IS RESPONSIBLE FOR PROVIDING AND SUBMITTING ALL POWER PACKS, RELAYS, SENSORS, CABLING, ETC AS REQUIRED TO PROVIDE COMPLETE AND OPERATIONAL OCCUPANCY CONTROLS IN COMPLIANCE WITH THE LATEST ENERGY CODES.

17. ALL CONDUITS ENTERING THE BUILDING FROM BELOW GRADE SHALL BE SEALED OFF FROM WATER INFILTRATION WITH CONDUIT SEALANT SYSTEM EQUAL TO POLY-WATER FST SYSTEM. ALL EMPTY STUBBED UP CONDUITS SHALL ALSO BE PROVIDE WITH THREADED CAP FOR COVER.

18. PROVIDE HANDLE-LOCK-OFF TYPE BREAKERS FOR ALL CIRCUITS FEEDING ELECTRIC RESISTIVE HEATERS (EH-#, CH-#, EDH-# FOR EXAMPLE).

19. PROVIDE TAMPER-RESISTANT TYPE RECEPTACLES IN ALL LOCATIONS AS REQUIRED BY NEC 406.12

ELECTRICAL SEISMIC NOTES

1. THE PROPOSED SCHOOL PROJECT IS CLASSIFIED AS SEISMIC DESIGN CATEGORY D AND SEISMIC USE GROUP 2 WITH COMPONENT IMPORTANCE FACTOR (Ip) = 1.0.

2. THE CONTRACTOR SHALL BE FAMILIAR WITH SECTION 1621 OF THE LATEST INTERNATIONAL BUILDING CODE (IBC) AND ARKANSAS AMENDMENT SUCH THAT THE SYSTEMS AND THE COMPONENTS ARE INSTALLED TO COMPLY.

3. BECAUSE THE COMPONENTS OF THESE FACILITIES HAVE A COMPONENT IMPORTANCE FACTOR (Ip) = 1.0, THE FOLLOWING ELECTRICAL COMPONENTS ARE EXCEMPT FROM THE REQUIREMENTS OF SECTION 1621:

    3.1 COMPONENTS WHICH HAVE FLEXIBLE CONNECTIONS BETWEEN THE ASSOCIATED EQUIPMENT, PIPING AND CONDUIT, ARE MOUNTED 4 FEET OR LESS ABOVE FLOOR LEVEL, AND WEIGH 400 POUNDS OR LESS. COMPONENTS WEIGHING 20 POUNDS OR LESS DO NOT HAVE A HEIGHT RESTRICTION.

    3.2 CONDUIT SUPPORTED BY ROD HANGERS WHICH ARE 12" OR LESS IN] LENGTH FROM TOP OF PIPES TO STRUCTURE. THE HANGERS MUST BE RIGID CONSTRUCTION WHICH WILL NOT BE SUBJECT TO BENDING.

    3.3 COMPONENTS SUPPORTED BY CHAINS OR SIMILARLY SUSPENDED FROM ABOVE ARE NOT REQUIRED TO MEET THE LATERAL SEISMIC FORCE REQUIREMENTS AND SEISMIC RELATIVE DISPLACEMENT REQUIREMENTS PROVIDED THAT THEY CANNOT BE DAMAGED OR CANNOT DAMAGE ANY OTHER COMPONENT WHEN SUBJECTED TO SEISMIC MOTION AND THEY HAVE DUCTILE OR ARTICULATING CONNECTIONS TO THE STRUCTURE AT THE POINT OF ATTACHMENT. THE GRAVITY DESIGN LOAD FOR THESE ITEMS SHALL BE THREE TIMES THEIR OPERATING LOAD.

4. ALL CEILING MOUNTED EQUIPMENT SUCH AS LIGHT FIXTURES SHALL BE SECURED TO THE STRUCTURE WITH #12 GA STEEL WIRE ON TWO (2) SIDES. IN ADDITION, LIGHT FIXTURES SHALL BE SECURED TO THE CEILING WITH FACTORY UL LISTED CLIPS

NOTE: "C-CLAMP" CONNECTORS ARE NOT ACCEPTABLE EVEN WITH EXCEPTIONS.

MINIMUM WIRING NOTES

WHETHER SHOWN OR NOT - THE CONTRACTOR SHALL PROVIDE THE MINIMUM WIRE NOTED BELOW FOR ALL EQUIPMENT CONNECTIONS:

MOCP/BREAKER:	WIRE:
20A	#12AWG
25A-30A	#10AWG
35A-40A	# 8AWG
45A-55A	# 6AWG
55A-70A	# 4AWG
70A-85A	# 3AWG
85A-100A	# 2AWG

ELECTRICAL SYMBOL LEGEND

SYMBOL	DESCRIPTION
	LIGHT FIXTURE - REFER TO SCHEDULE, TYPICAL
	INDICATES EMERGENCY EGRESS FIXTURE ["EM"]
	LIGHT STRIP/COVE FIXTURE - REFER TO SCHEDULE
	CEILING MOUNTED LIGHT FIXTURE - REFER TO SCHEDULE
	WALL MOUNTED LIGHT FIXTURE - REFER TO SCHEDULE
	EXIT LIGHT - CHEVRONS AS NOTED (BRACKET INDICATES WALL MOUNT)
	EMERGENCY BATTERY LIGHT (TYPE DENOTED)
	CEILING FAN WITH T-BAR SUPPORT (REFER TO DETAIL/SCHEDULE)
	POLE/WALL MOUNTED LIGHT (TYPE DENOTED)
	TRACK AND TRACK LIGHT (TYPES DENOTED)
	LIGHTING CHANNEL WIRE (TYPE DENOTED)
OS	OCCUPANCY SENSOR - CEILING MOUNT 360DEG INFRARED TYPE
OS	OCC SENSOR - CEILING MOUNT CORRIDOR ULTRASONIC TYPE (AIM DOWN CORRIDOR)
OS	OCC SENSOR - CEILING MOUNT 360DEG DUAL-TECHNOLOGY TYPE
OS	OCCUPANCY SENSOR - DIRECTIONAL DUAL-TECHNOLOGY TYPE
	OCC SENSOR - WALL MOUNT +8'-0"AFF UNO - SEE DETAIL
$OS	OCC SENSOR - FLUSH WALL SWITCH @ +48"AFF TO TOP OF SWITCH
LS	LIGHT LEVEL SENSOR - TYPE DENOTED
	PHOTOCELL "PEC"
$T	DIGITAL TIMER SWITCH - FLUSH MOUNT @ +48"AFF TO TOP OF SWITCH
$	SWITCH - SINGLE POLE, 4'-0" A.F.F.
$2	TWO-POLE TOGGLE DISC. SWITCH-MTD AS NOTED
$3	SWITCH - THREE WAY, 4'-0" A.F.F.
$4	SWITCH - FOUR WAY, 4'-0" A.F.F.
ab$c	a,b,c INDICATES ZONE CONTROLLED, TYP.
$D	DIMMER - 4'-0" A.F.F. - TYPE AS NOTED/REQUIRED BY MANU' OF FIXTURE BEING CONTROLLED - SUBMIT WITH LIGHTING PACKAGE.
$LV	LOW VOLTAGE SWITCH - TYPE AS NOTED/SPECIFIED MOUNT BACKBOX AS REQ'D AT 4'-0" A.F.F. TO TOPWITH 3/4"C MIN. TO ABOVE ACCESSIBLE CEILING. [LVM - INDICATES "MASTER"]
$K	INDICATES KEYED SWITCH
$F	VARIABLE SPEED CONTROLLER FOR CEILING FAN - 4'-0" A.F.F. REFER TO CEILING FAN SPECIFICATION FOR MODEL NUMBER.
	SW. W/PILOT
R	LIGHTING RELAY / LOW VOLTAGE CONTROL PACK
HEIGHT:	[+48"AFF, IN REGARDS TO ALL LIGHTING SWITCHES, IS TO THE TOP OF BOX]

SYMBOL	DESCRIPTION
	RECEPTACLE, DUPLEX - 18" A.F.F. UNLESS NOTED OTHERWISE.
	RECEPT ON EMERGENCY CKT (DUPLEX SHOWN)
	RECEPTACLE, DUPLEX "SPLIT-WIRED" AT 18"A.F.F. - U.N.O.
	ISOLATED GROUND RECEPT (DUPLEX SHOWN)
	RECEPTACLE, DUPLEX - CEILING FLUSH MOUNT. PROVIDE 6FT WHIP FROM J-BOX ABOVE CEILING TO RECEPTACLE LOCATION.
	SPECIAL PURPOSE OUTLET
	CONDUIT COUPLING - CONNECT TO EQUIPMENT AS REQUIRED.
	INDICATES ABOVE COUNTER [TYPICALLY, +6" TO BOTTOM OF BOX FROM COUNTERTOP HEIGHT - U.N.O.]
	RECEPTACLE (DOUBLE DUPLEX) - 18" A.F.F. - U.N.O.
	SPECIAL RECEPTACLE, NEMA STYLE AS NOTED - VERIFY SIZE WITH EQUIPMENT [TYPICALLY, +18" AFF - U.N.O.]
	DUPLEX/QUAD RECPT IN FLUSH MOUNTED FLOORBOX, SEE PLANS FOR COOR'D WITH SYSTEMS FLOOR BOX(ES) [MULTI-GANG WALKER RFB6-OG SERIES - U.N.O.]
	RECEPT ON DROP CORD (DUPLEX SHOWN)
	RECEPT ON CORD REEL (DUPLEX SHOWN)
	240 VOLT RECEPT (TYPE AS NOTED)
HEIGHT:	[+18", IN REGARDS TO RECEPTACLES, IS TO THE CENTERLINE OF BOX]
$M	MANUAL MOTOR STARTER, SQUARE 'D' TYPE FG w/ OVERLOAD PROTECTION IN ALL PHASES. MOUNT AT 4'-0" A.F.F. TO TOP AND MARK WITH BAKELITE LABEL AS DETAILED.
	COMBINATION MOTOR STARTER AND DISCONNECT SWITCH W/HOA SWITCH, RUN PILOT LIGHT AND AUX. CONTACTS
	FUSED DISCONNECT - w/GROUNDING LUG, SIZE/FUSE AS NOTED ON PLANS
	DISCONNECT SWITCH - w/GROUNDING LUG, SIZE AS NOTED ON PLANS
	ENCLOSED CIRCUIT BREAKER
	ELECTRIC ELEMENT - SIZE AS NOTED (MAKE ALL FINAL CONNECTIONS)
	EQUIPMENT - SIZE AS NOTED ON PLANS (MAKE ALL FINAL CONNECTIONS)
	MOTOR - SIZE AS NOTED ON PLANS (MAKE ALL FINAL CONNECTIONS)
	SURFACE MOUNTED PANEL BOARD
	FLUSH MOUNTED PANEL BOARD
	PUSHBUTTON - TYPE AS INDICATED ON PLANS.
	METER SOCKET - AS REQ'D BY UTILITY
	GROUND ROD
	GROUND ROD (PLAN VIEW)
	ANTENNA
	POWER POLE
T	TELEPHONE PEDESTAL
	LIGHTNING PROTECTION AIR TERMINAL

SYMBOL	DESCRIPTION
F	INTERIOR: FIRE ALARM HORN/SPKR - MTD. AT 80" A.F.F. TO BOTTOM - U.N.O. EXTERIOR: RE-ENTRANT HORN/SPKR - 24" BELOW ROOF LINE, U.N.O. (11'-6" MAX. HGT.).
F	FIRE ALARM, STROBE ONLY, 80" A.F.F.
	FIRE ALARM, SPKR / STROBE COMBINATION, 80" A.F.F.
PF	FIRE ALARM STATION - PULL STATION, 4'-0" A.F.F.
TS /	WATER SUPERVISORY TAMPER SWITCH
DH /	MAGNETIC DOOR HOLD OPEN - TYPE AS NOTED IN FIRE ALARM GENERAL NOTES/SPECIFICATIONS.
S	SD - SMOKE DETECTOR - AUTOMATIC, ADDRESSABLE, CEILING MOUNTED
	HD - HEAT DETECTOR - AUTOMATIC, ADDRESSABLE, CEILING MOUNTED
S	'DSD' DENOTES DUCT SMOKE DETECTOR (SUP=SUPPLY/RET=RETURN)
F	FIRE ALARM, STROBE ONLY, CEILING MOUNT FA NOTES: "cd"= CANDELA RATING
	FA, CEILING SPKR / STROBE COMBINATION
SFA / FA	FA, CEILING SPEAKER ONLY
FS /	WATER SUPERVISORY FLOW SWITCH
	REMOTE TEST/STATUS STATION
FR /	INDICATES FA ADDRESSABLE RELAY
HEIGHT:	[+48", IN REGARDS TO FIRE ALARM, IS TO THE TOP OF BOX] [+80", IN REGARDS TO FIRE ALARM, IS TO THE BOTTOM OF BOX]
	CATV COAX OUTLET - MOUNT AT HEIGHT NOTED (F-CONNECTOR)
	VOICE/TELEPHONE JACK OUTLET @ 18" A.F.F.
	DATA/COMPUTER JACK OUTLET @ 18" A.F.F.
	COMPUTER/TELE. COMBO OUTLET @ 18" A.F.F.
	WIRELESS ACCESS POINT - CEILING
	FLUSH MOUNTED FLOOR BOX, SEE PLANS FOR COOR'D WITH POWER FLOOR BOX(ES) TELE/DATA OR COMBO AS INDICATED (MULTI-GANG WALKER RFB6-OG - U.N.O.)
TV	COMBINATION RECEPTACLE AND LOW-VOLTAGE "AV" CABLING IN MULTI-GANG BOX MOUNT AT HEIGHT NOTED/DETAILED ON RISER
	TELECOM TERMINAL BOARD: 4FTx8FTx3/4" FIRE-RATED PLYWOOD - U.N.O.
	CABLE TRAY - TYPE AND MOUNTING AS DETAILED
HEIGHT:	[IN REGARDS TO TELECOM, MATCH RECEPTACLE HEIGHTS: +18"AFF / "AC" IS +6" COUNTERTOP]

SYMBOL	DESCRIPTION
	BELL - MTD. AT 12" BELOW CEILING INTERIOR, 24" BELOW ROOFLINE EXTERIOR(11'-6" MAX. HGT.).
	DOOR BUZZER
	DIGITAL CLOCK-MTD. AT 12" BELOW CEILING INTERIOR, (11'-6" MAX. HGT.) PROVIDE DOUBLE-FACE U.N.O. / ("S") INDICATES SINGLE-FACE
I / $IC	INTERCOM CALL-SWITCH, 4'-0" A.F.F. TO TOP OF BOX
IC	INTERCOM TWO-WAY TELEPHONE HANDSET. MOUNT 4'-0" A.F.F. TO TOP OF BOX WHERE SHOWN AS WALL-MOUNT. ("ADMIN" INDICATES ADMINISTRATIVE TELEPHONE)
S / S	SPEAKER - CEILING MOUNTED 8" ROUND / 2x2 AS SPEC'D INTERCOM/PAGING U.N.O. [RN INDICATES SOUND REINFORCE, FA - FIRE, AV- AUDIO/VISUAL]
S	SPEAKER - WALL MOUNTED 12" BELOW CEILING INTERIOR, (11'-6" MAX. HGT.) ARCHITECTURAL GRADE
S	LOUDSPEAKER/HORN - MOUNT AT HEIGHT NOTED (11'-6" MAX UNO)
	VOLUME CONTROL
MIC / M	MICROPHONE OUTLET
HEIGHT:	[+48", IN REGARDS TO INTERCOM, IS TO THE TOP OF BOX]
K /	KEYPAD - INTRUS.
D / MC	MAGNETIC CONTACT(SECURITY)
EM	ELECTROMAGNETIC LOCK - ACCESS CONTROL
PIR	PIR SENSOR FOR DOOR RELEASE
PS	SECURITY/DOOR POWER SUPPLY
PH	ELECT POWER TRANSFER HINGE
PANIC	PANIC HARDWARE DOOR RELEASE
CR	CARD READER - ACCESS
EX	EXIT REQUEST BUTTON - ACCESS CONTROL
RC	READER CONTROLLER
PB	DOOR RELEASE PB / TWO-WAY INTERCOM
MD / GB	MOTION DETECTOR / GLASS BREAK
ES	ELECTRIC DOOR STRIKE /
EL	ELECTRIC LATCH
	CEILING CAMERA - CCTV
	WALL CAMERA - CCTV
HEIGHT:	[IN REGARDS TO SECURITY, +48"AFF IS TO TOP OF BOX - UNO]

SYMBOL	DESCRIPTION
TS / T	THERMOSTAT/TEMP SENSOR - PROVIDE BOX AS REQ'D BY MECHANICAL AT 4'-0" A.F.F. TO TOP WITH 3/4"C MIN. TO ABOVE ACCESSIBLE CEILING. [SEE MECH PLANS FOR LOCATIONS]
	MULTIOUTLET ASSEMBLY (TYPE DENOTED)
	SOLENOID VALVE
J	JUNCTION BOX - FINAL CONNECTION TO EQUIPMENT AS REQUIRED
J	EQUIPMENT J-BOX - TYPE AS SHOWN/NOTED - CONNECT TO EQUIPMENT AS REQUIRED
	WIRE DESIGNATIONS - HOT, SWITCH, NEUTRAL, GROUND, ISOLATED GROUND, RESPECTIVELY.
	WIRE IN CONDUIT-CEILING OR WALL
	HOMERUN TO PANEL
	CONDUIT STUB/SLEEVE
	WEATHERHEAD - SIZE AS NOTED ON PLANS
	WIRE IN CONDUIT - UNDERFLOOR. (SEE REQ'S IN SPECS)

ABBREVIATIONS:
WP - WEATHERPROOF (3R)
NS - NON-SWITCHED
EM - INDICATES EMERGENCY EGRESS FIXTURE
TC - TIME CLOCK
LC - LIGHTING CONTACTOR
FA - FIRE ALARM
EWC - ELECTRIC WATER COOLER(GFI BREAKER)
U.N.O. - UNLESS NOTED OTHERWISE
ER - EXISTING RELOCATED
WG - WIRE PROTECTIVE GUARD
1G/1G - SINGLE GANG BOX / SINGLE GANG RING
*- DASHED INDICATES EXISTING OR BELOW GRADE AS NOTED
AC - ABOVE COUNTER
HP - HORSEPOWER
C - CONDUIT ("EMT" OR "RIGID" AS SPECIFIED)
PVC - ELECT GRADE PVC CONDUIT (SCH. AS NOTED)
WM - SURFACE MOUNTED RACEWAY (WIREMOLD)
AV - INDICATES AUDIO/VISUAL DEVICE
SB - INDICATES INTERACTIVE DISPLAY BOARD
A.F.F. - INDICATES ABOVE FINISHED FLOOR
A.F.G. - INDICATES ABOVE FINISHED GRADE
B.F.G. - INDICATES BELOW FINISHED GRADE
F.D.S. - FUSIBLE DISCONNECT SWITCH
N.F.D.S. - NON-FUSIBLE DISCONNECT SWITCH

RECEPTACLES:
GFCI INDICATES GROUND FAULT CIRCUIT INTERRUPTER TYPE
CLG INDICATES CEILING
T INDICATES TAMPER-RESISTANT TYPE
U INDICATES DUPLEX POWER WITH "USB" OUTLETS
IG INDICATES ISOLATED GROUND TYPE
(PROVIDE SEPARATE NEUTRALS/GROUNDS ON ALL "IG" CIRCUITS)

EOHE	EXISTING OVERHEAD ELECTRICAL
EUGE	EXISTING UNDERGROUND ELECTRICAL
OHE	OVERHEAD ELECTRICAL
UGE	UNDERGROUND ELECTRICAL
UGT	UNDERGROUND TELEPHONE
UTV	UNDERGROUND CABLE (TELEVISION)
UFO	UNDERGROUND FIBER OPTIC
UC	UNDERGROUND SYSTEMS CONDUIT
X X X	INDICATES UTILITY TO BE REMOVED
(P) - (S)	(P-INDICATES PRIMARY; S-INDICATES SECONDARY)

LIGHT FIXTURE SCHEDULE

MARK	DESCRIPTION	MANUFACTURER	MODEL	WATTAGE	VOLTAGE	NOTES
A	2 x 2 RECESSED TROFFER	LITHONIA	CPX-2X2-4000LM-80CRI-40K-SWL-MIN10-MVOLT	30.2	UNV	-
A1	1 x 4 RECESSED TROFFER	LITHONIA	CPX-1X4-4000LM-80CRI-40K-SWL-MIN10-MVOLT	35.2	UNV	-
A2	2 x 4 RECESSED TROFFER	LITHONIA	CPX-2X4-4000LM-80CRI-40K-SWL-MIN10-MVOLT	26.1	UNV	-
A3	2 x 4 RECESSED TROFFER	LITHONIA	CPX-2X4-6000LM-80CRI-40K-SWL-MIN10-MVOLT	44.1	UNV	-
C	6" RECESSED ARCHITECTURAL DOWNLIGHT	GOTHAM	EVO-40/20-6AR-WD-LSS-MVOLT-EZ1	23.2	UNV	-
D	LINEAR UTILITY STRIP FIXTURE	LITHONIA	ZL1N-L48-3000LM-FST-MVOLT-40K-80CRI-WH	25	UNV	CHAIN MOUNT TO +10'-0" AFF WHERE NO CEILING
D1	INDUSTRIAL HIGH LUMEN UTILITY STRIP	LITHONIA	TMSL 8000LM L/LV MVOLT GZ10 40K 80CRI FINISH	58	UNV	CHAIN MOUNT TO +X'-X" AFF - UNO
G	WALL MOUNT EXTERIOR EGRESS FIXTURE	LITHONIA	AFF-FINISH-EXT	21	UNV	WALL MOUNT AT +8'-0" AFF - UNO
R	WALL MOUNT TWO-HEADED EMERGENCY EGRESS LIGHT	LITHONIA	ELM4L-FINISH	12	UNV	WALL MOUNT AT +9'-0" AFF - UNO
R2	~~WALL MOUNT HIGH OUTPUT EMERGENCY EGRESS LIGHT (2hr)~~	~~LITHONIA~~	~~ELM6L-FINISH-HO~~	~~16~~	~~UNV~~	~~WALL MOUNT AT +12'-0" AFF - UNO~~
SA	EXTERIOR TYPE 4 AREA LIGHT - SINGLE HEAD	LITHONIA	DSX2 LED P3 40K TFTM MVOLT	219	208	PROVIDE CONFIGURATIONS AS SHOWN ON PLANS. UTILIZE POLE TYPE: SSS405G (DMXXAS) FINISH
SB	EXTERIOR TYPE 4 AREA LIGHT - 2 HEAD @ 90	LITHONIA	DSX2 LED P3 40K TFTM MVOLT	219	208	PROVIDE CONFIGURATIONS AS SHOWN ON PLANS. UTILIZE POLE TYPE: SSS405G (DMXXAS) FINISH
W1	~~EXTERIOR WALL MOUNT COMMERICAL AREA LIGHT~~	~~LITHONIA~~	~~TWR1 LED P3 40K MVOLT BBBTXD~~	~~60~~	~~UNV~~	~~REFER TO ARCH ELEVATIONS FOR MOUNTING HEIGHT(S)~~
X	EMERGENCY EXIT LIGHT	LITHONIA	LQC-FINISH-1/2-R-ELN	2	UNV	WALL MOUNT AT +8'-0" AFF WHERE SHOWN AS SUCH.
Y	HIGH BAY ROUND FIXTURE	LITHONIA	JEBL-12000LM-PFL-MVOLT-40K-80CRI-WGX-DWHXD	93	UNV	MOUNT TO BOTTOM OF STRUCTURE
Z	FLOOD LIGHT	LITHONIA	DSXF2 LED P2 40K WFR MVOLT-IS-FINISH-STANCHION	78	UNV	PROVIDE 18" STANCHION MOUNT AS DETAILED ON PLANS

COMMENTS:
1. ALL HEIGHTS ARE IN REGARDS TO THE CENTERLINE OF FIXTURE - UNO.
2. ALL EXIT SIGNS SHALL BE PROVIDED WITH THE PROPER FACES/CHEVRONS AS REQUIRED. ALL EXIT SIGNS AND "R"/"G" EGRESS ONLY TYPE FIXTURES ARE TO BE NON-SWITCHED.
3. CONTRACTOR SHALL PROVIDE/SUBMIT COMPATIBLE LOW-VOLTAGE DIMMER SWITCHES WITH THE FINAL SELECTED FIXTURE SUBMITTALS.
4. ~~PROVIDE PROTECTIVE WIRE-GUARDS FOR ALL FIXTURES LOCATED IN SHOP WORKING AREA AND/OR IN SIMILAR ACTIVITY AREAS.~~

NOTE:
HUBBELL LIGHTING APPROVED EQUAL MANUFACTURER TO THE ABOVE LIGHTING SCHEDULE.

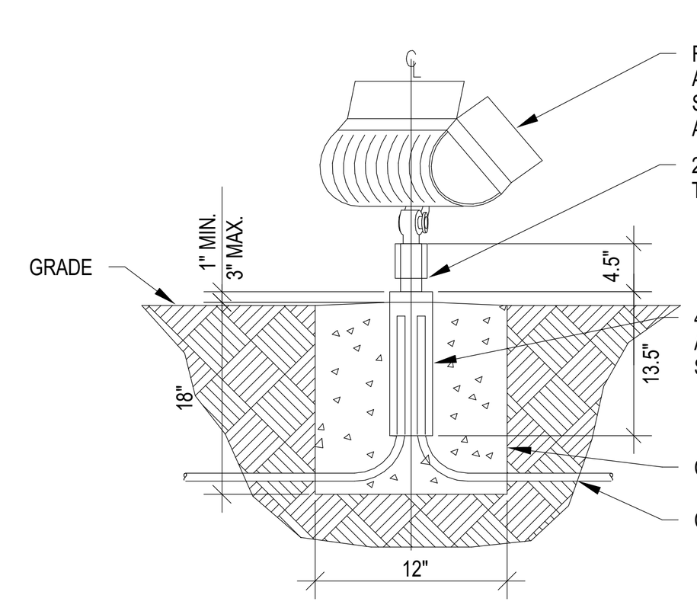

3 E7.1 LIGHT STANCHION DETAIL
NOT TO SCALE

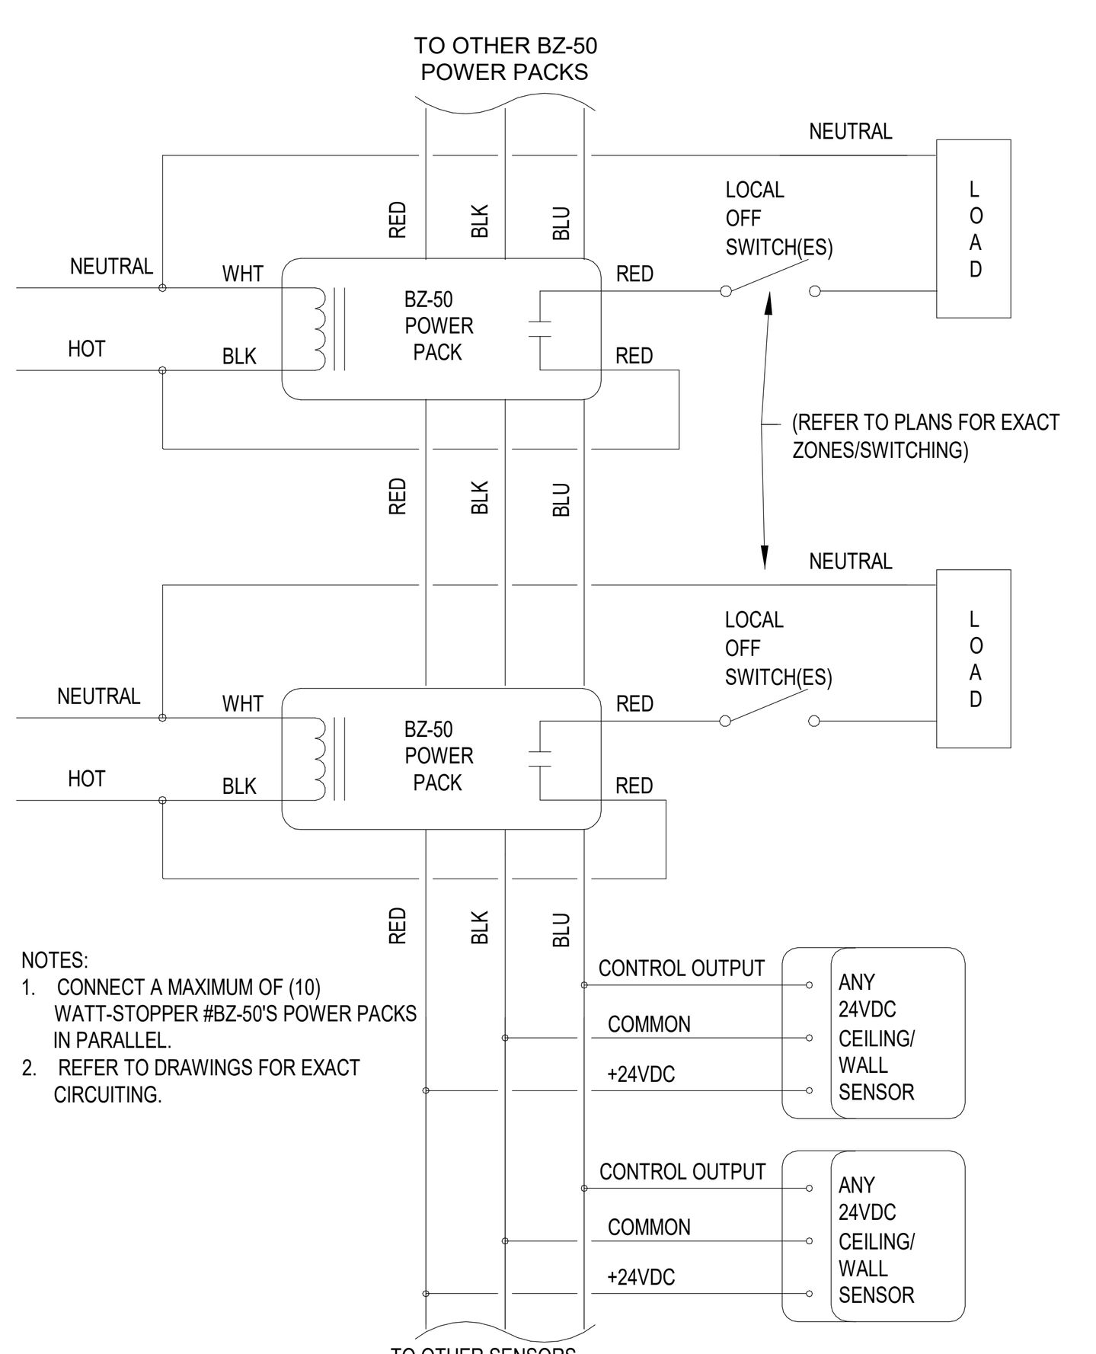

5 E7.1 OCC SENSOR DETAIL
NOT TO SCALE

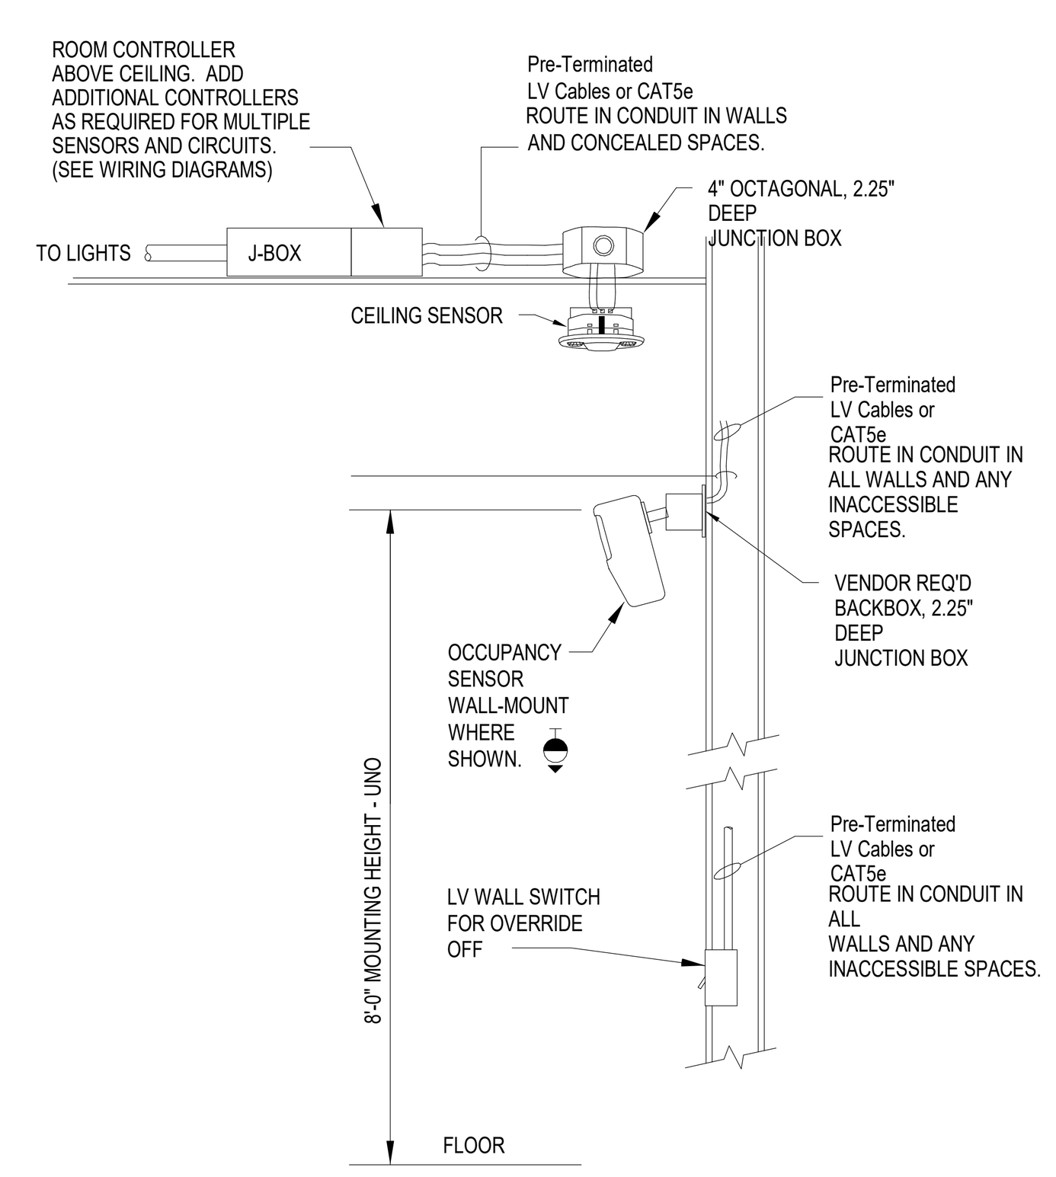

6 E7.1 OCC SENSOR MOUNT GENERAL
NOT TO SCALE

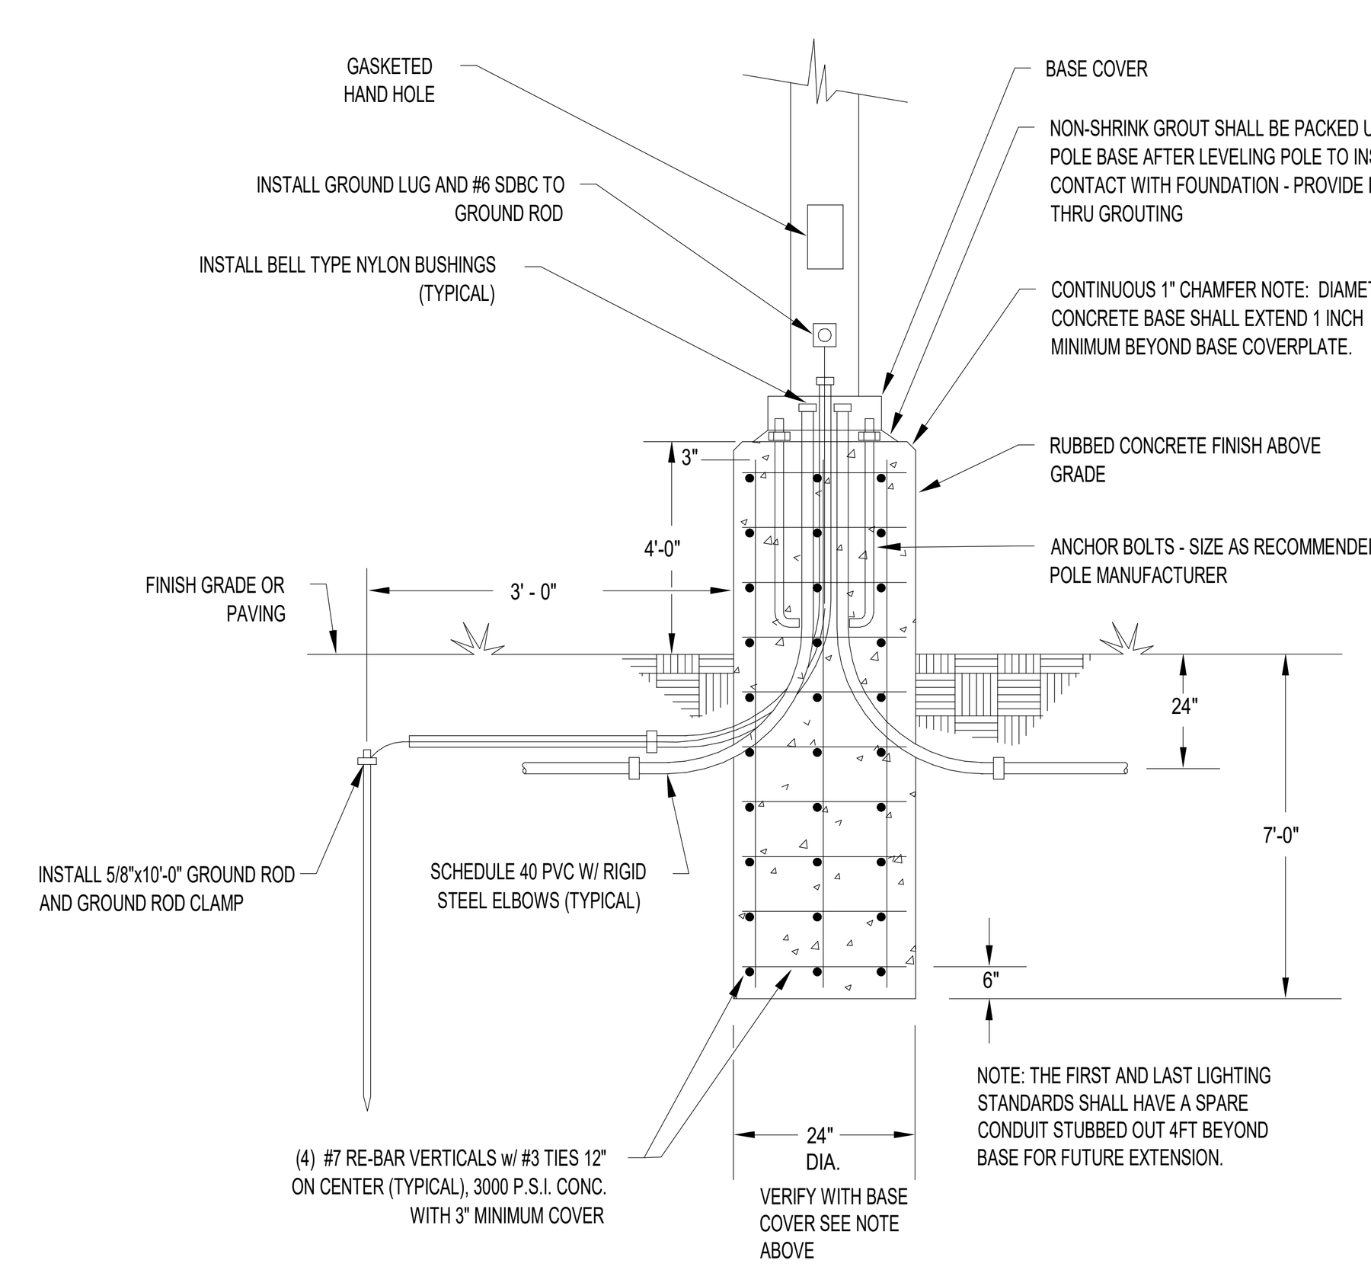

2 E7.1 LIGHT POLE BASE DET
NOT TO SCALE

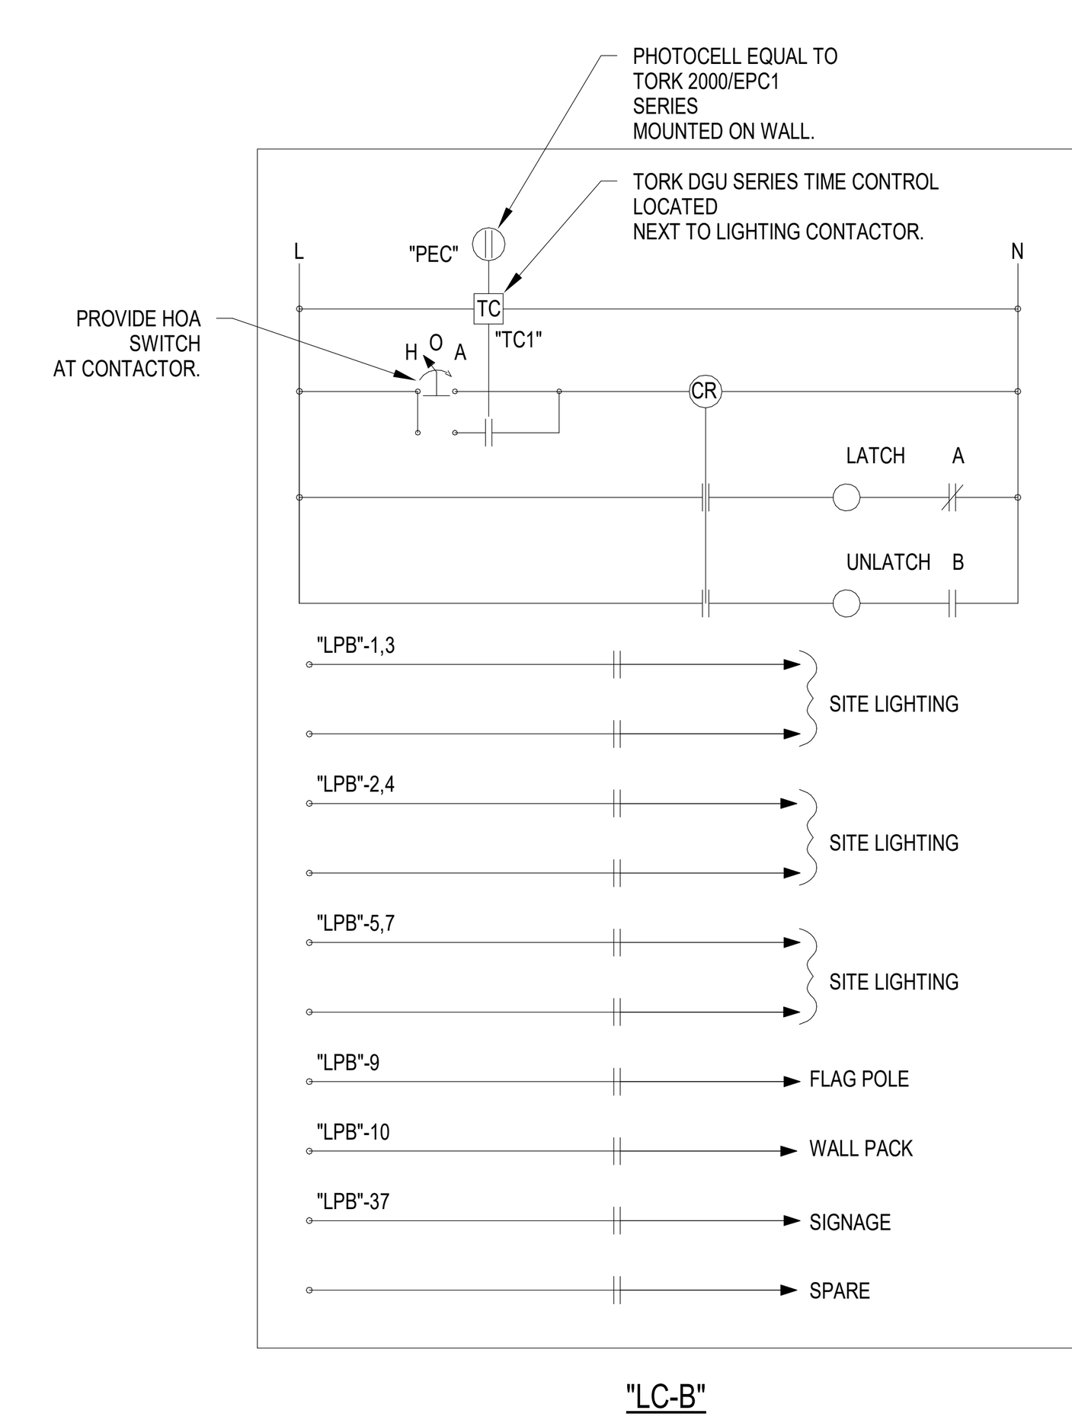

"LC-B"

MECHANICALLY HELD LIGHTING CONTACTOR IN NEMA 1 ENCLOSURE EQUIVALENT TO SQUARE D 8903-LXG-100-V02/V04 WITH 120V/277V CONTROL RELAY LOCATED IN ELECTRICAL ROOM. PROVIDE VOLTAGE AS SHOWN.

4 E7.1 LC-B
NOT TO SCALE

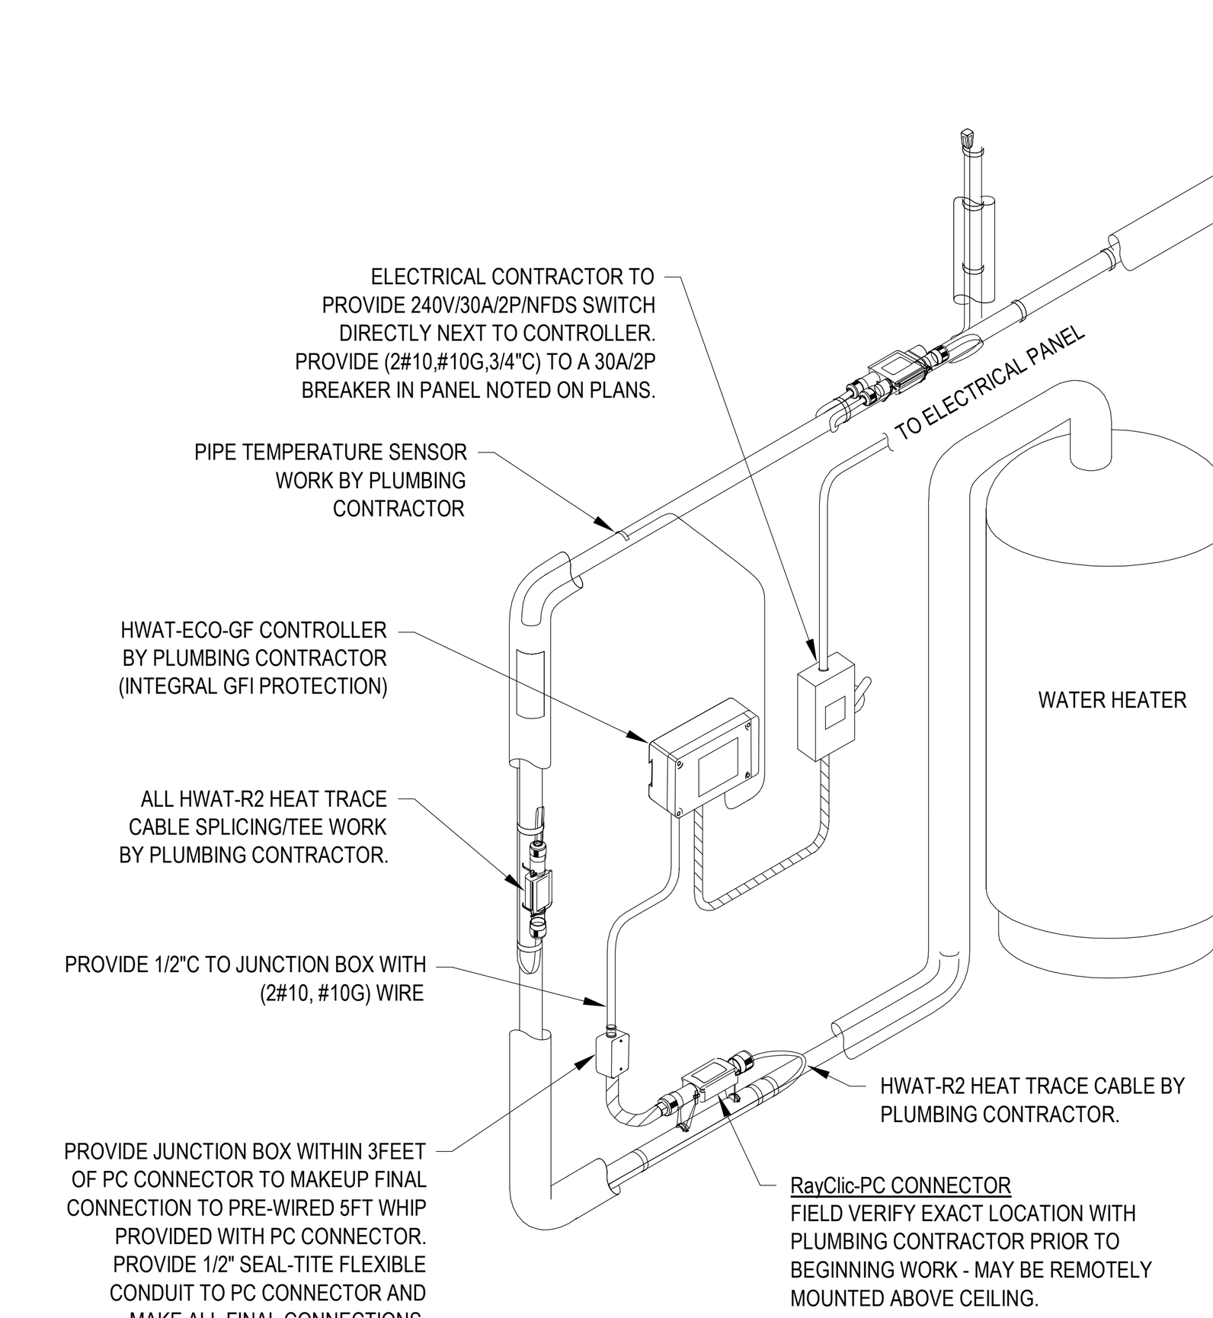

11 E7.1 HEAT TRACE CONNECTION
NOT TO SCALE

ELLIOTT • MCMORRAN • VADEN
RAGSDALE • WOODWARD • INCORPORATED
501 223 9302 • WWW LEMVRW COM
LEWIS ARCHITECTS ENGINEERS

LEGENDS & DETAILS/ LIGHT FIXTURE SCHEDULE

PUBLIC WORKS ADDITION
CITY OF PARAGOULD
PARAGOULD, ARKANSAS

CERTIFICATE OF AUTHORIZATION LEWIS ARCHITECTS ENGINEERS No. 186 ARKANSAS ENGINEER

STATE OF ARKANSAS REGISTERED PROFESSIONAL ENGINEER NO. 11659 SCOTT P. WOODWARD

DATE:	2024 08-16
PROJECT NO:	23044
DRAWN BY:	SW/CH
REVISION:	1 2024 09-05

E7.1